

1. THE INFORMATION SHOWN ON THIS
DRAWING IS COMPILED FROM :-
DRAINAGE SURVEY RECORDS PRODUCED
BY GUS DATED
AS BUILT RECORDS OF RECENT
DEVELOPMENTS DESIGNED BY MODUS
MODUS DESIGN INFORMATION (WHERE
NO AS BUILT INFORMATION AVAILABLE)
ORIGINAL SITE RECORDS


EXISTING FOUL WATER DRAINAGE SHOWN THUS :-
EXISTING SURFACE WATER DRAINAGE SHOWN THUS :-
EXISTING RISING MAIN SHOWN THUS :-
EXISTING LAND DRAIN SHOWN THUS :-

3. FOR DETAILS OF MANHOLES & INCOMING/OUTGOING PIPES REFER TO MANHOLE RECORD CARDS.

4. AREAS WHERE RESULTS OF THE DRAINAGE SURVEY ARE NOT CONCLUSIVE ARE SHOWN CLOUDED.

5. CAPACITY & CONDITION OF THE DRAINAGE NETWORK HAS NOT BEEN INVESTIGATED AS PART OF THIS SURVEY.

continued on Sheet 10124/006

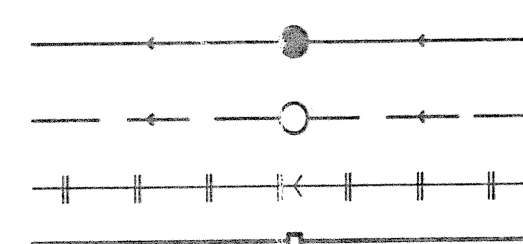

Refer to BGL drawing Substation
Proposed Drainage ref:
30042-BGL-XX-XX-DB-C-00301

A	6.2.00	BK	PH	DRAINAGE AMENDED
No.	DATE	DRAWN	REV'D	AMENDMENT

No	DATE	DRAWN	REV'D ENG.	AMENDMENT
----	------	-------	---------------	-----------

COPYRIGHT
The concepts and information contained in this document are the copyright of Sinclair Knight Merz Pty. Ltd. Use or copying of the document in whole or in part without the written permission of Sinclair Knight Merz Pty. Ltd. constitutes an infringement of copyright.



CLIENT	D.T.Z.	
PROJECT	HEYWOOD DISTRIBUTION PARK DRAINAGE SURVEY	
DRAFTER	C.M.Selwood	DRAFTING CHECK B.Brooks

TITLE		HEYWOOD DRAINAGE SHEET 1 of 5	
SCALE	PROJECT No / DRAWING No	DATE	AMOUNT
1:500	10124/002	18/12/00	A