

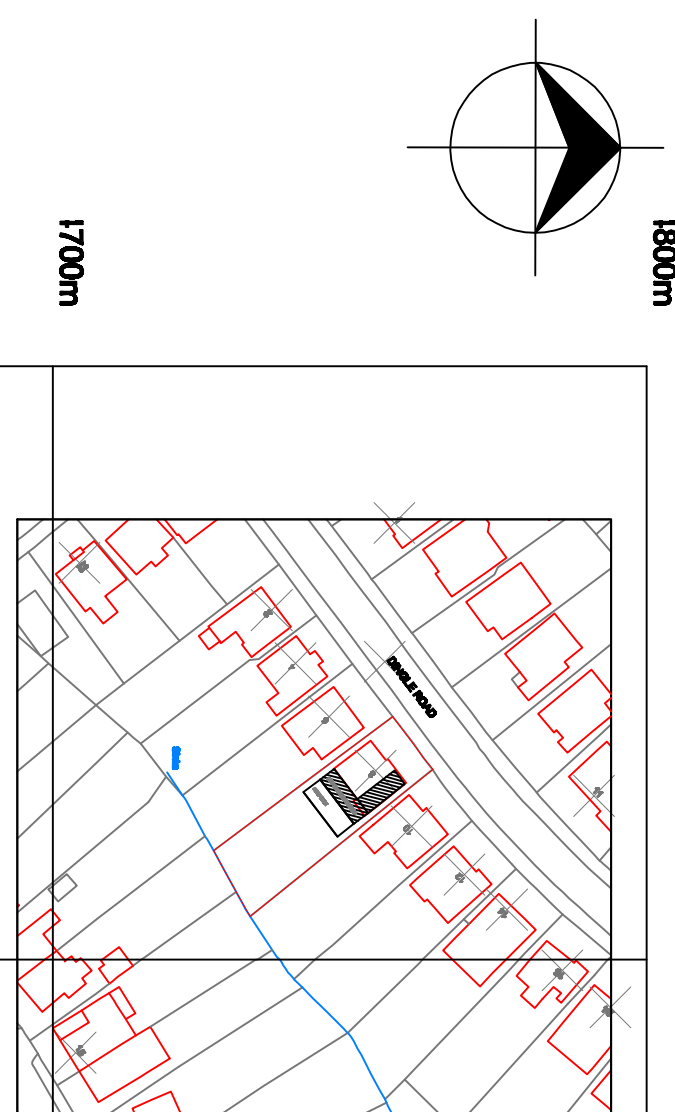
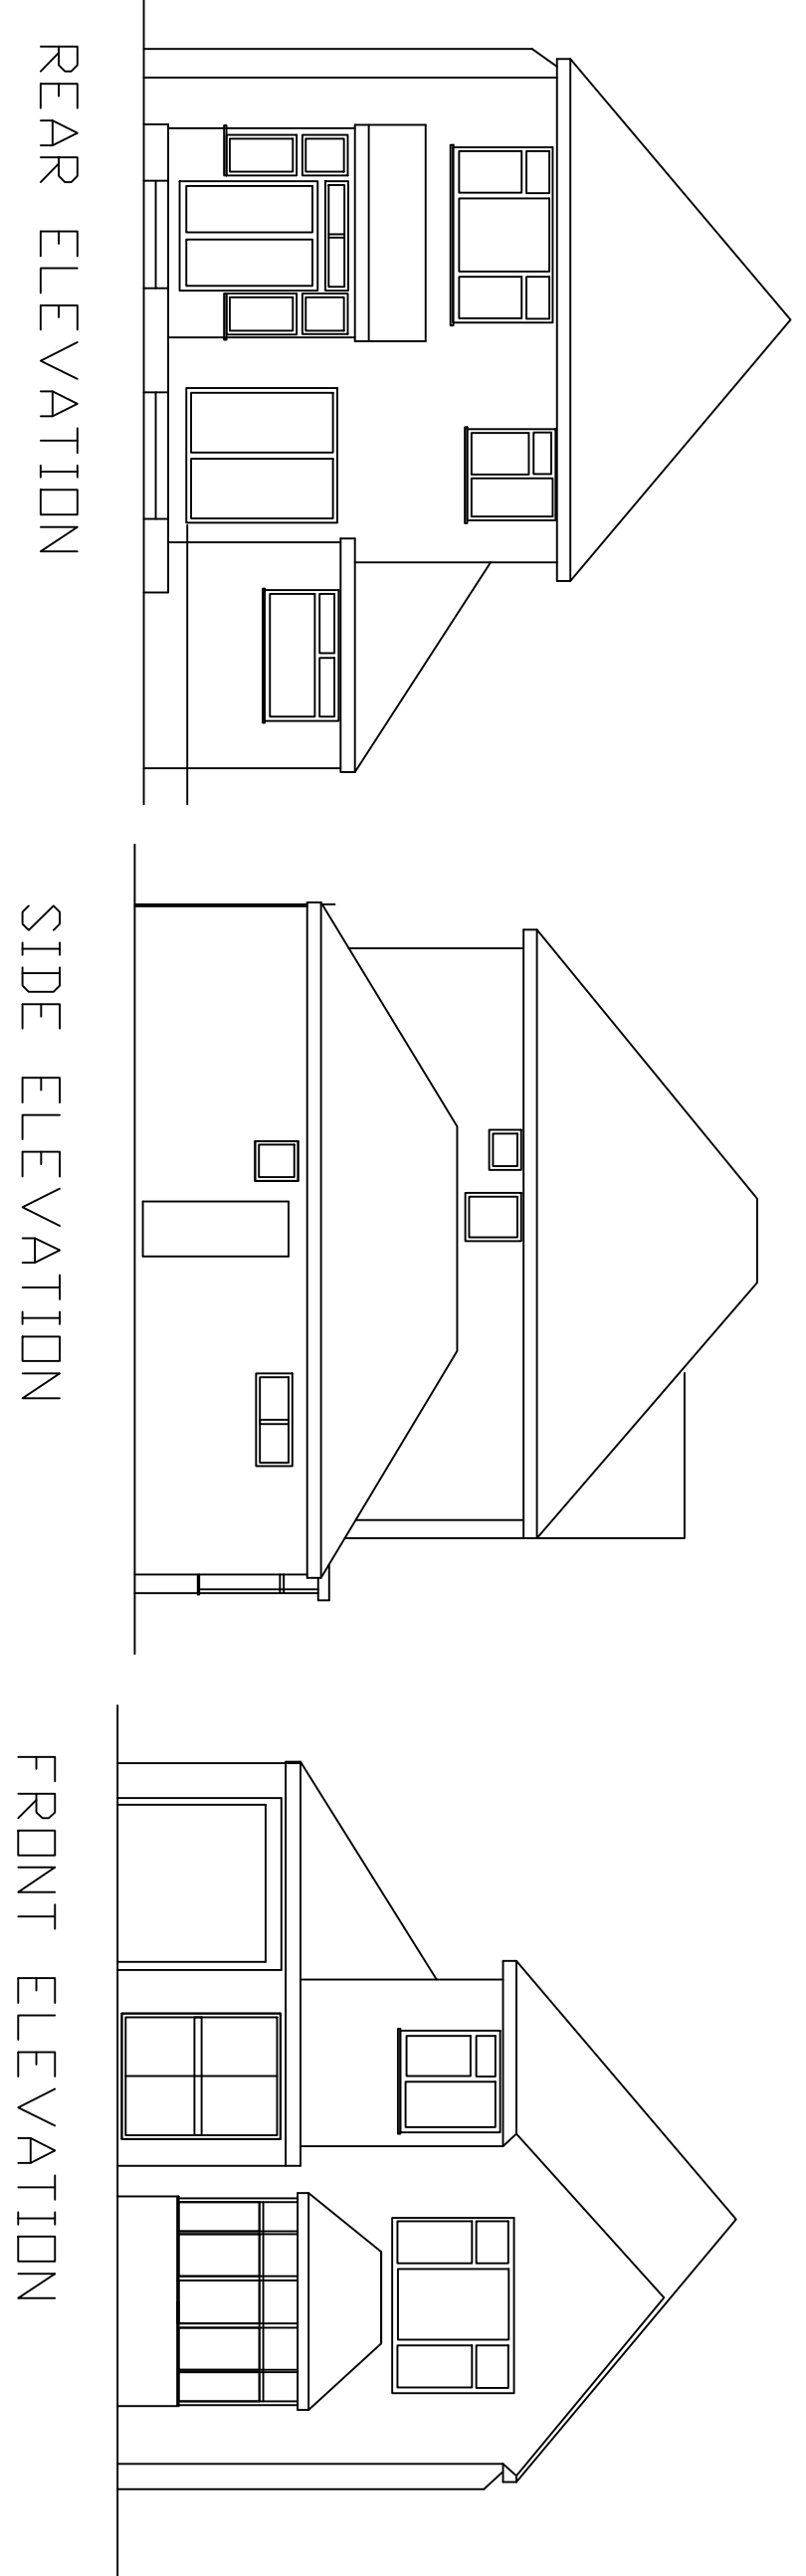
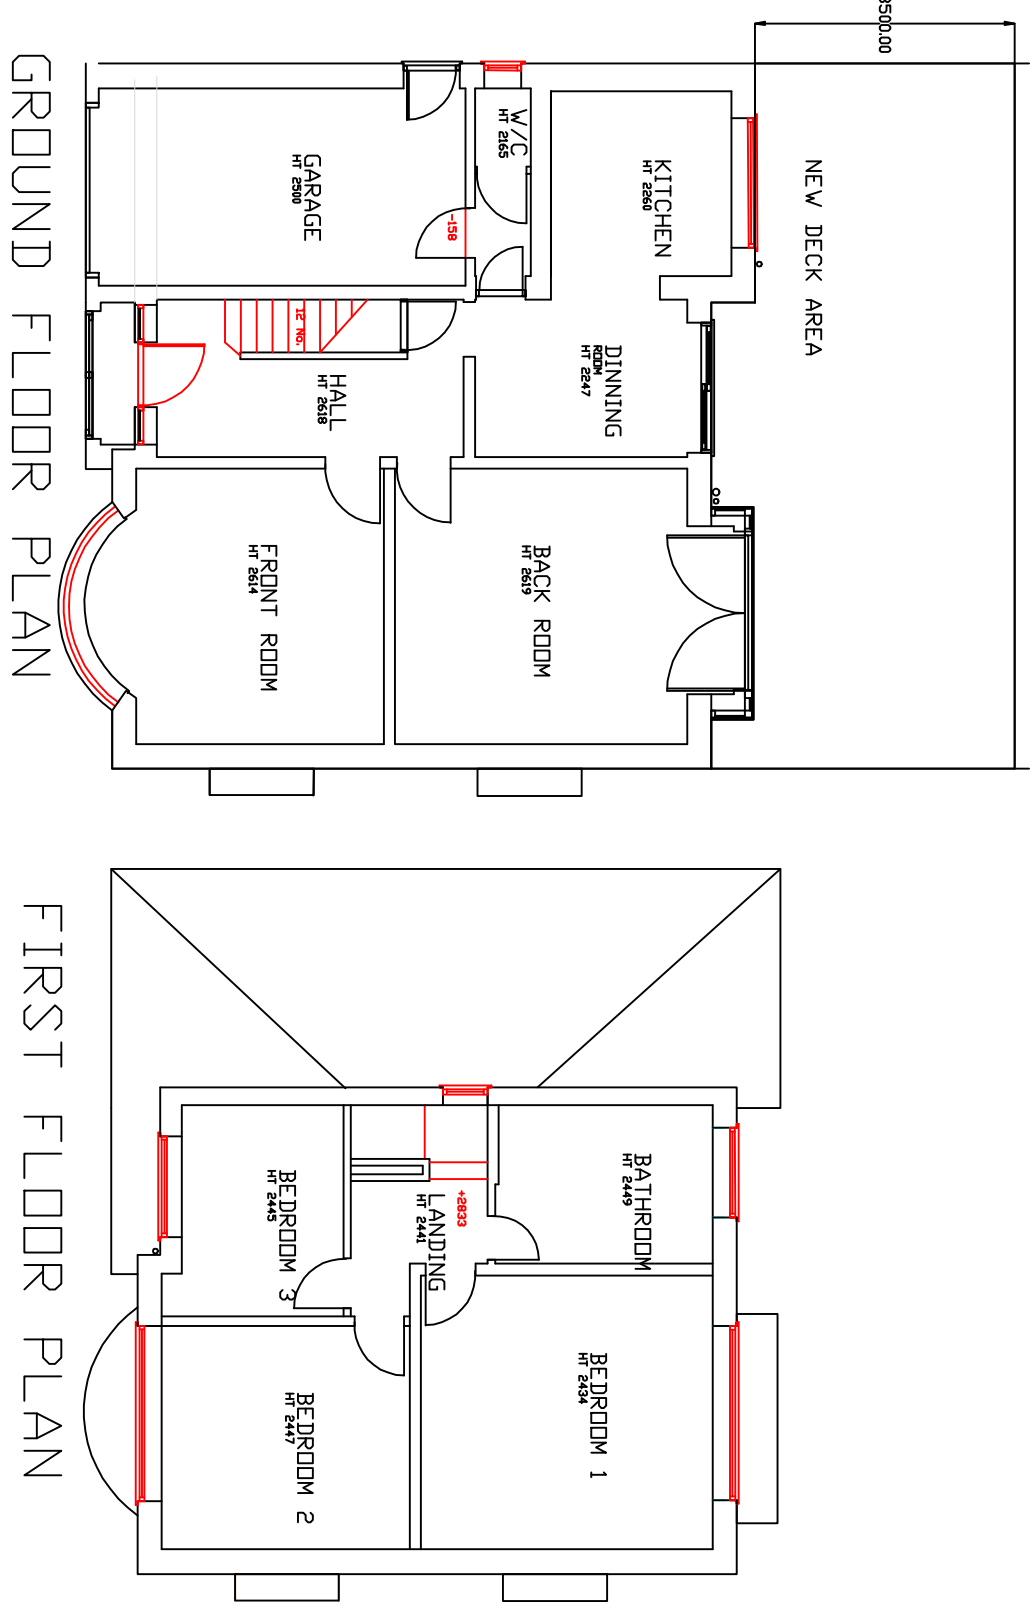





PLANS & ELEVATIONS AS EXISTING

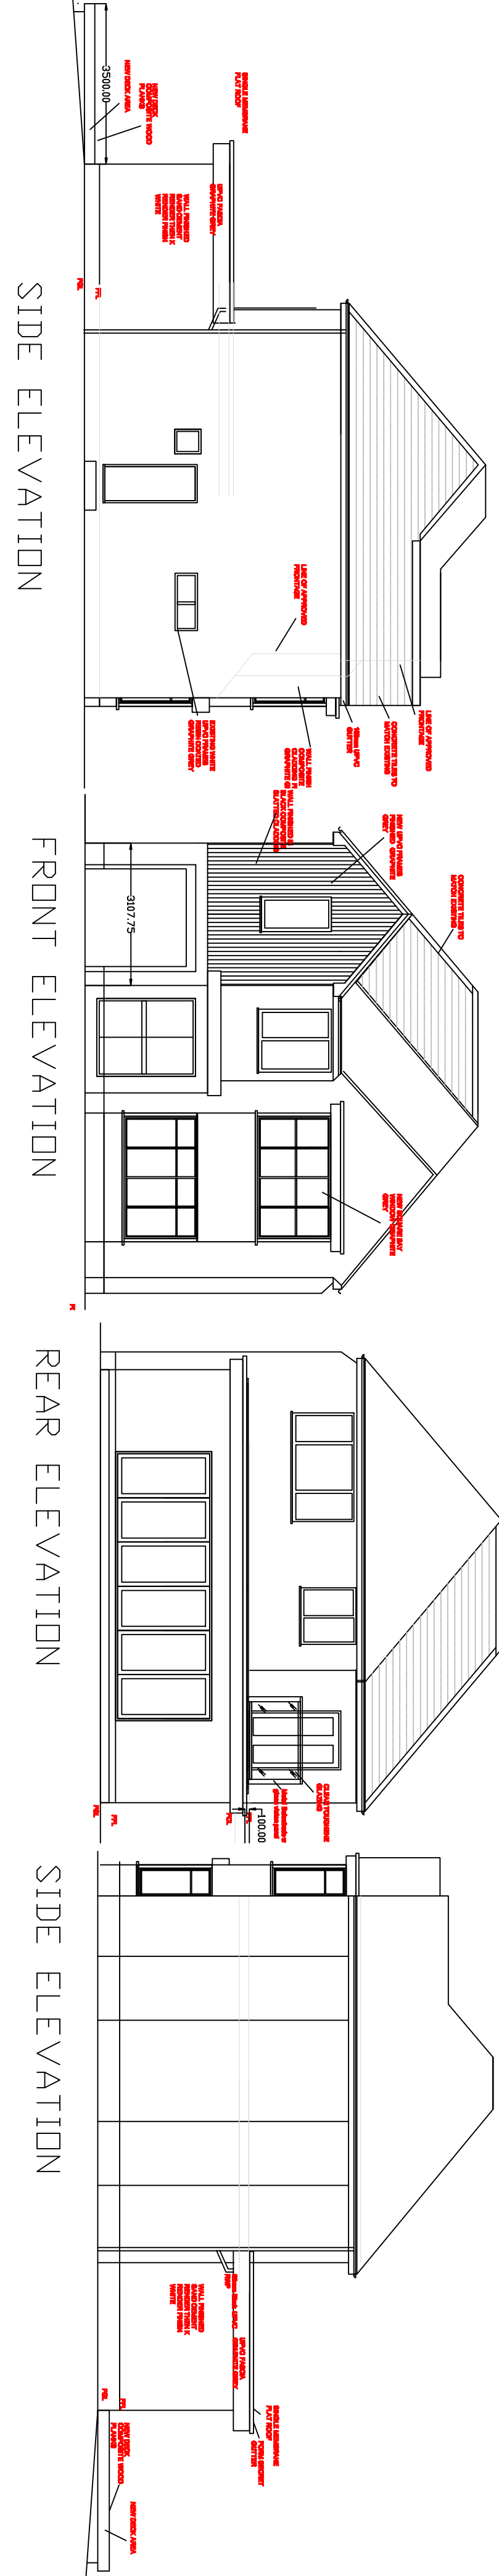

PLANS & ELEVATIONS AS PROPOSED

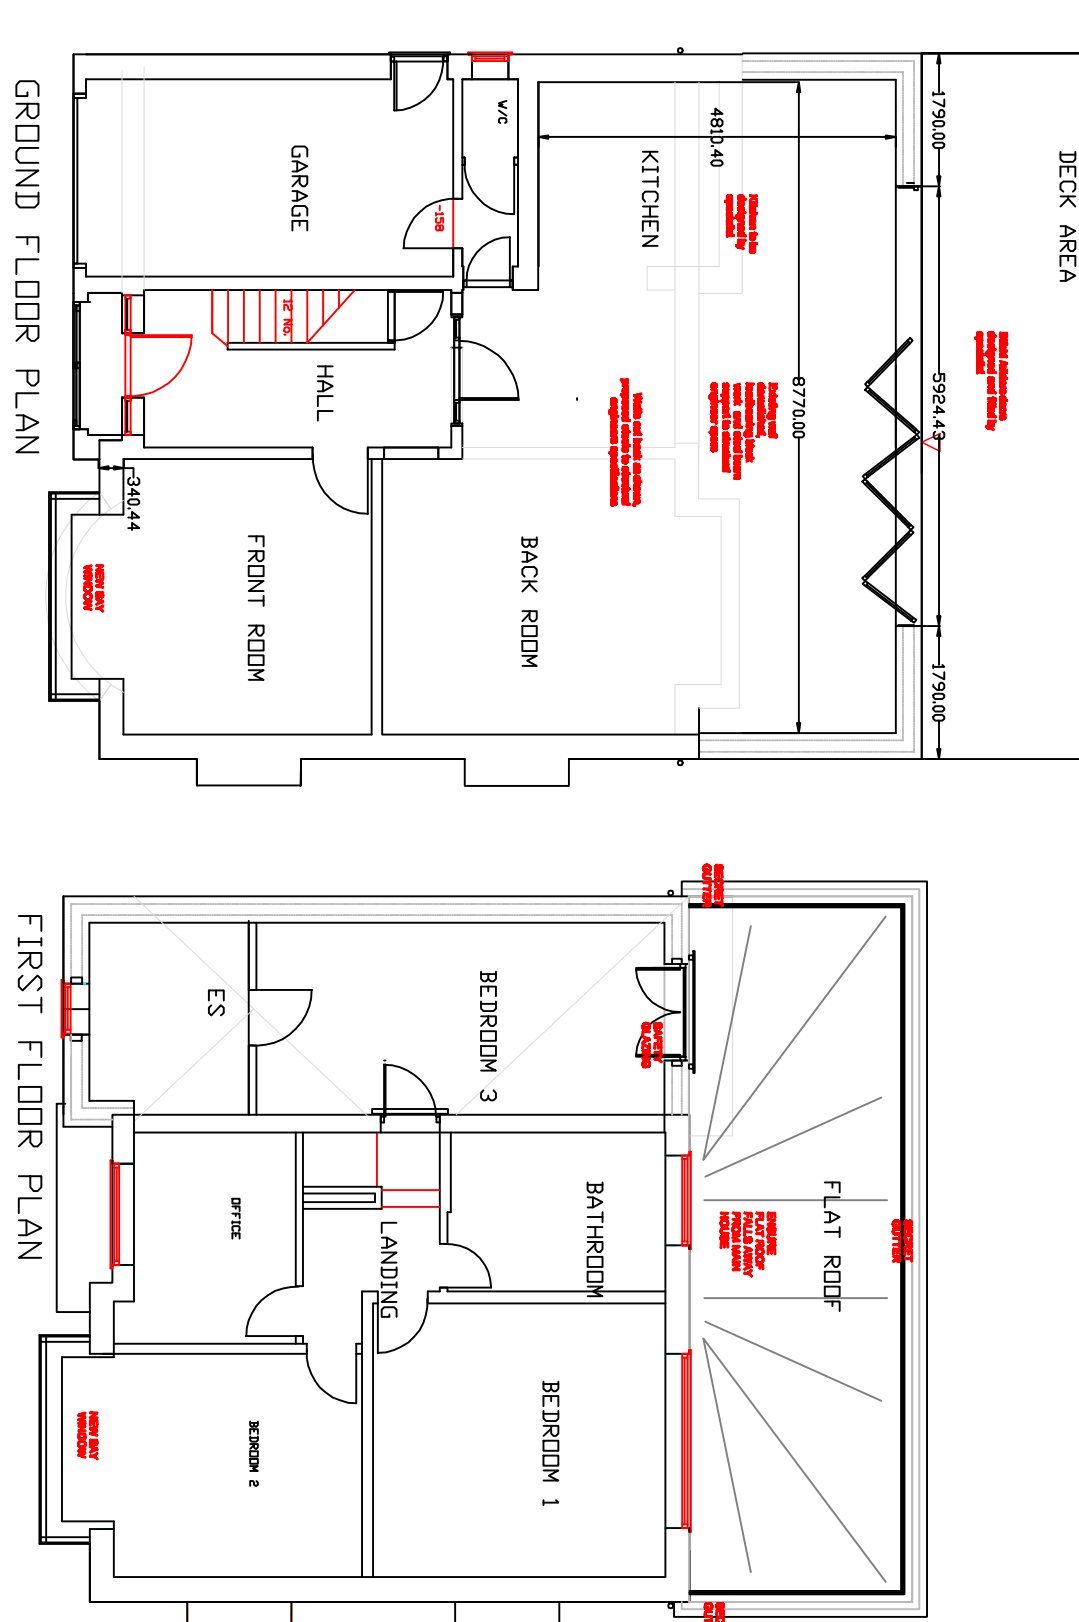

LOCATION PLAN 1/1250

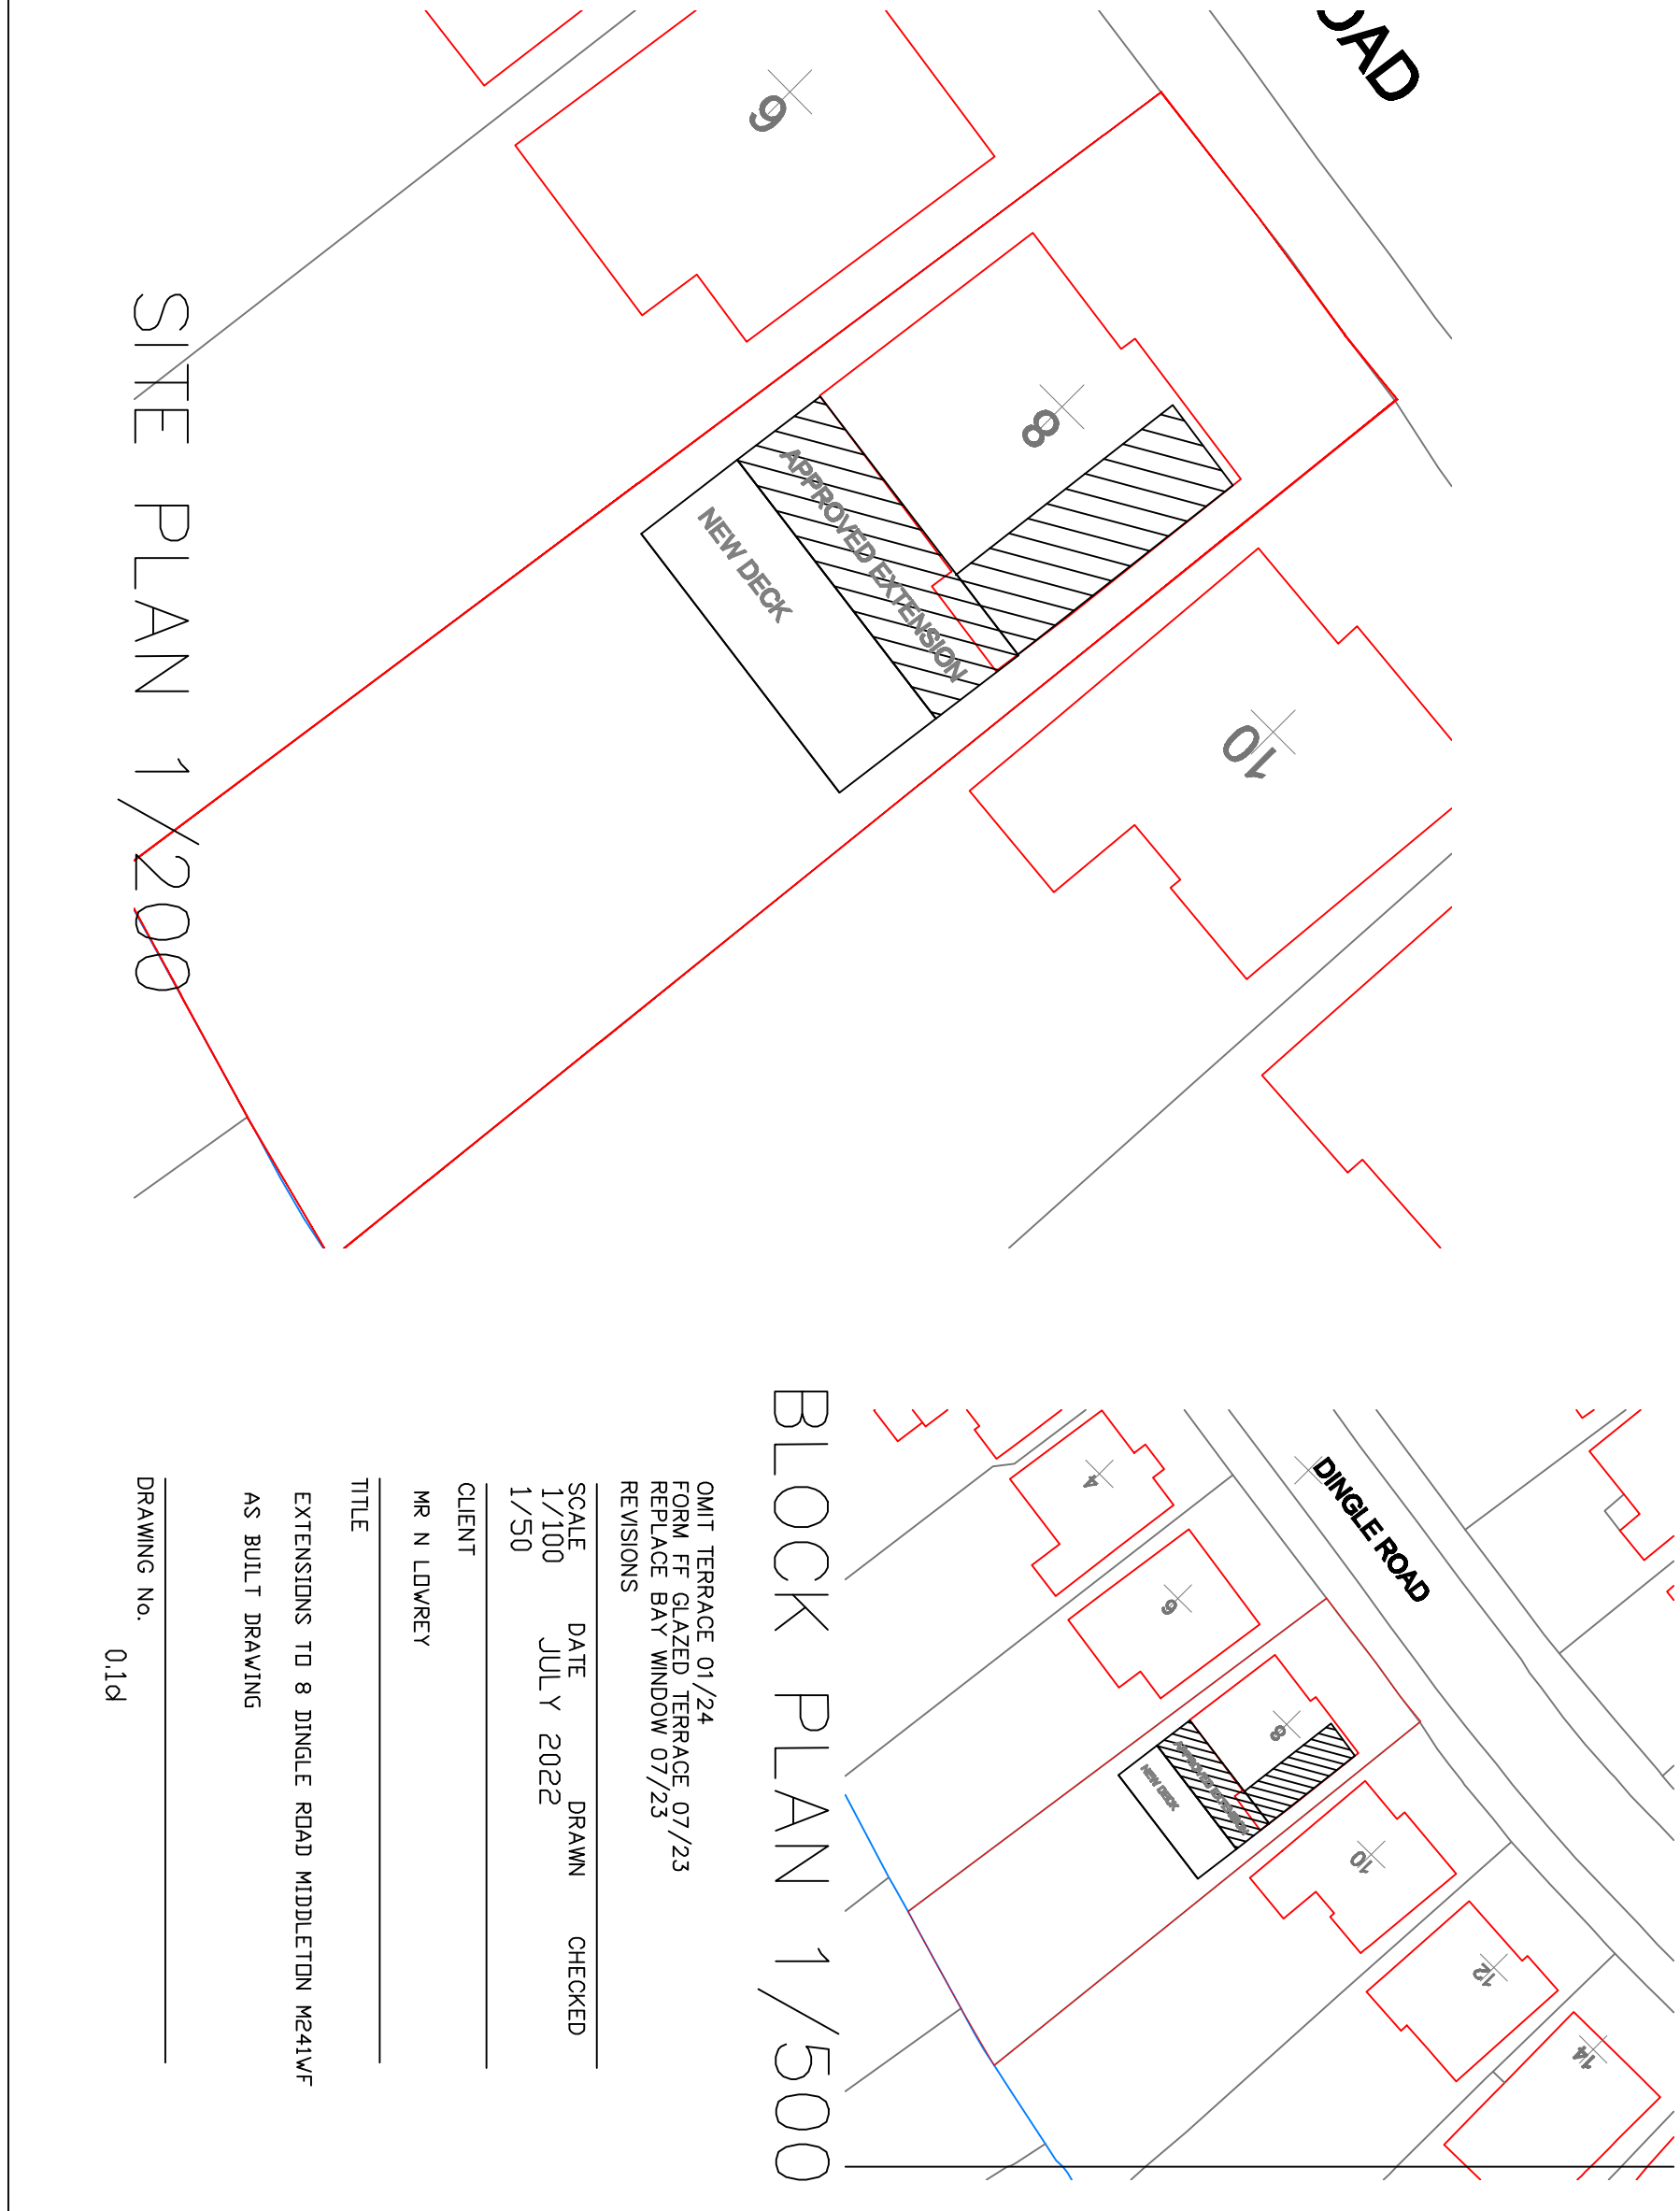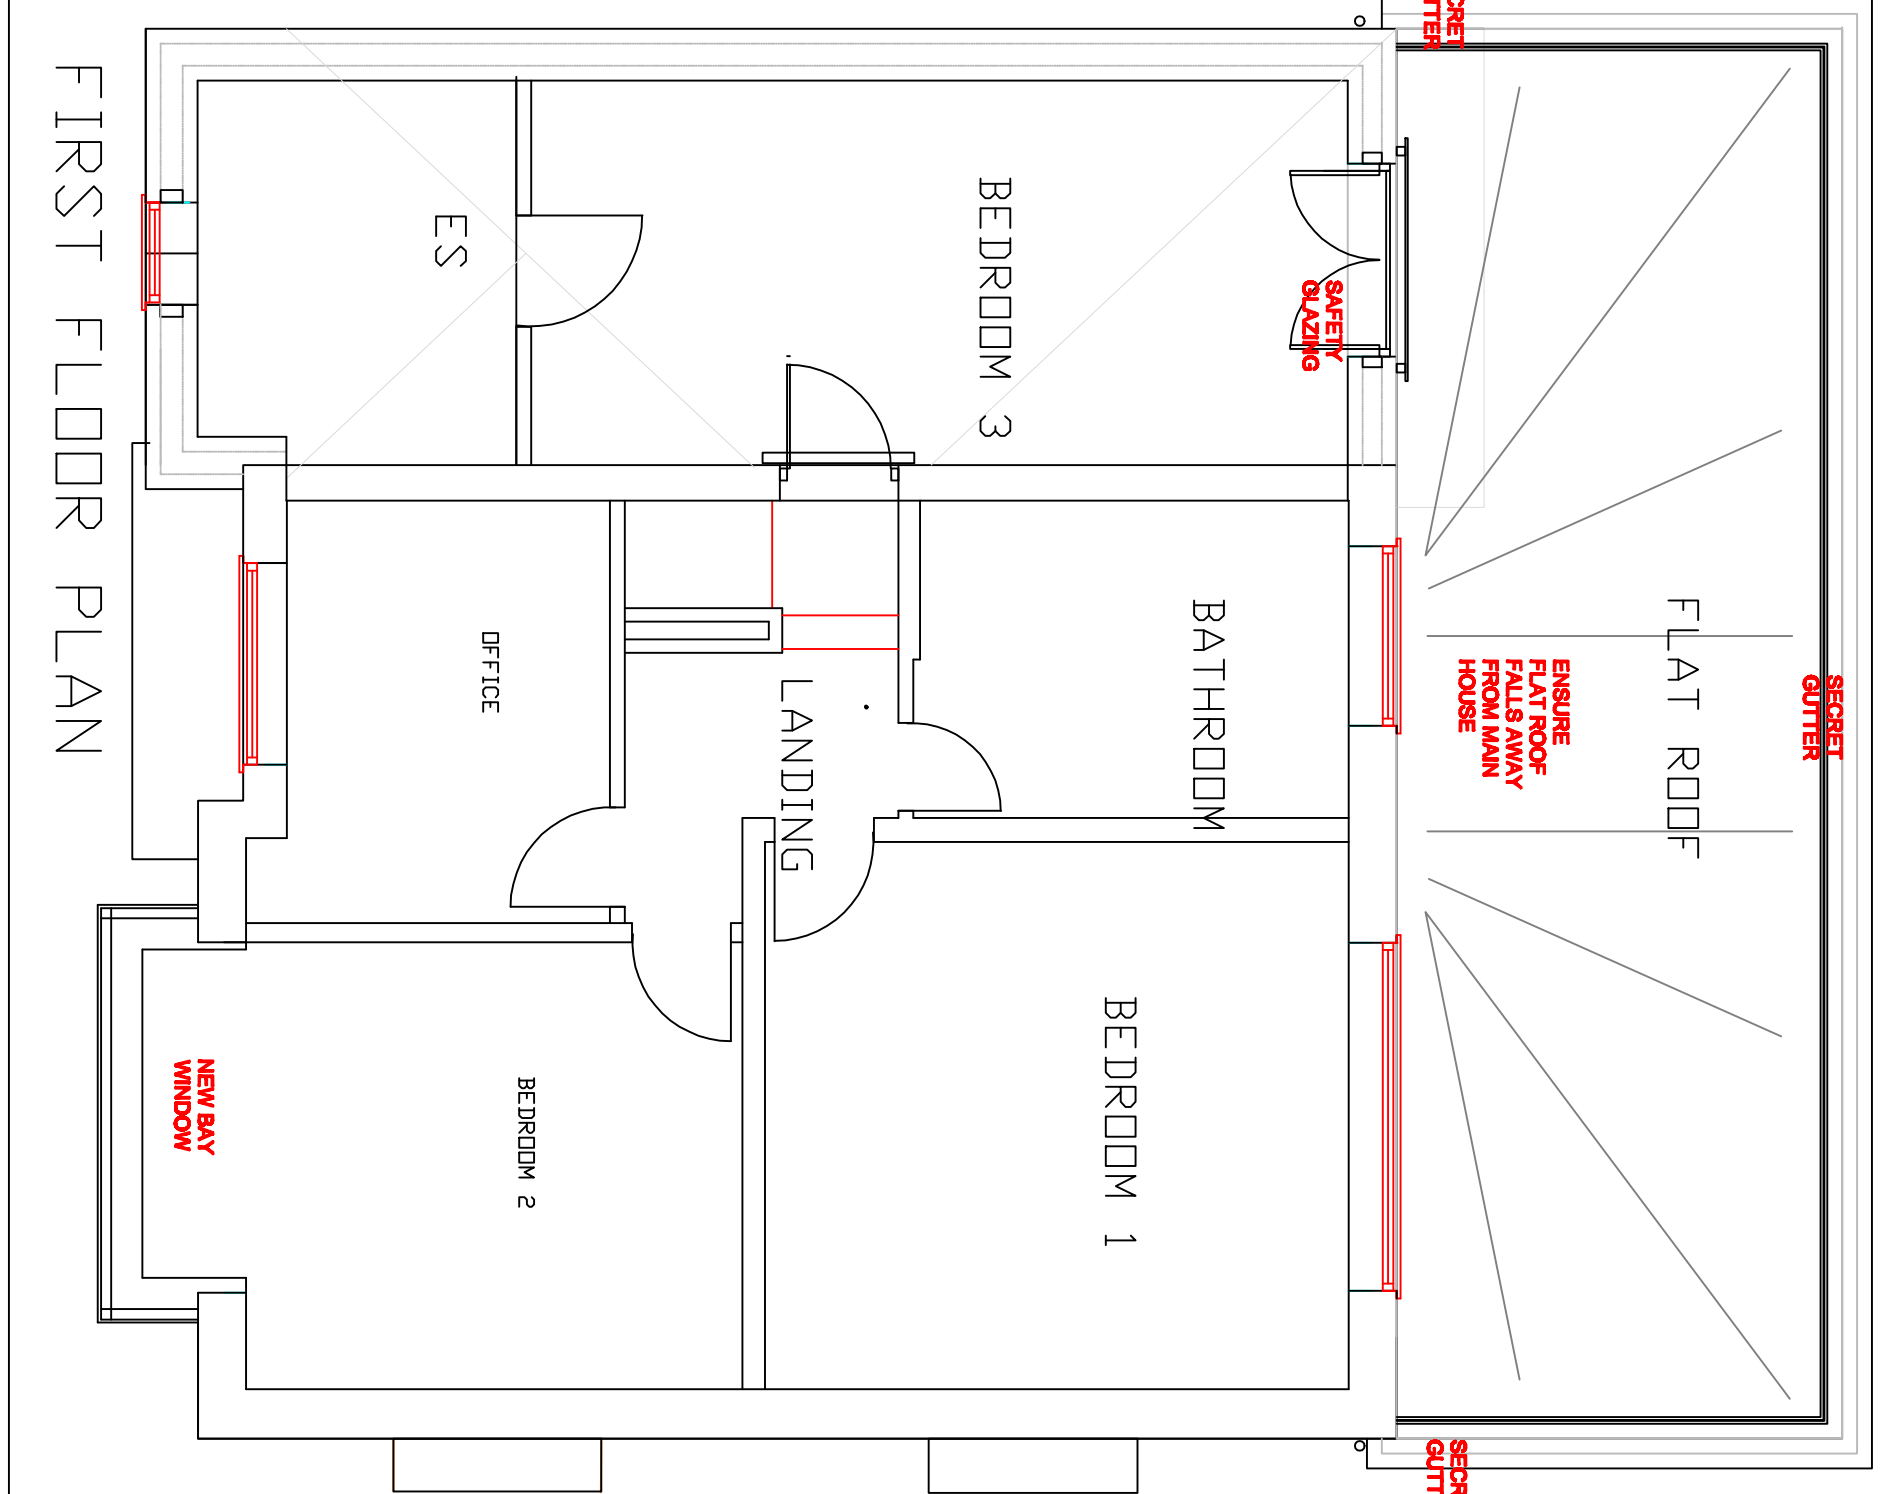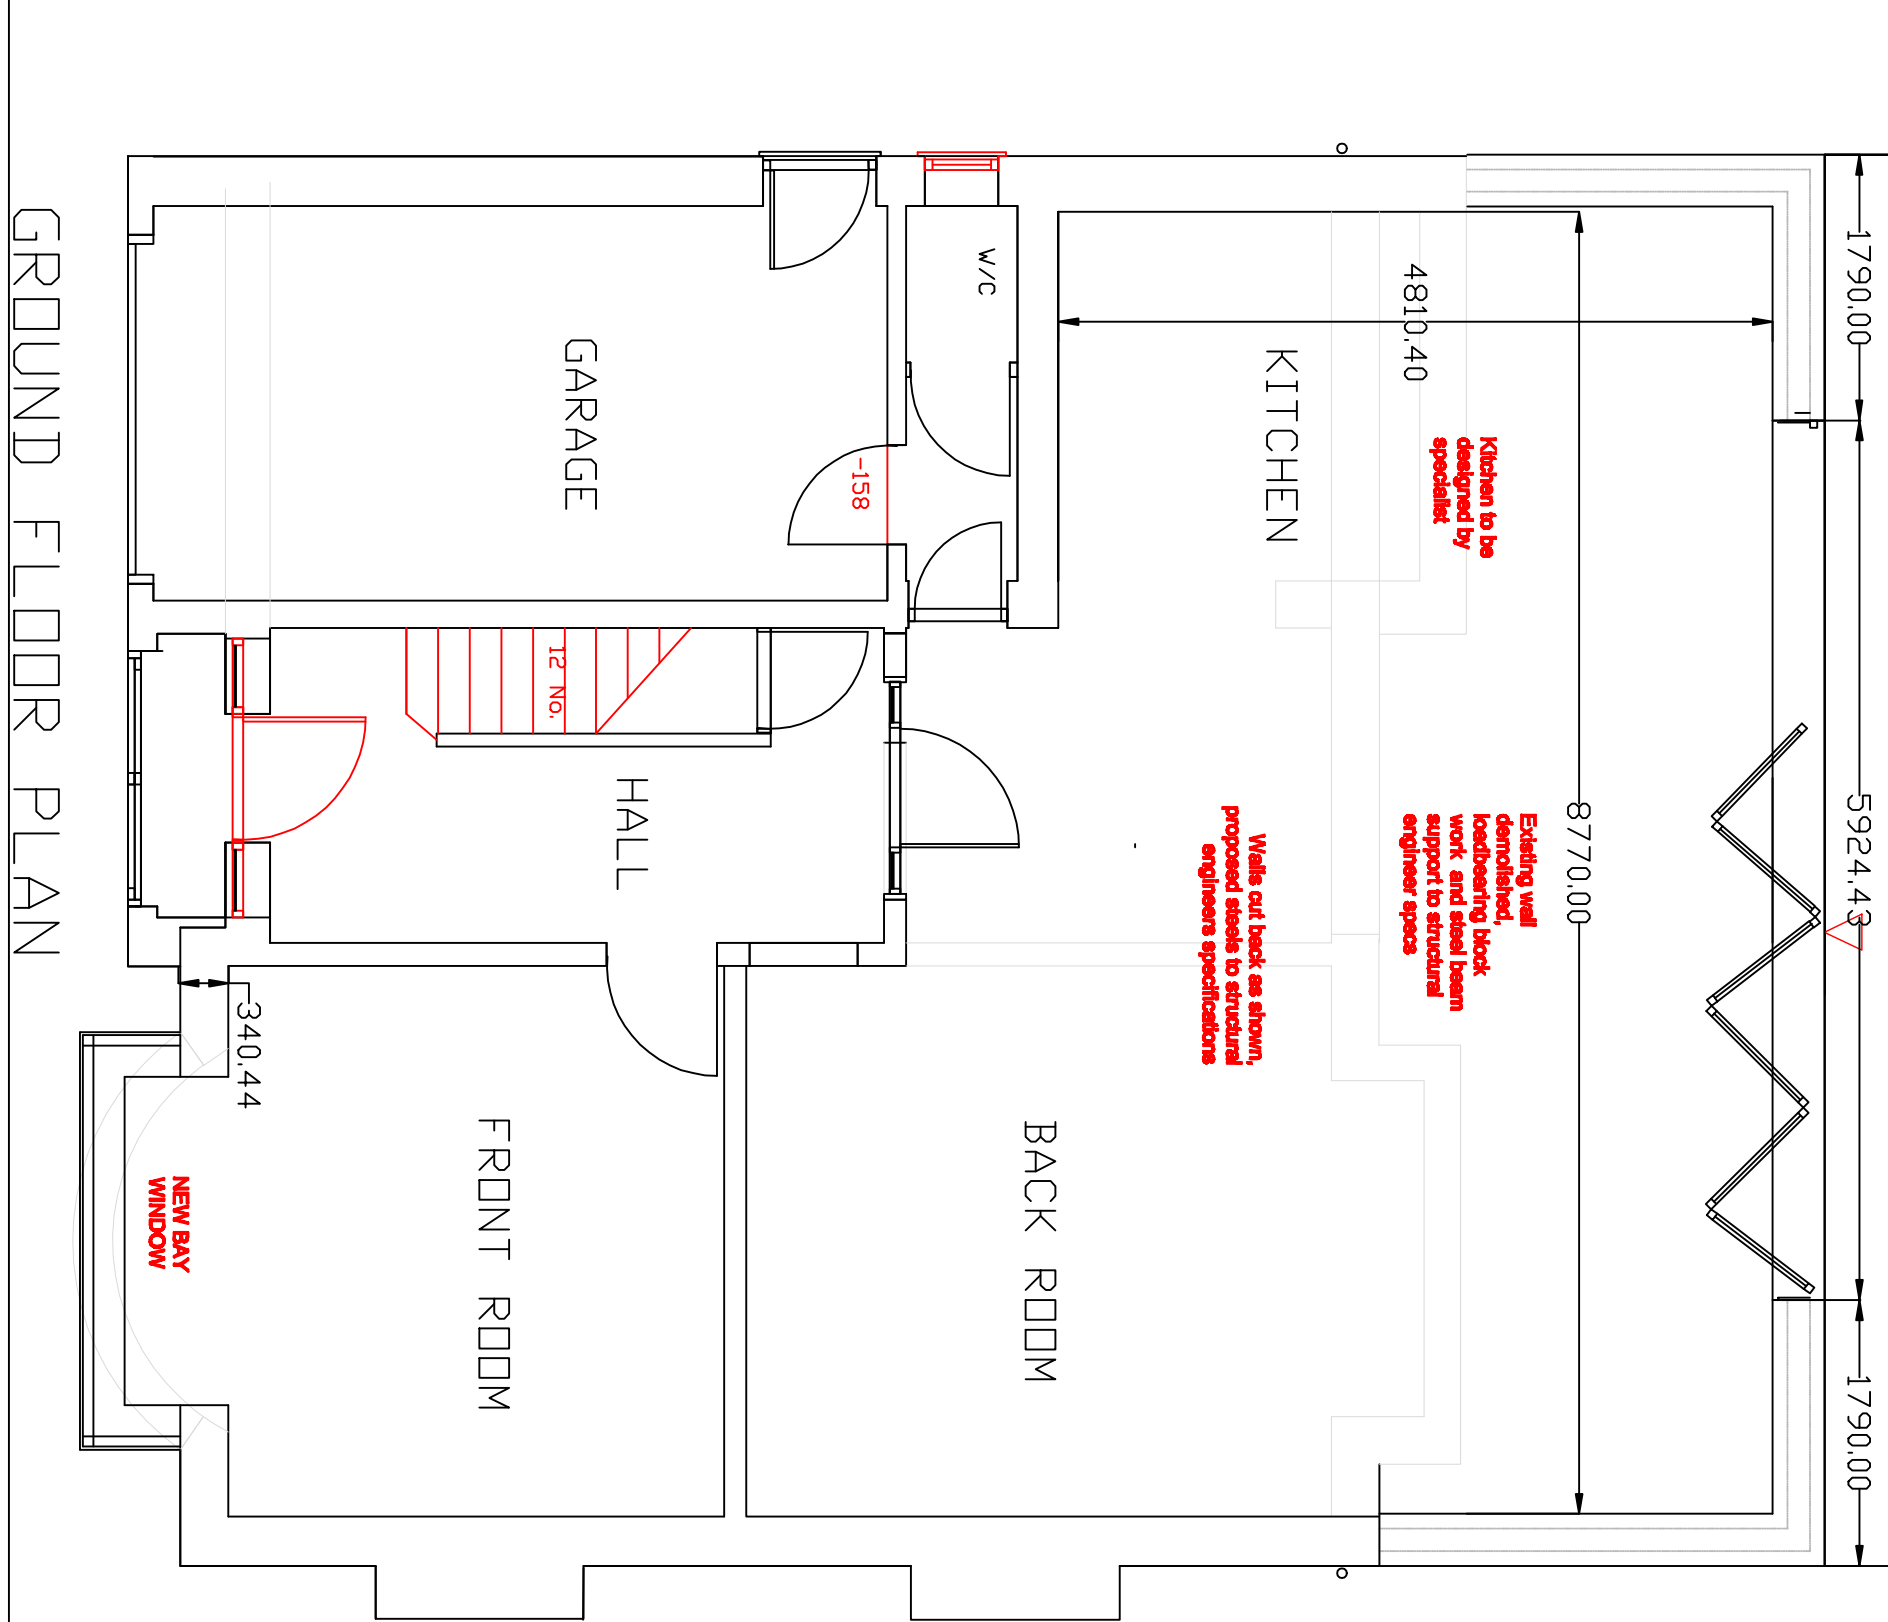

NOTES
ORIGINAL A1
DO NOT SCALE FROM THIS DRAWING.
ALL DIMENSIONS TO BE CHECKED 386400m SITE.
COPYRIGHT PROTECTED.

Ecocom Copyright and database rights 2022 OS Licence no. ACO0004986

OMIT TERRACE 07/23
REPLACE BAY WINDOW 07/23
REVISIONS

SCALE DATE DRAWN CHECKED
1/200 JULY 2022
1/50

CLIENT
MR N LOWREY

TITLE
EXTENSIONS TO 8 DINGLE ROAD MIDDLETON M241VF
AS BUILT DRAWING

DRAWING No. 016f