
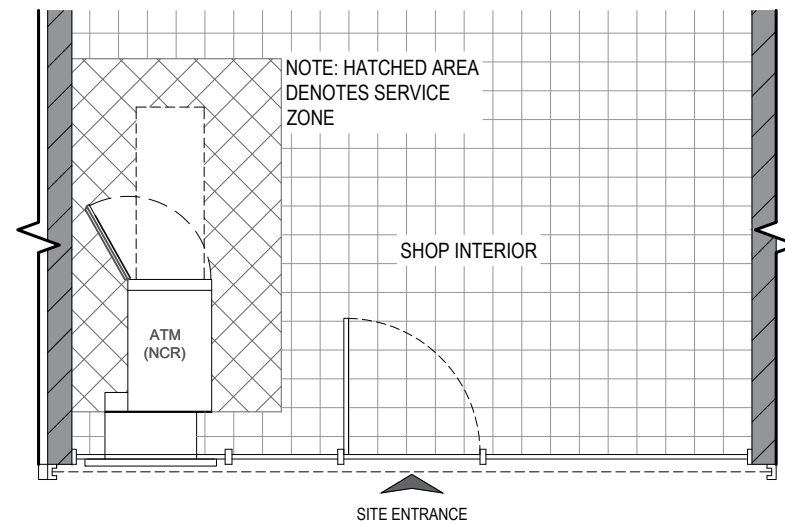
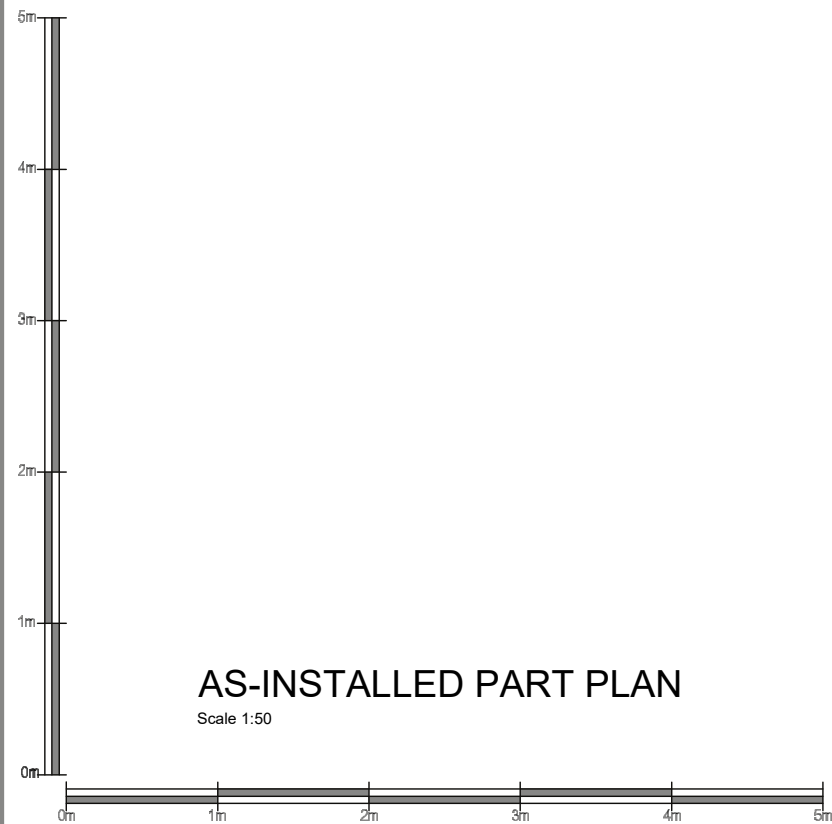
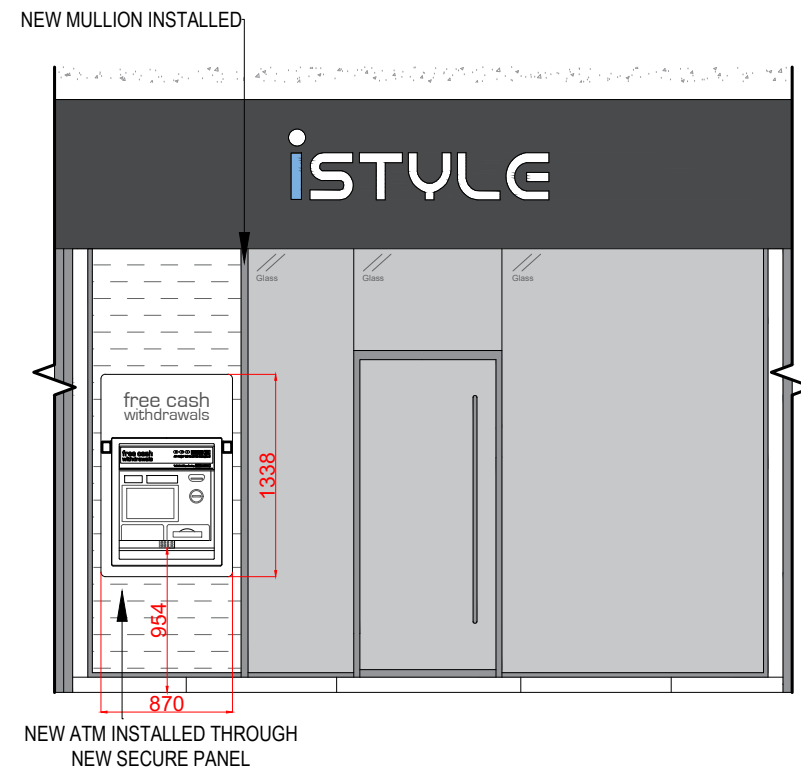


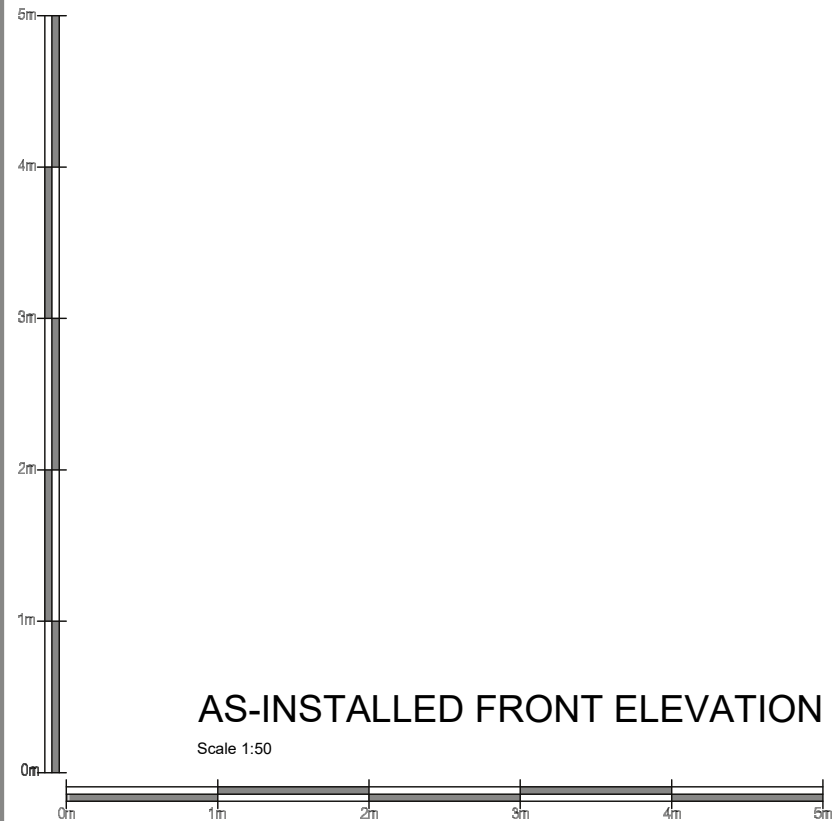

Date:	Comments:	By:
-------	-----------	-----

GENERAL NOTES:
1) All dimensions in millimeters unless otherwise stated.

Site:
York Street Mini Market,
75 YORK STREET,
HEYWOOD,
OL10 4NR

Drawing Title:
As-Installed Plan and Elevation

Ref: T020851_AI	Date: 13/04/2022	Rev:
Scale: 1:50	Paper: A3	Date Rev: