





Original plinth replicated




Glass balustrade

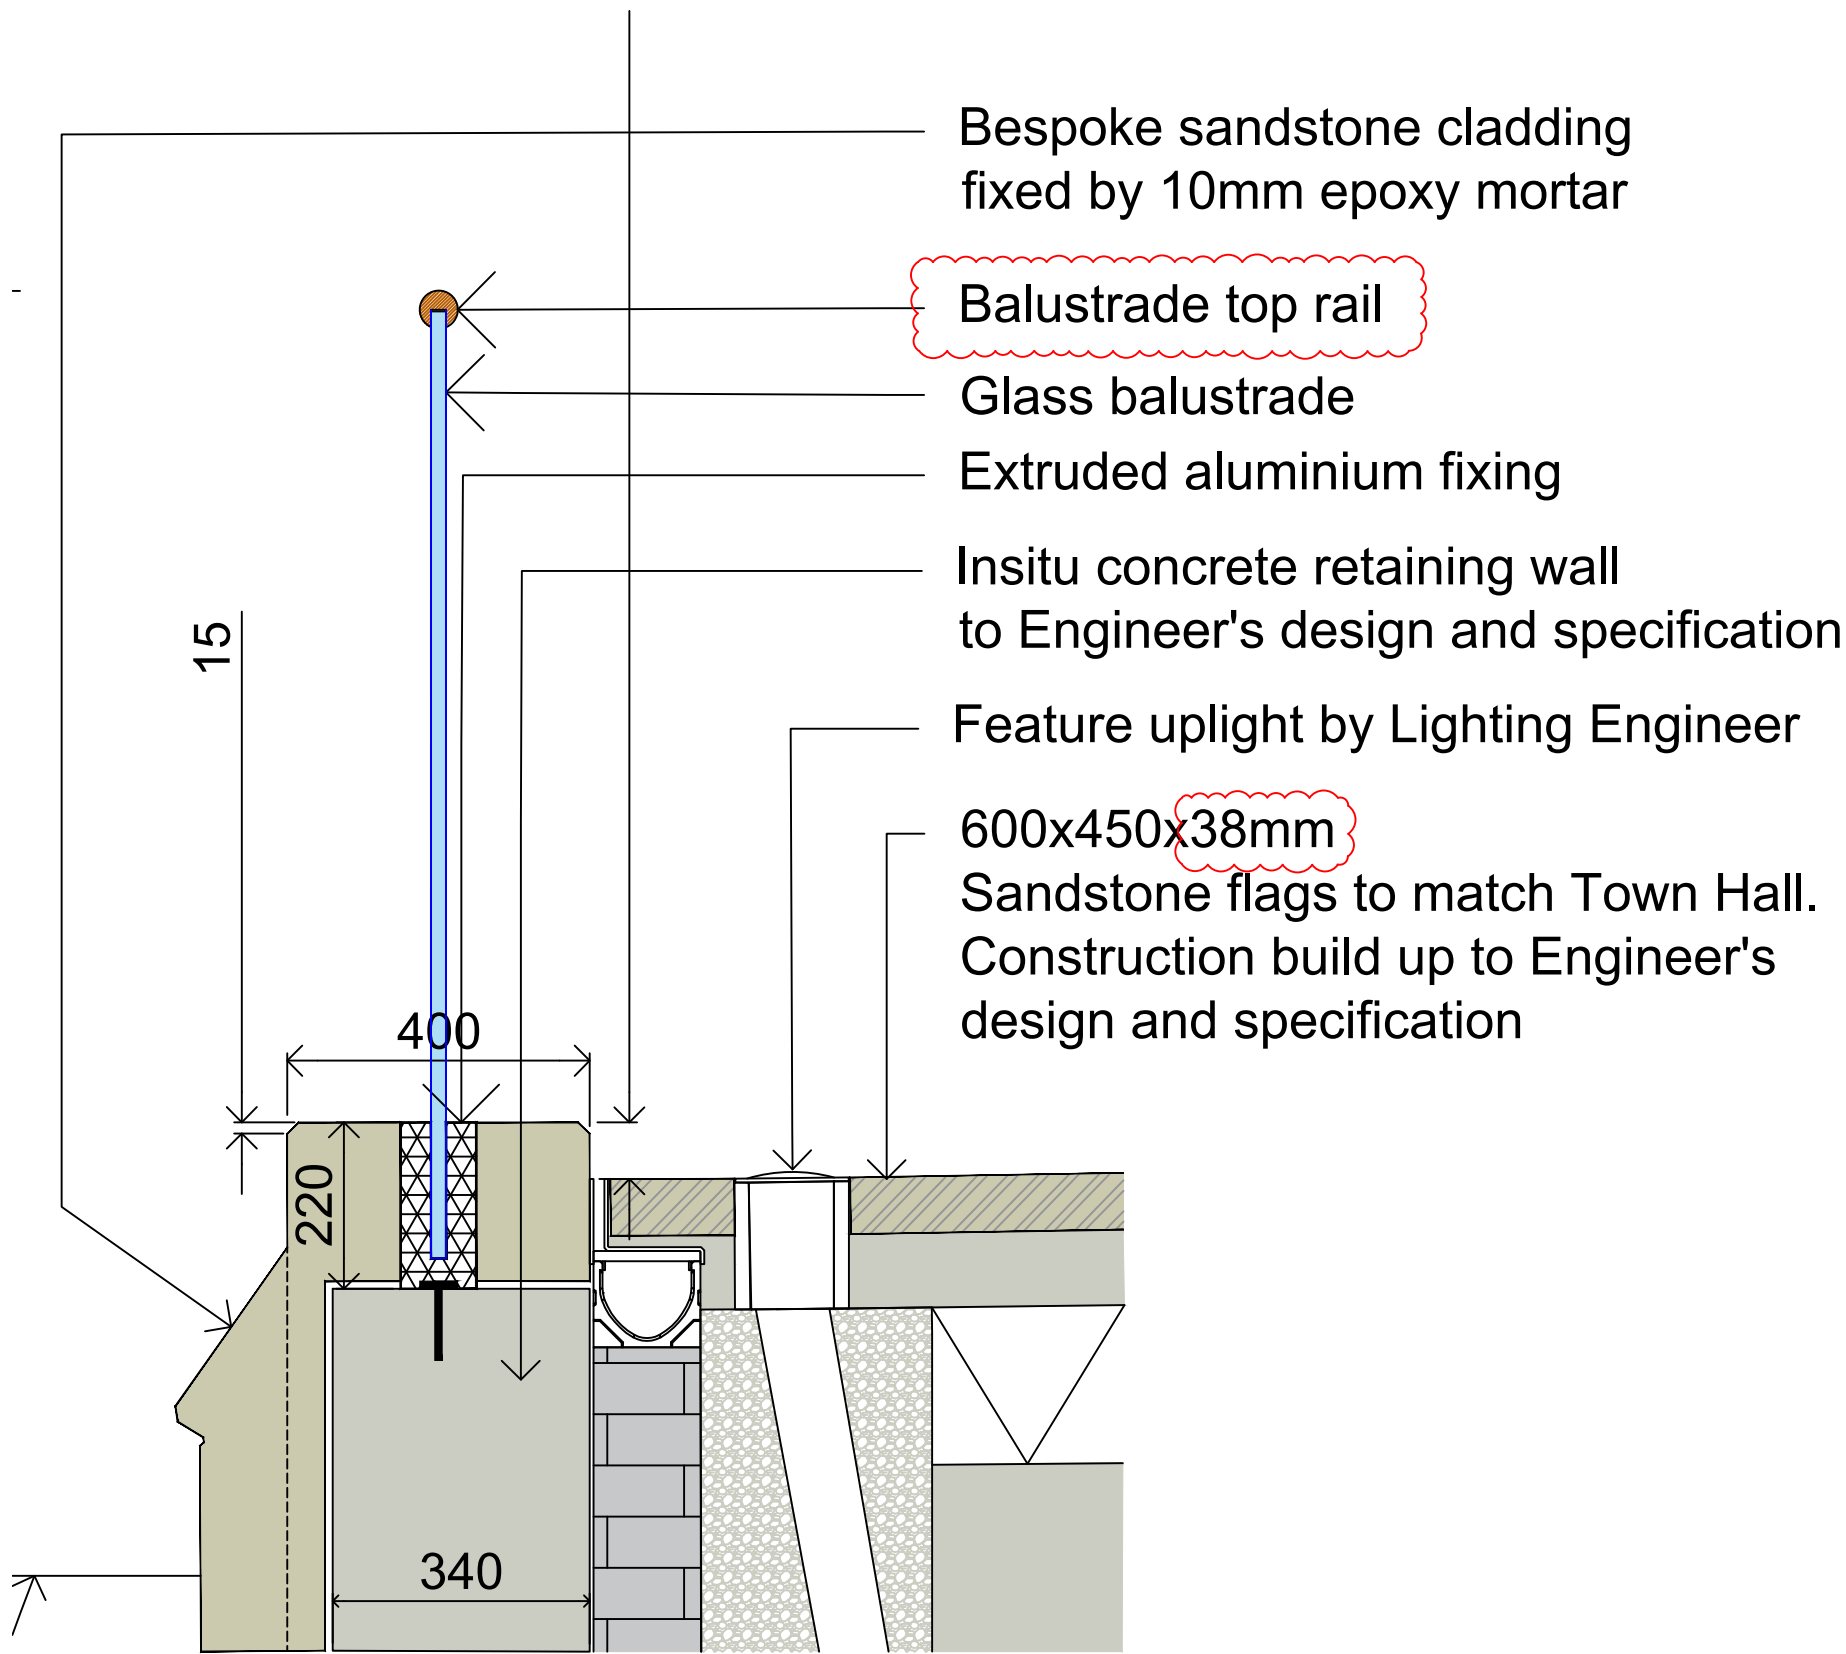

Proposed Retaining Wall with Plinth Detail

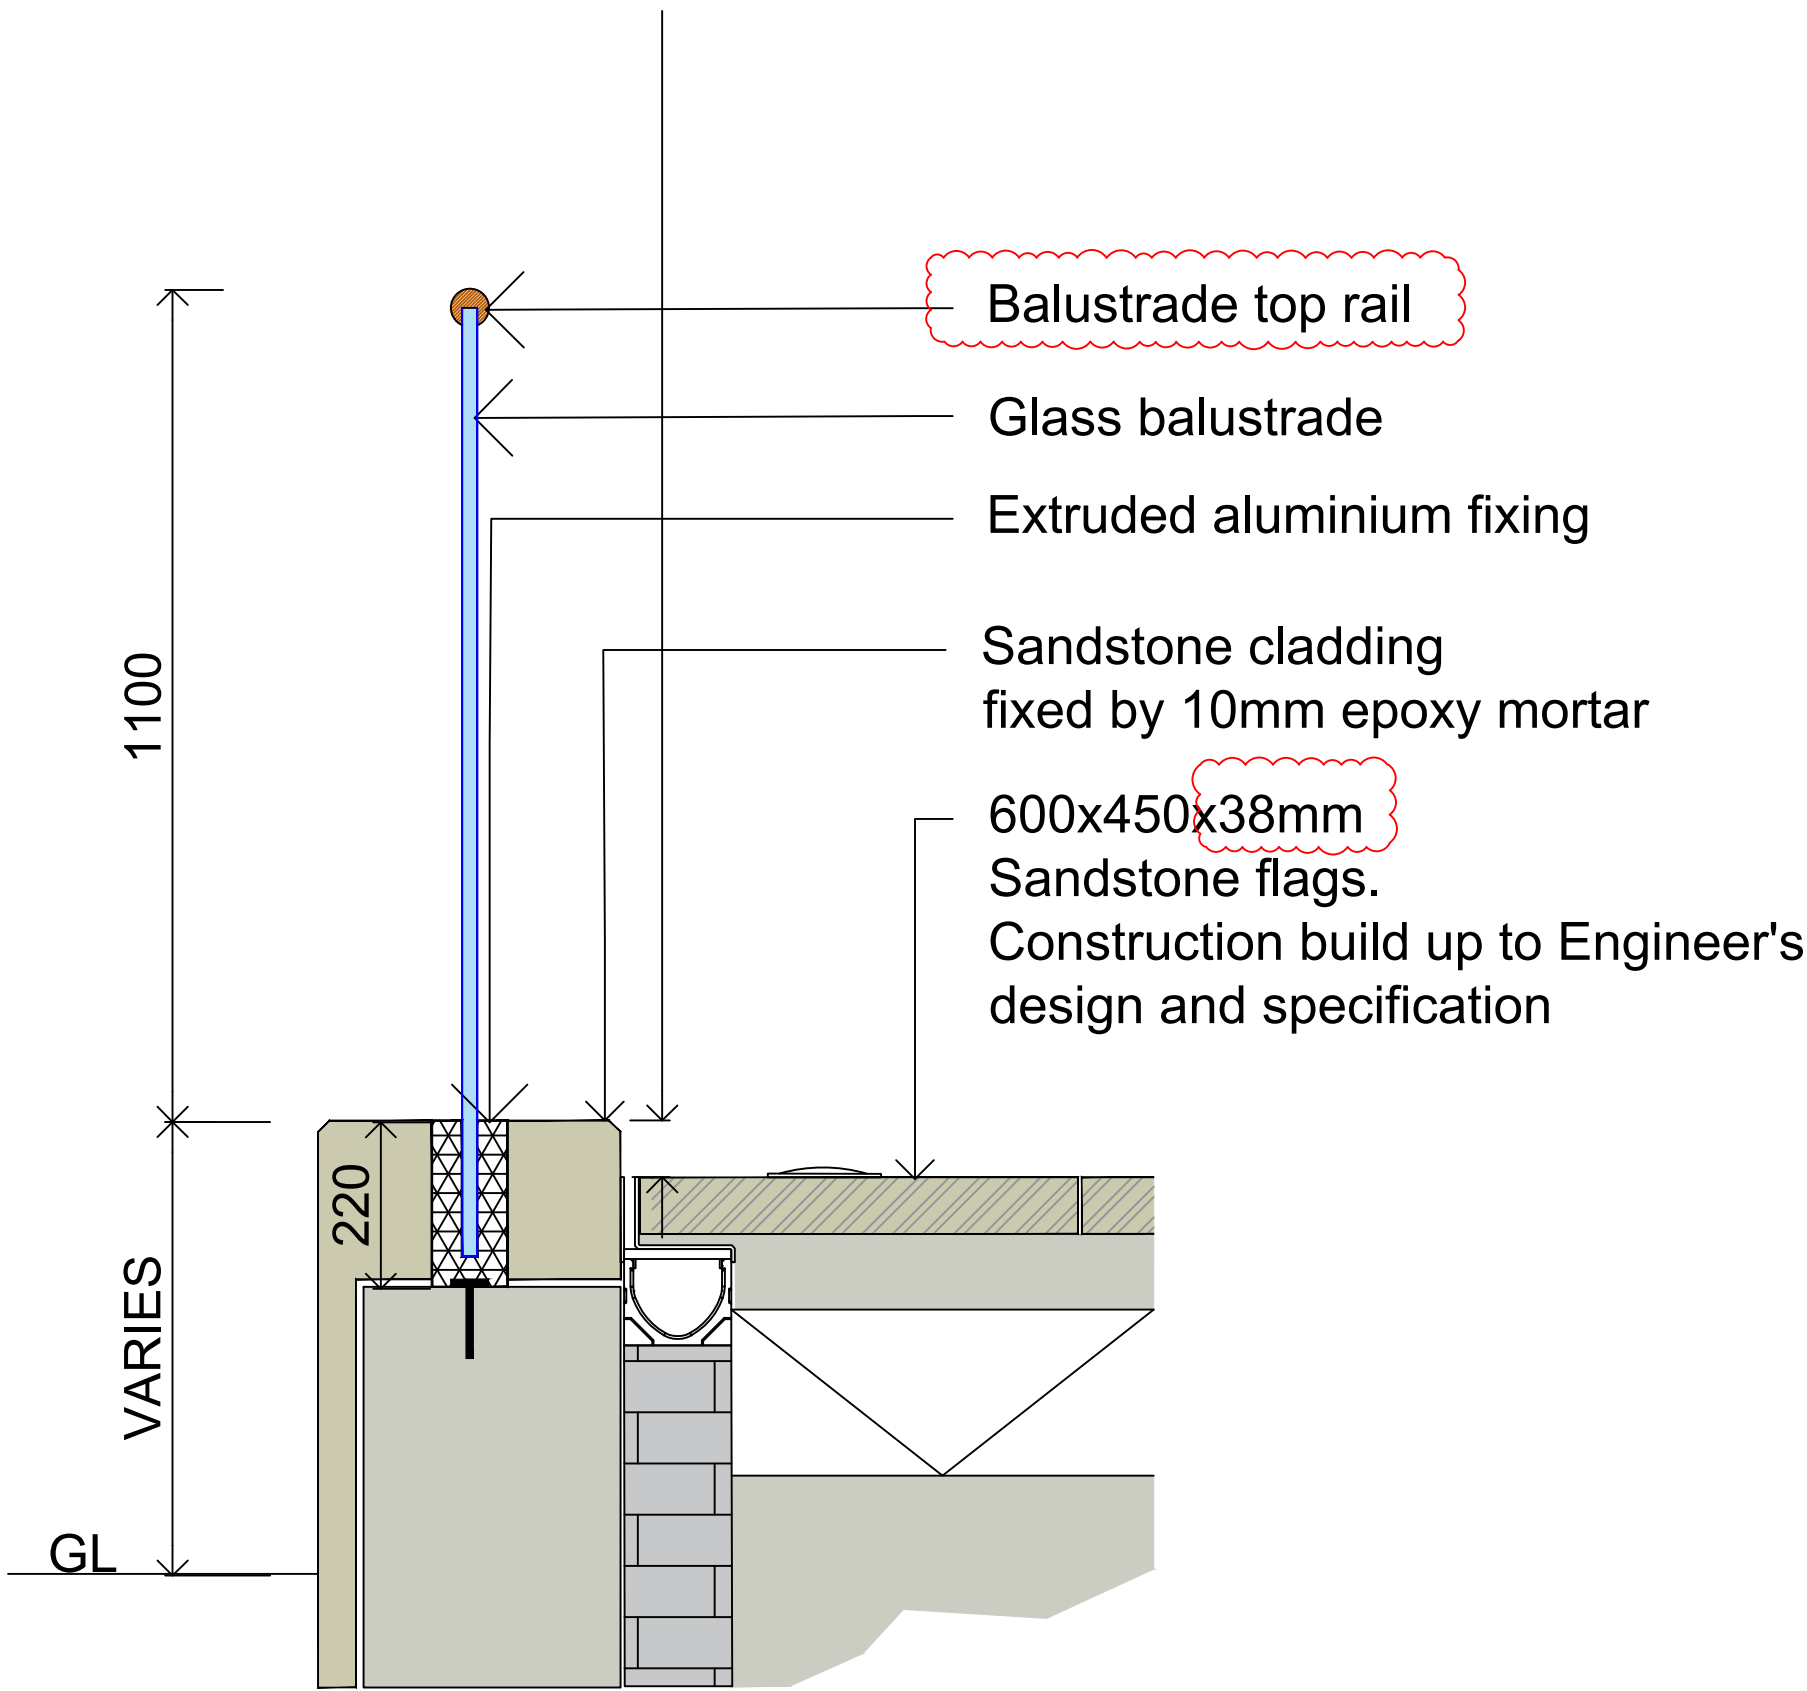

Proposed Retaining Wall without Plinth Detail

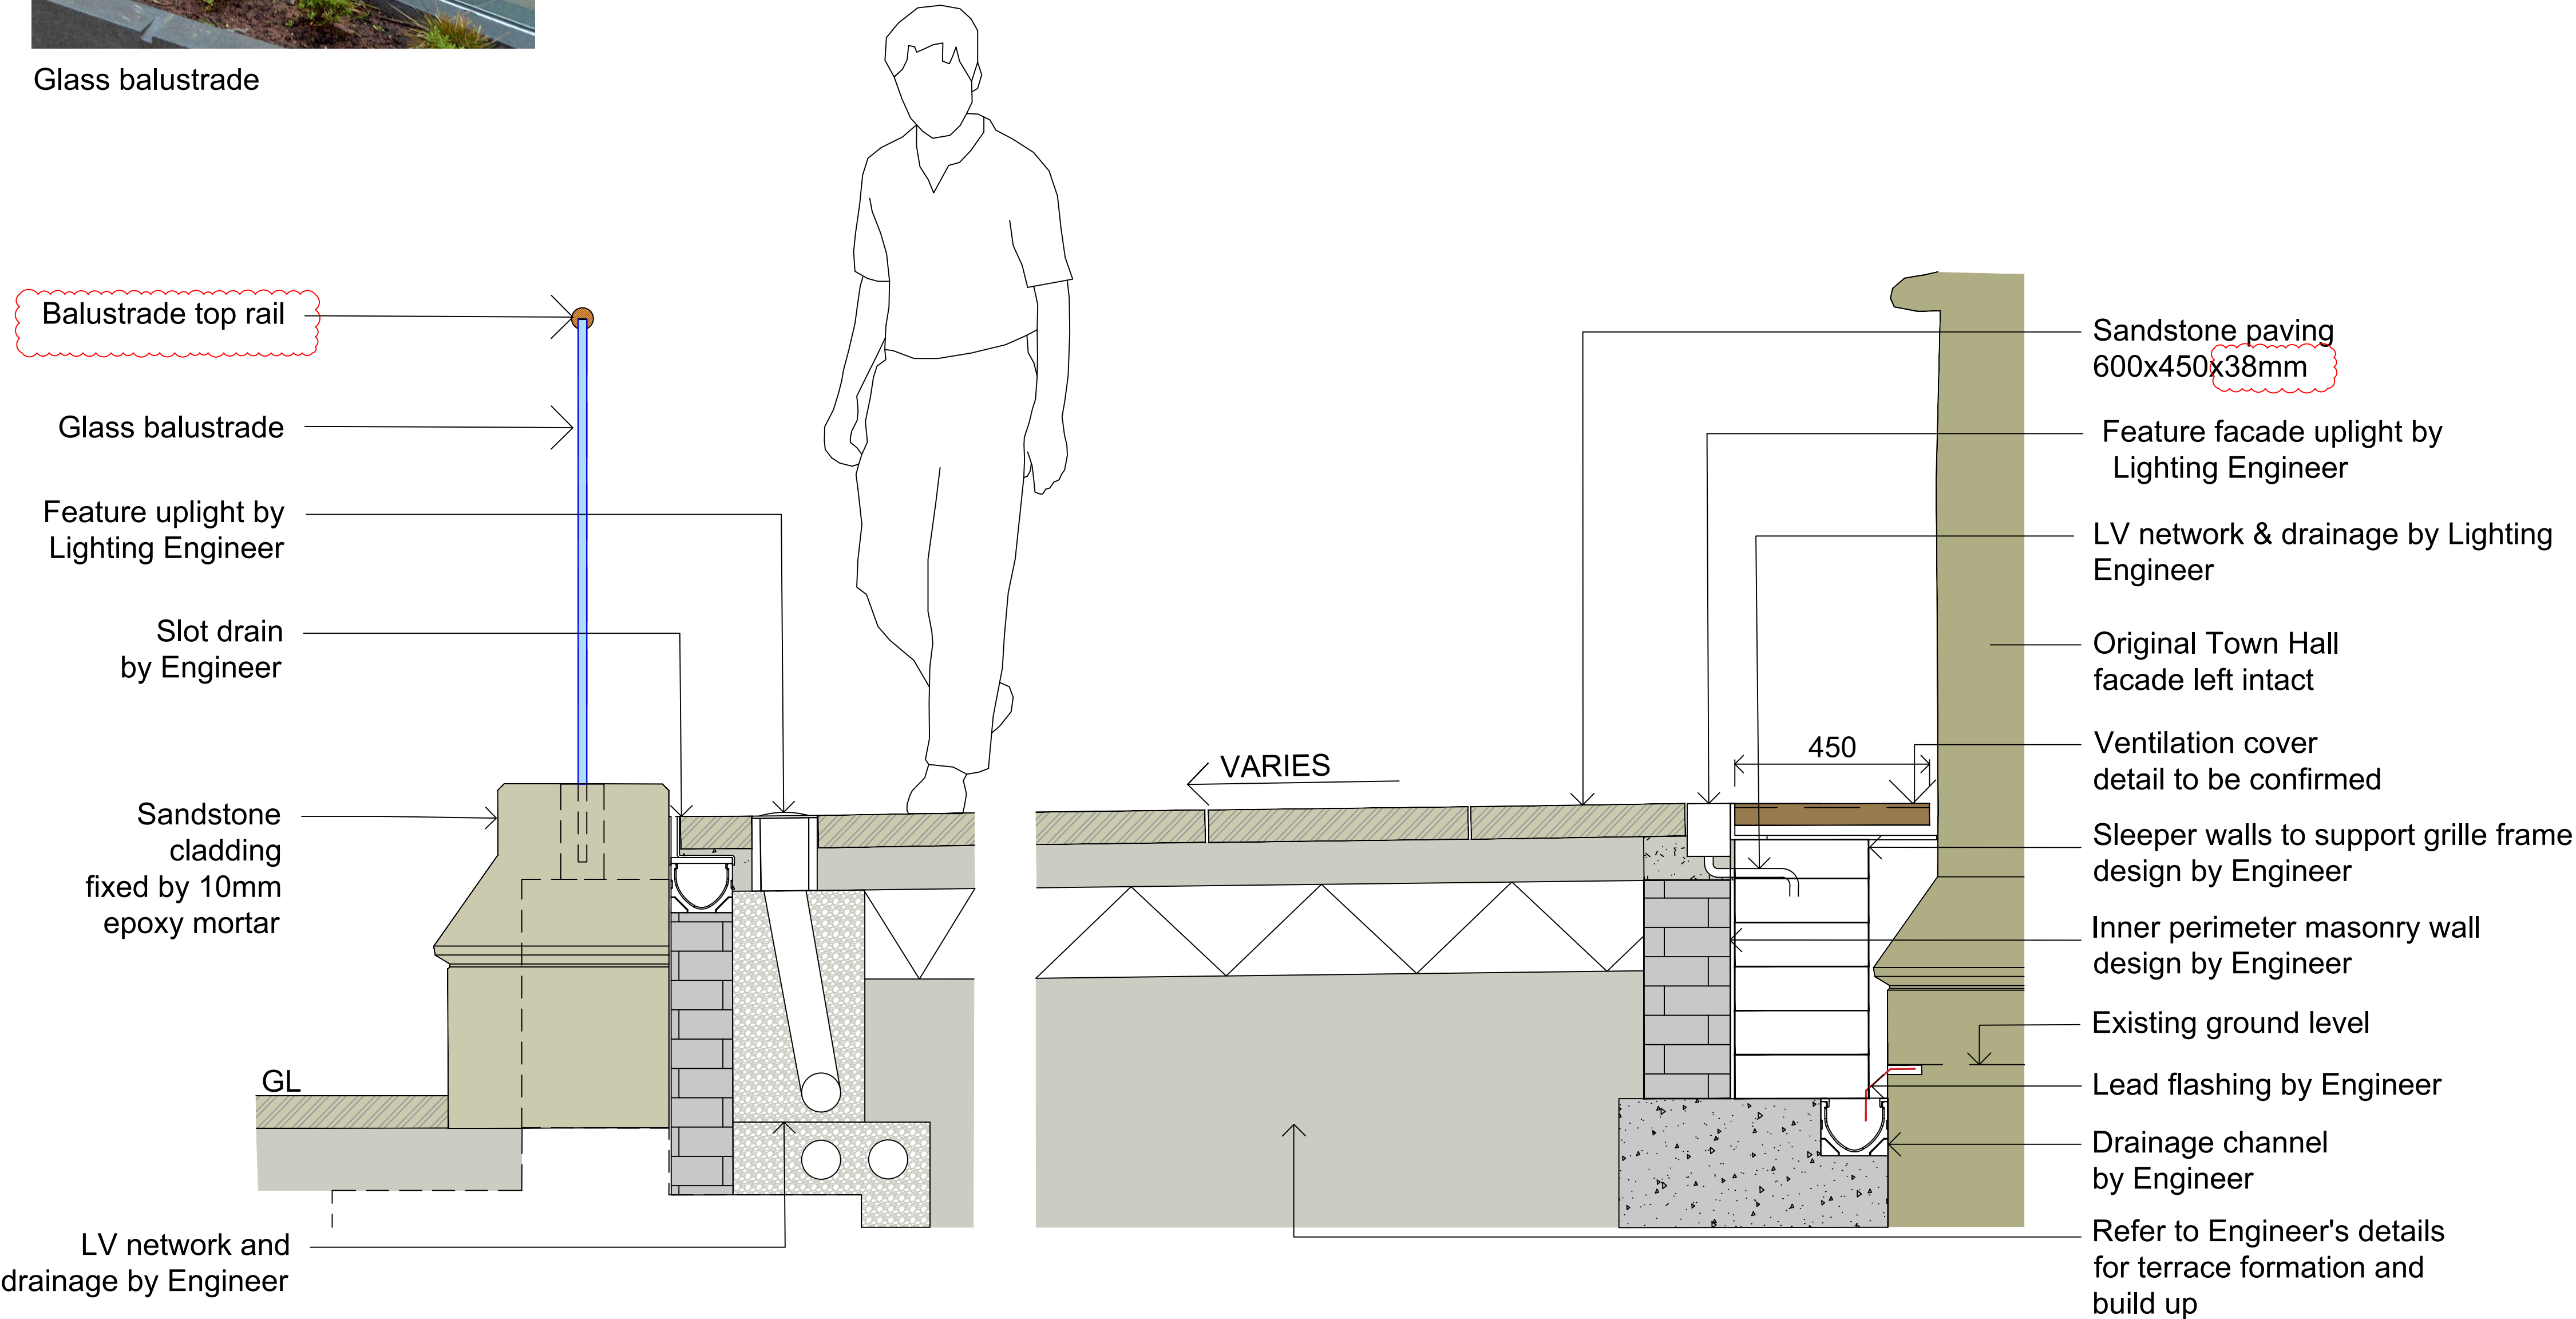

rev	details	by	date
00	Issued for information	KM	03/03/2020
01	General design development	JF	20/03/2020
02	Upstand and balustrade alterations	KM	22/04/2020
03	Co-ordinated with Engineer's details	KM	19/05/2020
04	Updated and issued for costing purposes	KM	20/11/2020
05	Added falls and slot drain. Lighting bollard replaced for in-ground uplight.	MS	14/09/2021
06	Inner wall thickness reduced	JF	21/09/2021
07	Outer wall upstand amended	MS	04/10/2021
08	Lead flashing added	MS	08/10/2021
09	Outer Wall capping height added	MS	14/10/2021
10	Details updated to match Engineer's design	MS	12/11/2021
11	Facade uplight detail updated	MS	18/11/2021
12	Issued for construction following VE updates	MS	14/01/2022
13	Balustrade detail updated	MS	25/01/2022
14	Terrace paving thickness reduced to 38mm. Annotations amended	JF	21.11.22

- Notes
1. Do not scale from drawing, use figured dimensions only.
 2. All dimensions to be checked onsite.
 3. This drawing to be read in conjunction with all other Gillespies drawings and specifications.

Ordnance Information shown is reproduced from Ordnance Survey material with the permission of Ordnance Survey on behalf of the Controller of Her Majesty's Stationary Office (© Crown Copyright. Unauthorised reproduction infringes Crown Copyright and may lead to prosecution or civil proceedings. License No. 1000 17362)

Project title
Rochdale Town Hall Square

Drawing title
Terraces
Wall Details

Drawing status
CONSTRUCTION

Scale
1:10@A1

Drwn
JF

Date
20/03/2020

Chk'd
WC

Rev

Drawing number
P11511-00-001-GIL-0302

14

© copyright GILLESPIES LLP. All rights reserved

Client
Rochdale Borough Council

Rochdale Borough Council
Number One Riverside
Smith Street
Rochdale
OL16 1AX

Gillespies
For Record Drawing

GILLESPIES
Westgate House, 44 Hale Road, W14 2EX
P: 0161 928 7715 E: design.manchester@gillespies.co.uk