



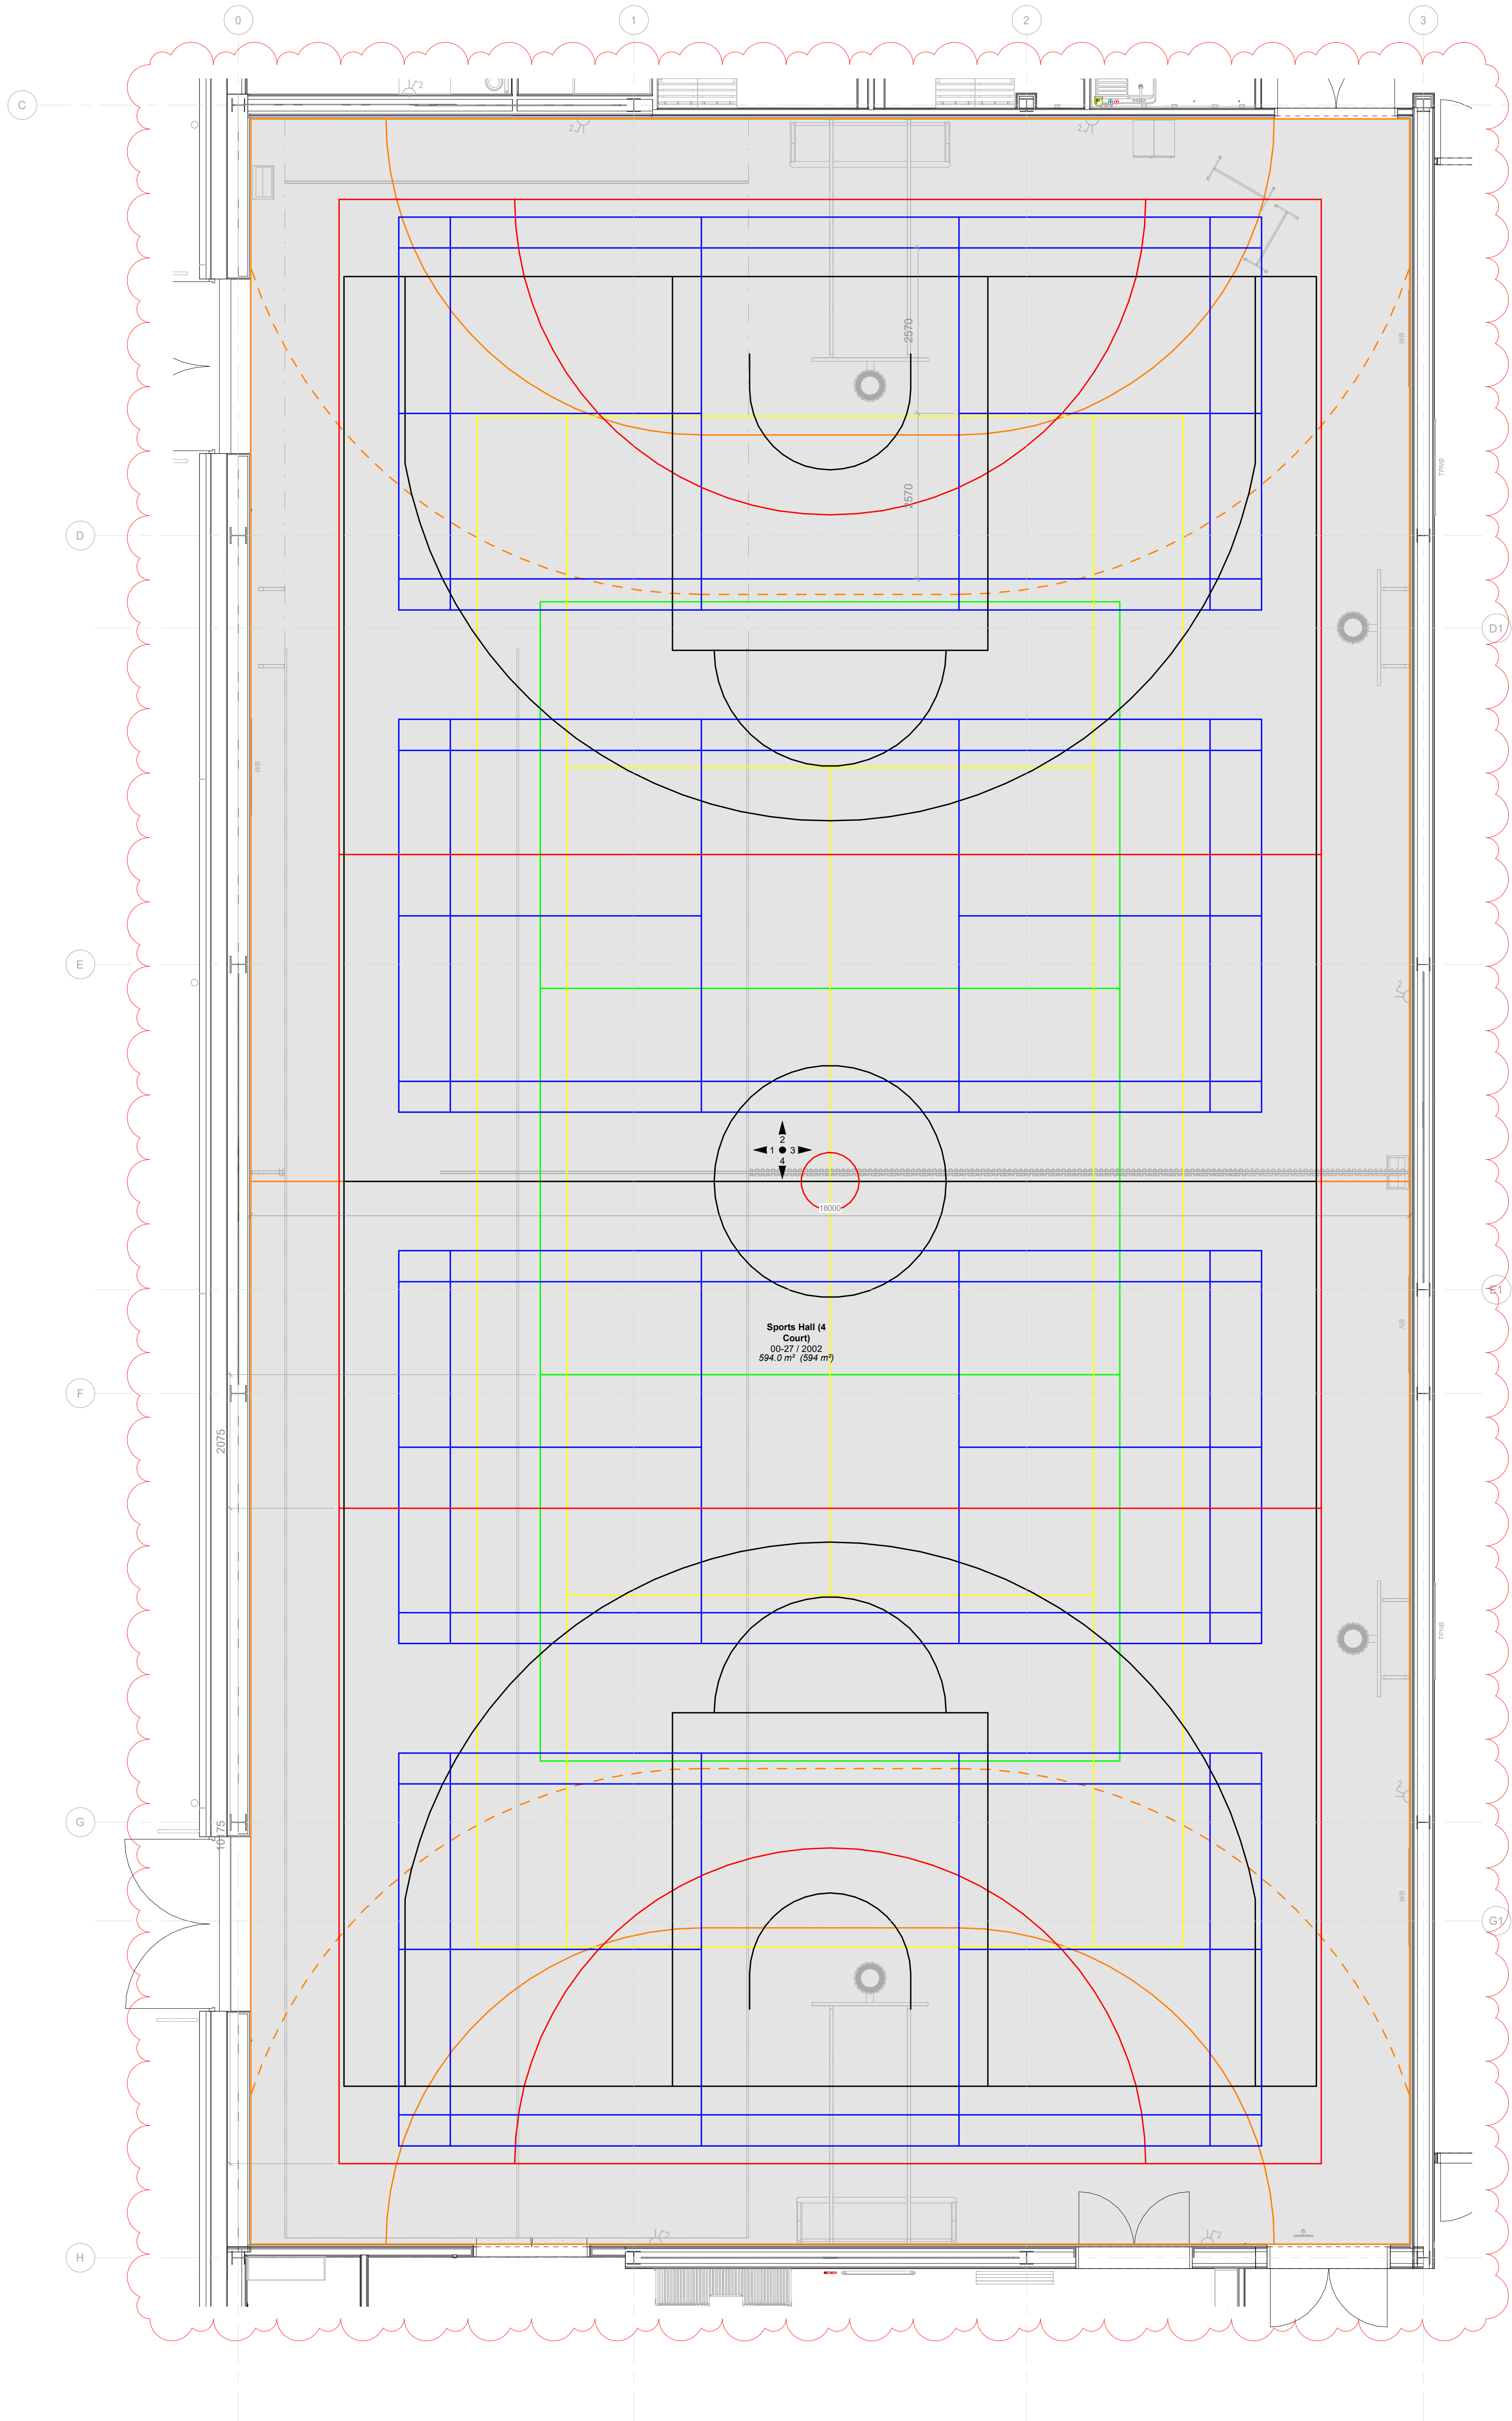


1 40 - Sports Hall Plan
1 : 50

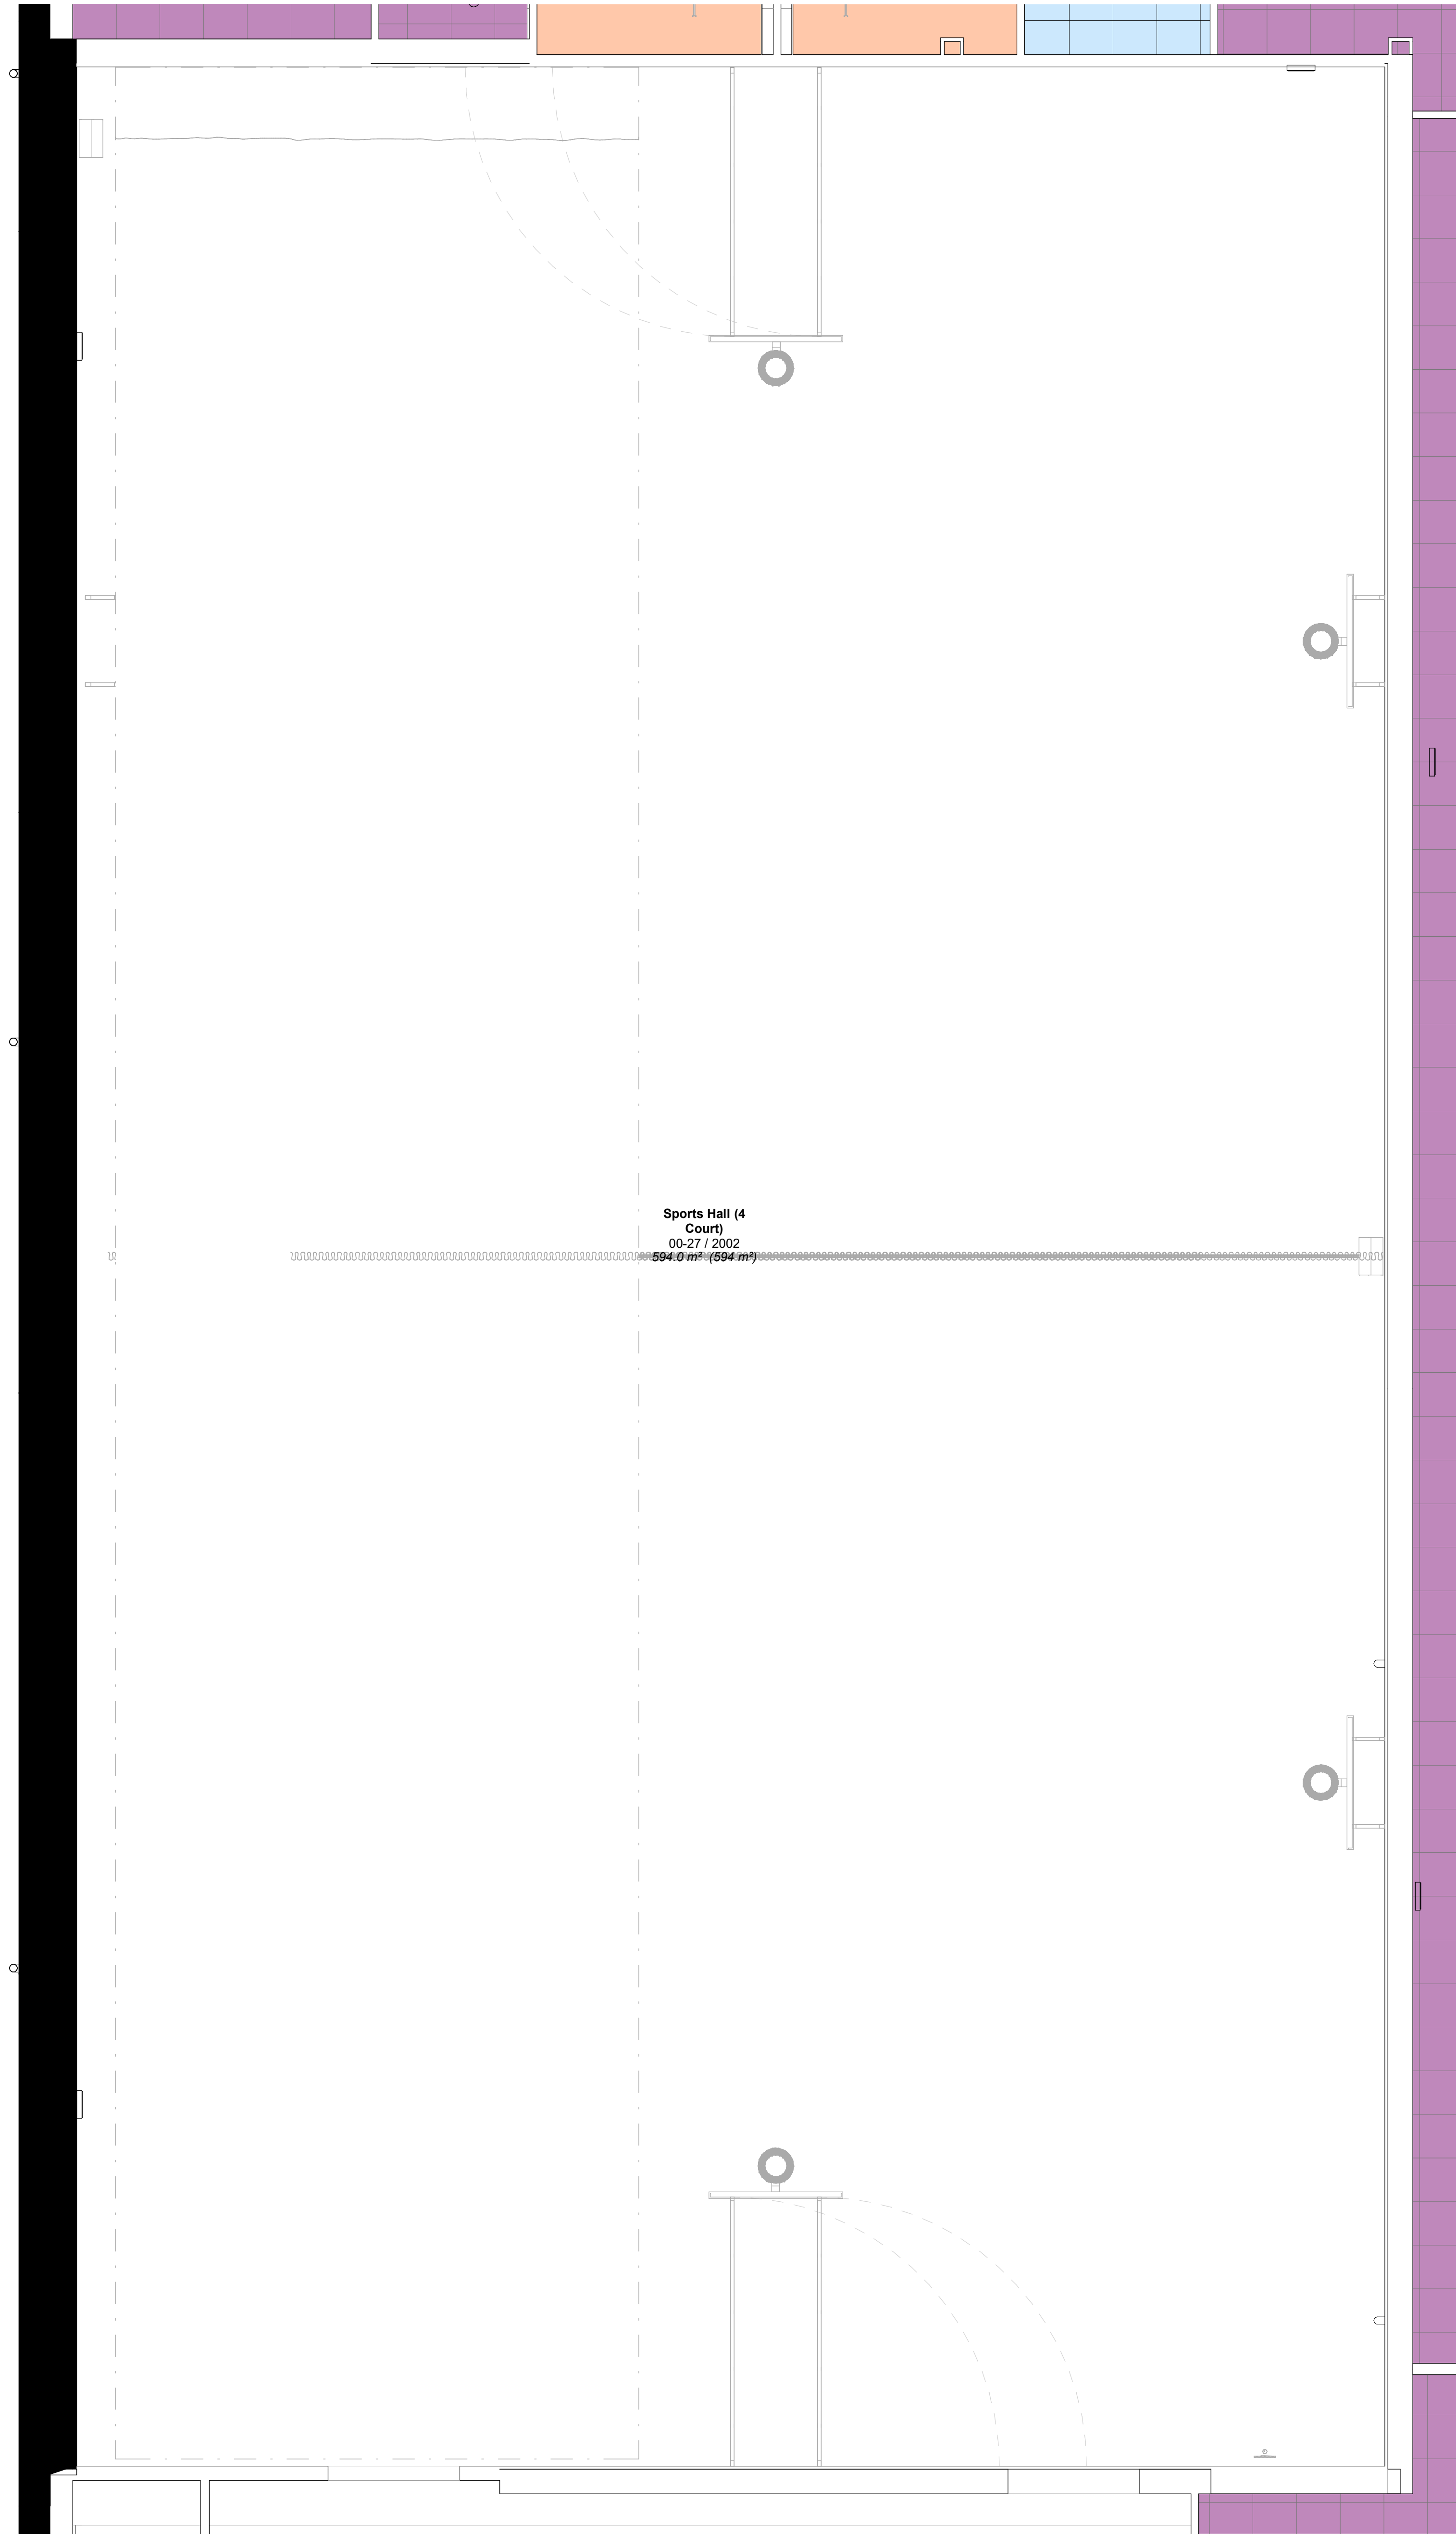

2 40 - Sports Hall CP
1 : 50

Notes :
1. This drawing should not be scaled, figured dimensions only to be taken
2. should any discrepancies be found with this drawing, please inform this office.
3. Copyright of this drawing is owned by JM Architects.
Structural information indicative only. To be confirmed by Structural Engineer.

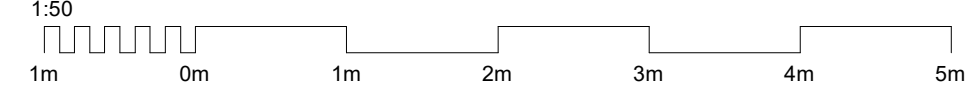

- Handball Court (Orange Lines).
Court Dimensions: 18 x 33m
- Volleyball Court (Green Lines).
Court Dimensions: 9 x 18m
- Tennis Court (Yellow Lines).
Court Dimensions: 10.97 x 23.77m
- Netball Court (Red Lines).
Court Dimensions: 15.25 x 30.5m
- Basketball Court (Black Lines).
Court Dimensions: 15 x 28m
- Badminton Court (White Lines).
Court Dimensions: 6.1 x 13.4m

Rev	Description	Date	Drawn By	Check By
P01	Line Workings added to Sports Hall	09/12/2022	SWR	PM
P02	Final model and M&E notes updated	11/11/2022	SWR	SWR
P03	Issued for Contractor Proposals	02/02/2023	SWR	PM

Project: Newhouse Academy
Title: 0-027 Sports Hall Plans
Client: Morgan Sindall
Proposed: Contractor's Proposals
Drawing Number: SRP1019-JMA-01-00-DR-A-4033

3A/54 Princess St
Manchester
M1 6HS
T : 0161 200 6300
man@jmarchitects.net
www.jmarchitects.net

Project	Originator	Version	Level	Type	Role	Number	Status	Revision	AKA Project Number
SRP1019-JMA	01-00	DR-A	4033	D2	P03	6945			