


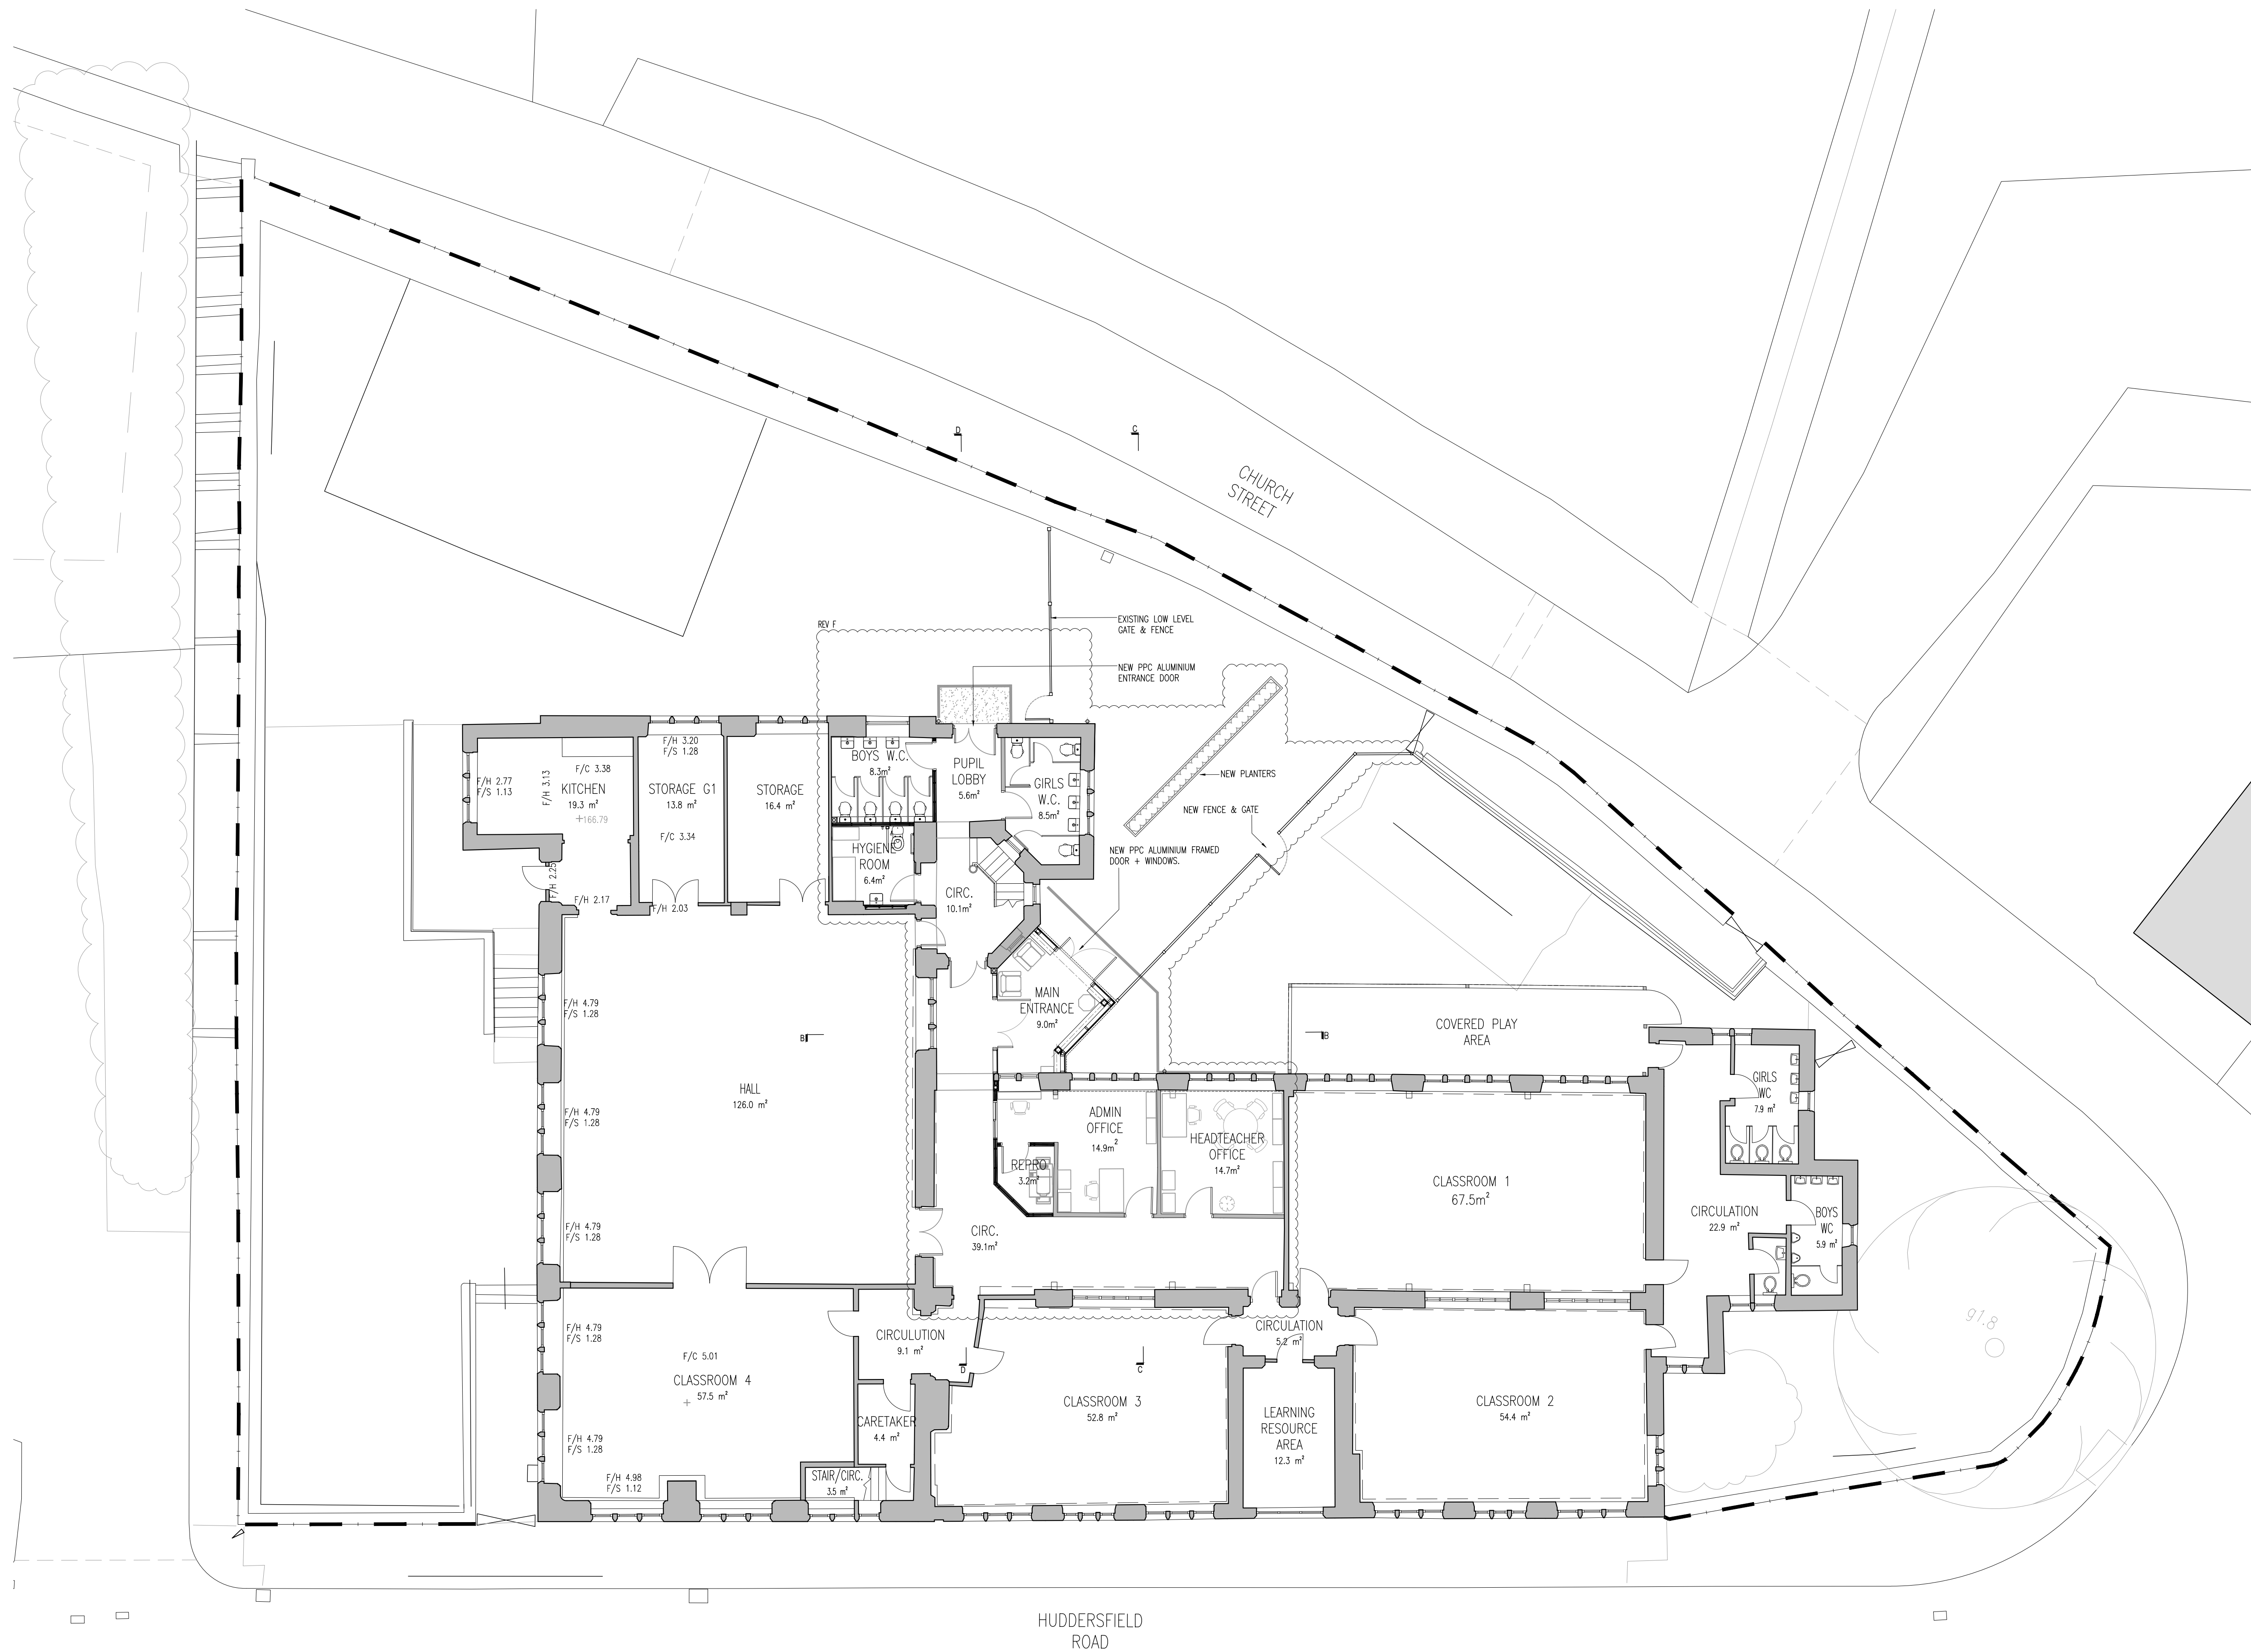

Schedule of Accommodation

Existing Gross Internal Floor Area:

Ground Floor: 647.5 m²

F	UPDATED SCOPE OF WORKS, ENTRANCES SWAPPED, LABELLING UPDATED.	20.05.24	RB	MDM
E	UPDATED TO SHOW FULL EXTENT OF THE GROUND FLOOR, AREAS OF WORK REMOVED.	25.10.23	RB	MDM
D	LAYOUT UPDATED.	07.09.23	RB	MDM
C	LAYOUT UPDATED.	04.07.23	SM	MT
B	LAYOUT UPDATED.	26.06.23	SM	MT
A	LAYOUT UPDATED.	26.06.23	SM	MDM
Rev	Description	Date	By	CHK

Status	Purpose for Issue
Planning ☒ Tender ☐	☐ As Built ☒ PLANNING
Construction ☐	

Client
THE GOVERNORS OF ST. THOMAS' C. OF E. PRIMARY SCHOOL, NEWHEY, ROCHDALE

Contract
PROPOSED NEW ENTRANCE, ADMIN BLOCK STAFF AREAS + TOILETS

Drawing
PROPOSED GROUND FLOOR PLAN

bateandtaylor
architects
www.bate-taylor.co.uk

macintosh house
cambridge street
manchester m1 5gg
tel: 0161 236 0999
fax: 0161 236 0404
mail@bate-taylor.co.uk

Drawing No.	MH1393-09	Revision	F
Scales	1:100 @ A1	Date	SEPT '23
Drawn	RB	Checked	MDM

This drawing is the copyright of the Architect and may not be reproduced without licence.
DO NOT scale from this drawing.