


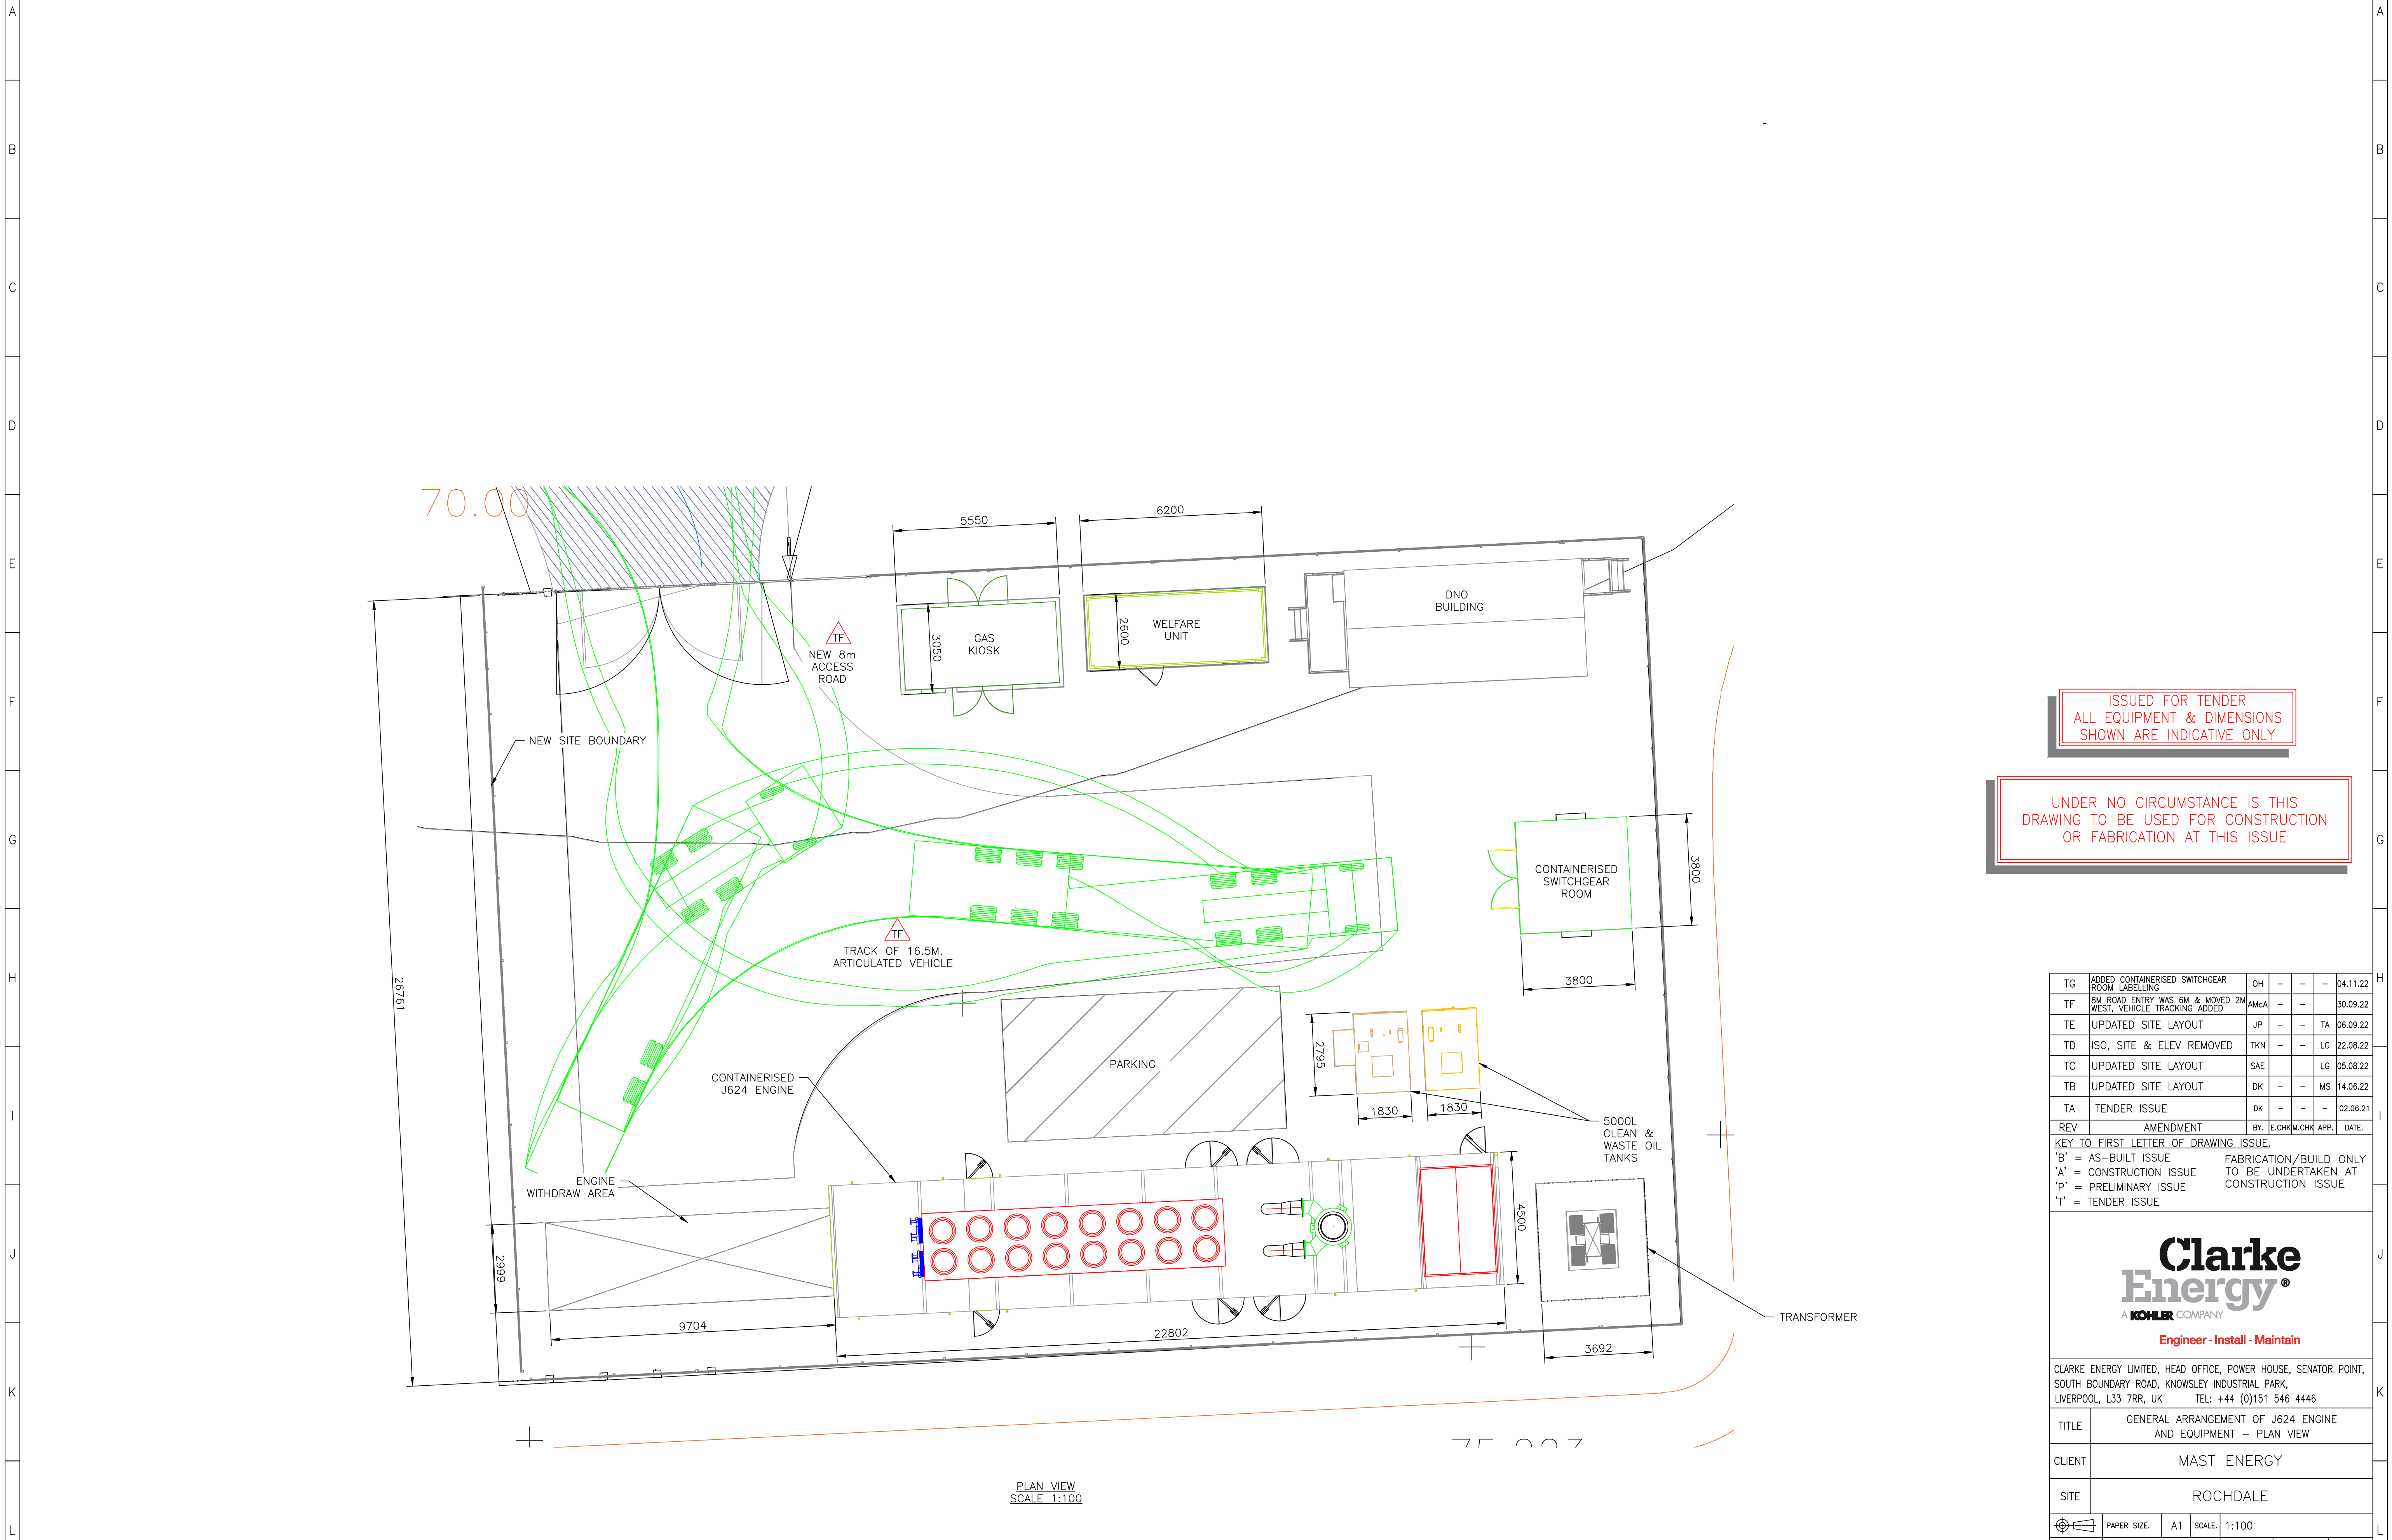

ISSUED FOR TENDER
ALL EQUIPMENT & DIMENSIONS
SHOWN ARE INDICATIVE ONLY

UNDER NO CIRCUMSTANCE IS THIS
DRAWING TO BE USED FOR CONSTRUCTION
OR FABRICATION AT THIS ISSUE

TG	ADDED CONTAINERISED SWITCHGEAR ROOM LABELLING	OH	-	-	04.11.22
TF	8M ROAD ENTRY WAS 6M & MOVED 2M WEST. VEHICLE TRACKING ADDED	AMcA	-	-	30.09.22
TE	UPDATED SITE LAYOUT	JP	-	TA	06.09.22
TD	ISO, SITE & ELEV REMOVED	TKN	-	LG	22.08.22
TC	UPDATED SITE LAYOUT	SAE	-	LG	05.08.22
TB	UPDATED SITE LAYOUT	DK	-	MS	14.06.22
TA	TENDER ISSUE	DK	-	-	02.06.21
REV	AMENDMENT	BY: E.CHKM	CHK: APP.	DATE	
KEY TO FIRST LETTER OF DRAWING ISSUE.					
'B' = AS-BUILT ISSUE			FABRICATION/BUILD ONLY		
'A' = CONSTRUCTION ISSUE			TO BE UNDERTAKEN AT		
'P' = PRELIMINARY ISSUE			CONSTRUCTION ISSUE		
'T' = TENDER ISSUE					

Clarke Energy
A KOHLER COMPANY

Engineer - Install - Maintain

CLARKE ENERGY LIMITED, HEAD OFFICE, POWER HOUSE, SENATOR POINT,
SOUTH BOUNDARY ROAD, KNOWSLEY INDUSTRIAL PARK,
LIVERPOOL, L33 7RR, UK TEL: +44 (0)151 546 4446

TITLE	GENERAL ARRANGEMENT OF J624 ENGINE AND EQUIPMENT - PLAN VIEW				
CLIENT	MAST ENERGY				
SITE	ROCHDALE				
	PAPER SIZE.	A1	SCALE.	1:100	
DRAWN BY.	DANIEL K		DATE DRAWN.	02.06.21	ISSUE.
DRAWING No.	C5059-GA-001				TG

THIS ASSEMBLY OR PART MUST COMPLY WITH KOHLER SPECIFICATION "PEP-RML-001 RESTRICTED MATERIAL LIST"