




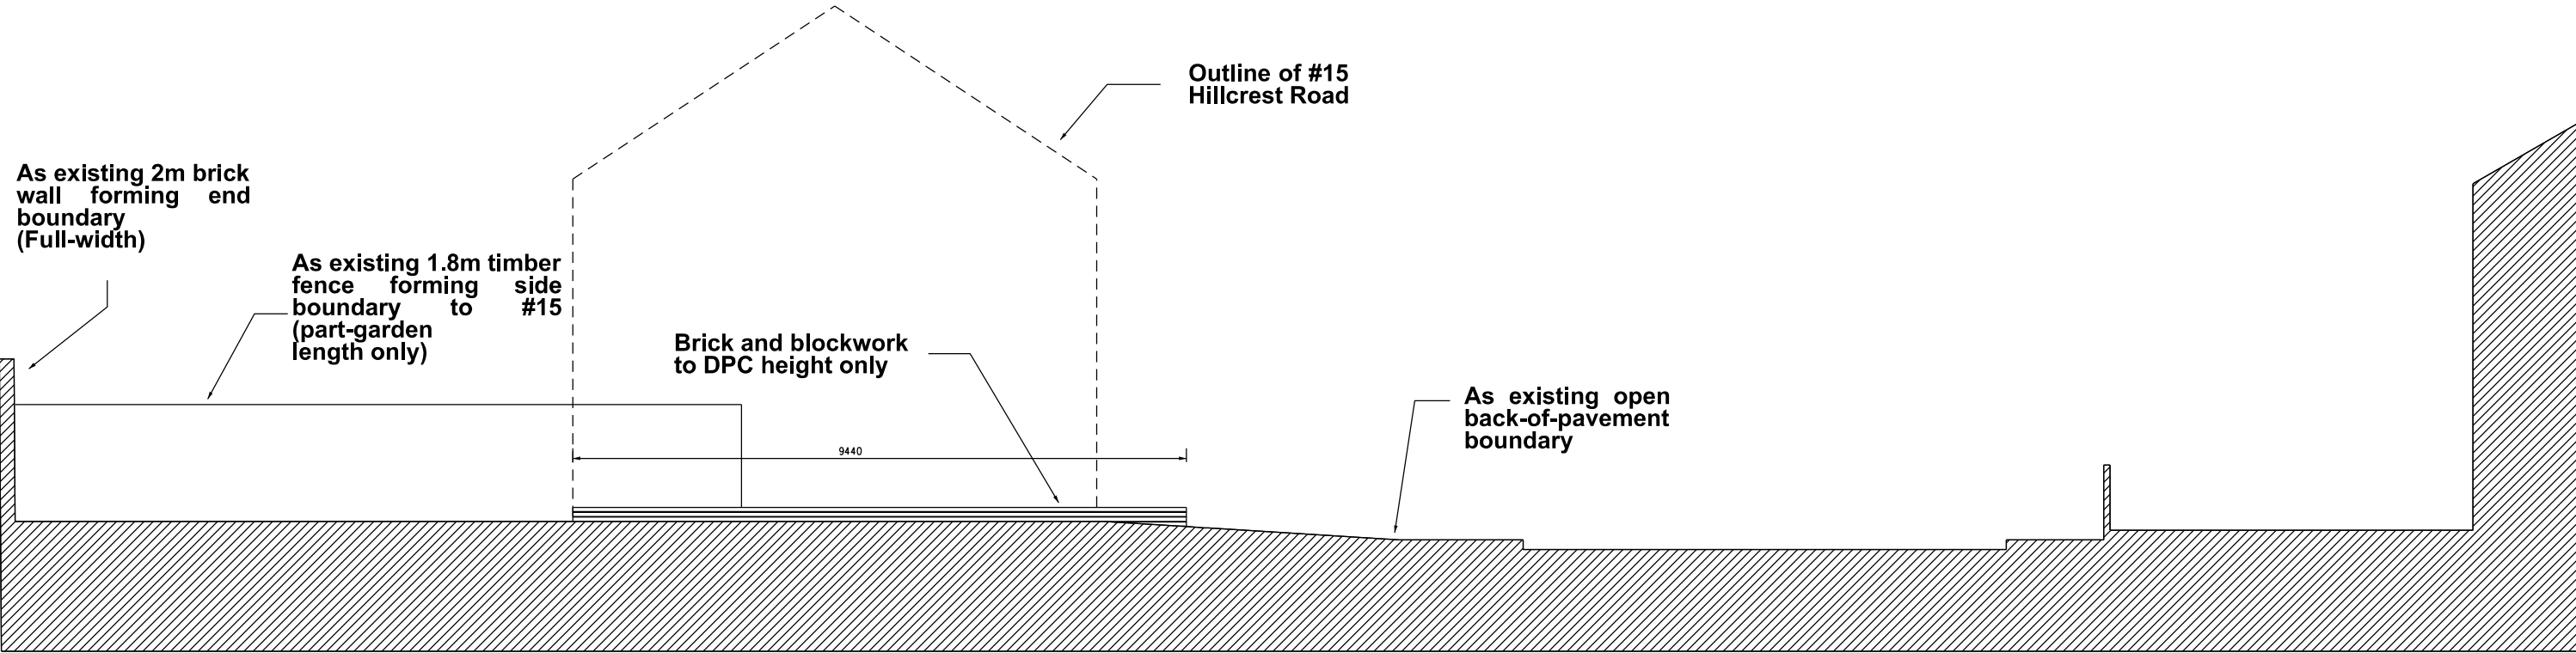

AS-BUILT SIDE ELEVATION (FACING #15 HILLCREST ROAD)

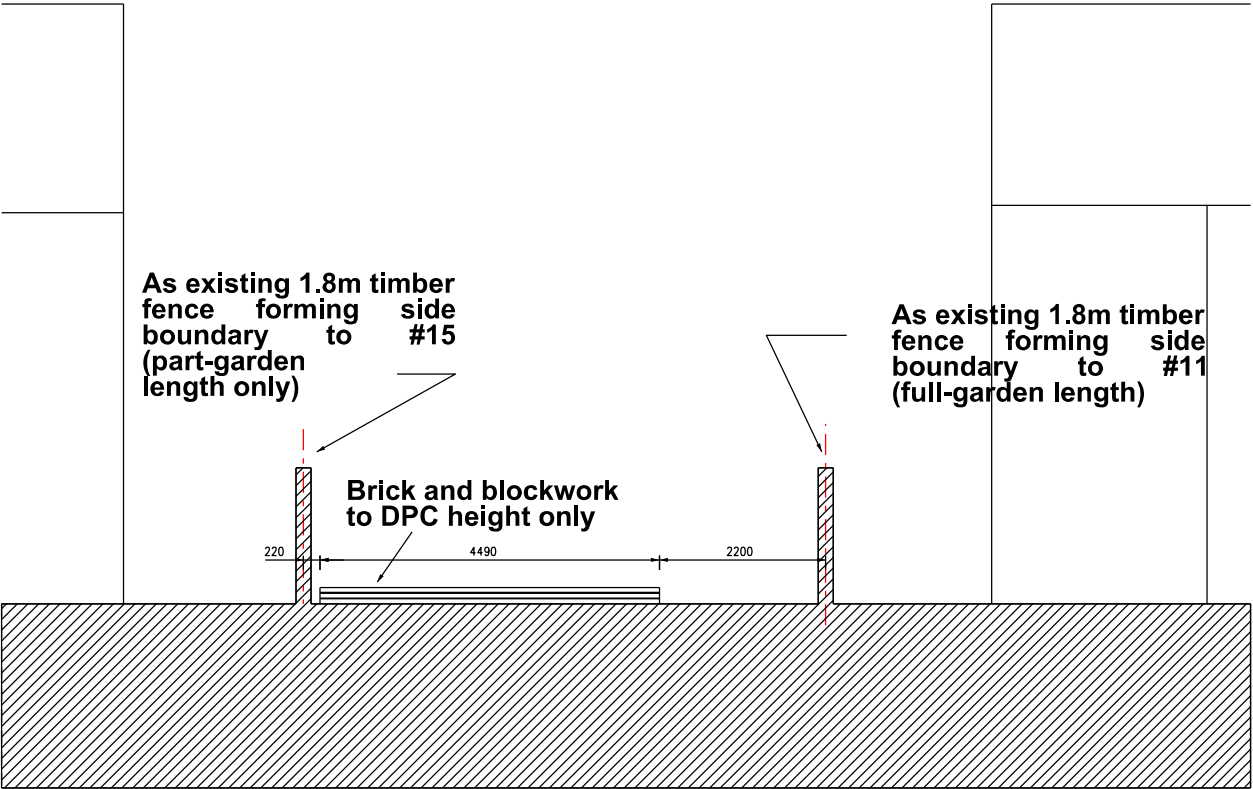

AS-BUILT REAR ELEVATION

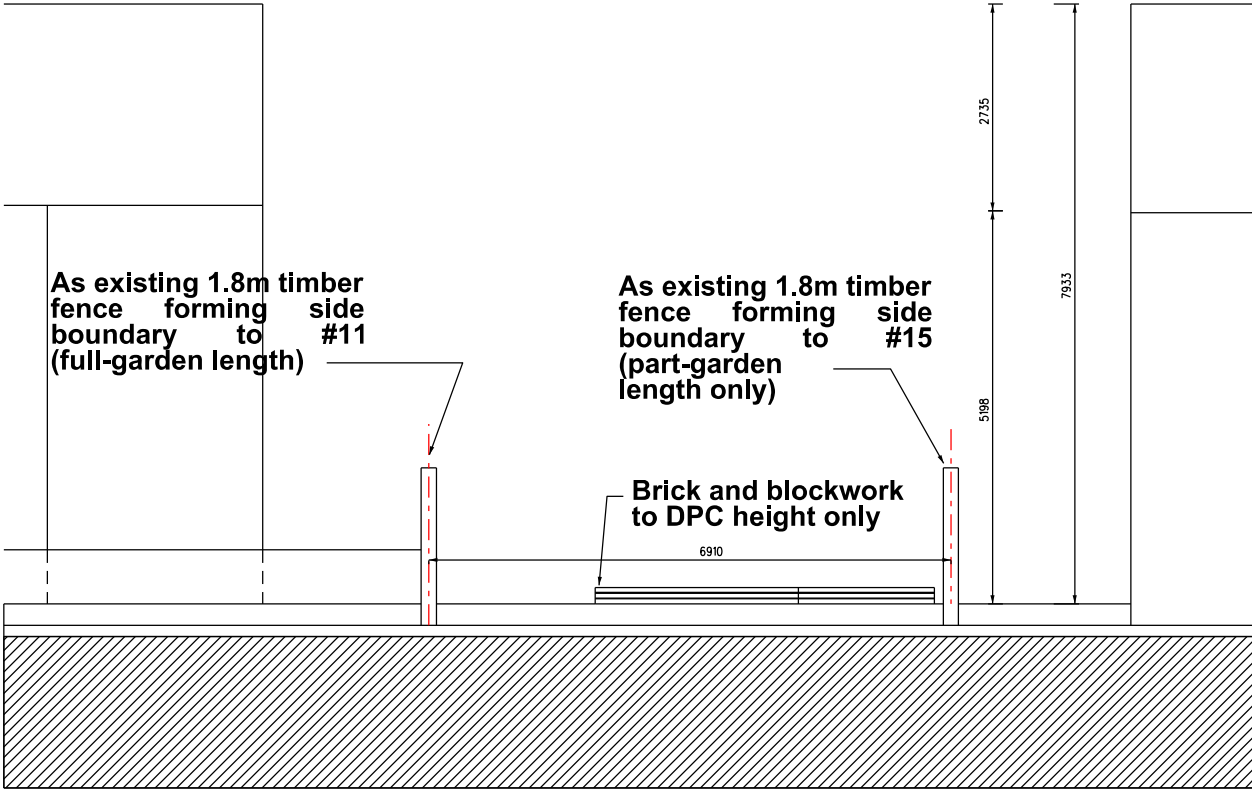


AS-BUILT FRONT ELEVATION TO HILLCREST ROAD

REVISIONS
Rev A: Planning Notes 16Jan23
Rev B: As built fence corrections 06Jul23

REVISION NOTES

PROJECT AND DETAILS:
Land adjacent 15 Hillcrest Road

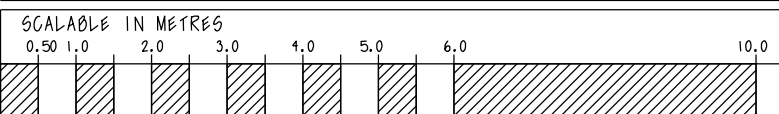

AT:
Rochdale, OL11 2QE

FOR:
L Wells

SCALE: 1:50 @ A1
1:100 @ A3

DRAWN: IB

DATE: 17 Nov 22

A B

DWG TITLE:
As Built Elevations

DWG NO:
499-PL04

