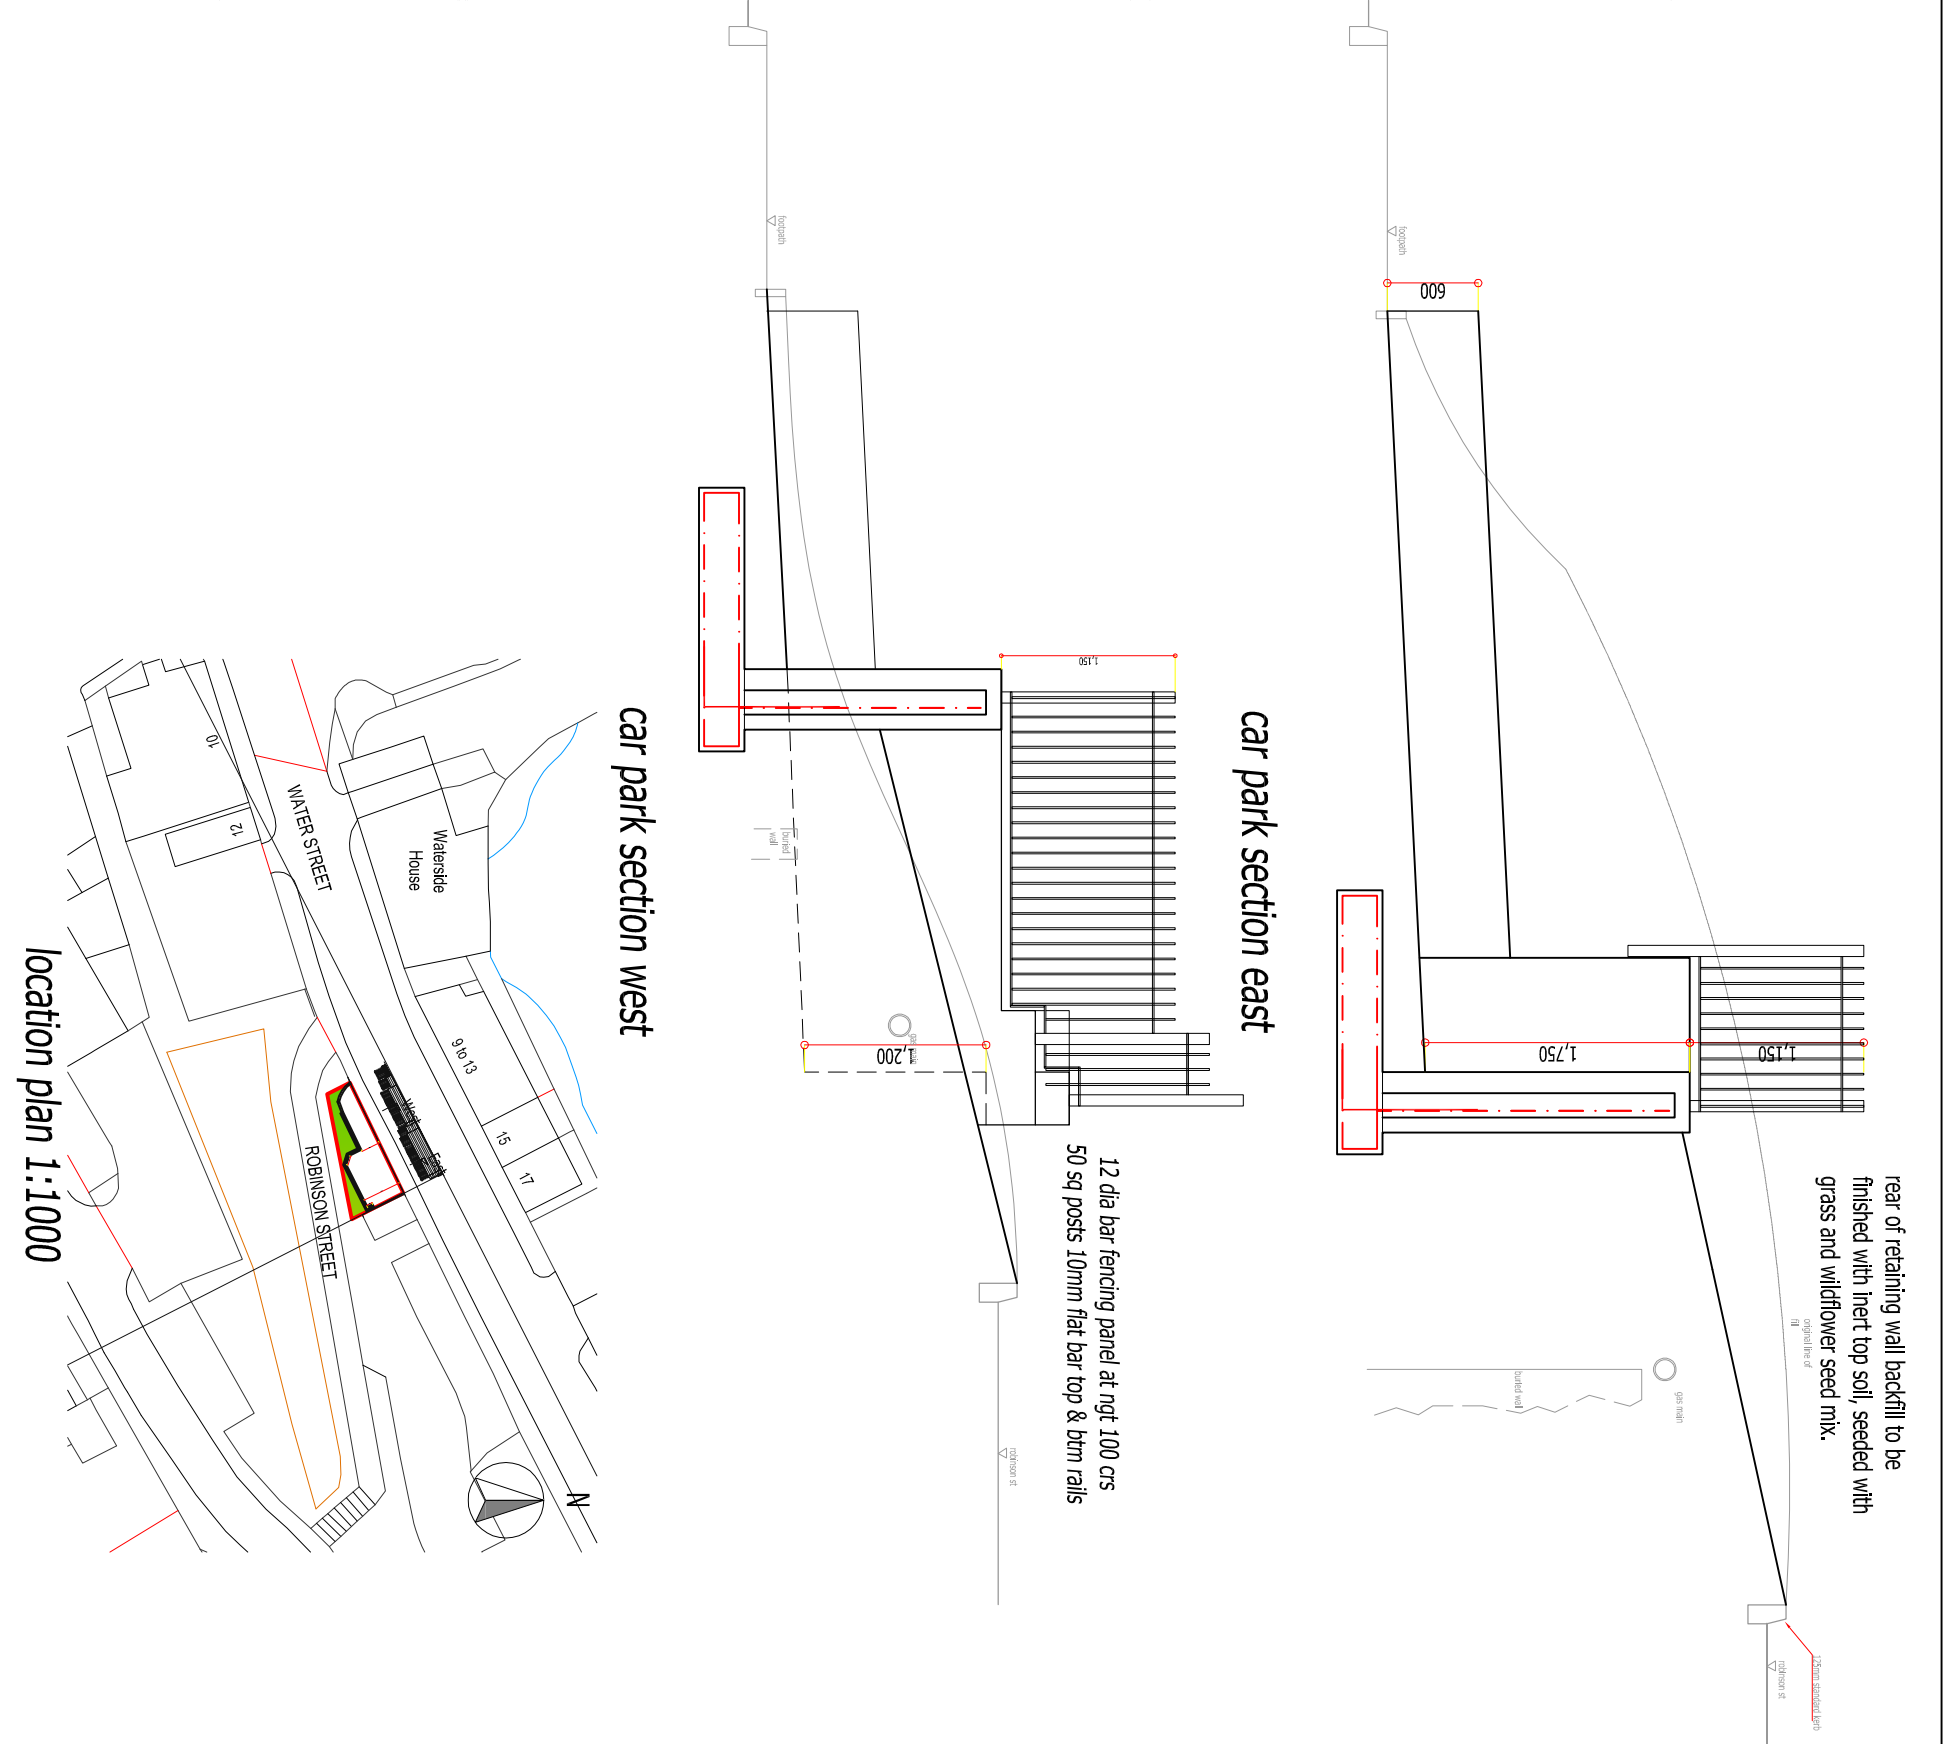
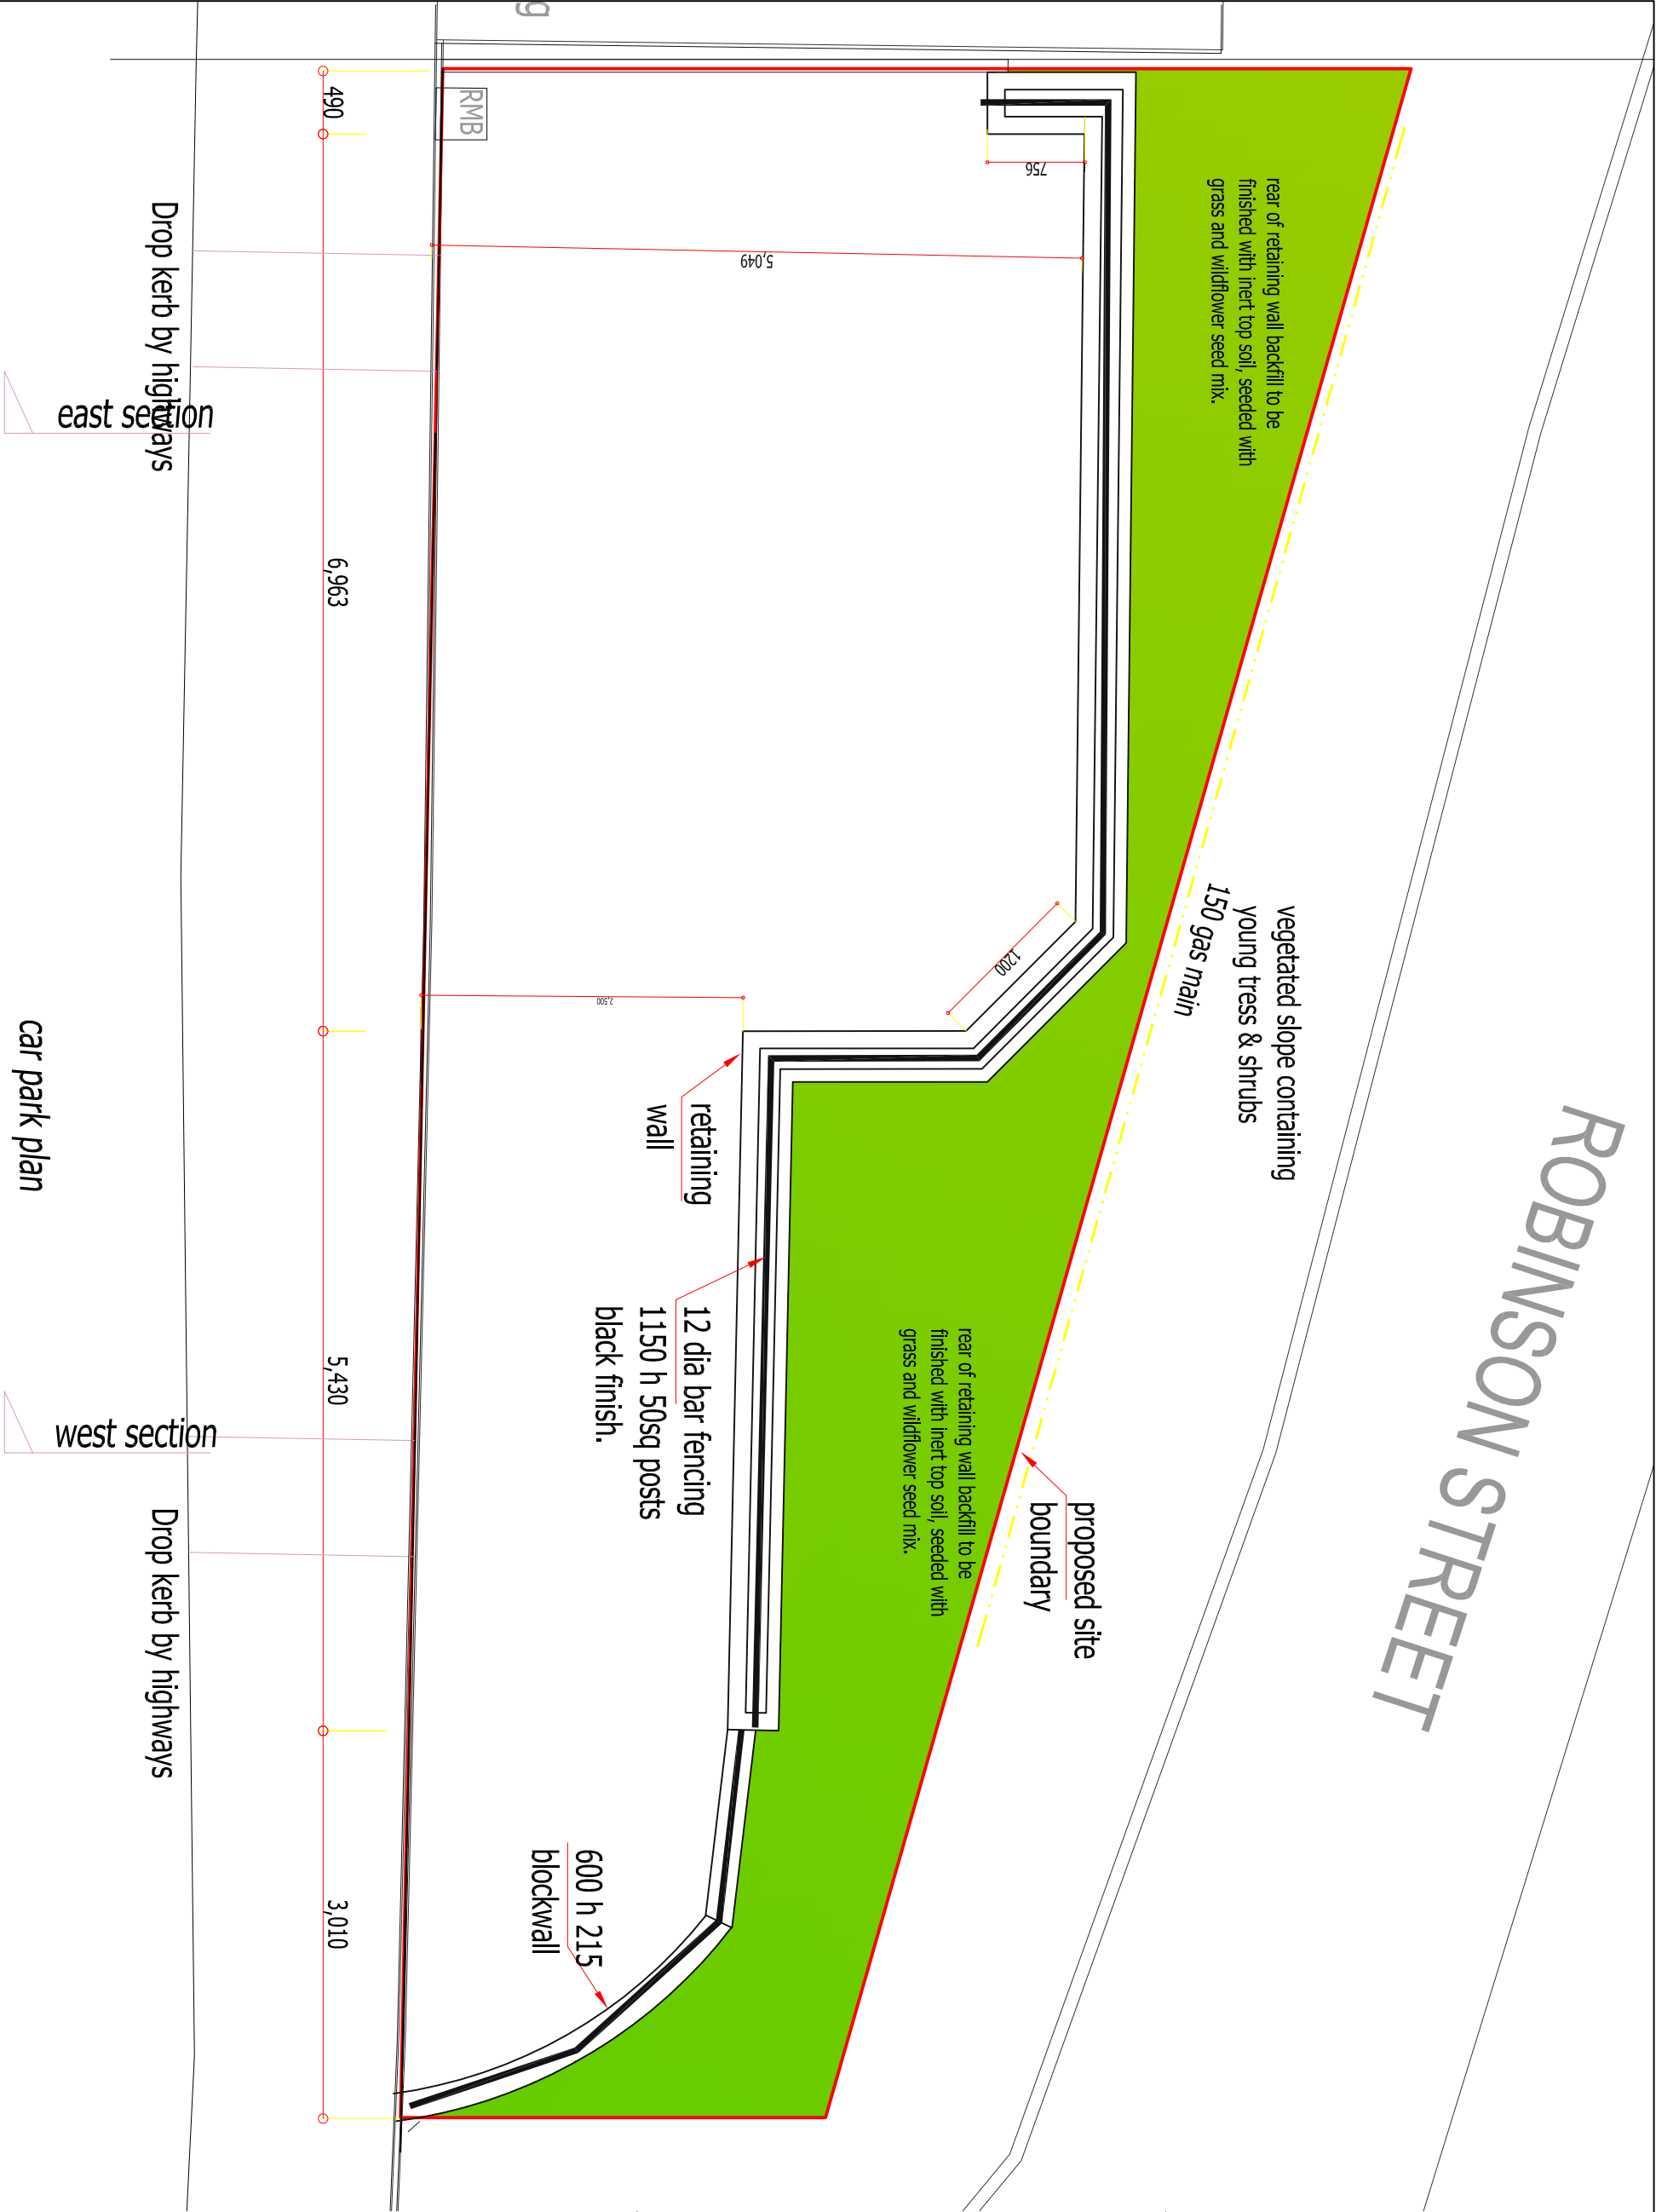


water street elevation

AMENDMENTS/ ISSUES				T J BOOTH ASSOCIATES CONSULTING CIVIL & GEOTECHNICAL ENGINEERS		20A Eastgate Street Rochdale OL16 1DH Tel:01706 868288
p7	elevations and landscape planting coloured	may 25	dt	Mr N Khan / 17 Water St, rochdale, OL16 1TL Vehicle Parking Area. Proposed Plan & Sections		
p6	proposed bank finish	may 25	dt			
p5	final AS BUILT	may 25	dt			
p4	AS BUILT	oct 24	dt			
p3	gas removed for RNBC	jun 22	dt			
p2	review	apr 22	dt			
p1	RNBC planning application	jul 21	dt	FILE NAME: dwg-tpa-rk-lan-17 water st-290520		
rev p0	original for public approval	jul 20	sed/td			
REVISION	REASON/ CHANGE	DATE	BY	SCALE: 1 : 50 @ A2		

NOTES:
heights are approximate & subject to resurvey for working dimensions
works adjacent to the gas main subject to approval from Cadent (utility owner)
site boundary indicated to be agreed between client & RNBC
retaining wall indicative only subject to working design & detail
Retained height 2100mm 140 dense blockwork 160 rc cavity 100mm dense blockwork rear
base 1600 overall width 300 thick.
Retained height less than 1700mm blockwork laid flat cross bonded in varying thickness of stem
as BRE bucket handle pointing.
handrail with 10mm dia bars at ngt 100mm CS overall ht nlt 1100mm as APP DOC K

planning