


PRE EXISTING.

SITE PLANS

52 NEWHOUSE ROAD
HEYWOOD
OL10 2NU

- A DRIVEWAY
- B LAWN
- C PATIO / PAVING
- D PALM TREE
- E CONSERVATORY
- F FLAT ROOF
- G BORDERS
- H EXISTING FLAT ROOF PORCH

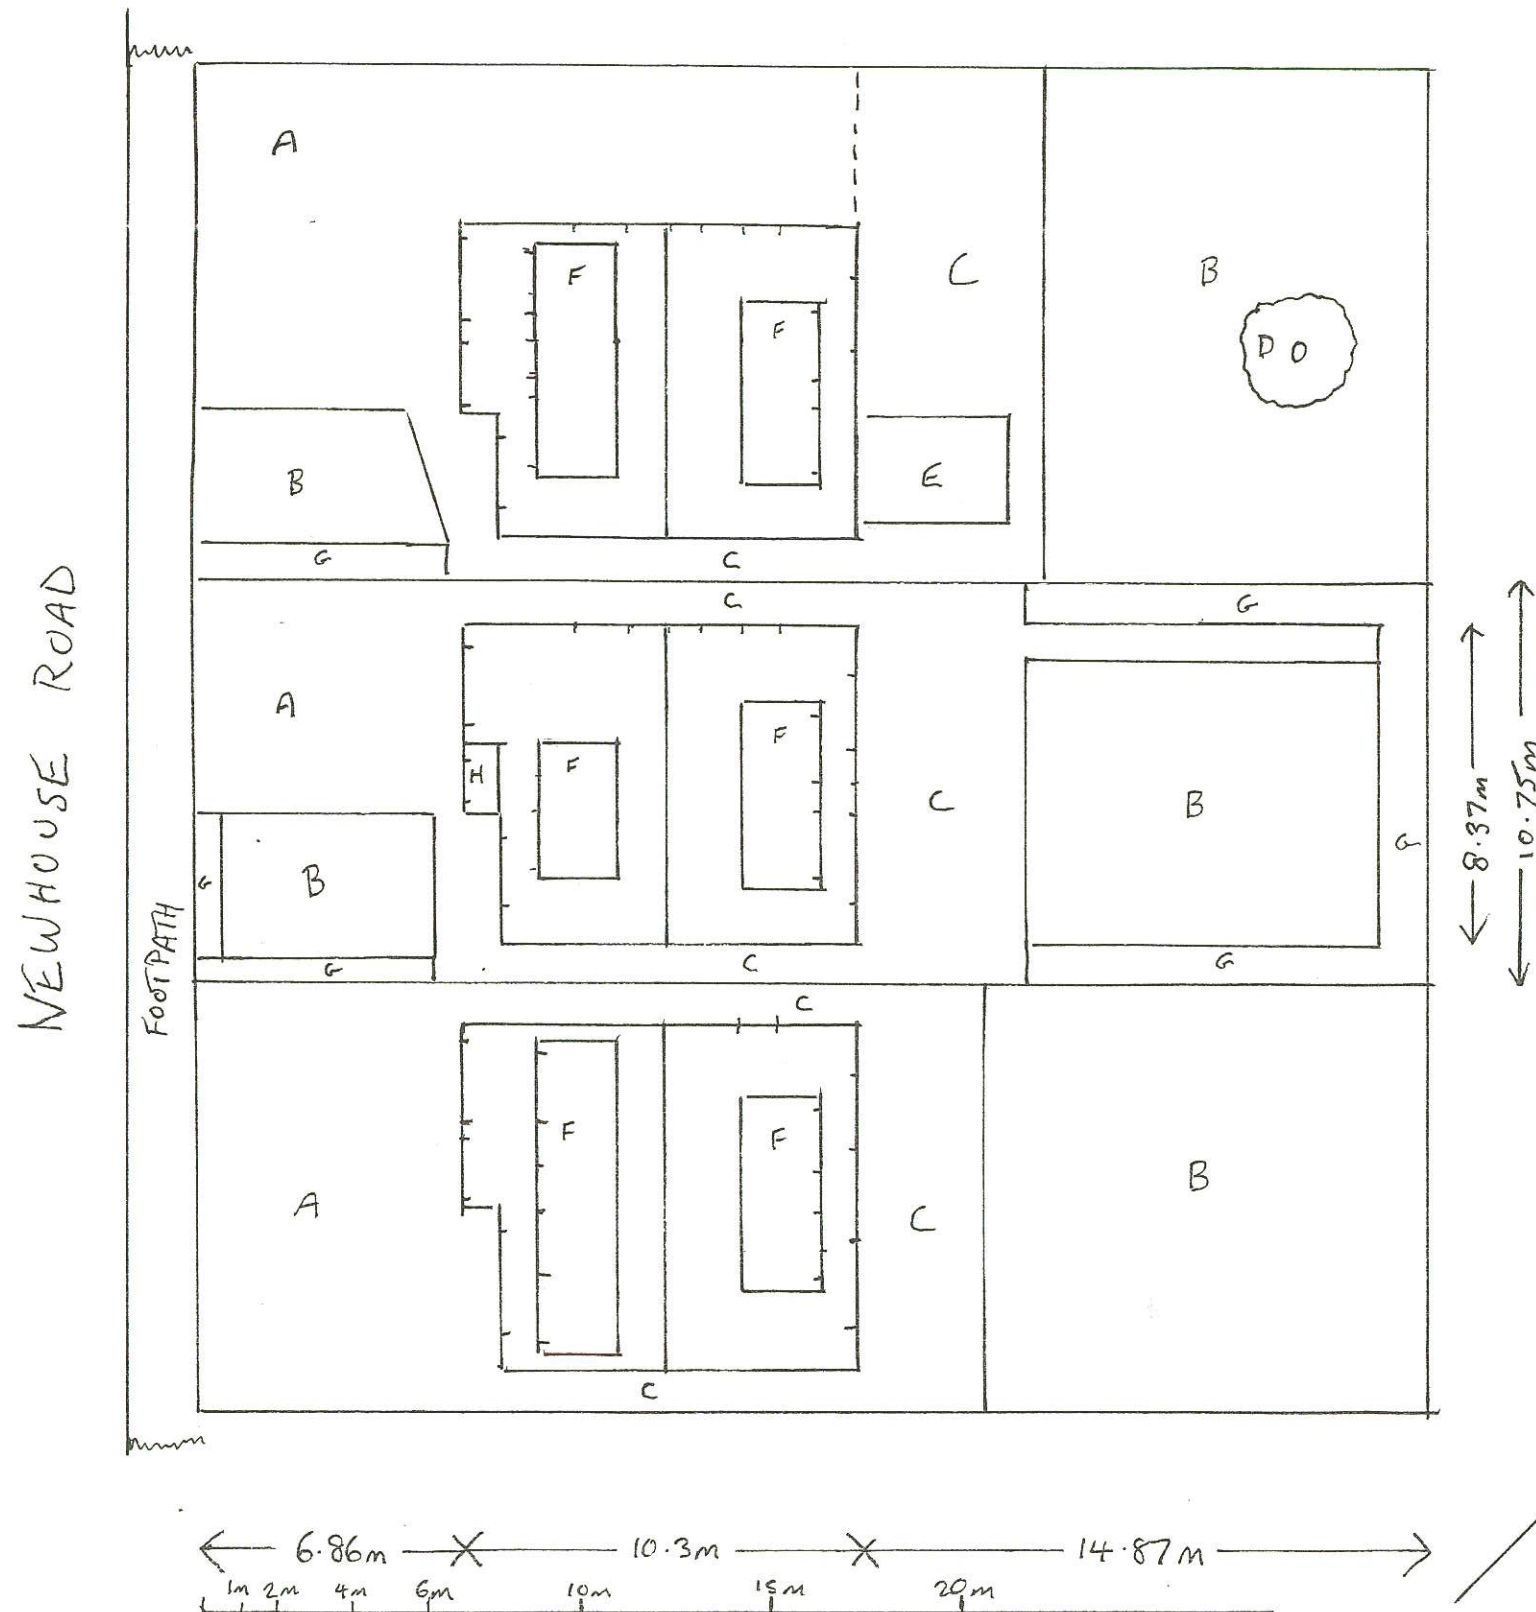


AS BUILT

SITE PLANS

52 NEWHOUSE ROAD
HEYWOOD
OL10 2NU

- A DRIVEWAY
- B LAWN
- C PATIO / PAVING
- D PALM TREE
- E CONSERVATORY
- F FLAT ROOF
- G BORDERS
- H EXISTING FLAT ROOF PORCH

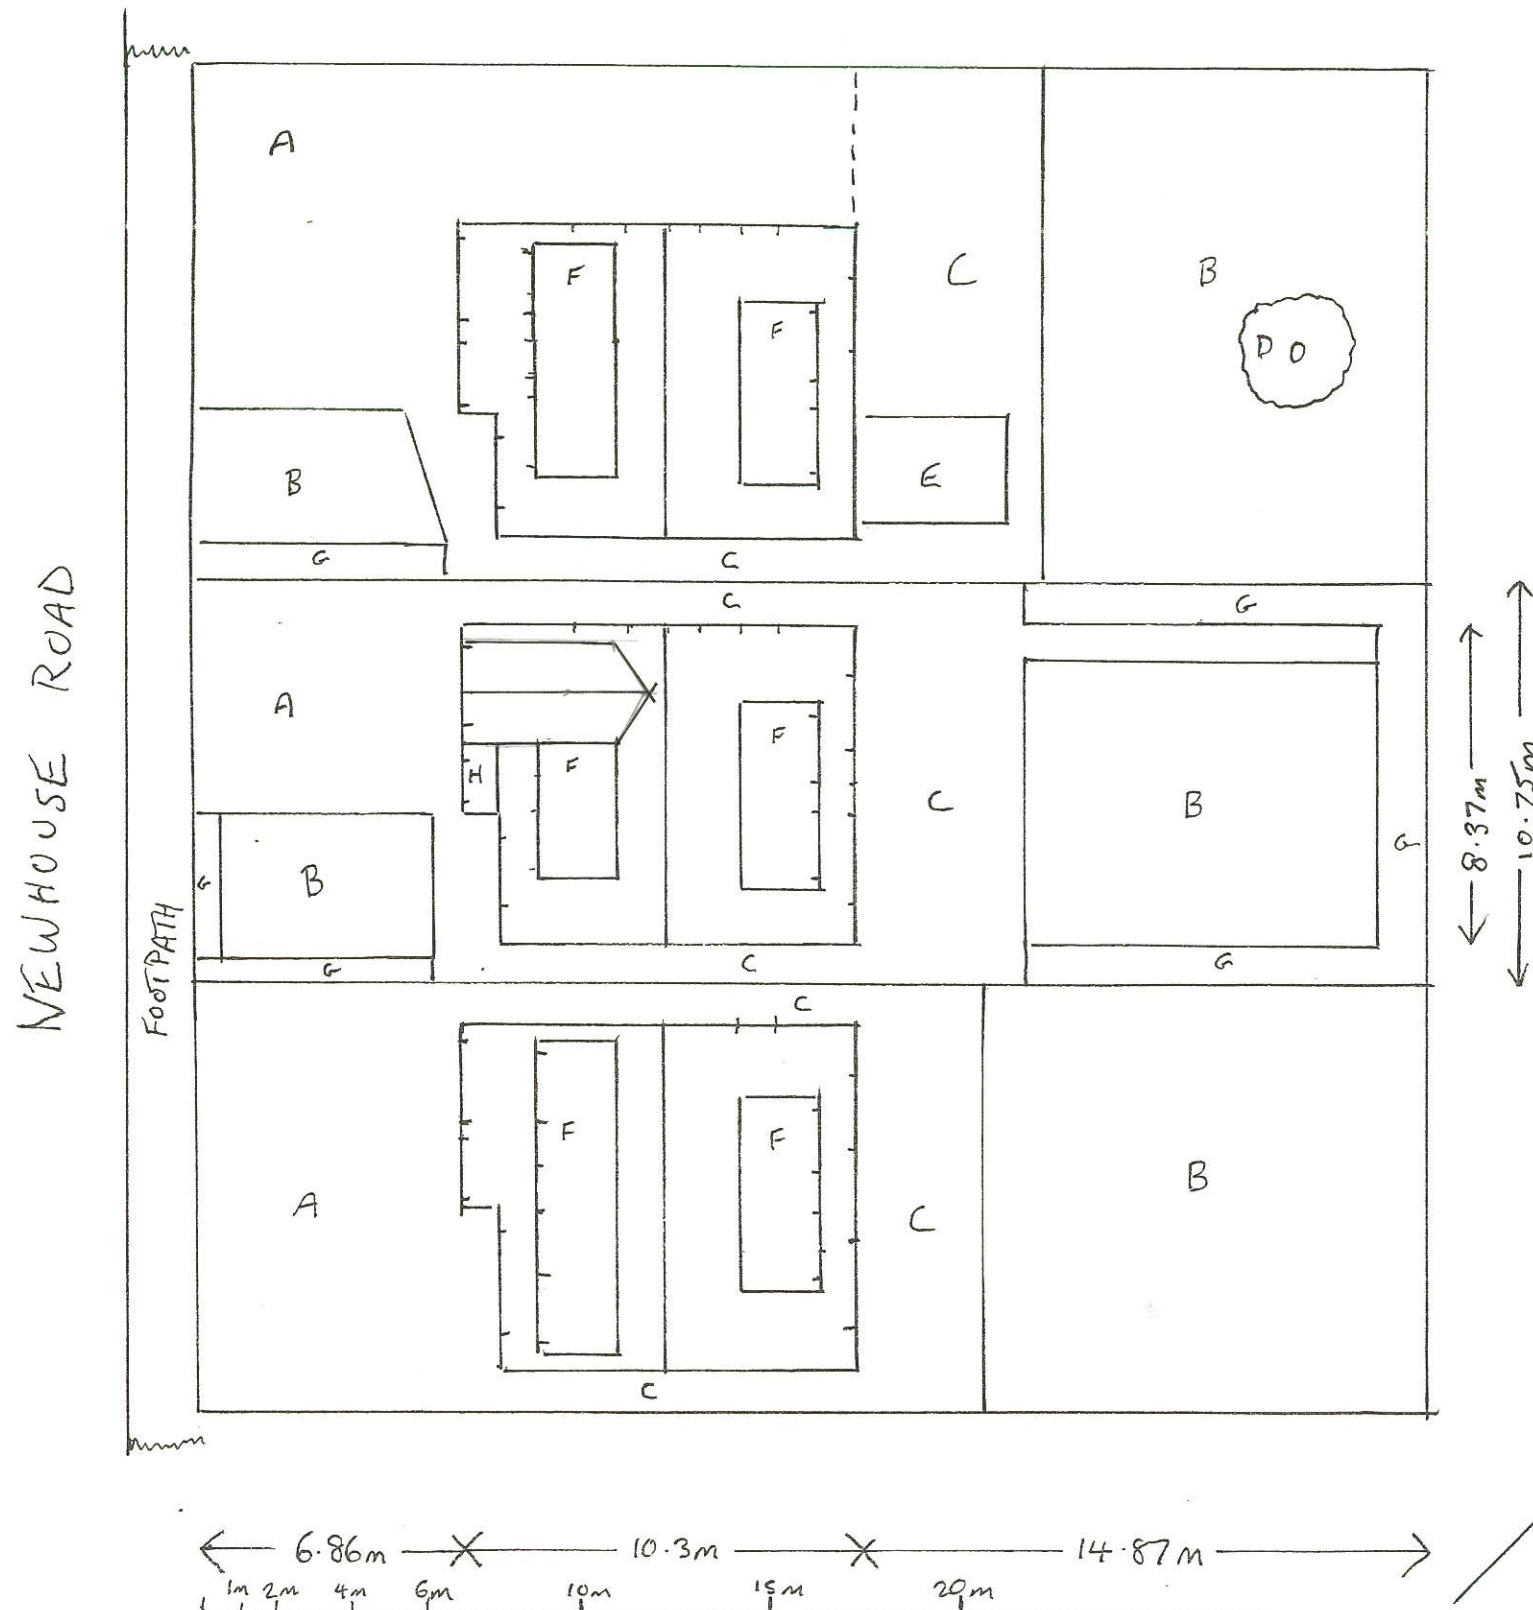

SCALE 1:200


DRAWING 2

PROPOSED

SITE PLANS

52 NEWHOUSE ROAD
HEYWOOD
OL10 2NU

- A DRIVEWAY
- B LAWN
- C PATIO / PAVING
- D PALM TREE
- E CONSERVATORY
- F FLAT ROOF
- G BORDERS
- H EXISTING FLAT ROOF PORCH

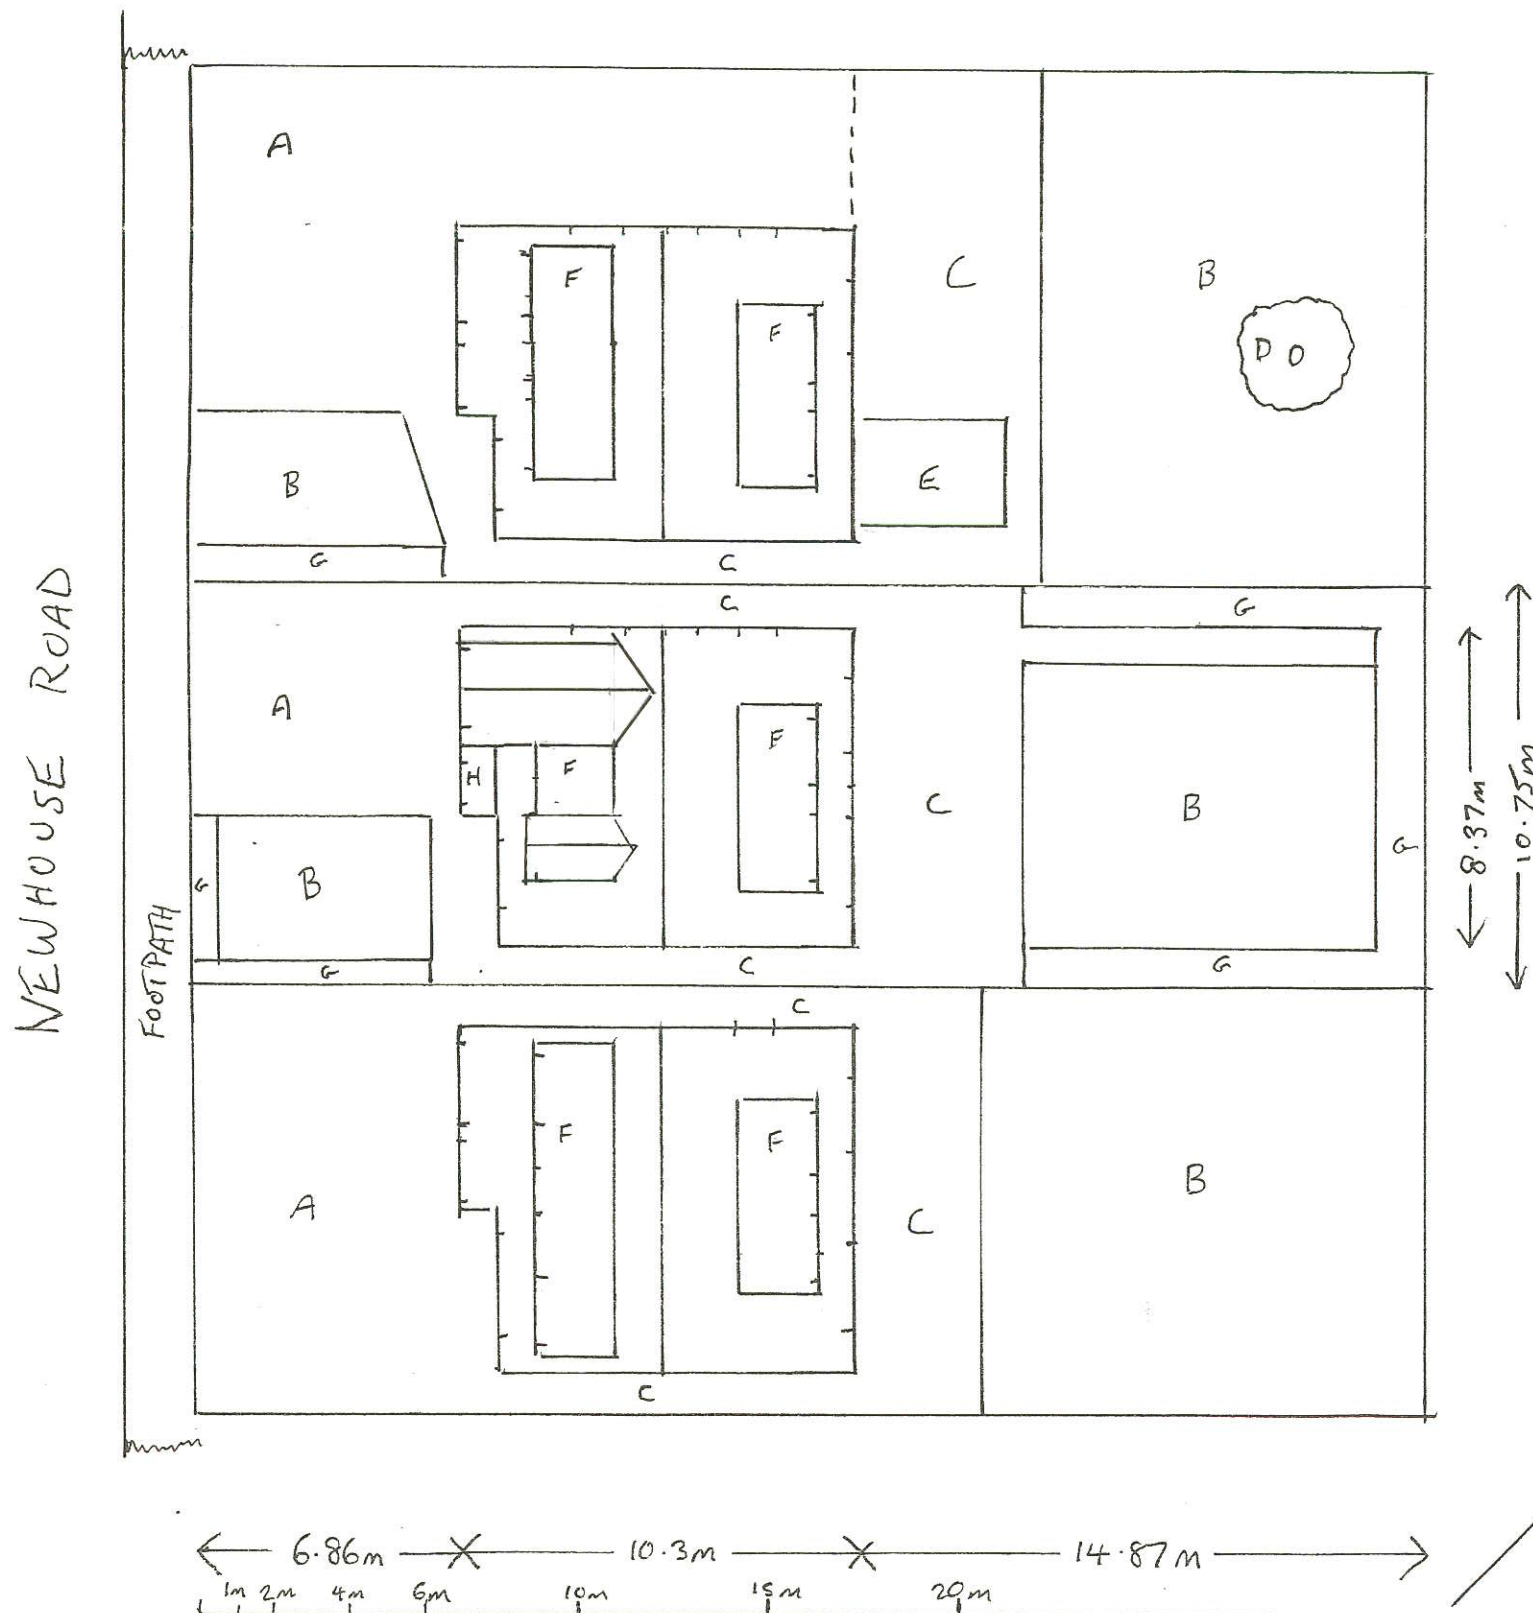

DRAWING 3