




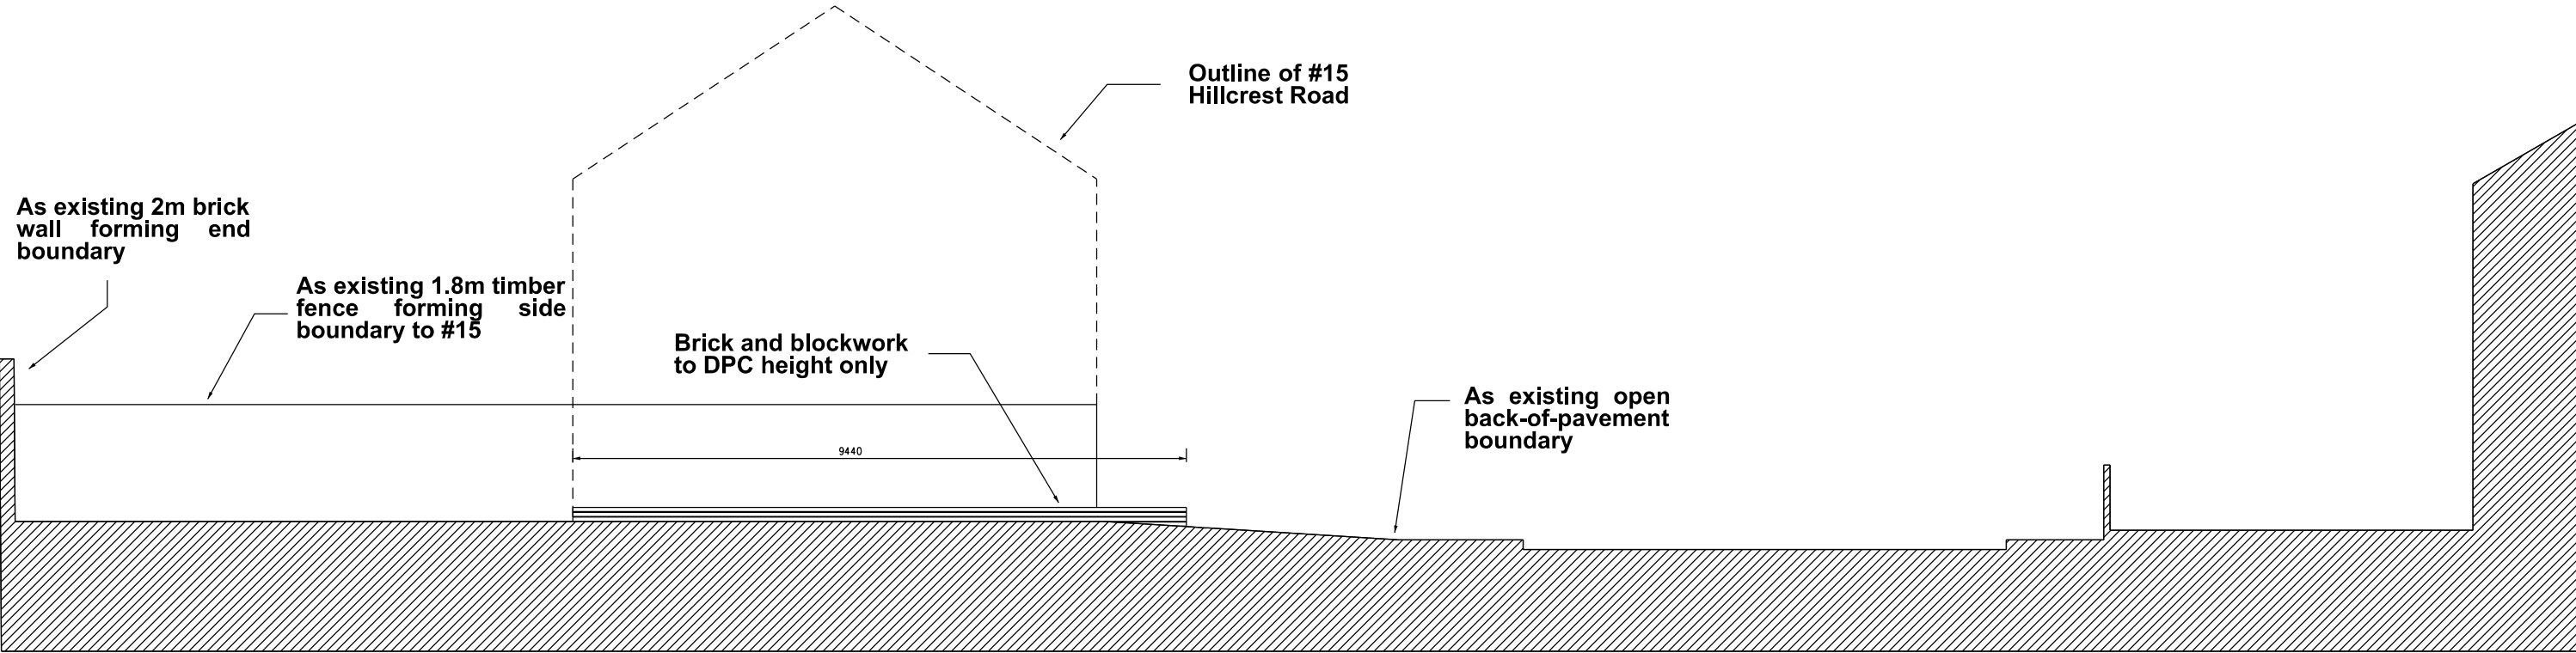

AS-BUILT SIDE ELEVATION (FACING #15 HILLCREST ROAD)

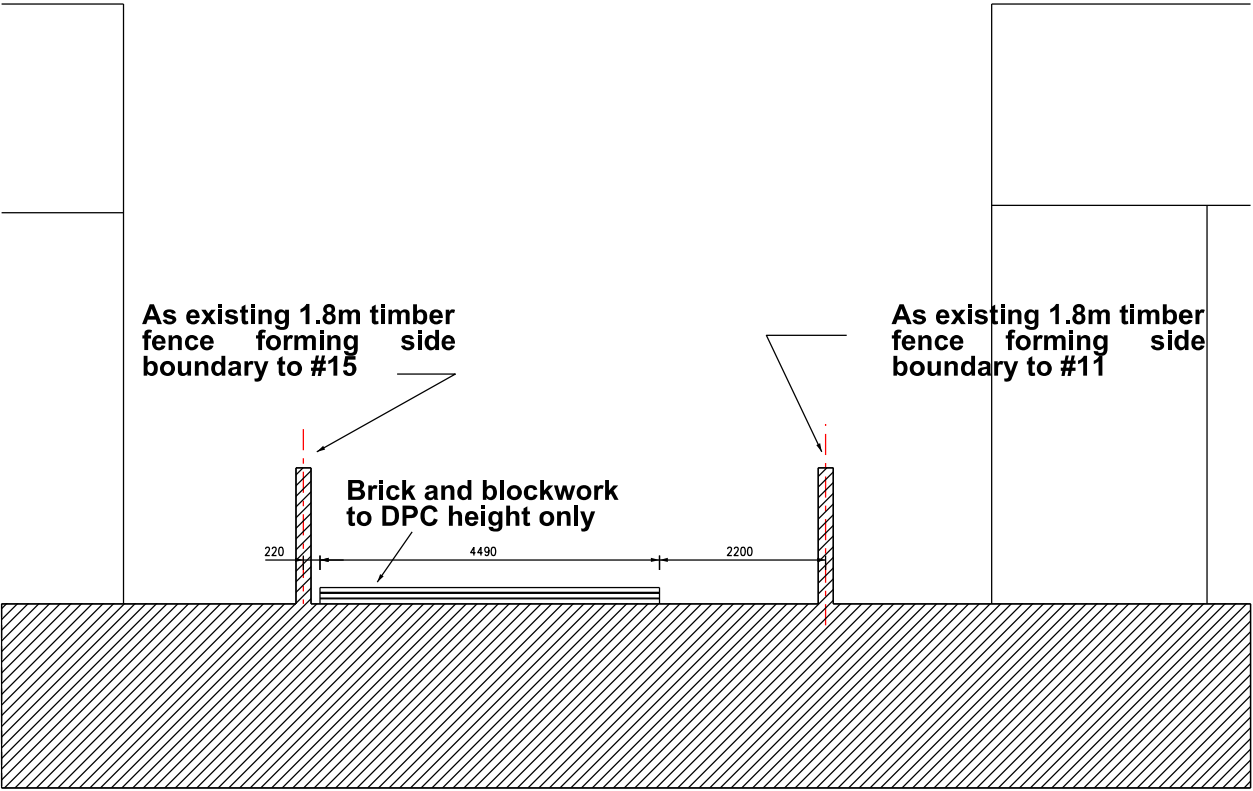

AS-BUILT REAR ELEVATION

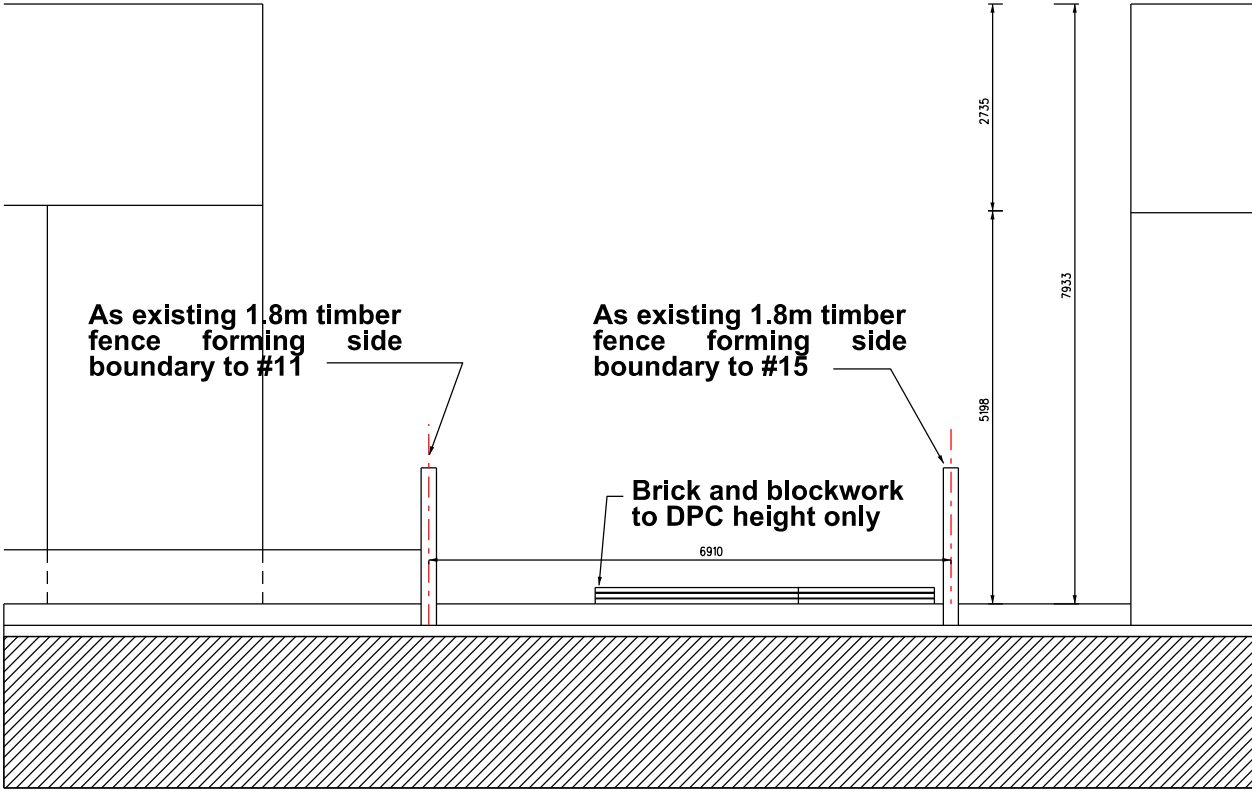

AS-BUILT FRONT ELEVATION TO HILLCREST ROAD


REVISIONS
Rev A: Planning Notes 16Jan23

REVISION NOTES

PROJECT AND DETAILS:

Land adjacent 15 Hillcrest Road

SCALABLE IN METRES

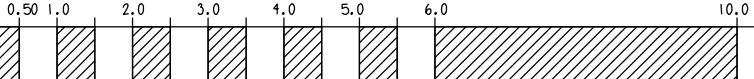

AT:

Rochdale, OL11 2QE

FOR:

L Wells

SCALE:

1:50 @ A1
1:100 @ A3

DRAWN:

IB

DATE:

17 Nov 22

A

1 2 3 4 5 6 7 8 9 10 11 12

DWG TITLE:

As Built Elevations

DWG NO:

499-PL04

