
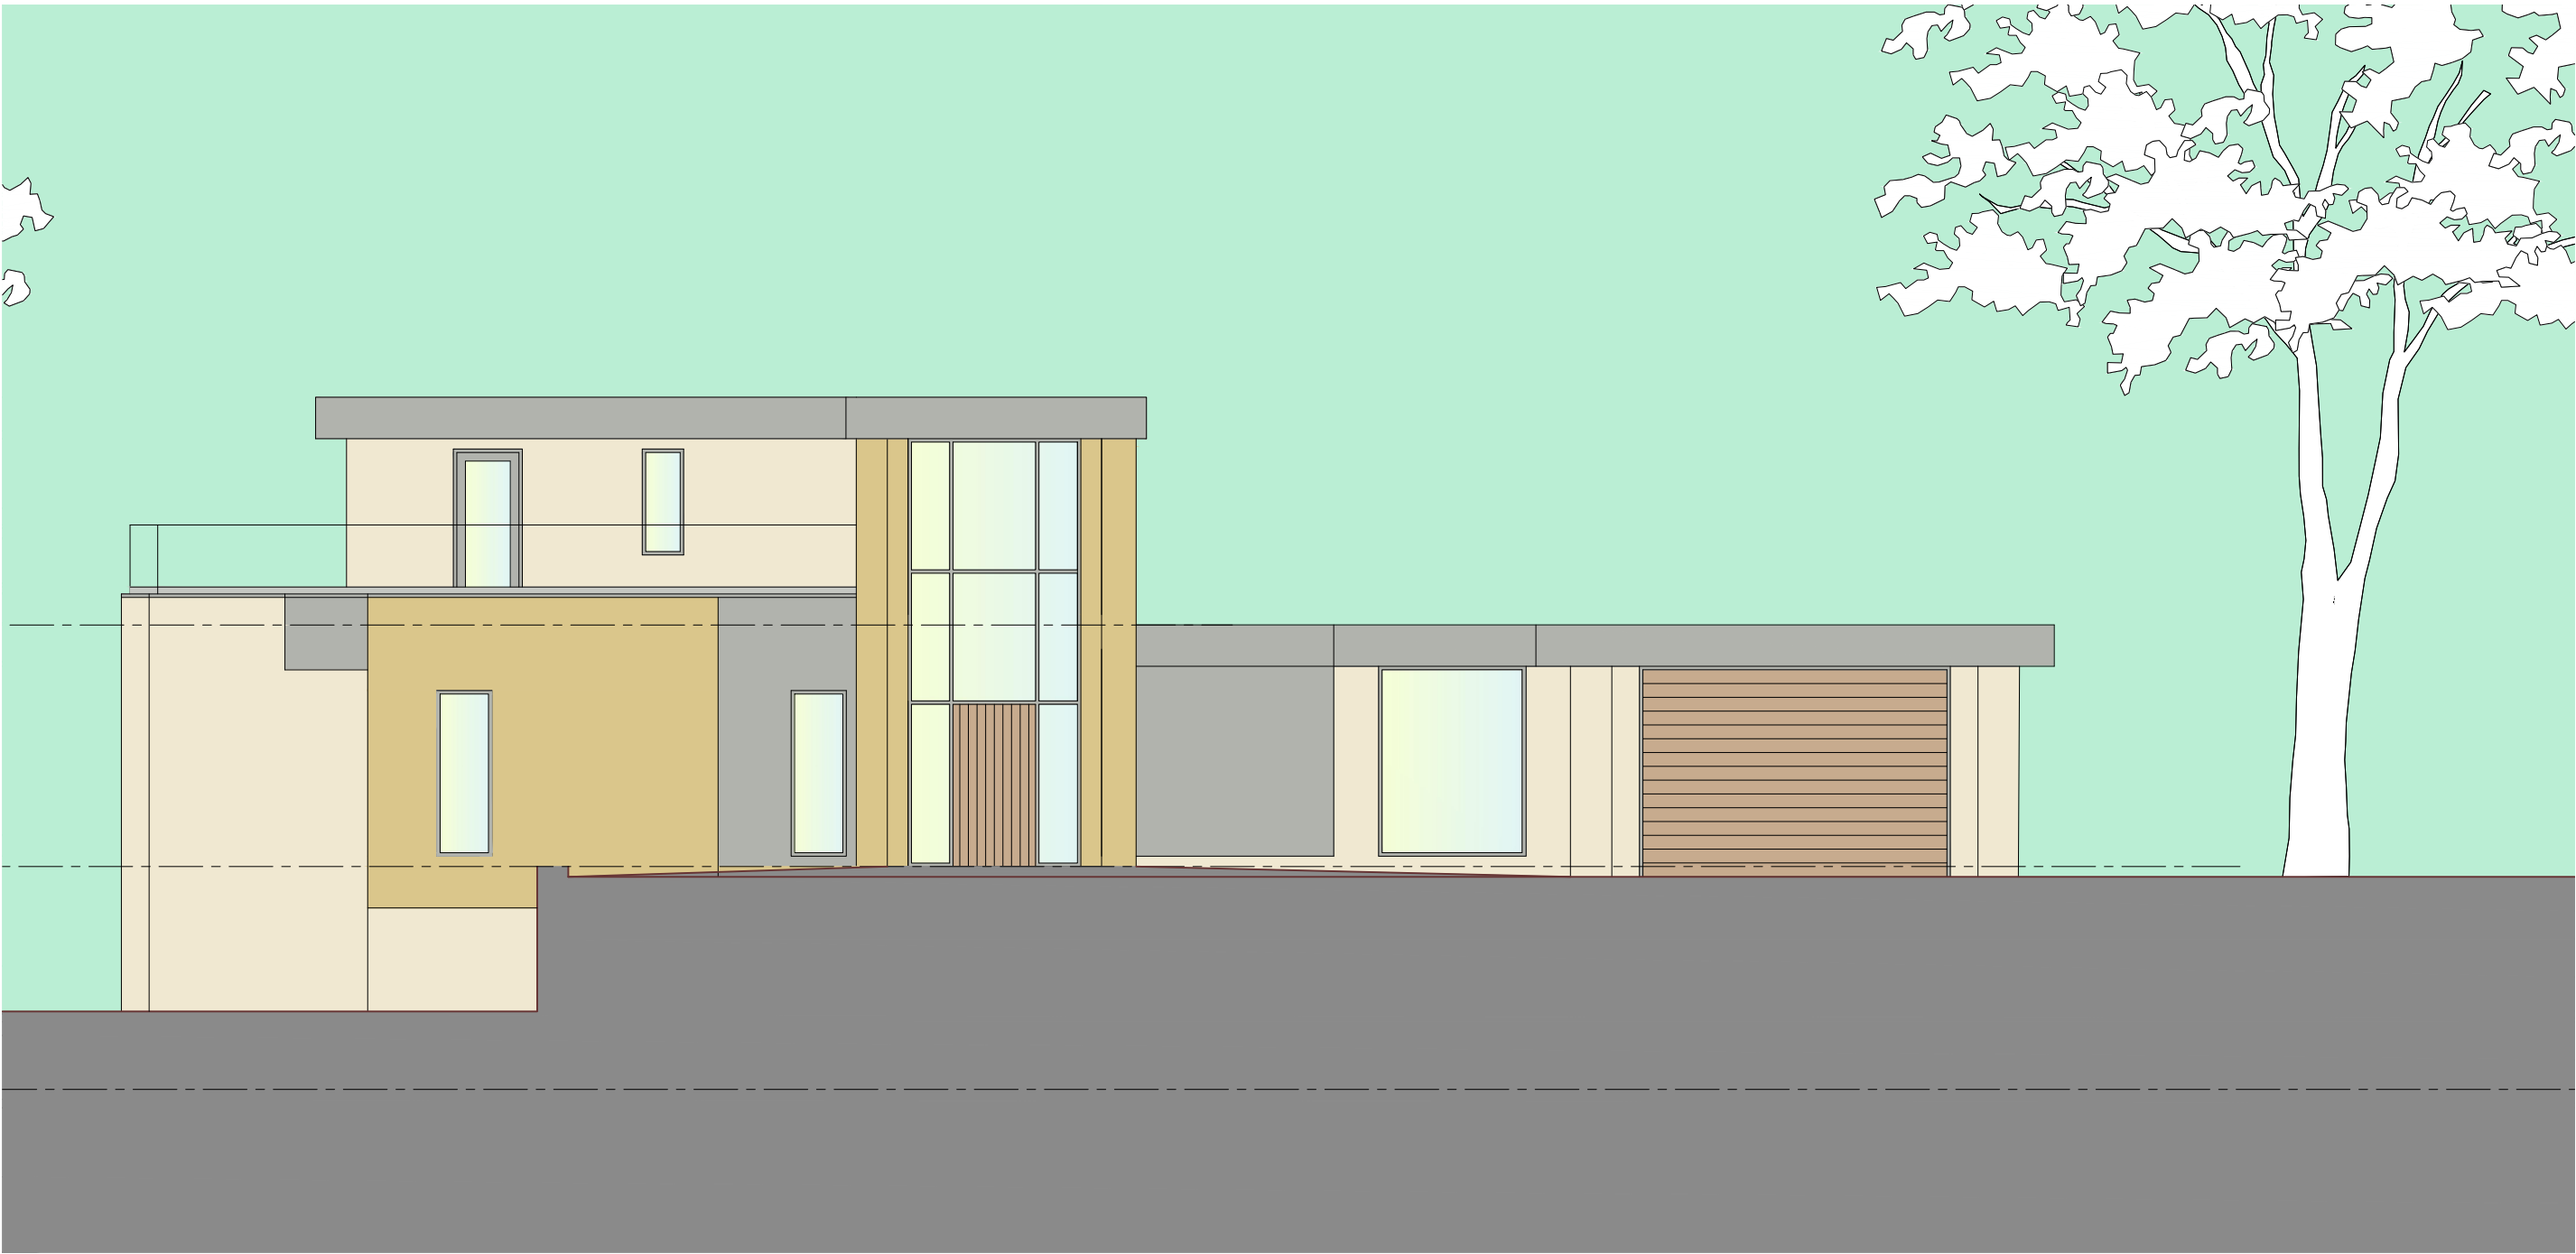


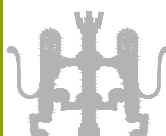

north elevation

Kieren and Jo McDonnell Proposed Eco Home Mill House Farm Overtown Lane Norden	North Elevation AS BUILT	contract no 3396	drawing no 19	revision	Blue Pit Mill Queensway Castleton Rochdale OL11 2PG +44 (0)1706 631347 info@cjpartnership.com www.cjpartnership.com	CJPARTNERSHIP ENVIRONMENTAL ARCHITECTS		
	work to figured dimensions	drawn by PDC	date May 2020	scale @ A3 1:100				Revisions: A.
	© CJ Partnership owns the copyright of this design / drawing which must not be reproduced in whole or in part without the written permission of CJ Partnership							