
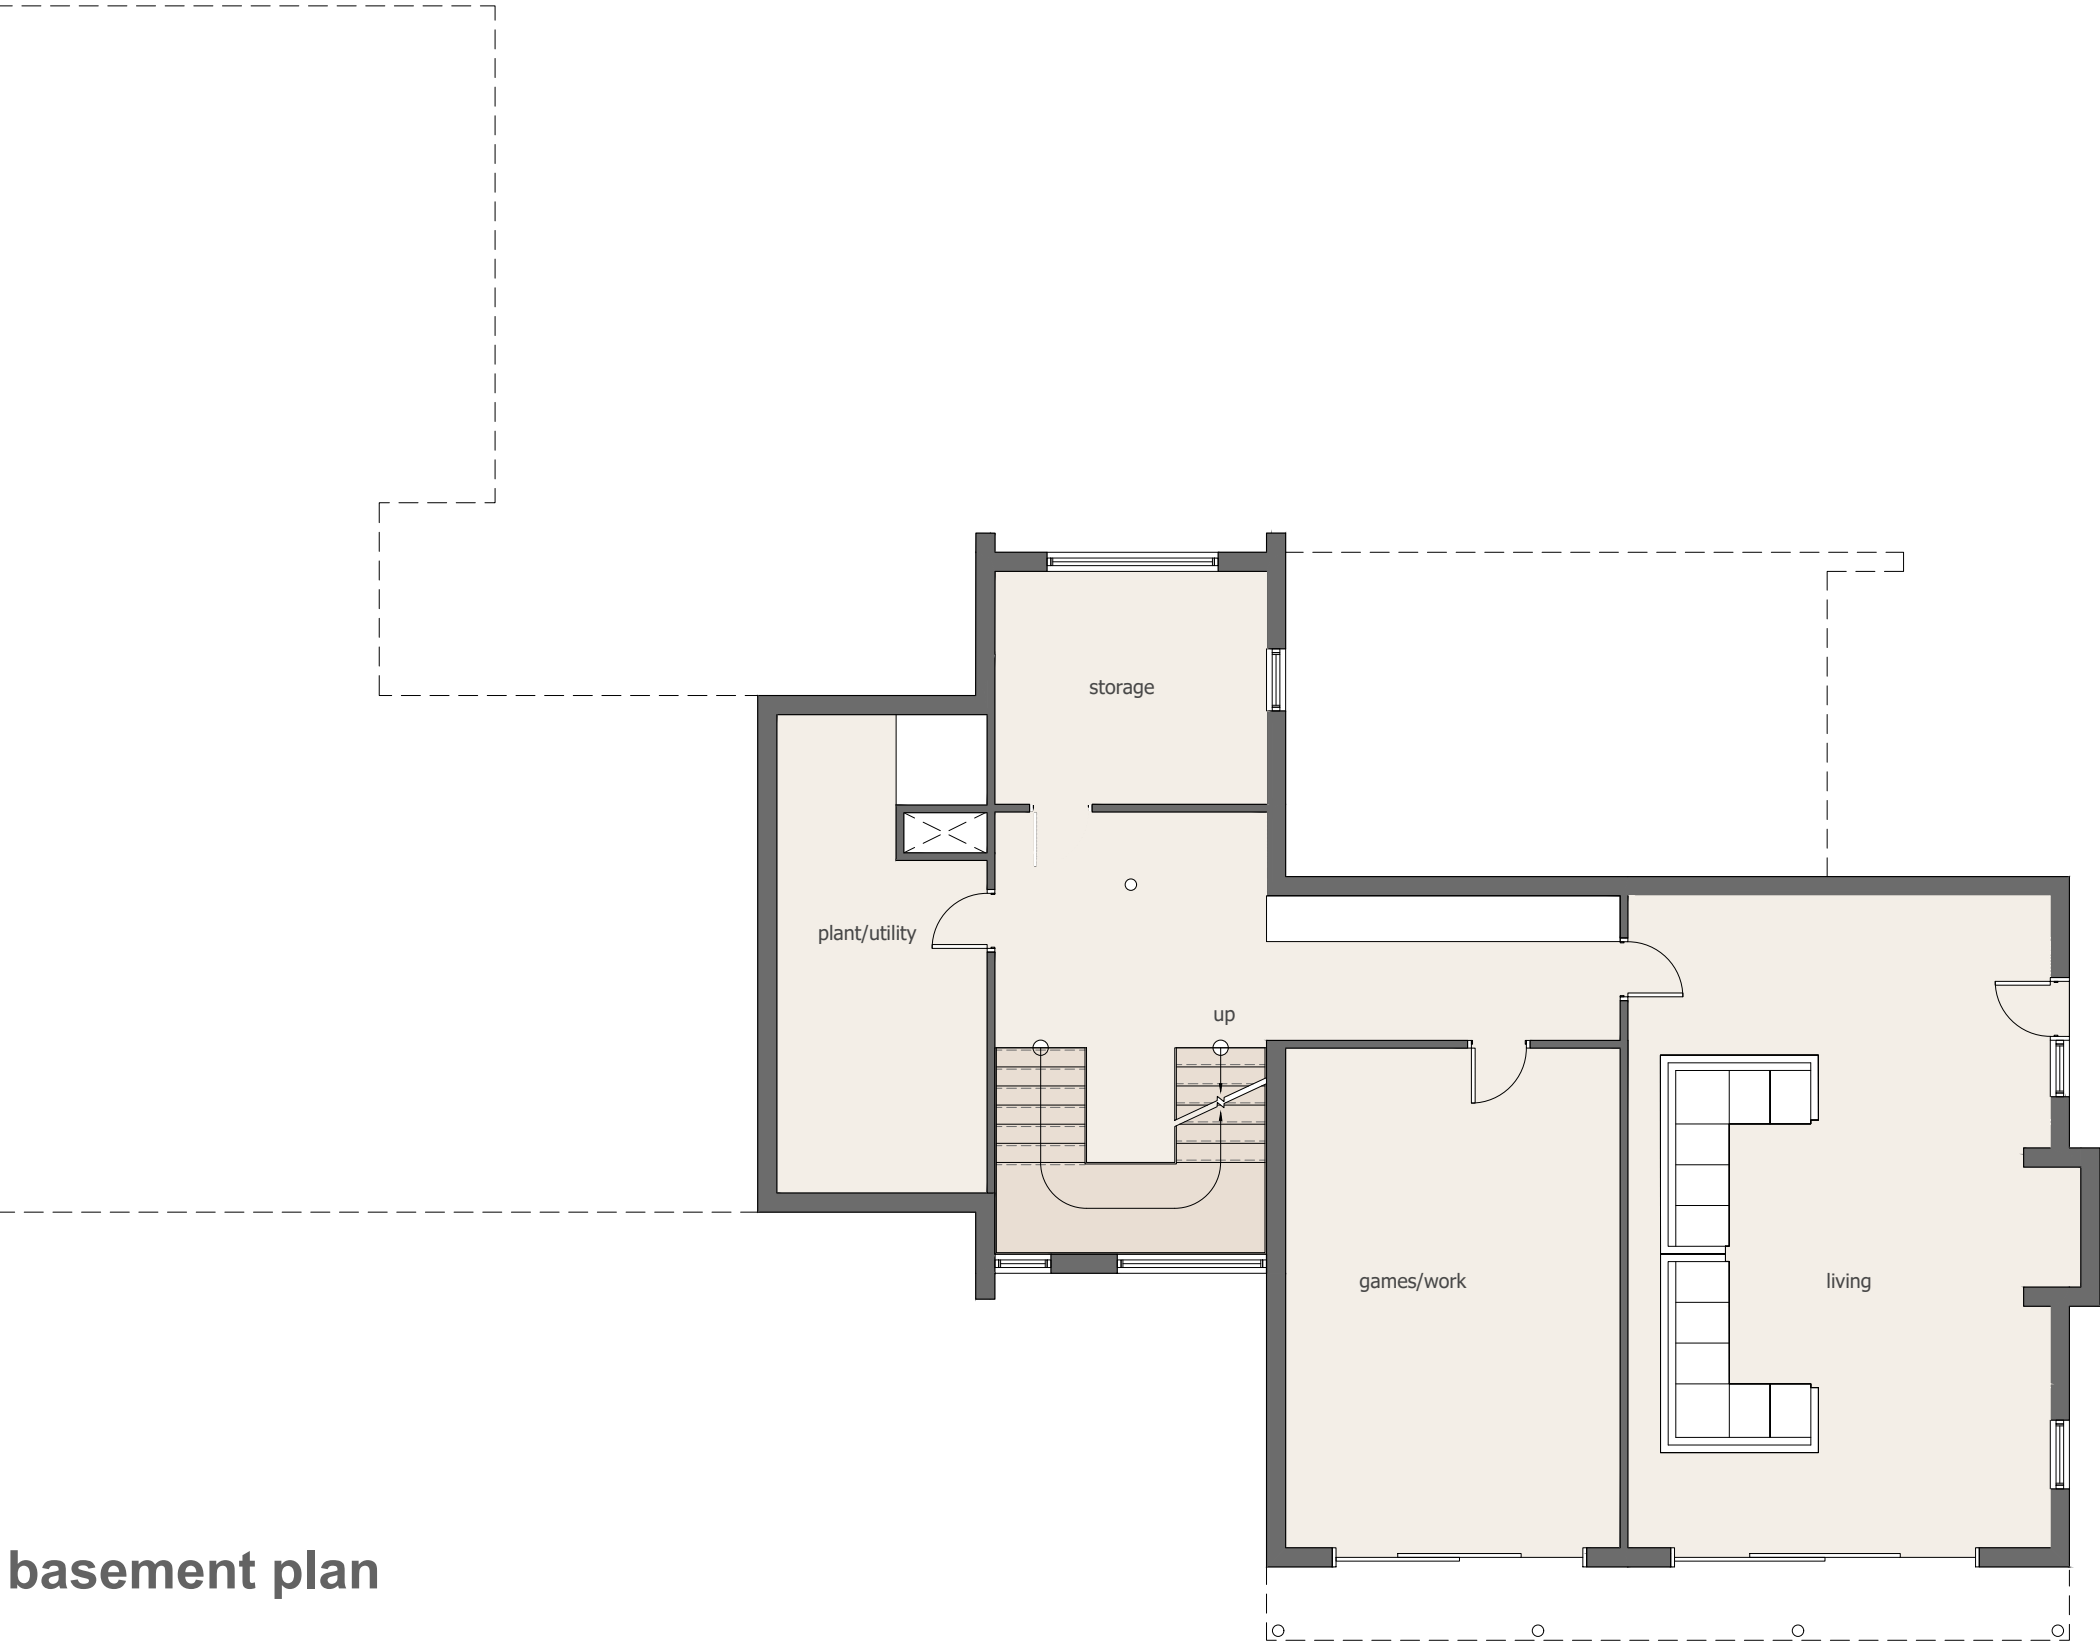


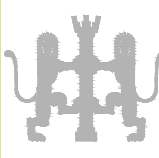

basement plan

Kieren and Jo McDonnell Proposed Eco Home Mill House Farm Overtown Lane Norden	Basement Plan	contract no	drawing no	revision	Blue Pit Mill Queensway Castleton Rochdale OL11 2PG +44 (0)1706 631347 info@cjpartnership.com www.cjpartnership.com	CJPARTNERSHIP ENVIRONMENTAL ARCHITECTS 
	AS BUILT	3396	16			
	work to figured dimensions	drawn by PDC	date November 2015	scale @ A3 1:100		
	© CJ Partnership owns the copyright of this design / drawing which must not be reproduced in whole or in part without the written permission of CJ Partnership				Revisions: A.	