


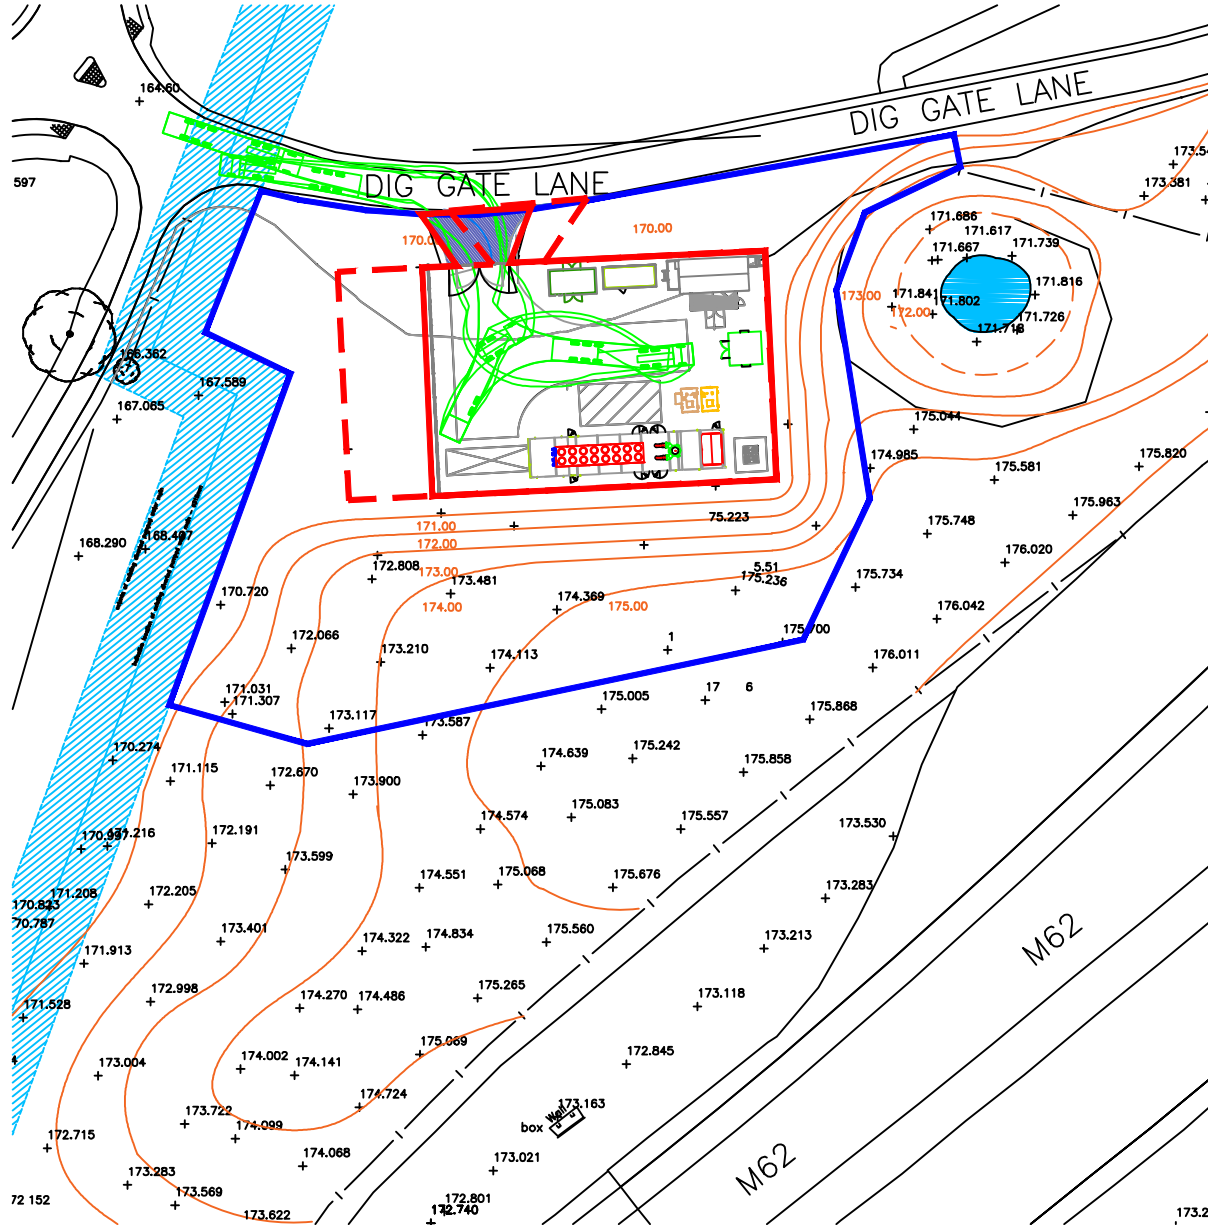

KEY:

	APPLICATION SITE BOUNDARY (APPROX. 1200m ²)
	ORIGINAL APPLICATION SITE BOUNDARY (APPROX. 1400m ²)
	OWNERSHIP BOUNDARY

ISSUED FOR TENDER
ALL EQUIPMENT & DIMENSIONS
SHOWN ARE INDICATIVE ONLY

UNDER NO CIRCUMSTANCE IS THIS
DRAWING TO BE USED FOR CONSTRUCTION
OR FABRICATION AT THIS ISSUE

Clarke
Energy®
A KOHLER COMPANY
Engineer - Install - Maintain

CLARKE ENERGY LIMITED,
HEAD OFFICE, POWER
HOUSE, SENATOR POINT,
SOUTH BOUNDARY ROAD,
KNOWSLEY INDUSTRIAL
PARK, LIVERPOOL, L33
7RR, UK
TEL: +44 (0)151546446

TC	UPDATED LAYOUT	AMcA			30.09.2
TB	UPDATED SITE LAYOUT	JP	–	TA	06.09.2
TA	TENDER ISSUE	DK	–	LG	23.08.2
REV	AMENDMENT	BY.	CHK.	APP.	DATE.

	PAPER SIZE.	A4	SCALE. 1:1250	TITLE	GENERAL ARRANGEMENT OF J624 ENGINE AND EQUIPMENT – LOCATION PLAN (ZOOM OUT)			
	<u>KEY TO FIRST LETTER OF DRAWING ISSUE.</u> 'B' = ASBUILT ISSUE 'A' = CONSTRUCTION ISSUE 'P' = PRELIMINARY ISSUE 'T' = TENDER ISSUE FABRICATION/BUILD ONLY TO BE UNDER TAKEN AT CONSTRUCTION ISSUE			CLIENT	MAST ENERGY			
				SITE	ROCHDALE			
				DRAWN BY.	DANIEL K	DATE DRAWN.	23.08.22	ISSUE.
				DRAWING NO.	C5059-GA-008			TC