


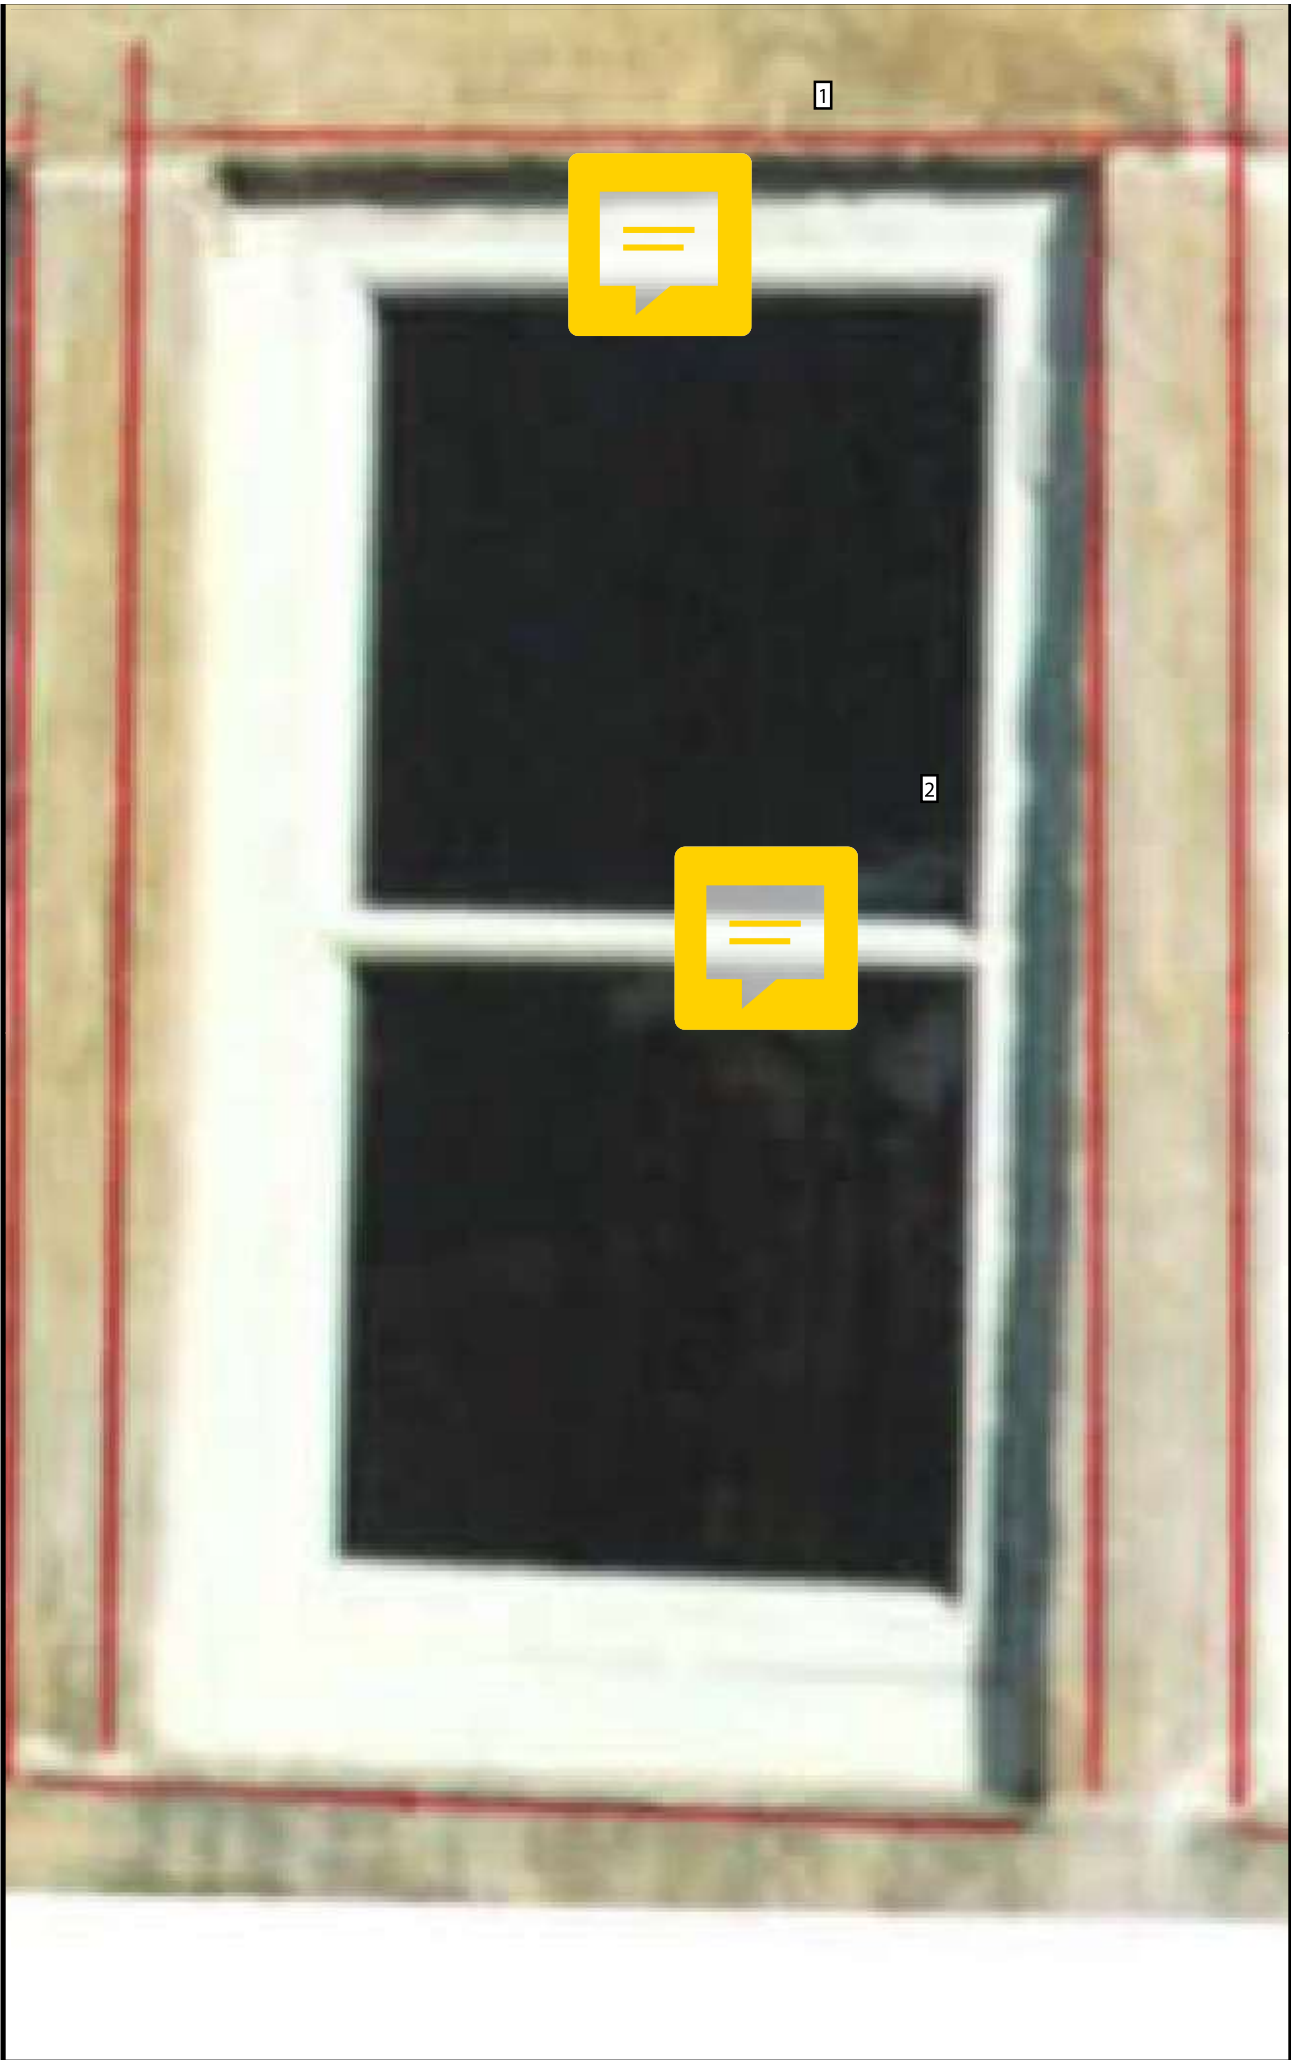

Summary of Comments on window detail_ (003).pdf

Page: 1

	Number: 1	Author: FenghourCatherine	Subject: Sticky Note	Date: 03/10/2024 15:30:56
	please provide thickness			
	Author: 10660933	Subject: Sticky Note	Date: 08/10/2024 17:47:14	
	Frame size 80mm x 57mm			
	Sash size 44mm x 57mm			
	Number: 2	Author: FenghourCatherine	Subject: Sticky Note	Date: 03/10/2024 15:31:23
	please provide width and depth of glazing bar and confirm it will be integral			
	Author: 10660933	Subject: Sticky Note	Date: 08/10/2024 17:48:17	
	Glazing bar 38mm x 44 mm and is integral			
	Author: 10660933	Subject: Sticky Note	Date: 08/10/2024 17:48:39	
	Glass Units 14mm overall			