



VDE A3 v1 Plotted By: William Evans on 25.09.2023 at 1:34 PM

THIS DRAWING REMAINS THE PROPERTY OF VITAL ENERGI AND MUST NOT BE REPRODUCED, COPIED, OR HANDED OVER TO A THIRD PARTY WITHOUT PRIOR WRITTEN CONSENT.

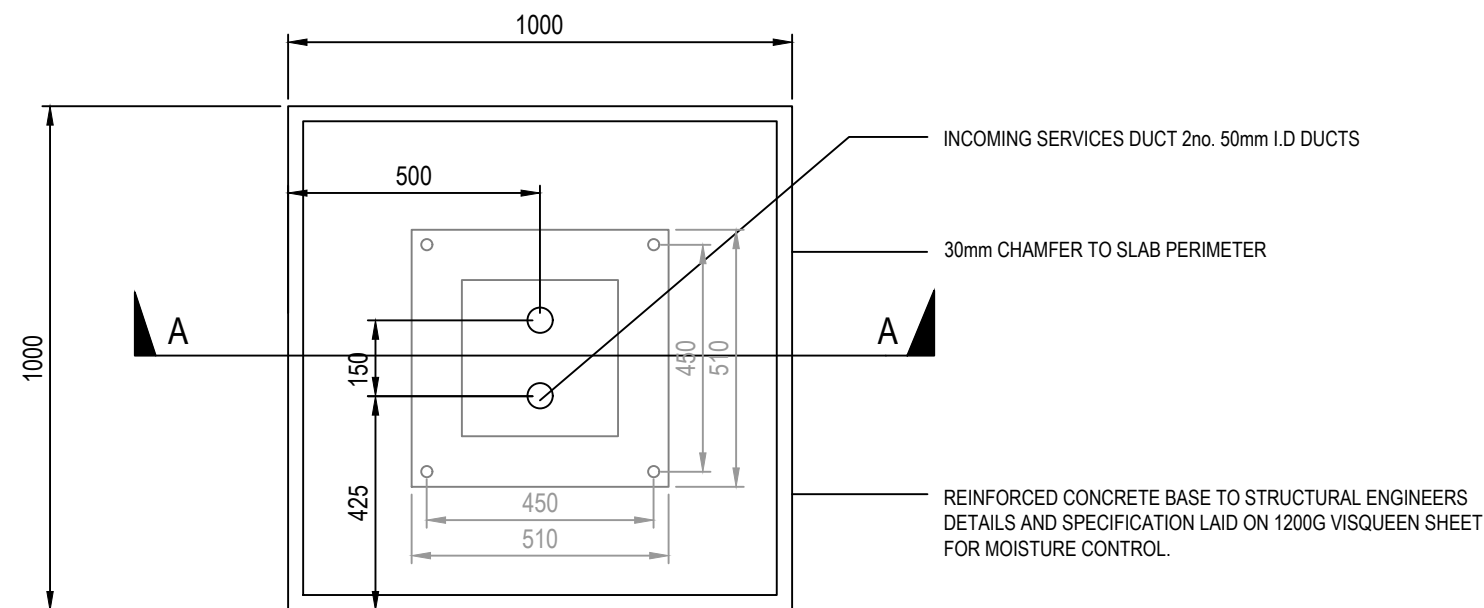

BASE LAYOUT
SCALE 1:15

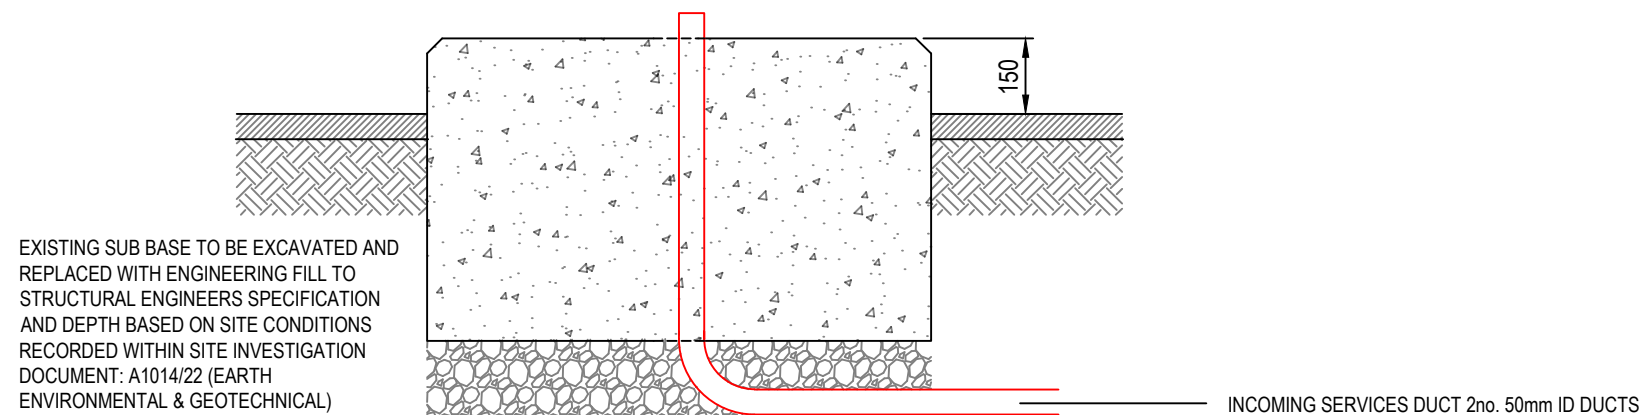

SECTION A-A THROUGH SLAB
SCALE 1:15

CCTV POST SUPPORT BASE LAYOUT AND SECTION
SCALE 1:15

GENERAL NOTES:

ALL BUILDERS WORK IS TO BE CONSTRUCTED IN ACCORDANCE WITH THE CURRENT AND RELEVANT BUILDING REGULATIONS AND BRITISH STANDARDS. MANUFACTURERS INSTALLATION/ GUIDANCE NOTES ARE TO BE READ IN CONJUNCTION TO TASK BEING CARRIED OUT.

ALL DIMENSIONS ON DRAWING ARE IN MILLIMETERS UNLESS OTHERWISE STATED. ALL LEVELS ON DRAWING ARE IN METERS UNLESS OTHERWISE STATED.

THE CONTRACTOR SHALL BE RESPONSIBLE FOR THE ACCURACY OF ALL DIMENSIONS AND FOR THE CORRECT SETTING OUT OF WORK CARRIED OUT ON SITE.

THIS DRAWING IS TO BE READ IN CONJUNCTION WITH ALL RELEVANT ARCHITECTURAL, STRUCTURAL AND MECHANICAL DRAWINGS/ SPECIFICATIONS ISSUED.

ALL MATERIALS AND WORKMANSHIP SHALL BE IN ACCORDANCE WITH THE RELEVANT SPECIFICATIONS AND BRITISH STANDARDS

THE CONTRACTOR SHALL ENSURE THE STABILITY OF THE BUILDING AND ANY ADJOINING STRUCTURES IS MAINTAINED AT ALL STAGES OF CONSTRUCTION. THE CONTRACTOR SHALL DESIGN, INSTALL AND MAINTAIN ANY NECESSARY TEMPORARY WORKS.

CONTRACTOR TO PROVIDE METHOD STATEMENTS AND RISK ASSESSMENTS TO THE ENGINEER AND PLANNING SUPERVISOR A MINIMUM OF 14 DAYS BEFORE THE WORKS COMMENCE

THIS DRAWING IS TO BE READ IN CONJUNCTION WITH:

AS-BUILT / HANDOVER

AB	25.09.23	AS-BUILT / HANDOVER	RJR	BP	BMc
REV	DATE	DESCRIPTION	DRW	CKD	APP

VITAL ENERGi.
Century House,
Roman Road, Blackburn
United Kingdom, BB1 2LD.

Tel: +44 (0)1254 296 000
Fax: +44 (0)1254 296 040



Project: CHAMBER HOUSE -ROCHDALE

Title: CCTV POST SUPPORT BASE
LAYOUT & SECTION



DATE	25.09.2023	SCALE	1:15	SHEET	A3
------	------------	-------	------	-------	----

AS-BUILT / HANDOVER

Status:
AB

Stage:
6

Drg-No:
50716-VE-SW-XX-DR-A-XX12

Rev:
AB