


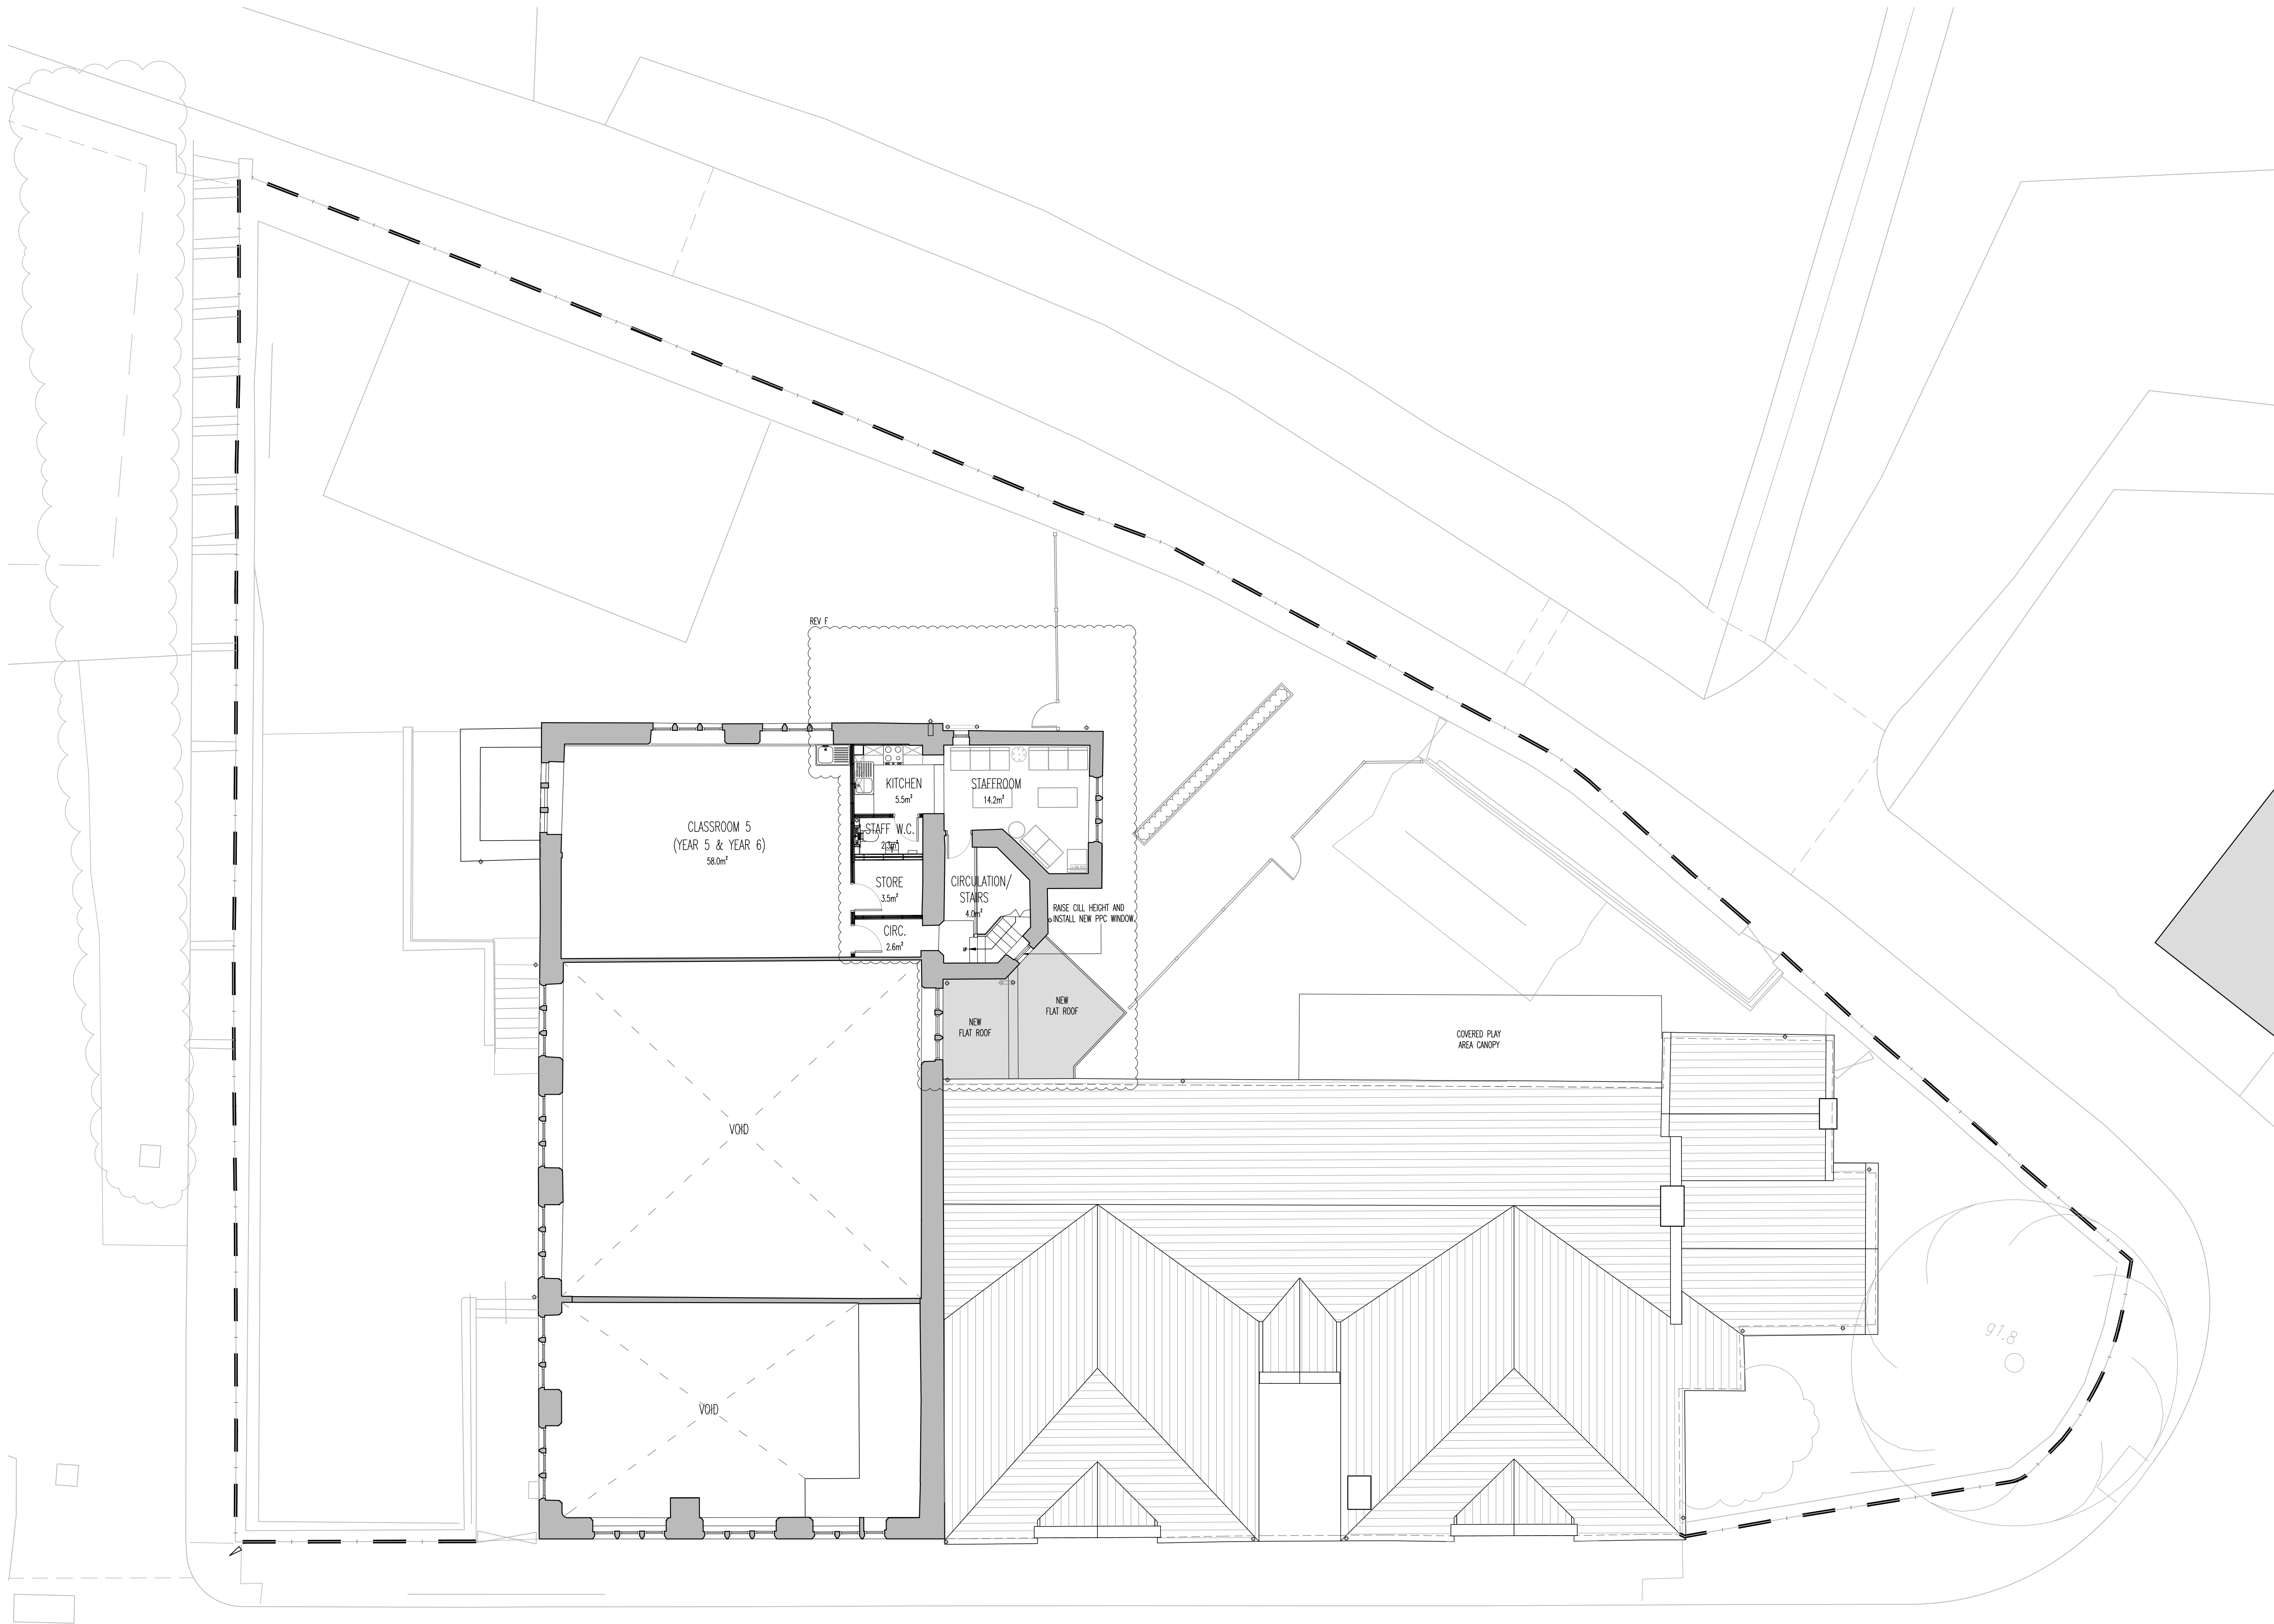

Schedule of Accommodation

Existing Gross Internal Floor Area:

First Floor: 101.0 m²

D	SCOPE OF WORKS UPDATED.	20.05.24	RB	MDM
C	AREAS OF WORK REMOVED.	25.10.23	RB	MDM
B	LAYOUT UPDATED.	07.09.23	RB	MDM
A	PROPOSED MAIN ENTRANCE ROOF UPDATED.	04.07.23	SM	MT
Rev	Description	Date	By	Chk

Status	Purpose for Issue
Planning	☒ Tender ☐
Construction	☐ As Built ☒ PLANNING

Client
THE GOVERNORS OF ST. THOMAS' C. OF E.
PRIMARY SCHOOL, NEWHEY, ROCHDALE

Contract
PROPOSED NEW ENTRANCE, ADMIN BLOCK
STAFF AREAS + TOILETS

Drawing
PROPOSED FIRST FLOOR PLAN

bateandtaylor

architects

www.bate-taylor.co.uk

macintosh house

cambridge street

manchester m1 5gg

tel: 0161 236 0999

fax: 0161 236 0404

mail@bate-taylor.co.uk

Drawing No.	MH1393-10	Revision	D
Scales	1:100 @ A1	Date	SEPT '23
Drawn	RB	Checked	MDM

This drawing is the copyright of the Architect and may not be reproduced without licence.
DO NOT scale from this drawing.