



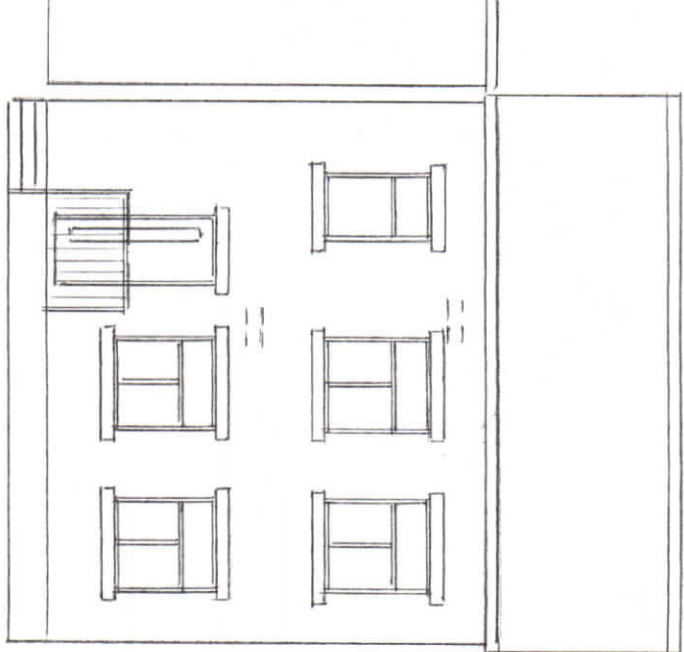


FRONT ELEVATION

AS BUILT

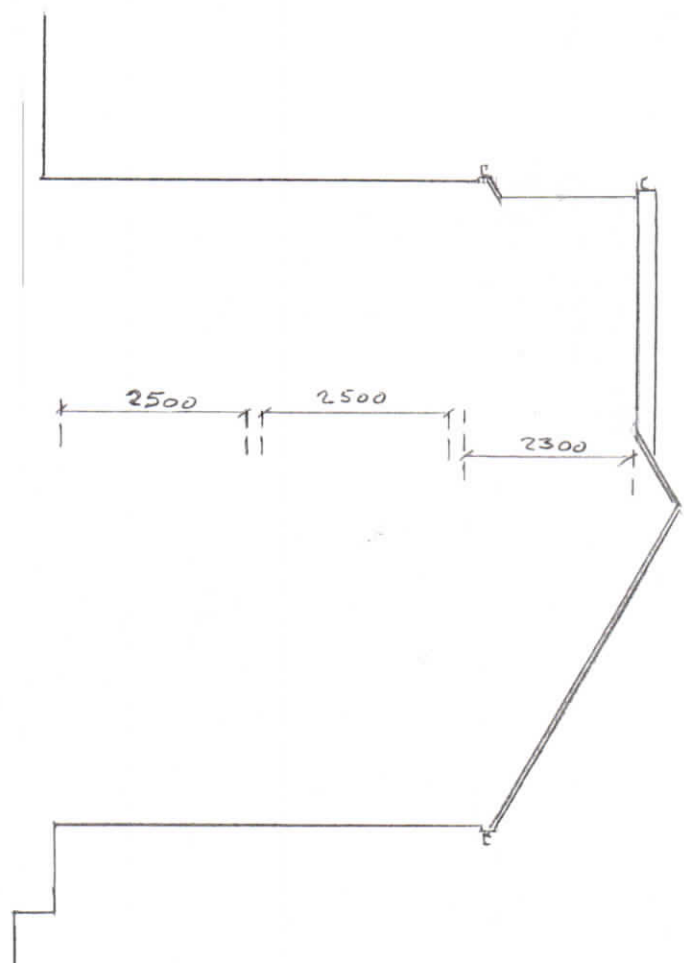

SIDE ELEVATION

AS BUILT

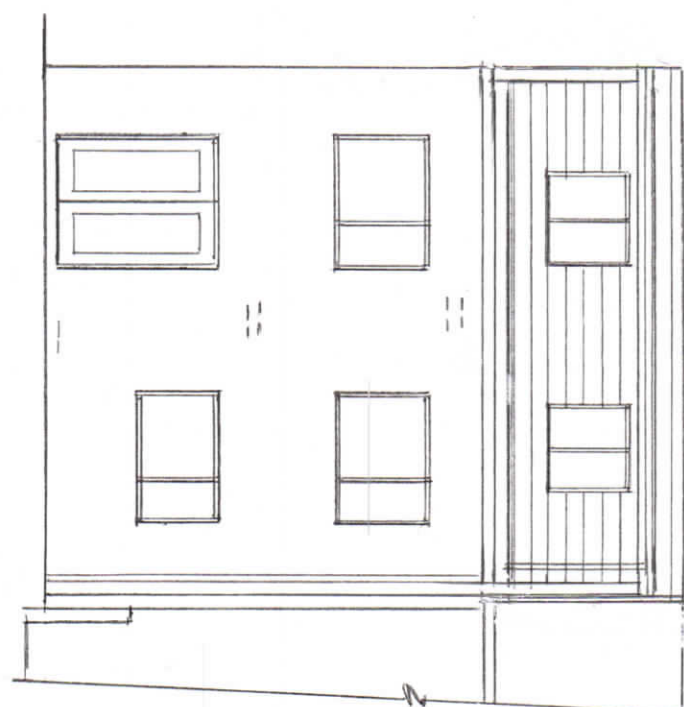

REAR ELEVATION


AS BUILT

300 1800 1800 300

1200 1200 1200 1200


RAFTERS 47x195 C24
@ 400 o/c

FLAT ROOF JOISTS
47x172 C16 @ 450 o/c

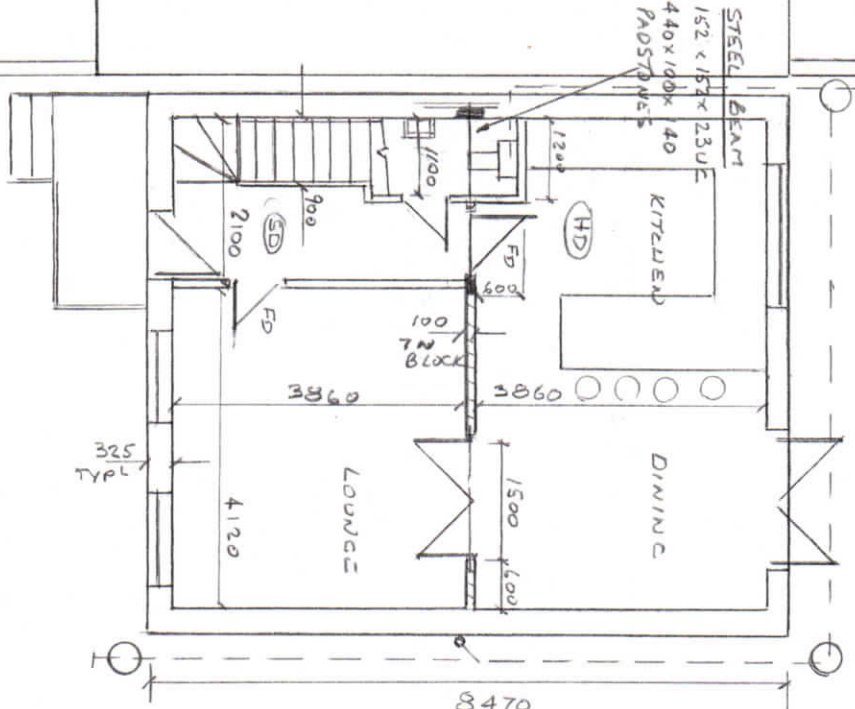


GROUND FLOOR PLAN

AS BUILT

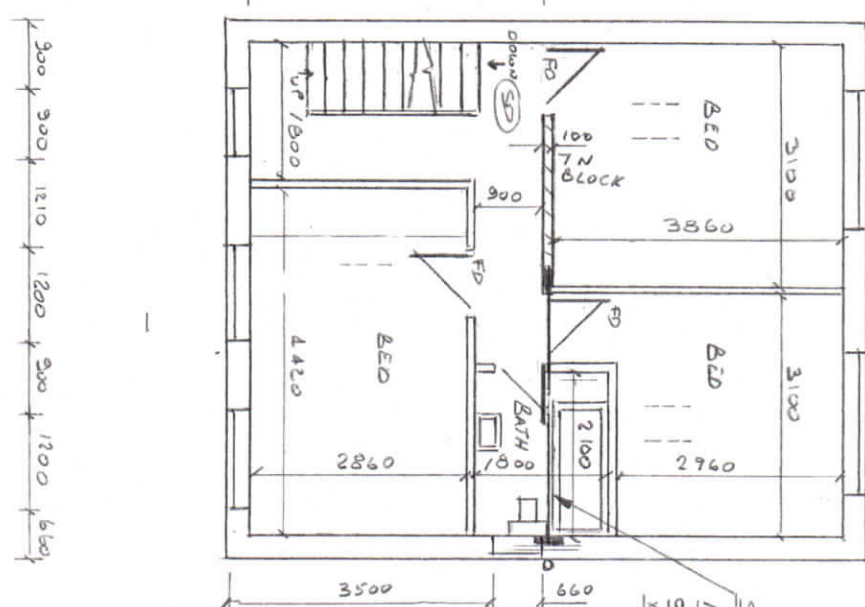

FIRST FLOOR PLAN

AS BUILT

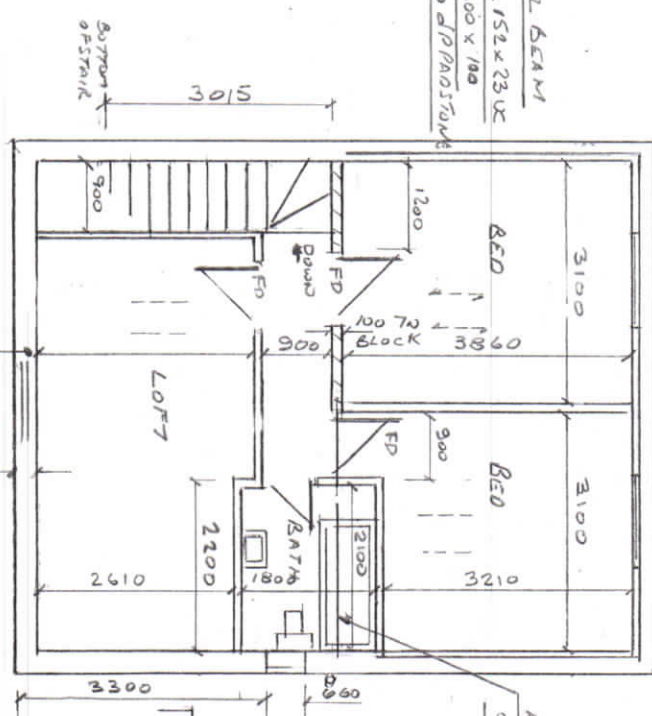

LOFT PLAN AS BUILT

ALL WALLS 100 & U/125 Cavity
100 TU BLOCK

SIDE ELEVATION

AS BUILT

Thompson Designs
Tel 0161 705 1458 Mob 07884 318634

PLANS AS BUILT
49 LITTLE DALE STREET
BOCHDALE OL12 6SZ

Aug 2020 SCALE 1:100

Rev 3