


Conway Architectural Design shall have no responsibility for any use made of this document other than for that which it was prepared and issued. This drawing should not be scaled. Work to figured dimensions only.
All dimensions and levels to be checked on site. No building work is to be started until all relevant approvals are in place.
Any discrepancies should be reported to Conway Architectural Design.
This drawing should not be reproduced without written permission from Conway Architectural Design.
Standard Building Regs Notes are to be provided by Conway Architectural Design prior to a building regs application being submitted.

Fence Materials
Vertical panels fixed to timber posts.

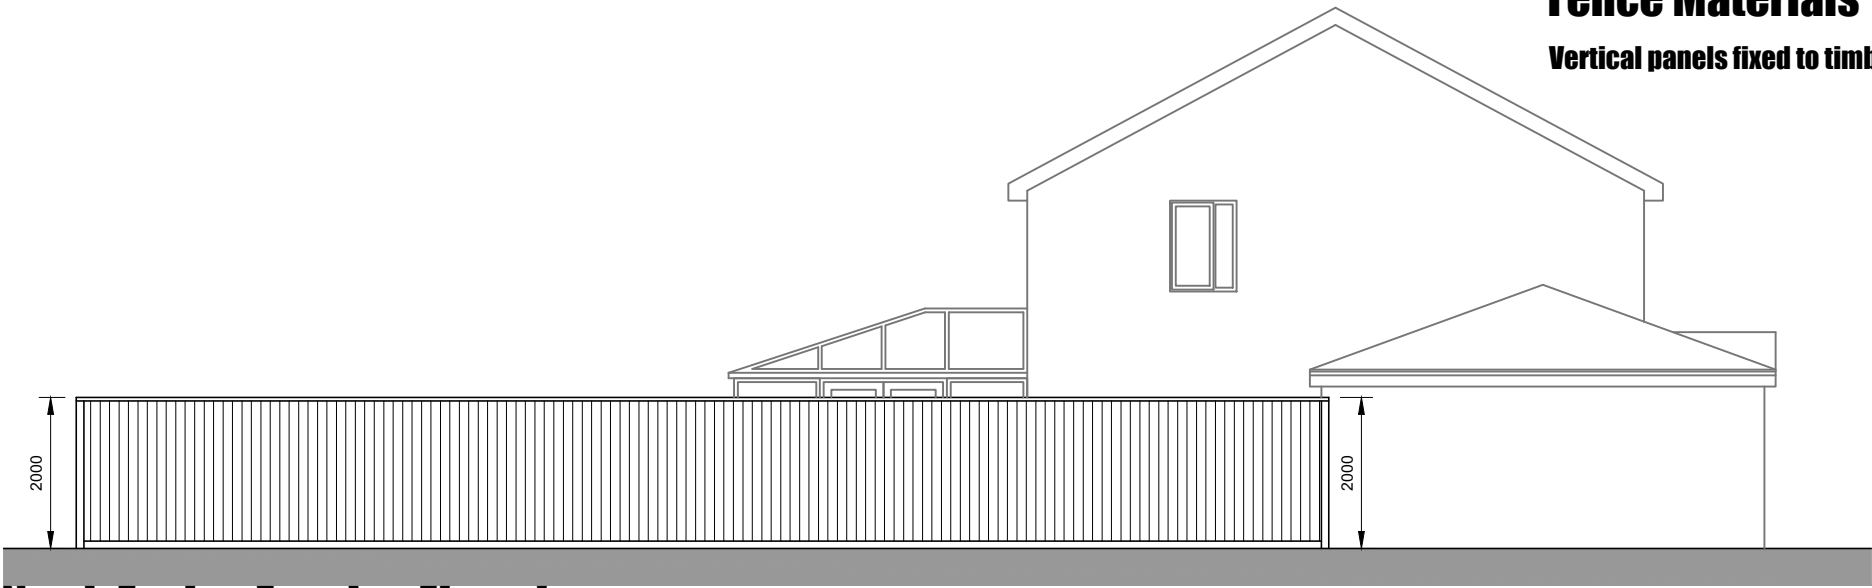

North Facing Fencing Elevation

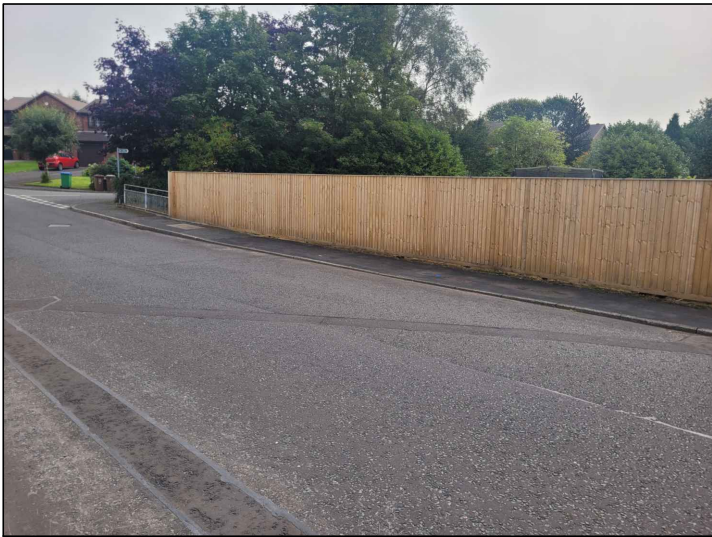


Photo Of Fence 01


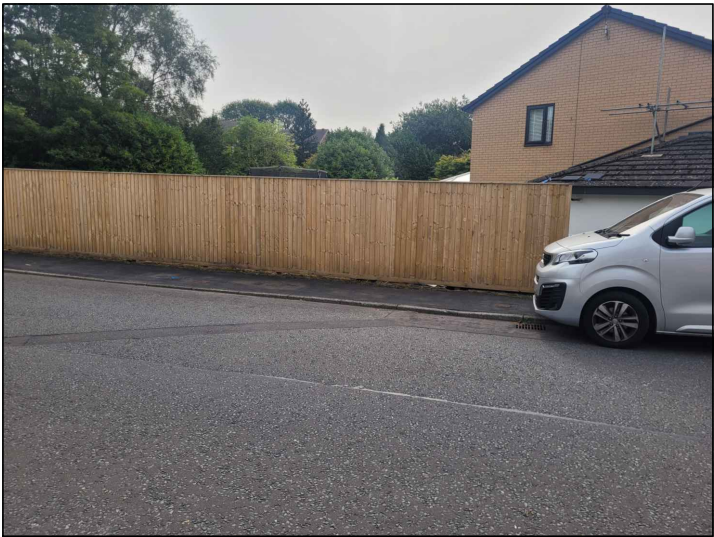


Photo Of Fence 02

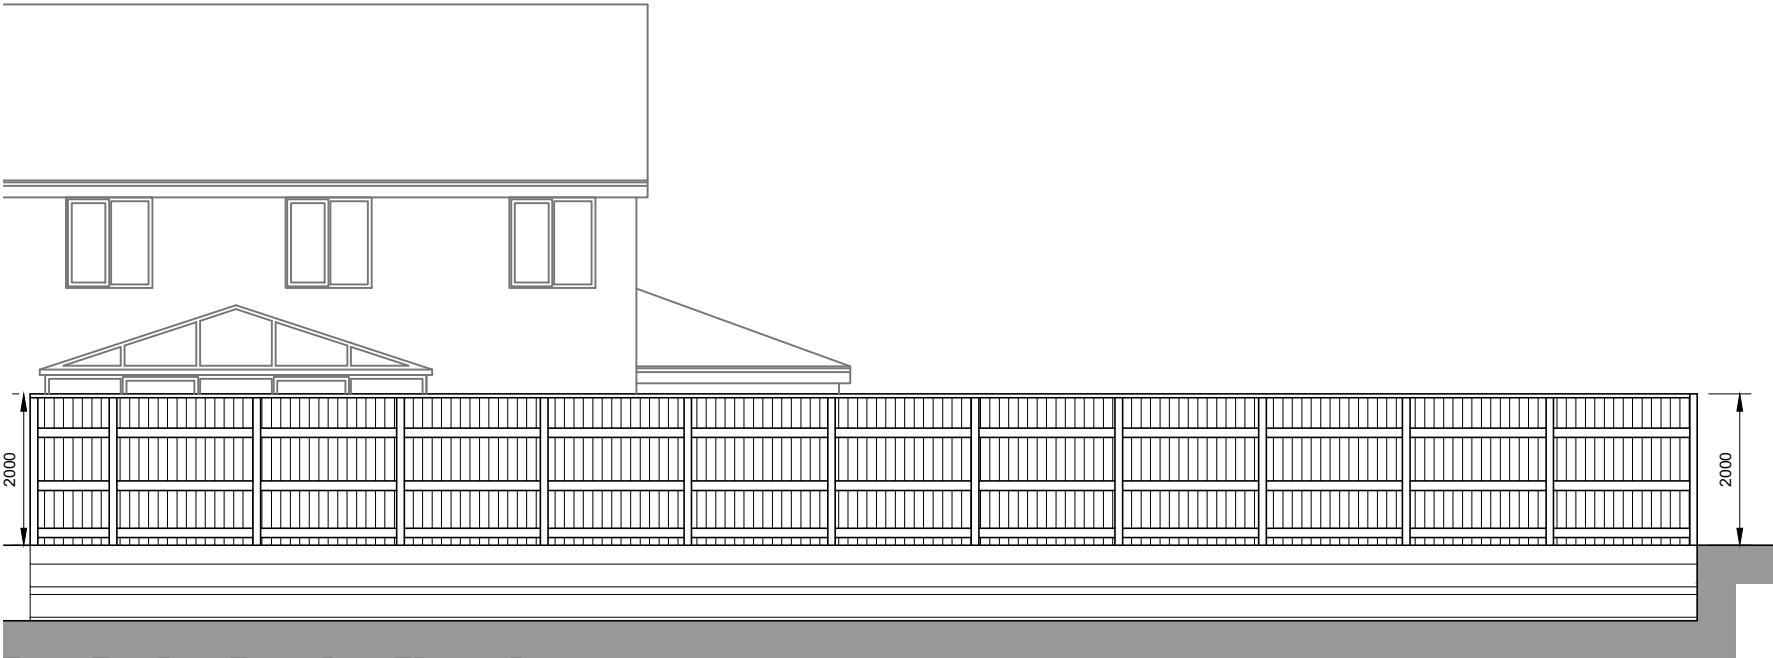

East Facing Fencing Elevation



Photo Of Fence 03

**Conway
Architectural
Design**

6 Conway Close
Alkington
Middleton
Manchester, M24 1EW
E: conway-design@outlook.com

JOB TITLE : 2 Storey Side, Single Storey Rear Extension
ADDRESS : 137 Starring Way, Littleborough
DRAWING TITLE : As Built Fence Elevations
SCALE : 1:100 @ A3
DRAWN : xxx
DATE : 14.09.23

JOB NO./
DWG NO.

780-11