

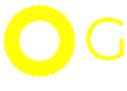


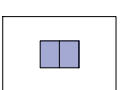

- Legend
-  Incoming Gas Supply
 -  Incoming Electric Supply
 -  PV
2 panels (0.8KW)
 -  PV
3 panels (1.2KW)

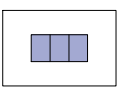



As built photo of PV panels

Rev	Date	Comments	By
-	-	-	-

ACCOMMODATION SCHEDULE								
Housetype	Number	Mid	End	Def	Sqft	Bed Nos.	En-SU	Total Sqft
Yew	17	8	9	0	755	2	No	12835
Holly	20	2	16	2	911	3	No	18220
Oak	2	0	1	1	914	3	Yes	1828
Willow	10	4	6	0	1164	4	Yes	11640
TOTAL	49							44523
Gross Area					Acres			
Nett Area	2.6				Acres			
Coverage	17,124				Sqft/Acre			
Density	18.8				UPA			

Stonebond.

Stonebond Properties (Manchester)Ltd
Registered Office:
Suite 5, Egerton House
Towers Business Park
Wilmslow Rd
Didsbury, M20 2DX

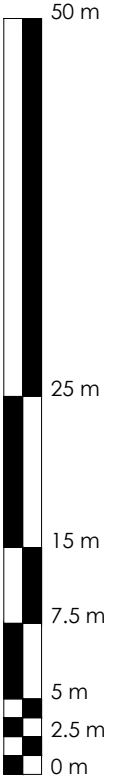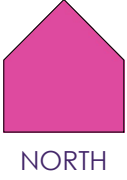

site:	Edenfield Rd Norden Rochdale		
title:	Services Layout		
scale: @A1	1:500	drawn by:	AC
date:	Sept 23	checked:	
drawing no:	SBM-001-SerL01		
sheet no:	Sheet 1 of 1	revision:	-