


©TRIANGLE ARCHITECTS LIMITED

- THIS DRAWING IS THE SUBJECT OF COPYRIGHT WHICH VESTS IN TRIANGLE ARCHITECTS LIMITED. IT IS AN INFRINGEMENT OF COPYRIGHT TO REPRODUCE THIS DRAWING, BY WHATEVER MEANS, INCLUDING ELECTRONIC, WITHOUT THE EXPRESS WRITTEN CONSENT OF TRIANGLE ARCHITECTS LIMITED WHICH RESERVES ALL ITS RIGHTS.
- TRIANGLE ARCHITECTS LIMITED ASSERTS ITS RIGHTS TO BE IDENTIFIED AS THE AUTHOR OF THIS DESIGN.
- DRAWING NOT TO BE SCALED. FIGURED DIMENSIONS TO BE WORKED TO IN ALL CASES.
- THE CONTRACTOR IS RESPONSIBLE FOR CHECKING DIMENSIONS, TOLERANCES & REFERENCES.
- ANY DISCREPANCY TO BE VERIFIED WITH THE ARCHITECT BEFORE PROCEEDING WITH THE WORKS.
- REPORT ERRORS & OMISSIONS TO ARCHITECT.
- WHERE AN ITEM IS COVERED BY DRAWINGS OF DIFFERENT SCALES, THE LARGER SCALE DRAWING TO BE WORKED TO. DO NOT SCALE FROM THE DRAWING. FIGURED DIMENSIONS TO BE WORKED TO IN ALL CASES.
- CHECK ALL DIMENSIONS ON SITE.
- DRAWING TO BE READ IN CONJUNCTION WITH THE HEALTH & SAFETY PLAN, AND ALL RELEVANT RISK ASSESSMENTS AND THE FOLLOWING DRAWINGS:

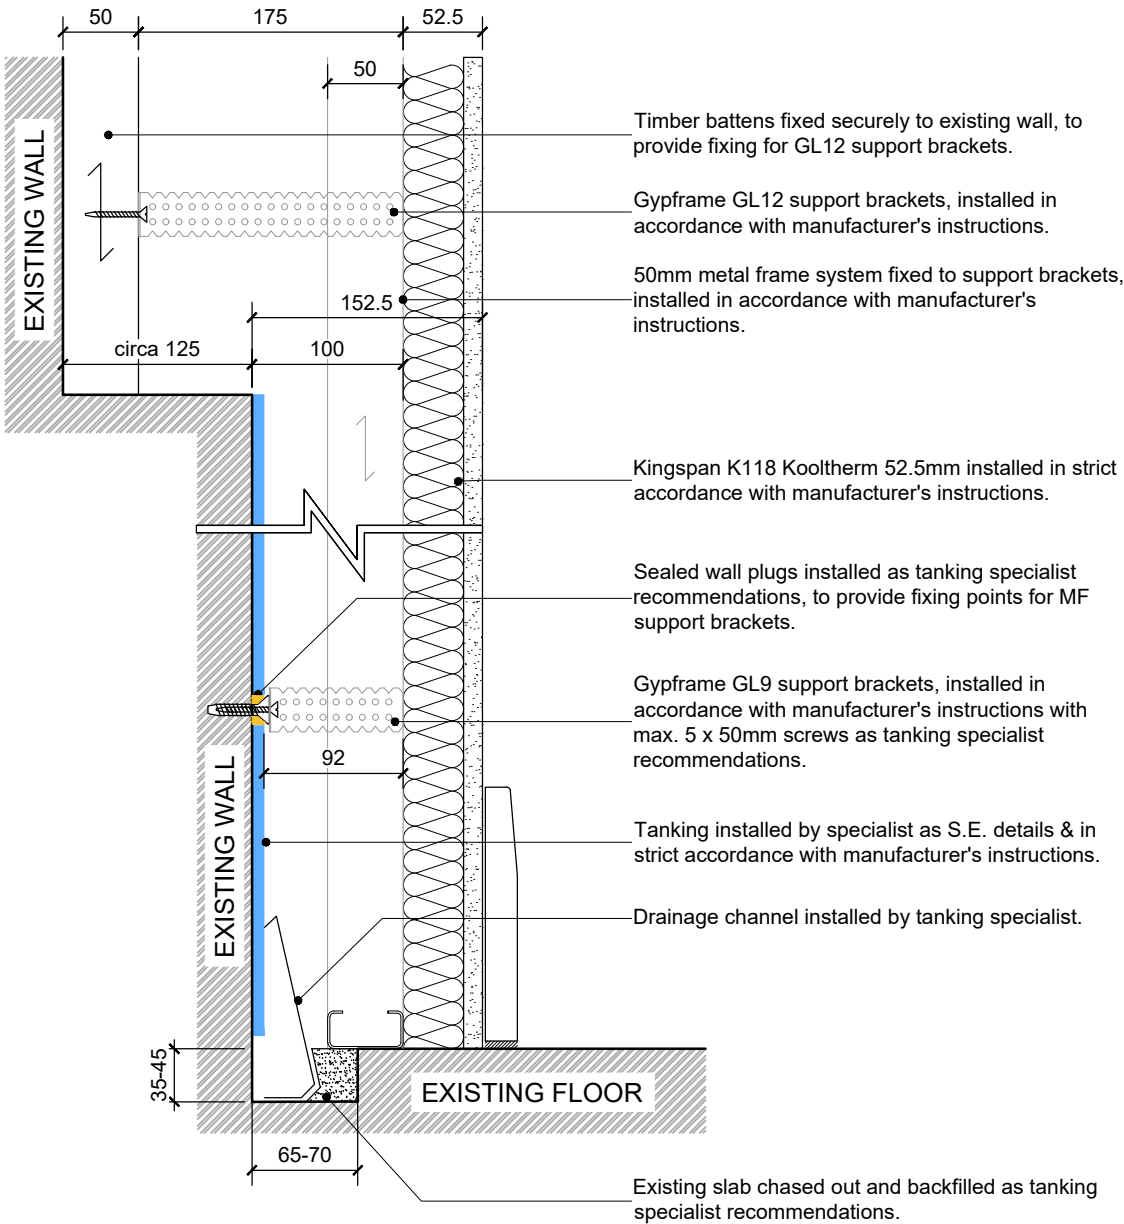

scale 1:5 0 0.25m

Revision	Date	By	Remarks	Date:	Scale	Project Number:	Drawing Number:	Drawing Purpose:	 TRIANGLE ARCHITECTS Tel: 0161 272 3500 Web: www.trianglearchitects.co.uk E-mail: studio@trianglearchitects.co.uk Twitter: @TriangleArch Raven House, 113 Fairfield Street, Manchester, M12 6EL	Client:						
C03	18.09.23	JS	As built handover drawings.	May 2023	1:5@A3	21-051	Refer to CDE No.	CONSTRUCTION		Project:						
C02	06.06.23	JS	Support frame taken down to basetrack, as contractor comments.	Drawn:	Checked:	Status:	Project	Originator		Vol/Sys	Level	Type	Role	No:	Revision:	Drawing:
C01	02.06.23	JS	Issued for comment.	JS		-	SMI	TRI		XX	XX	DR	A	5611	C03	Basedrain Boxing-in Detail