





01 Proposed Northwest Section 1
Scale 1:100 @ A1

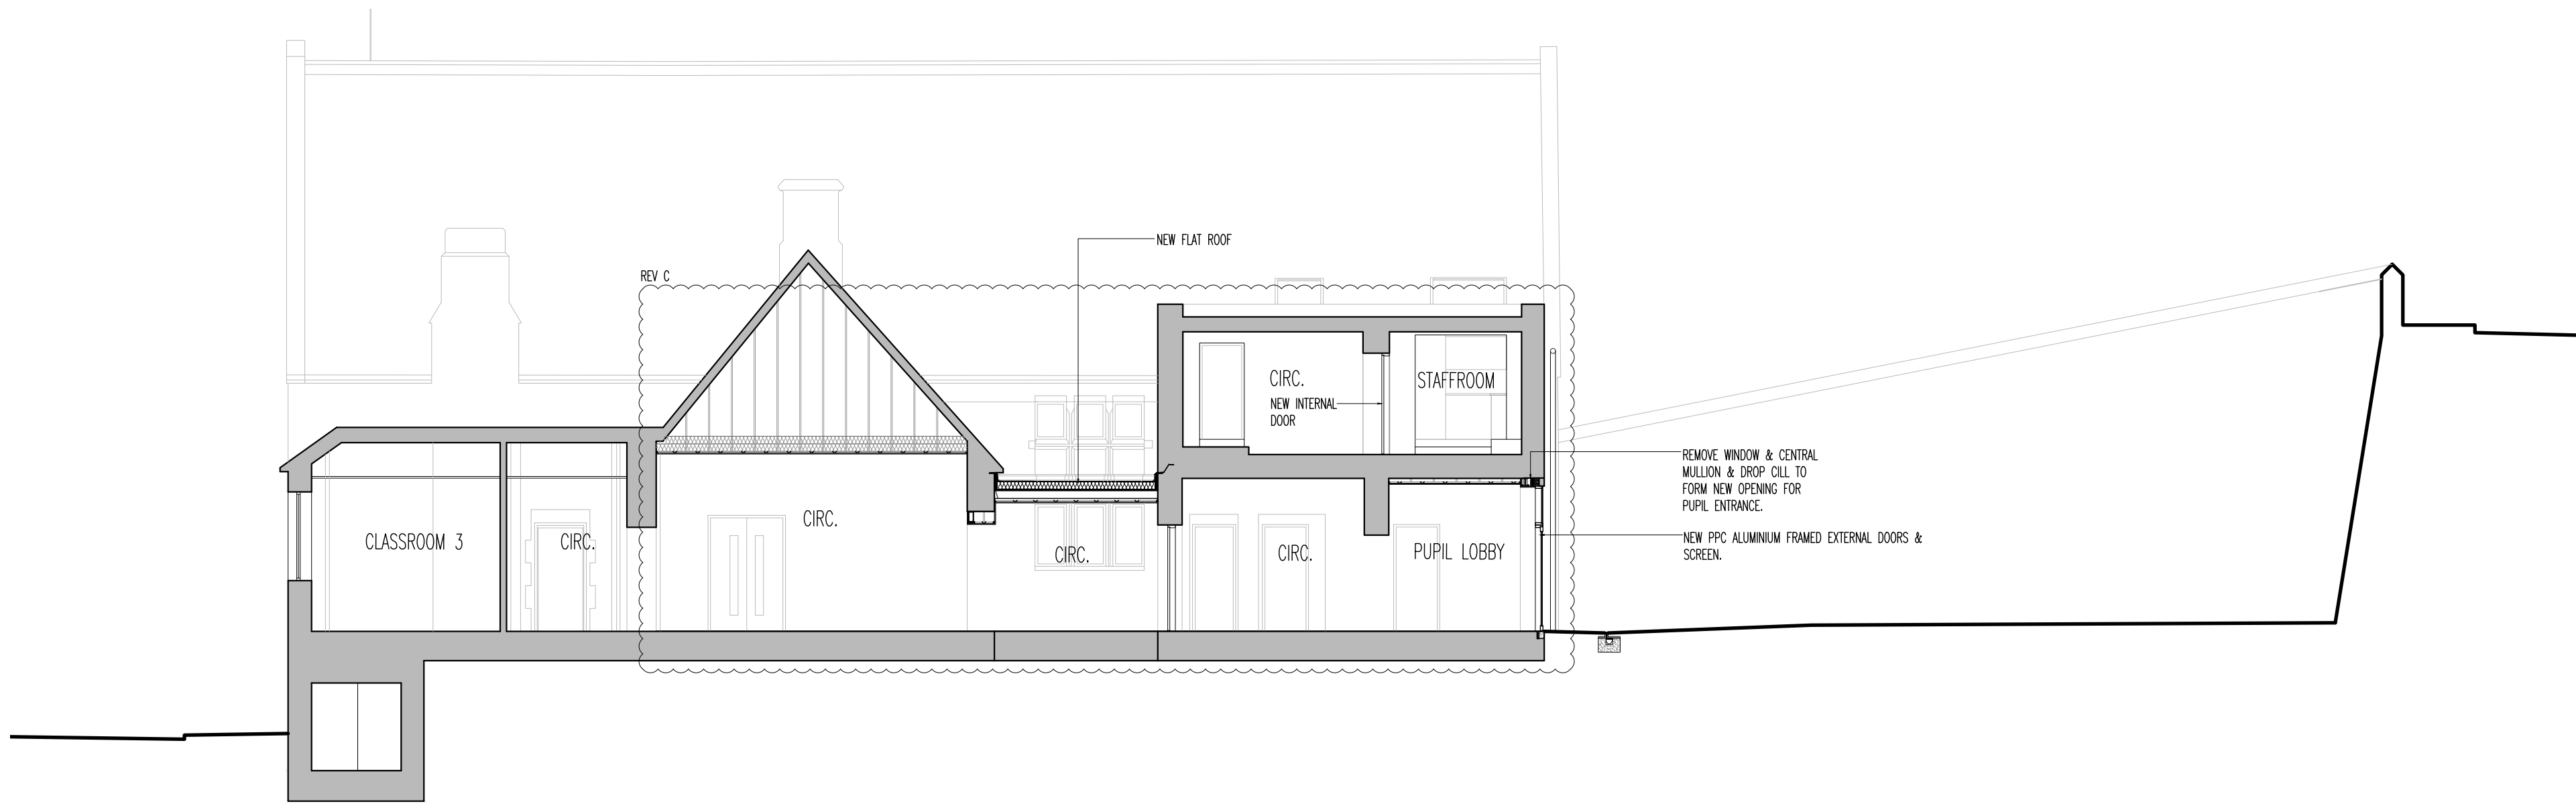

02 Proposed Northwest Section 2
Scale 1:100 @ A1

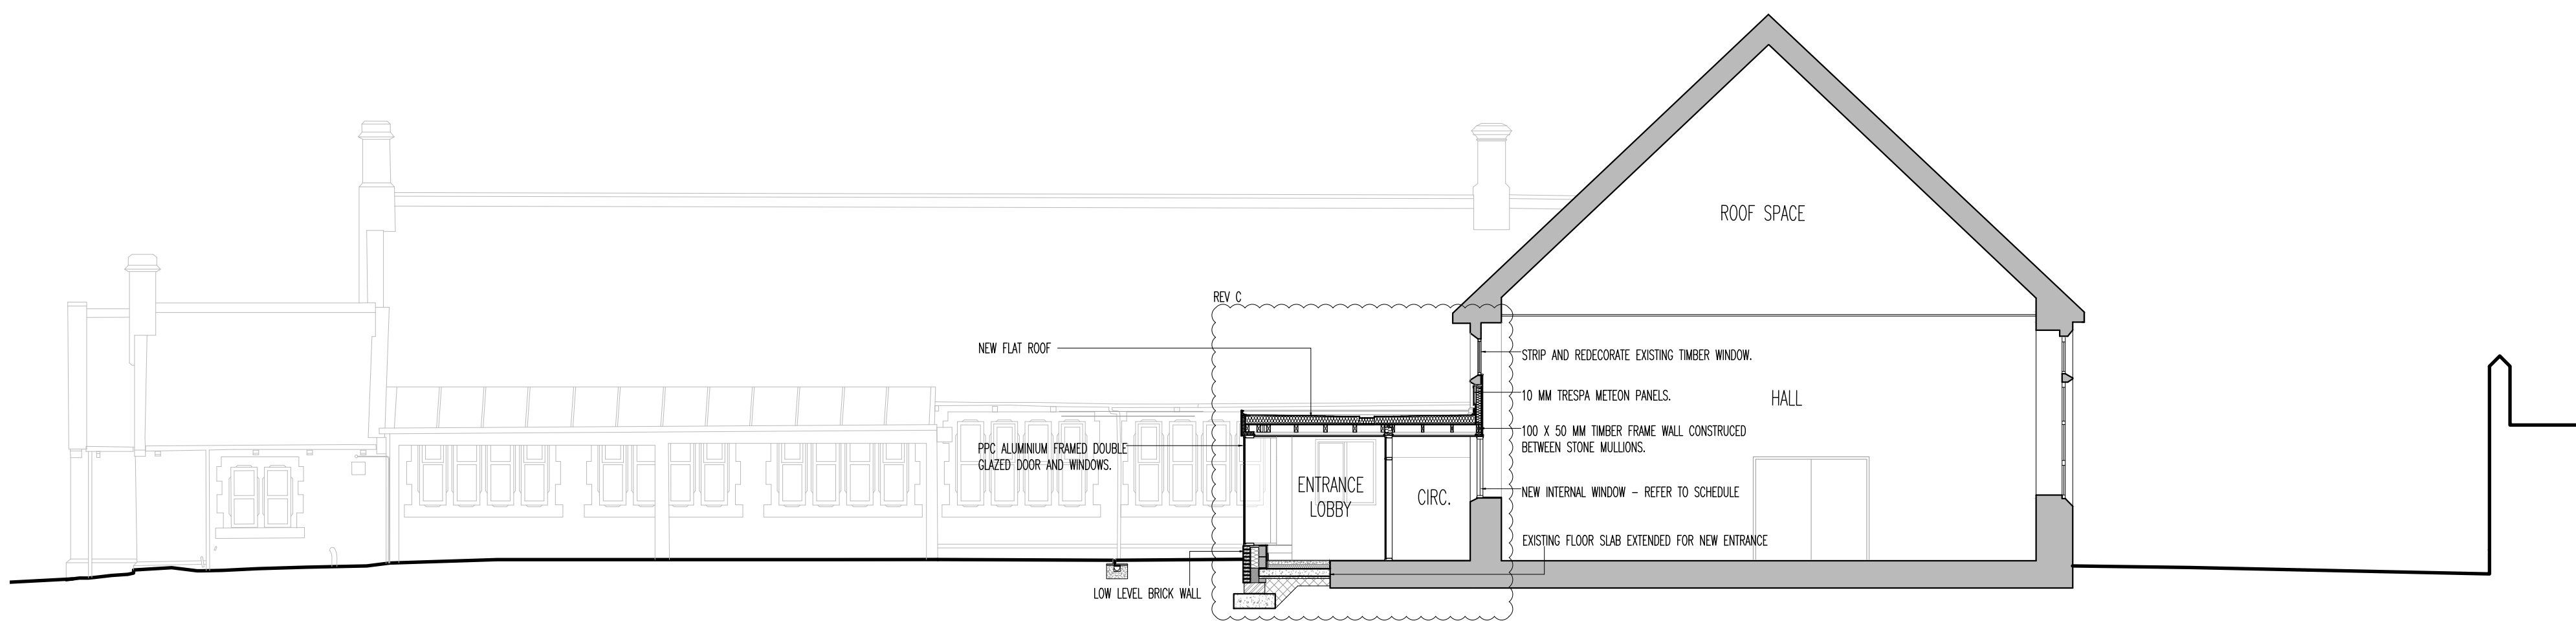

03 Proposed Southwest Section
Scale 1:100 @ A1

C	UPDATED SCOPE OF WORKS.	20.05.24	RB	MDM
B	AREAS OF WORK LABELS ADJUSTED.	25.10.23	RB	MDM
A	PROPOSED DESIGN UPDATED.	04.07.23	SM	MT
Rev	Description	Date	By	Chk

Status	Purpose for Issue
Planning ☒ Tender ☐	
Construction ☐ As Built ☐	PLANNING

Client
THE GOVERNORS OF ST. THOMAS' C. OF E.
PRIMARY SCHOOL, NEWHEY, ROCHDALE

Contract
PROPOSED NEW ENTRANCE, ADMIN BLOCK
+ TOILETS

Drawing
PROPOSED SECTIONS

bateandtaylor
architects
www.bate-taylor.co.uk

macintosh house
cambridge street
manchester m1 5gg
tel: 0161 236 0999
fax: 0161 236 0404
mail@bate-taylor.co.uk

Drawing No.	MH1339-13	Revision	C
Scales	1:100 @ A1	Date	SEPT '23
Drawn	SM	Checked	MDM

This drawing is the copyright of the Architect and may not be reproduced without licence.
DO NOT scale from this drawing.