

VDI_A2_113 Printed By: William Evans on 25.09.2023 at 12:38 PM

GENERAL NOTES:

ALL BUILDERS WORK IS TO BE CONSTRUCTED IN ACCORDANCE WITH THE CURRENT AND RELEVANT BUILDING REGULATIONS AND BRITISH STANDARDS. MANUFACTURERS INSTALLATION/ GUIDANCE NOTES ARE TO BE READ IN CONJUNCTION TO TASK BEING CARRIED OUT.

ALL DIMENSIONS ON DRAWING ARE IN MILLIMETERS UNLESS OTHERWISE STATED. ALL LEVELS ON DRAWING ARE IN METERS UNLESS OTHERWISE STATED.

THE CONTRACTOR SHALL BE RESPONSIBLE FOR THE ACCURACY OF ALL DIMENSIONS AND FOR THE CORRECT SETTING OUT OF WORK CARRIED OUT ON SITE.

THIS DRAWING IS TO BE READ IN CONJUNCTION WITH ALL RELEVANT ARCHITECTURAL, STRUCTURAL AND MECHANICAL DRAWINGS/ SPECIFICATIONS ISSUED.

ALL MATERIALS AND WORKMANSHIP SHALL BE IN ACCORDANCE WITH THE RELEVANT SPECIFICATIONS AND BRITISH STANDARDS


THE CONTRACTOR SHALL ENSURE THE STABILITY OF THE BUILDING AND ANY ADJOINING STRUCTURES IS MAINTAINED AT ALL STAGES OF CONSTRUCTION. THE CONTRACTOR SHALL DESIGN, INSTALL AND MAINTAIN ANY NECESSARY TEMPORARY WORKS.

CONTRACTOR TO PROVIDE METHOD STATEMENTS AND RISK ASSESSMENTS TO THE ENGINEER AND PLANNING SUPERVISOR A MINIMUM OF 14 DAYS BEFORE THE WORKS COMMENCE


THIS DRAWING IS TO BE READ IN CONJUNCTION WITH:




RIGHT ELEVATION
SCALE 1:30

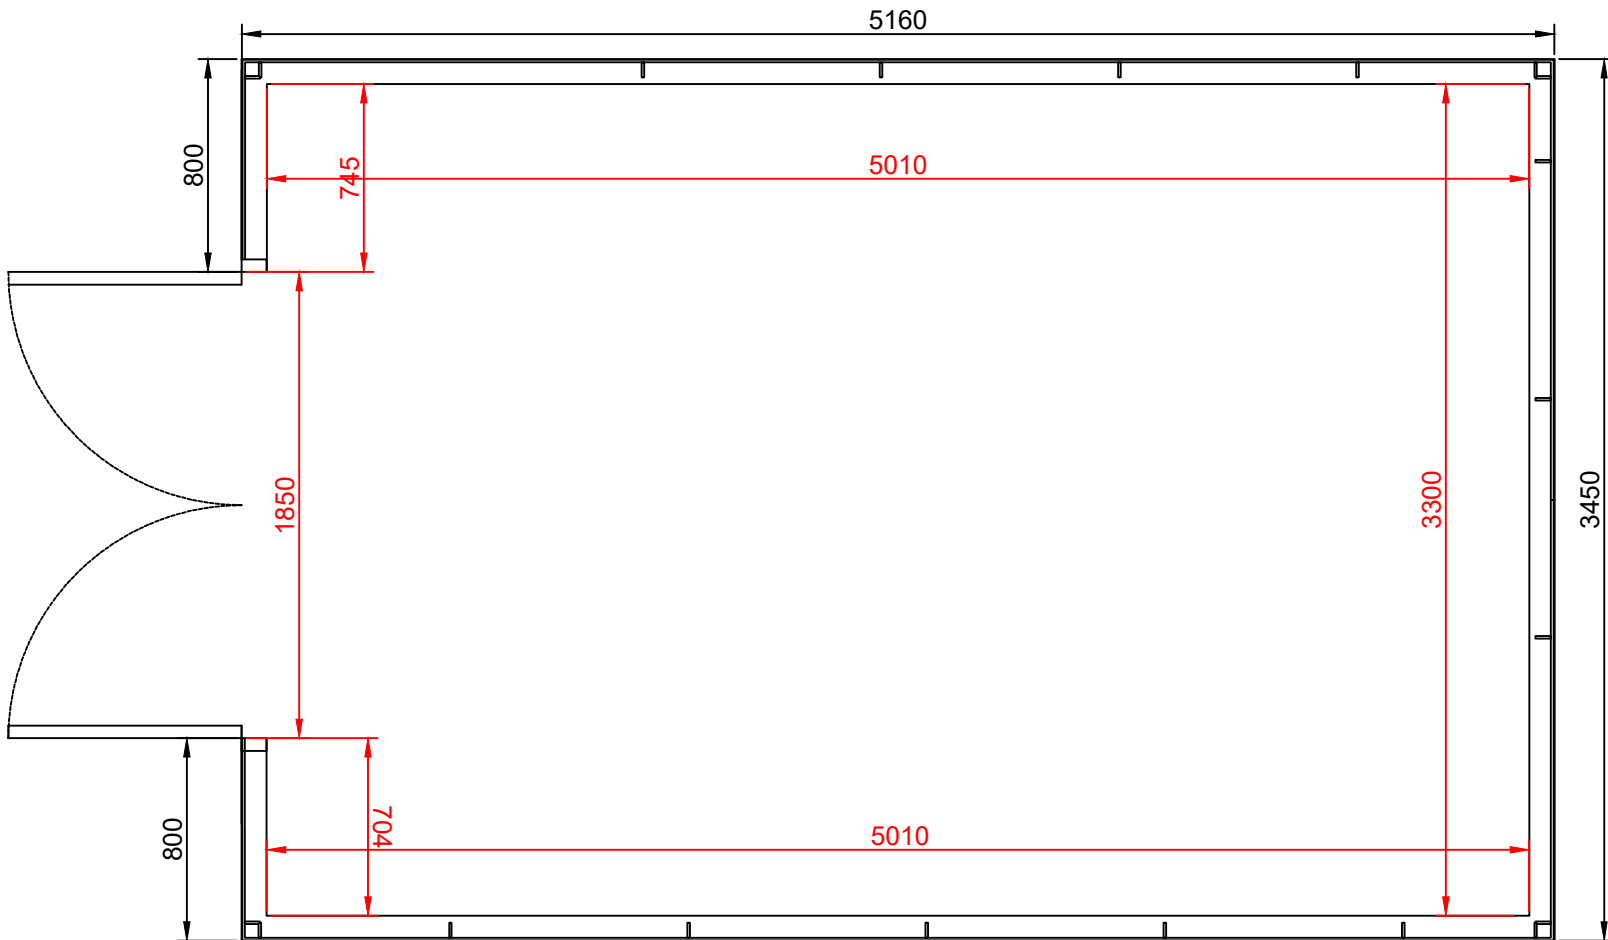


PLAN VIEW
SCALE 1:30

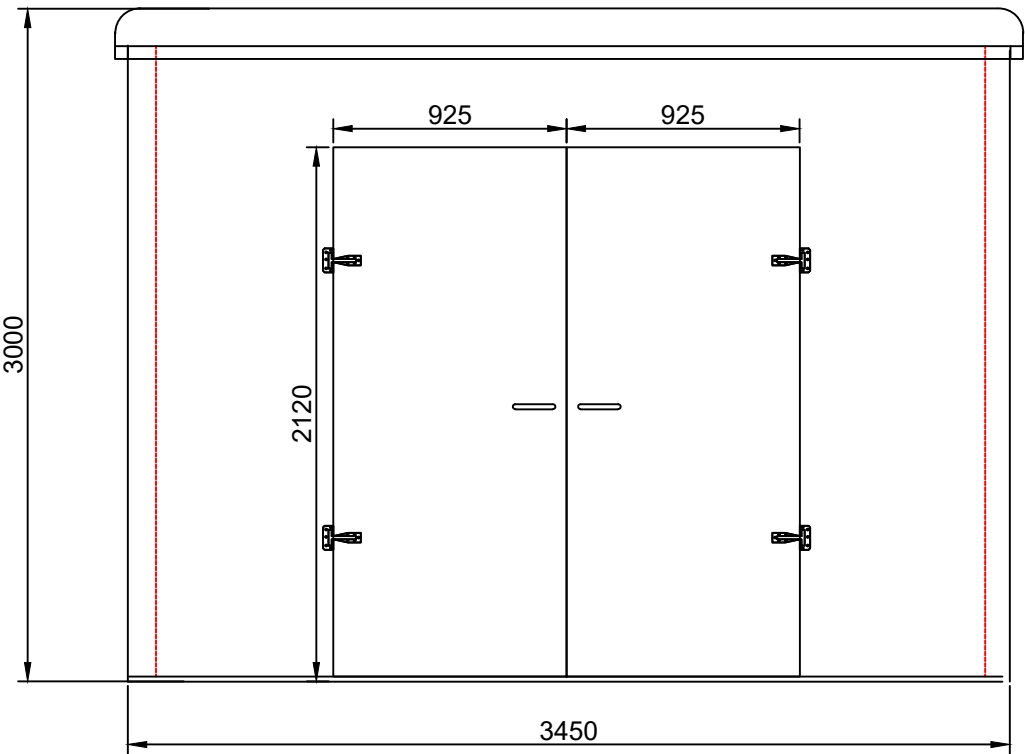

FRONT ELEVATION
SCALE 1:30

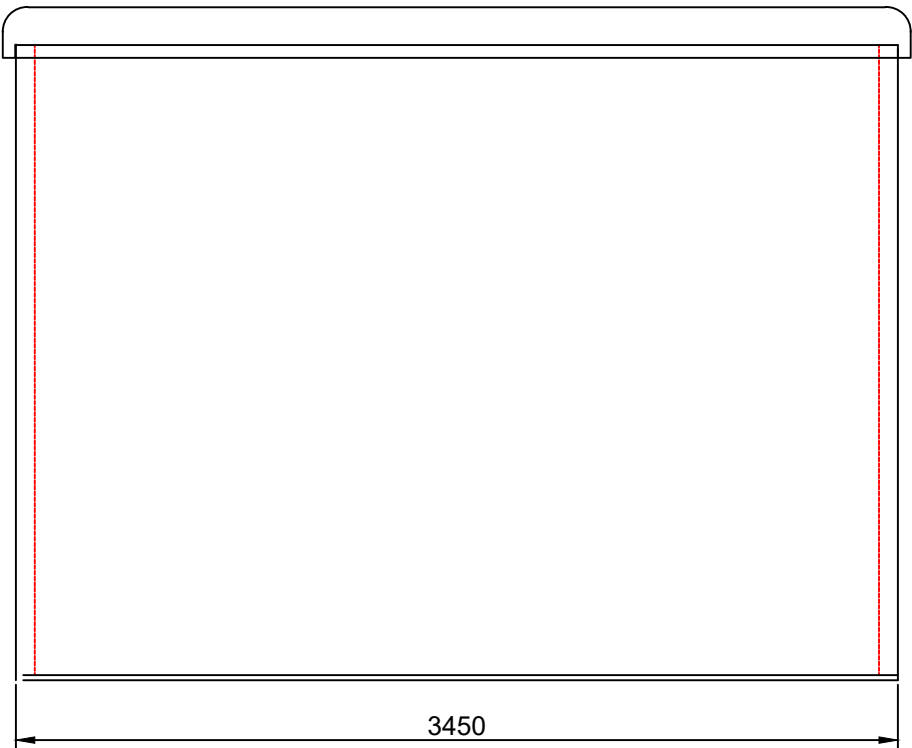

REAR ELEVATION
SCALE 1:30

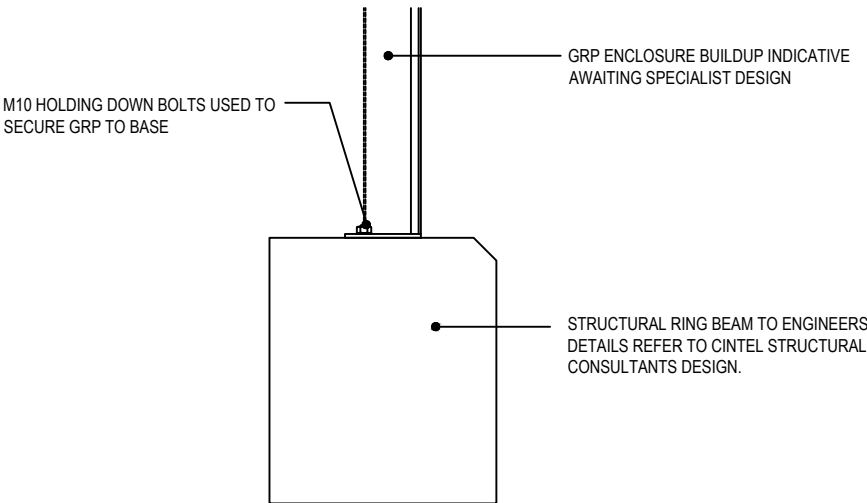

BASE & GRP JUNCTION DETAIL
SCALE 1:10



LEFT ELEVATION
SCALE 1:30

AS-BUILT / HANDOVER

VITAL
ENERGI

Vital Energi, Century House, Roman Road, Blackburn, Lancashire, BB1 2LD
Tel: +44 (0)1254 296 000 Fax: +44 (0)1254 296 040

Project: CHAMBER HOUSE					
Title: SWITCH GEAR GRP LAYOUT AND ELEVATIONS					
DATE	15.03.2023	SCALE	1:30	SHEET	A2
AS-BUILT				Status: AB	Stage: 6
50716-VE-SW-XX-DR-A-XX10				Drg-No:	Rev: AB

AB	25.09.23	AS-BUILT / HANDOVER	WE	RJR	BMc
REV	DATE	DESCRIPTION	DRW	CKD	APP