
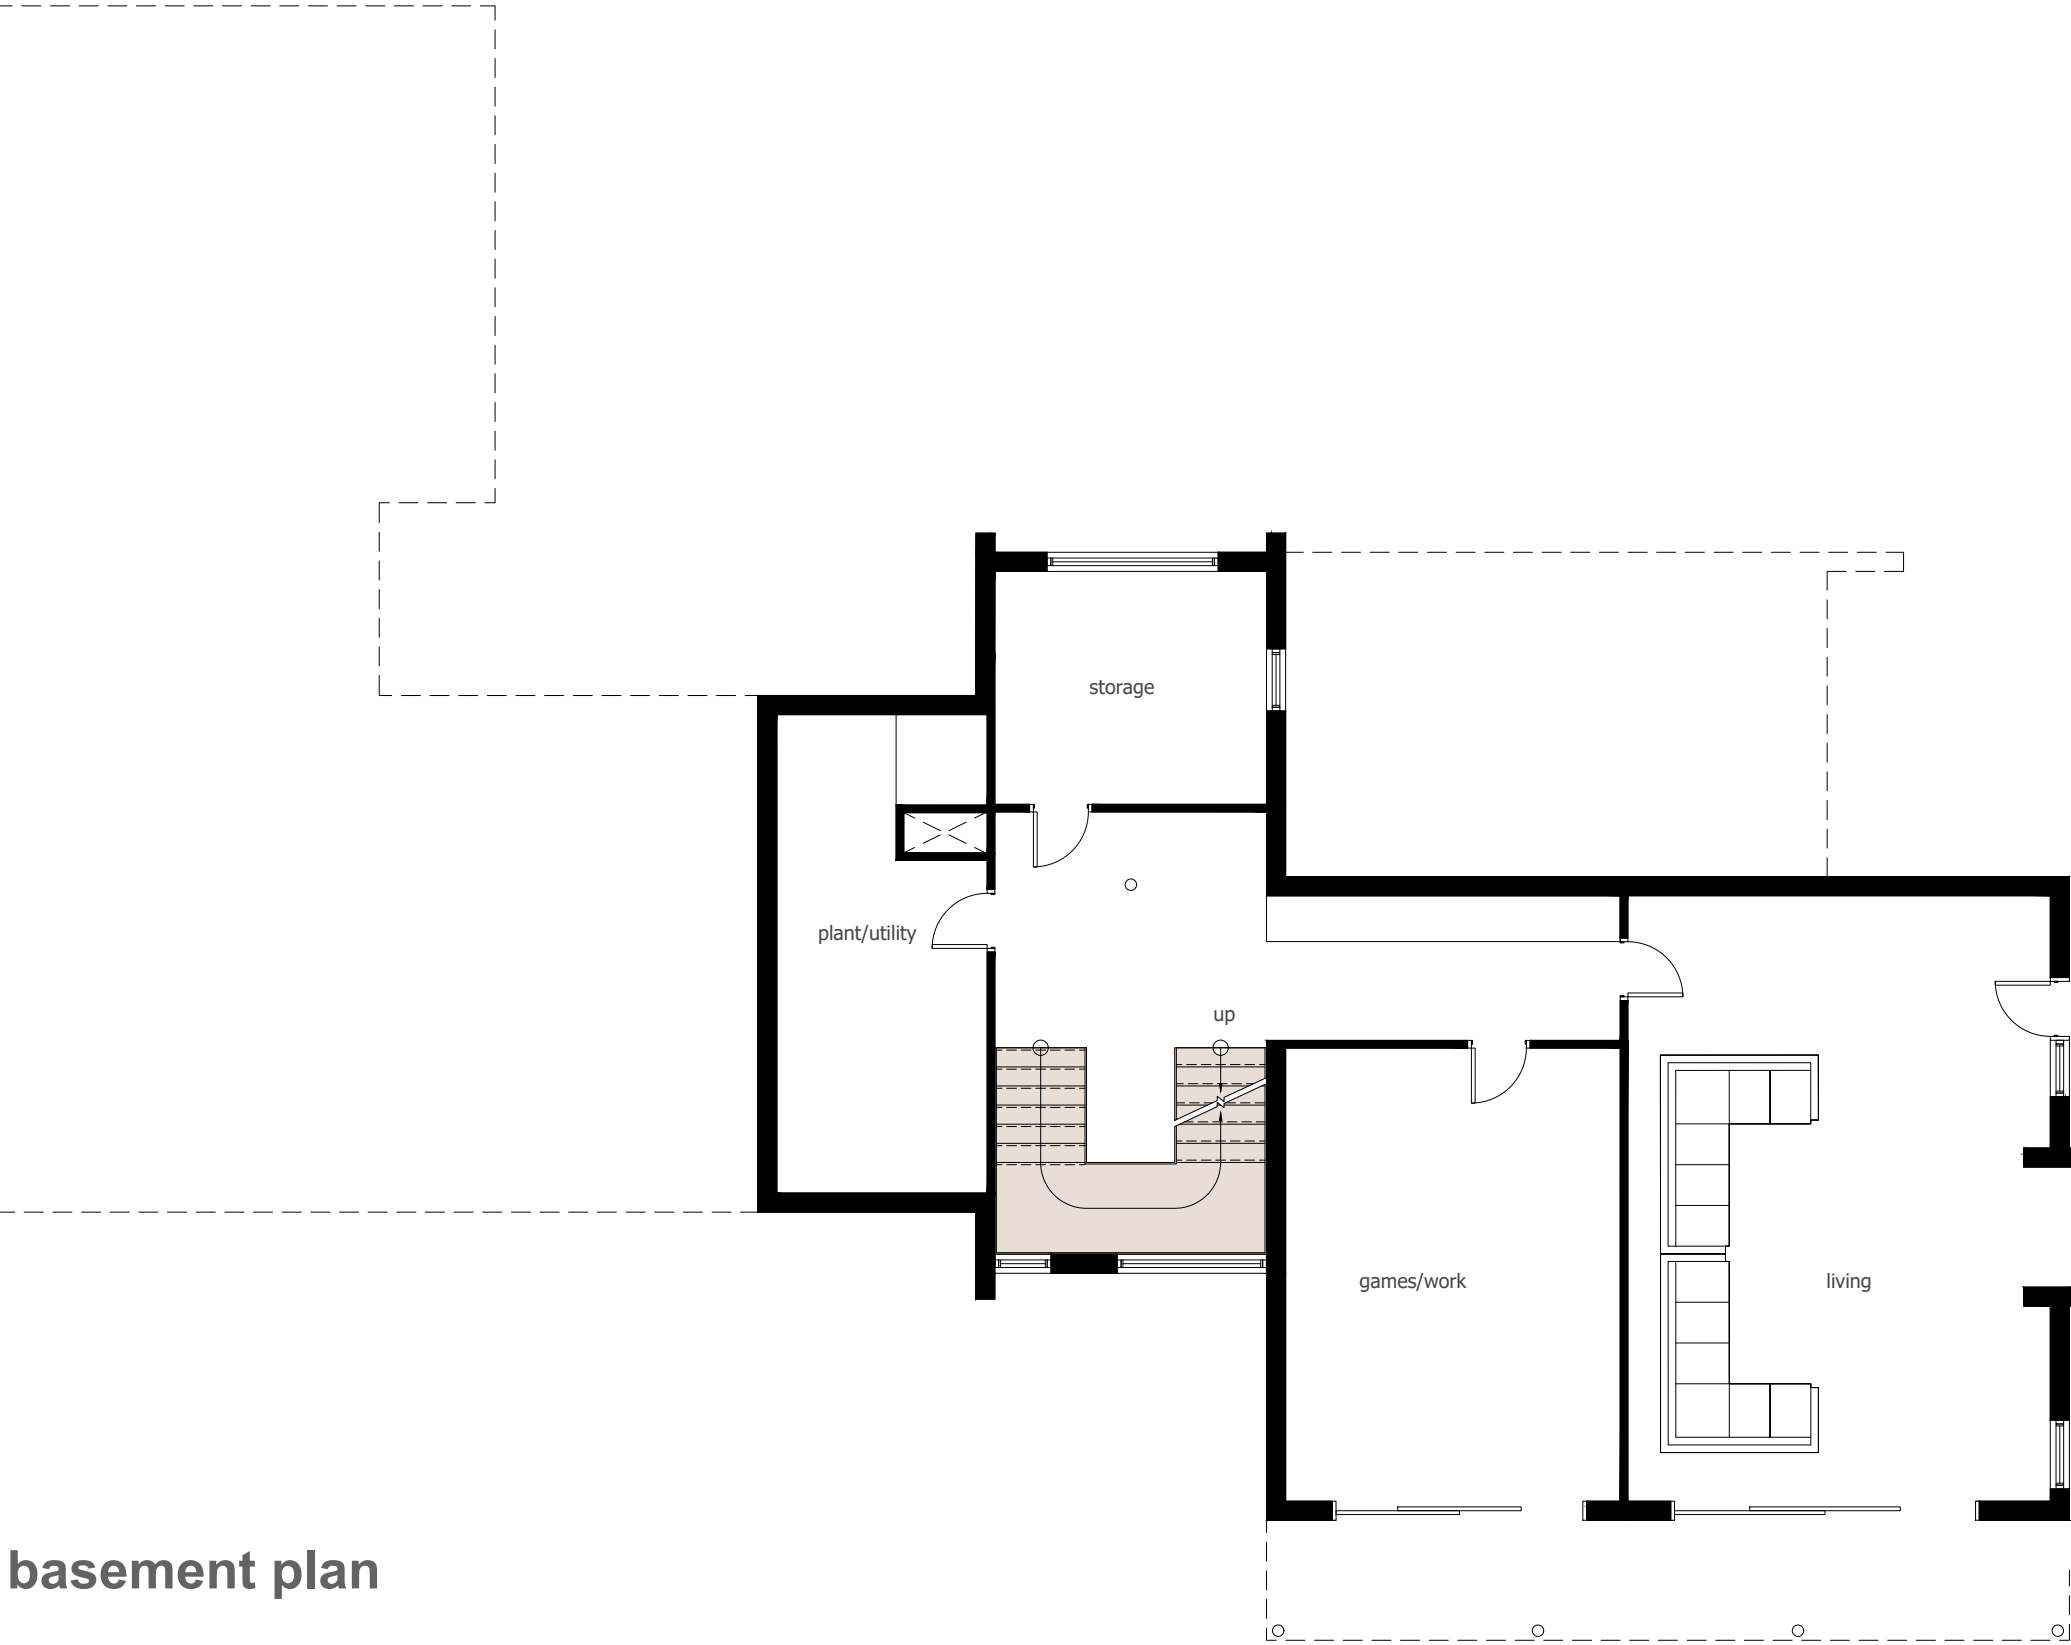


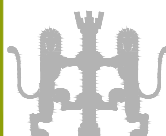

basement plan

Kieren and Jo McDonnell Proposed Eco Home Mill House Farm Overtown Lane Norden	Basement Plan AS BUILT	contract no 3396	drawing no 16	revision A	Revisions: A. Living room and games/work room area re-measured reduced in size correspondingly.PDC.03.10.2023	Blue Pit Mill Queensway Castleton Rochdale OL11 2PG +44 (0)1706 631347 info@cjpartnership.com www.cjpartnership.com	CJPARTNERSHIP ENVIRONMENTAL ARCHITECTS	
	work to figured dimensions							
	© CJ Partnership owns the copyright of this design / drawing which must not be reproduced in whole or in part without the written permission of CJ Partnership	drawn by PDC	date November 2015	scale @ A3 1:100				