


Conway Architectural Design shall have no responsibility for any use made of this document other than for that which it was prepared and issued. This drawing should not be scaled. Work to figured dimensions only. All dimensions and levels to be checked on site. No building work is to be started until all relevant approvals are in place. Any discrepancies should be reported to Conway Architectural Design. This drawing should not be reproduced without written permission from Conway Architectural Design. **Standard Building Regs Notes are to be provided by Conway Architectural Design prior to a building regs application being submitted.**

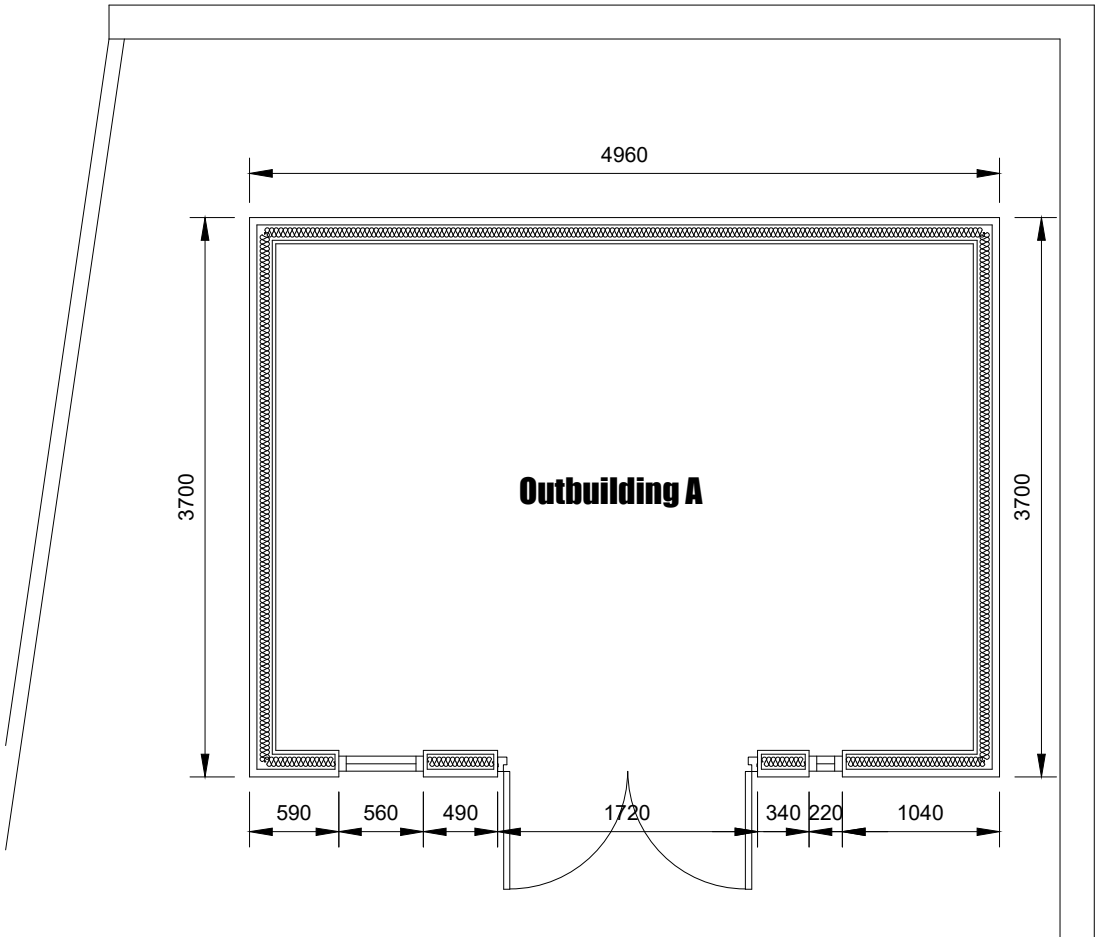

Floor Plan - Scale 1:50



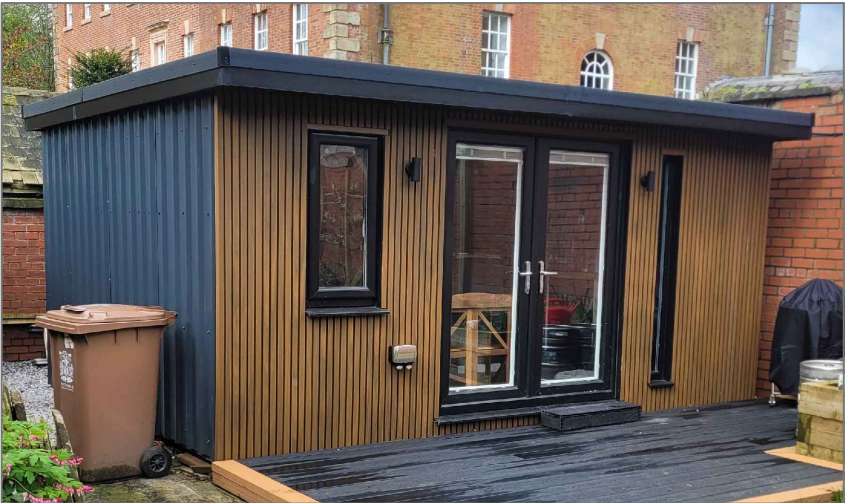



Photo Of Outbuilding A

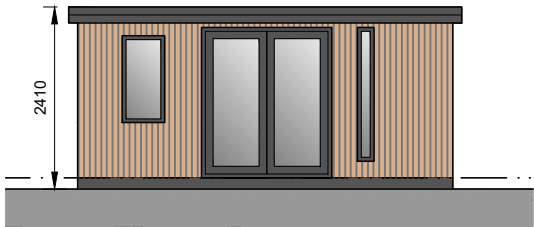


Front Elevation
Scale 1:100

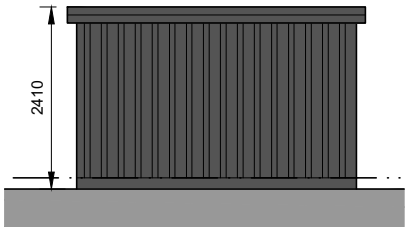

Left Side Elevation
Scale 1:100

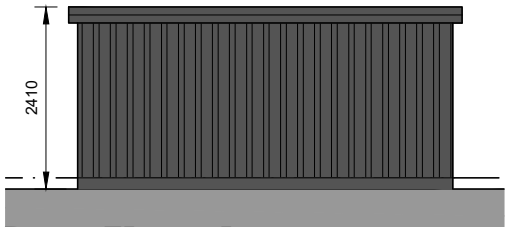


Rear Elevation
Scale 1:100

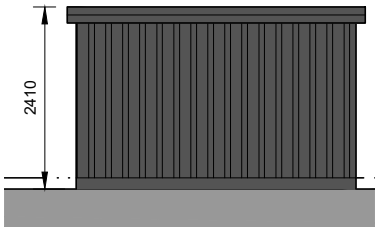

Right Side Elevation
Scale 1:100

Outbuilding A

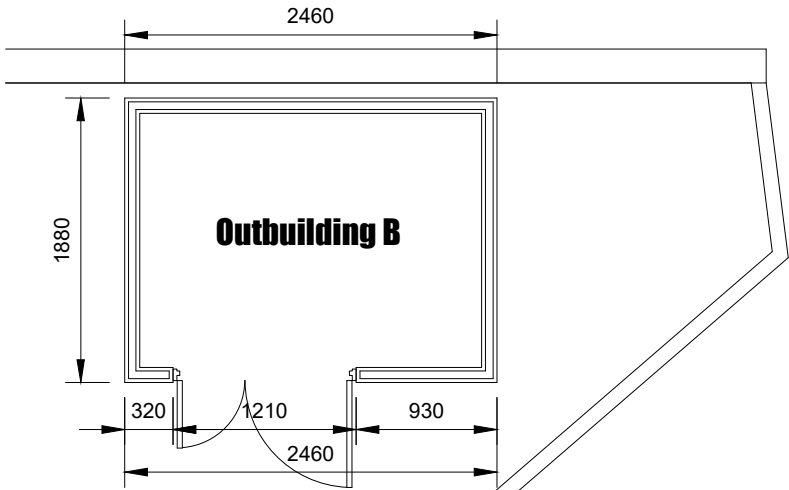

Floor Plan - Scale 1:50



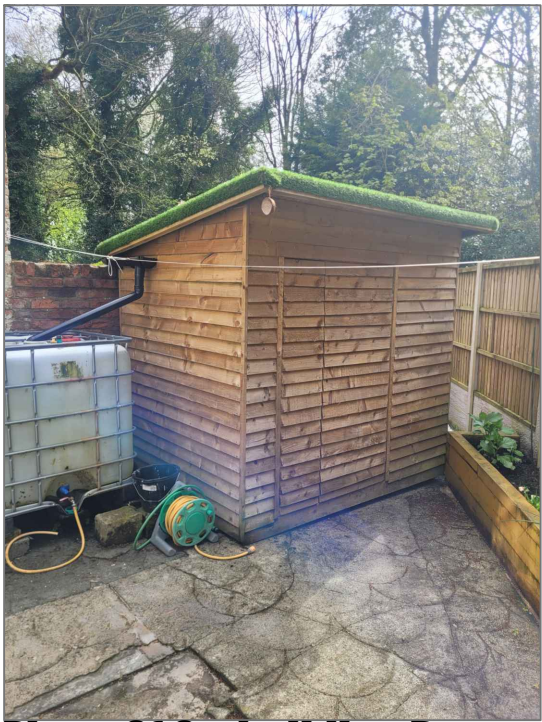



Photo Of Outbuilding B

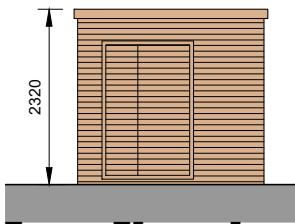


Front Elevation
Scale 1:100

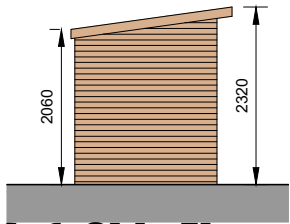

Left Side Elevation
Scale 1:100

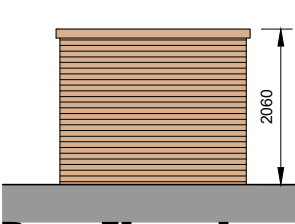

Rear Elevation
Scale 1:100

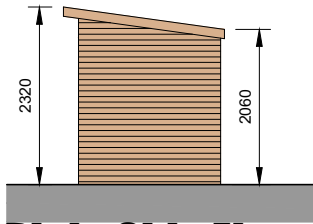

Right Side Elevation
Scale 1:100

Outbuilding B



6 Conway Close
Alkington
Middleton
Manchester, M24 1EW
E: conway-design@outlook.com

JOB TITLE : As Built Outbuildings
ADDRESS : Glenmore, Alkington Hall, Alkington
DRAWING TITLE : Plans And Elevations
SCALE : As Noted @ A3
DRAWN : xxx DATE : 24.05.24