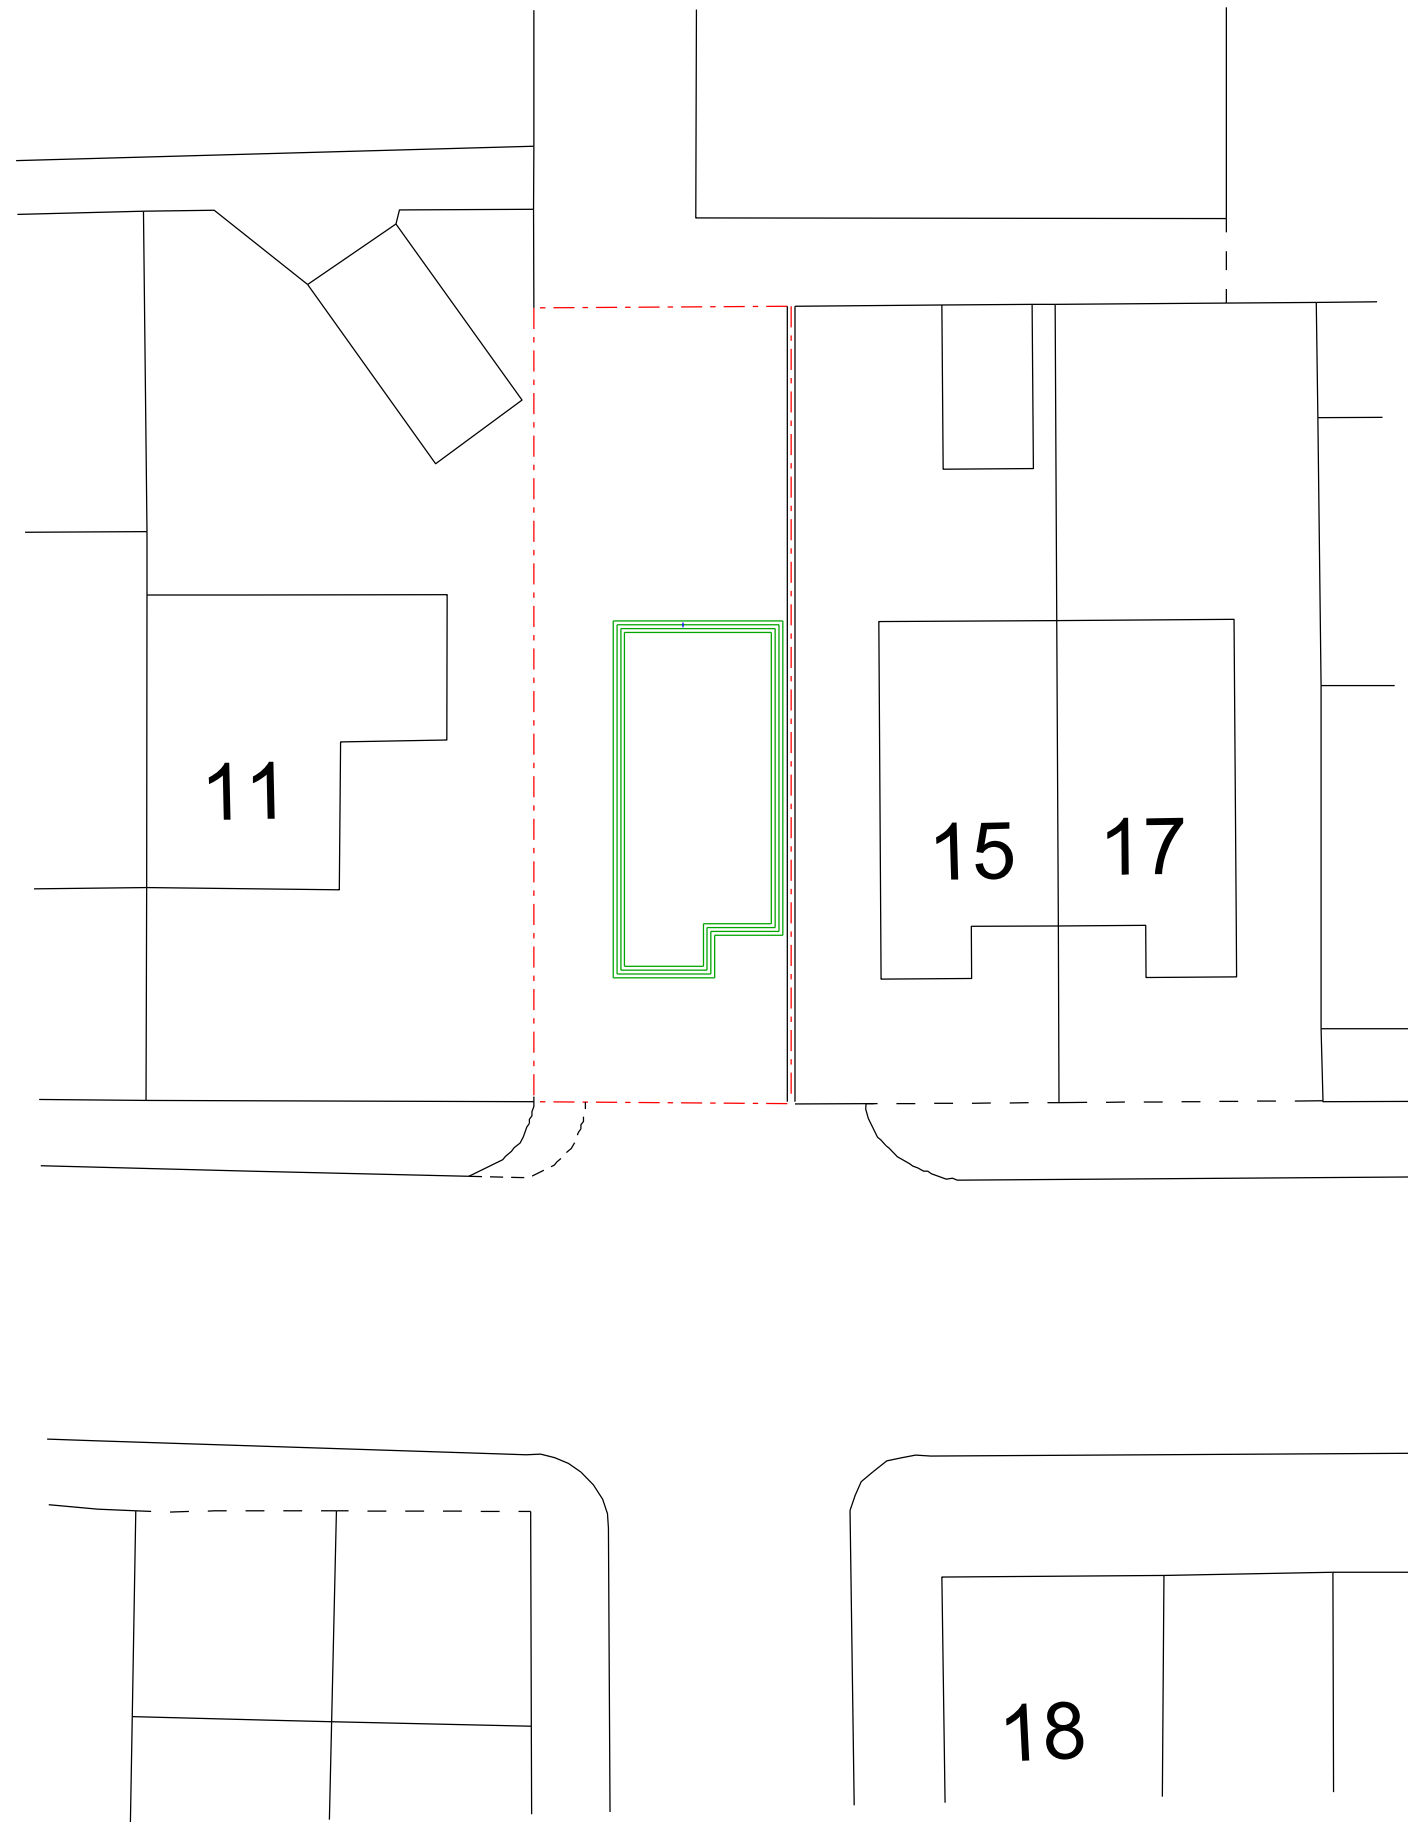



REVISIONS
Rev A: Planning Notes 16Jan23

REVISION NOTES

PROJECT AND DETAILS:

Land adjacent 15 Hillcrest Rd

SCALABLE IN METRES

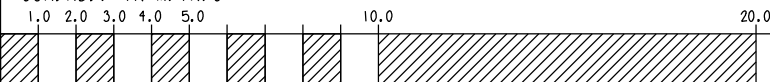

AT:

Rochdale, OL11 2QE

FOR:

L Wells

SCALE: 1:100 @ A1
1:200 @ A3

DRAWN: IB

DATE: 17 Nov 22

A

DWG TITLE:
As Built Block Plan

DWG NO:
499-PL02

ATOLL
art and architecture collaborative

Ian Banks • Director
m 0771 7710014 • ian.banks@atolluk.com • www.atolluk.com