

Pre Existing


ORIGINAL FRONT ELEVATION S/W
52 NEWHOUSE ROAD
HETWOOD OL10 2NU
20/8/23

WINDOWS AND DOOR UPVC.

GARAGE DOOR FIBREGLASS
CLADDING ON DORMER AND ABOVE THE GARAGE UPVC.

ROOF — DOUBLE ROMAN TILES
FLAT ROOF ON DORMER — FELTED
LEAD FLASHINGS

FACIAS AND SOFFITS UPVC.

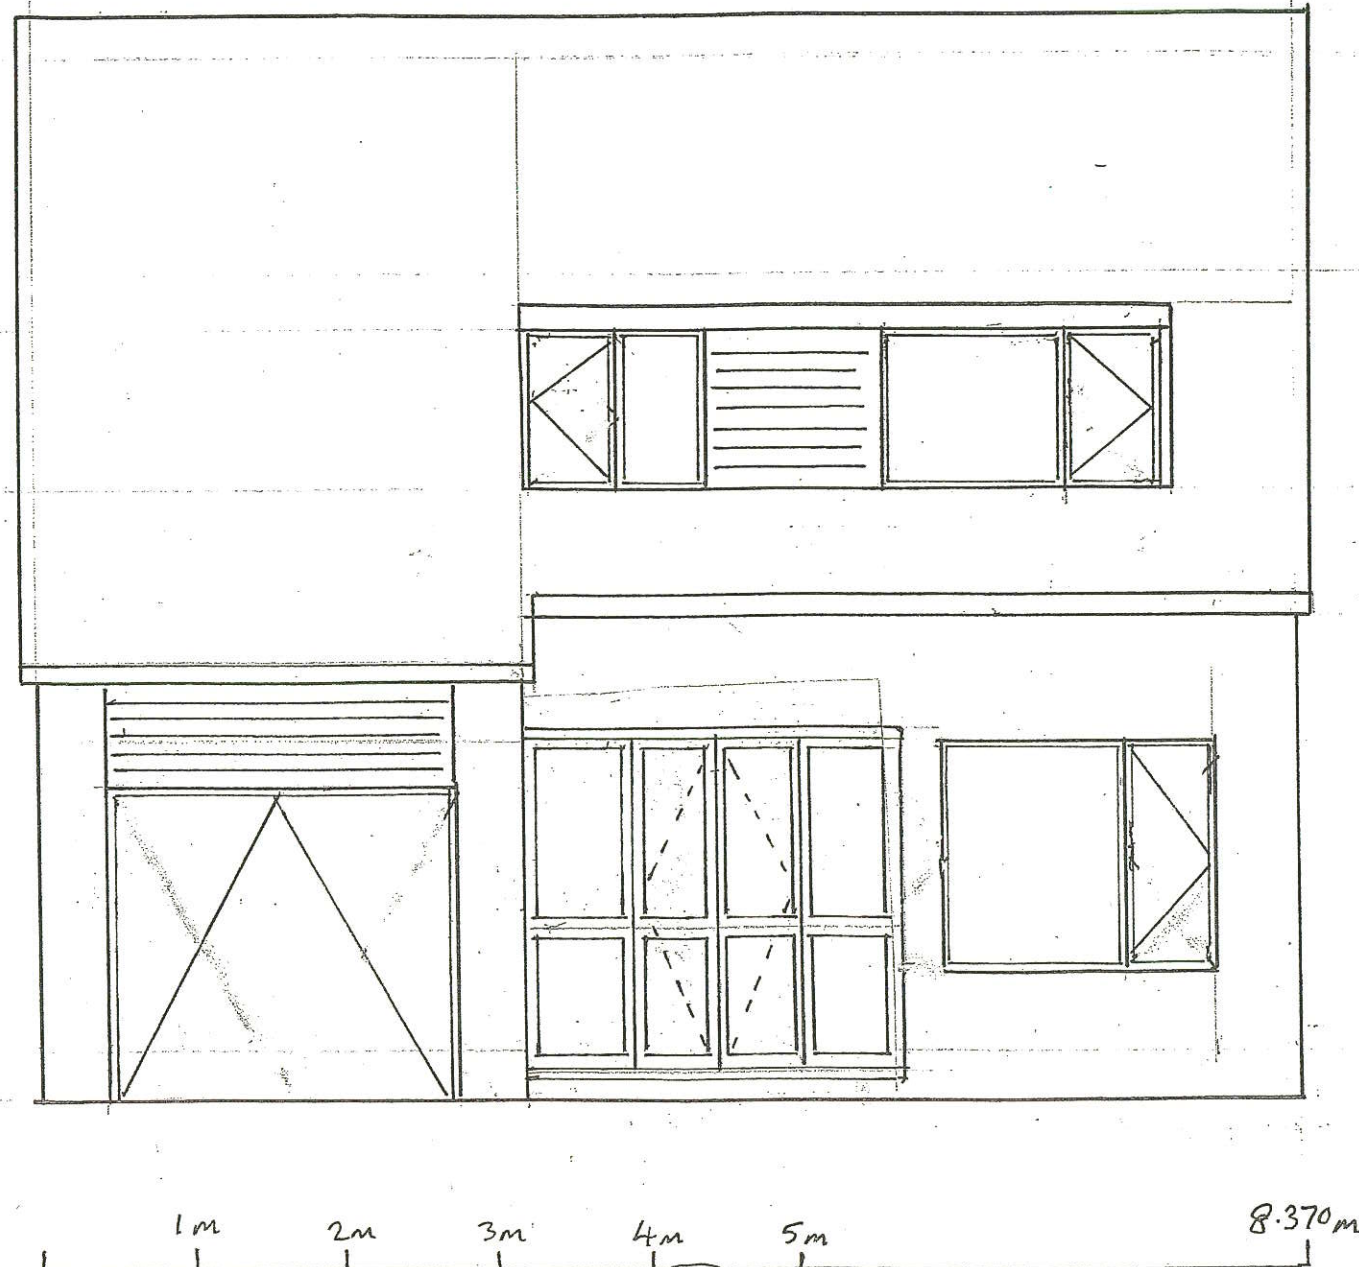

ELEVATION FACES SOUTH WEST


SCALE 1:50

DRAWING 6.

Pre-Existing

ORIGINAL FRONT ELEVATION S/W
52 NEWHOUSE ROAD
HEYWOOD OL10 2NU

20/8/23

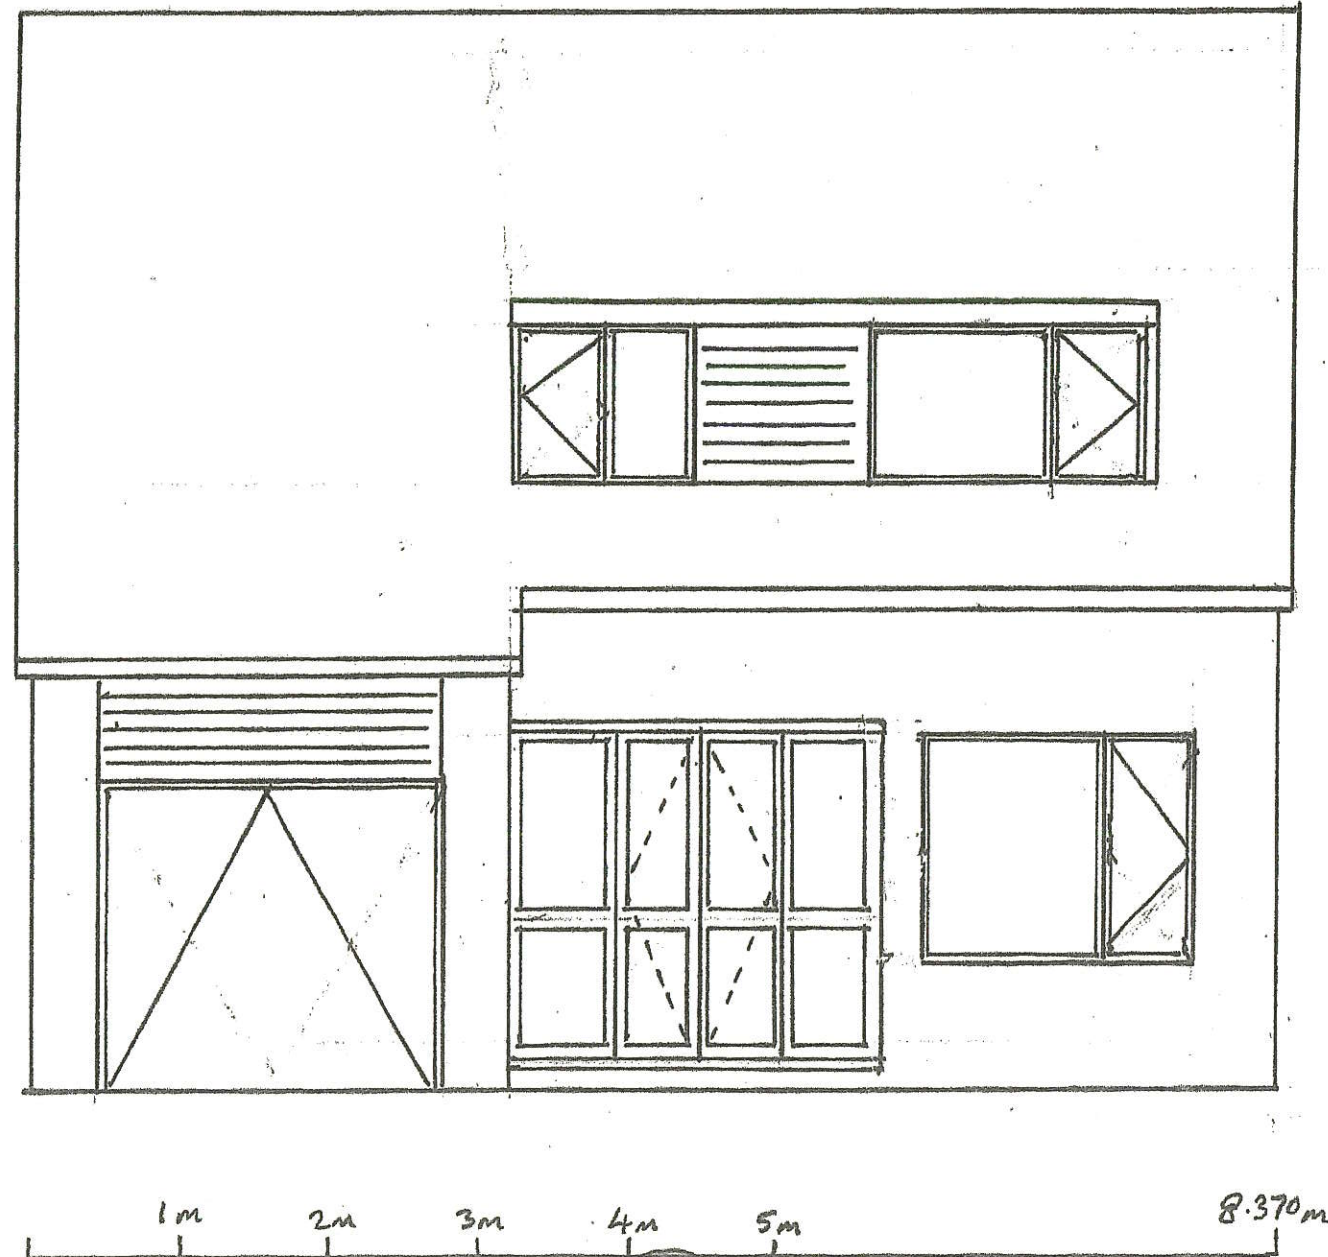

As Built Existing

EXISTING FRONT ELEVATION
AS OF 24/7/24
SITE INSPECTION 026431
COMPLETION BY A CRONAN



PROPOSED CHANGES TO
52 NEWHOUSE ROAD
HEYWOOD OL10 2NU
26/8/24

PROPOSED CHANGES TO MATCH
EXISTING ADDITION IN
APPEARANCE AND CONSTRUCTION
TECHNIQUES

N.B. EXISTING FLAT ROOF
HAS NO INSULATION
PROPOSED CHANGES TO
INCORPORATE KINGSPAN
TYPE INSULATION UP TO
150mm



DRAWING 4