
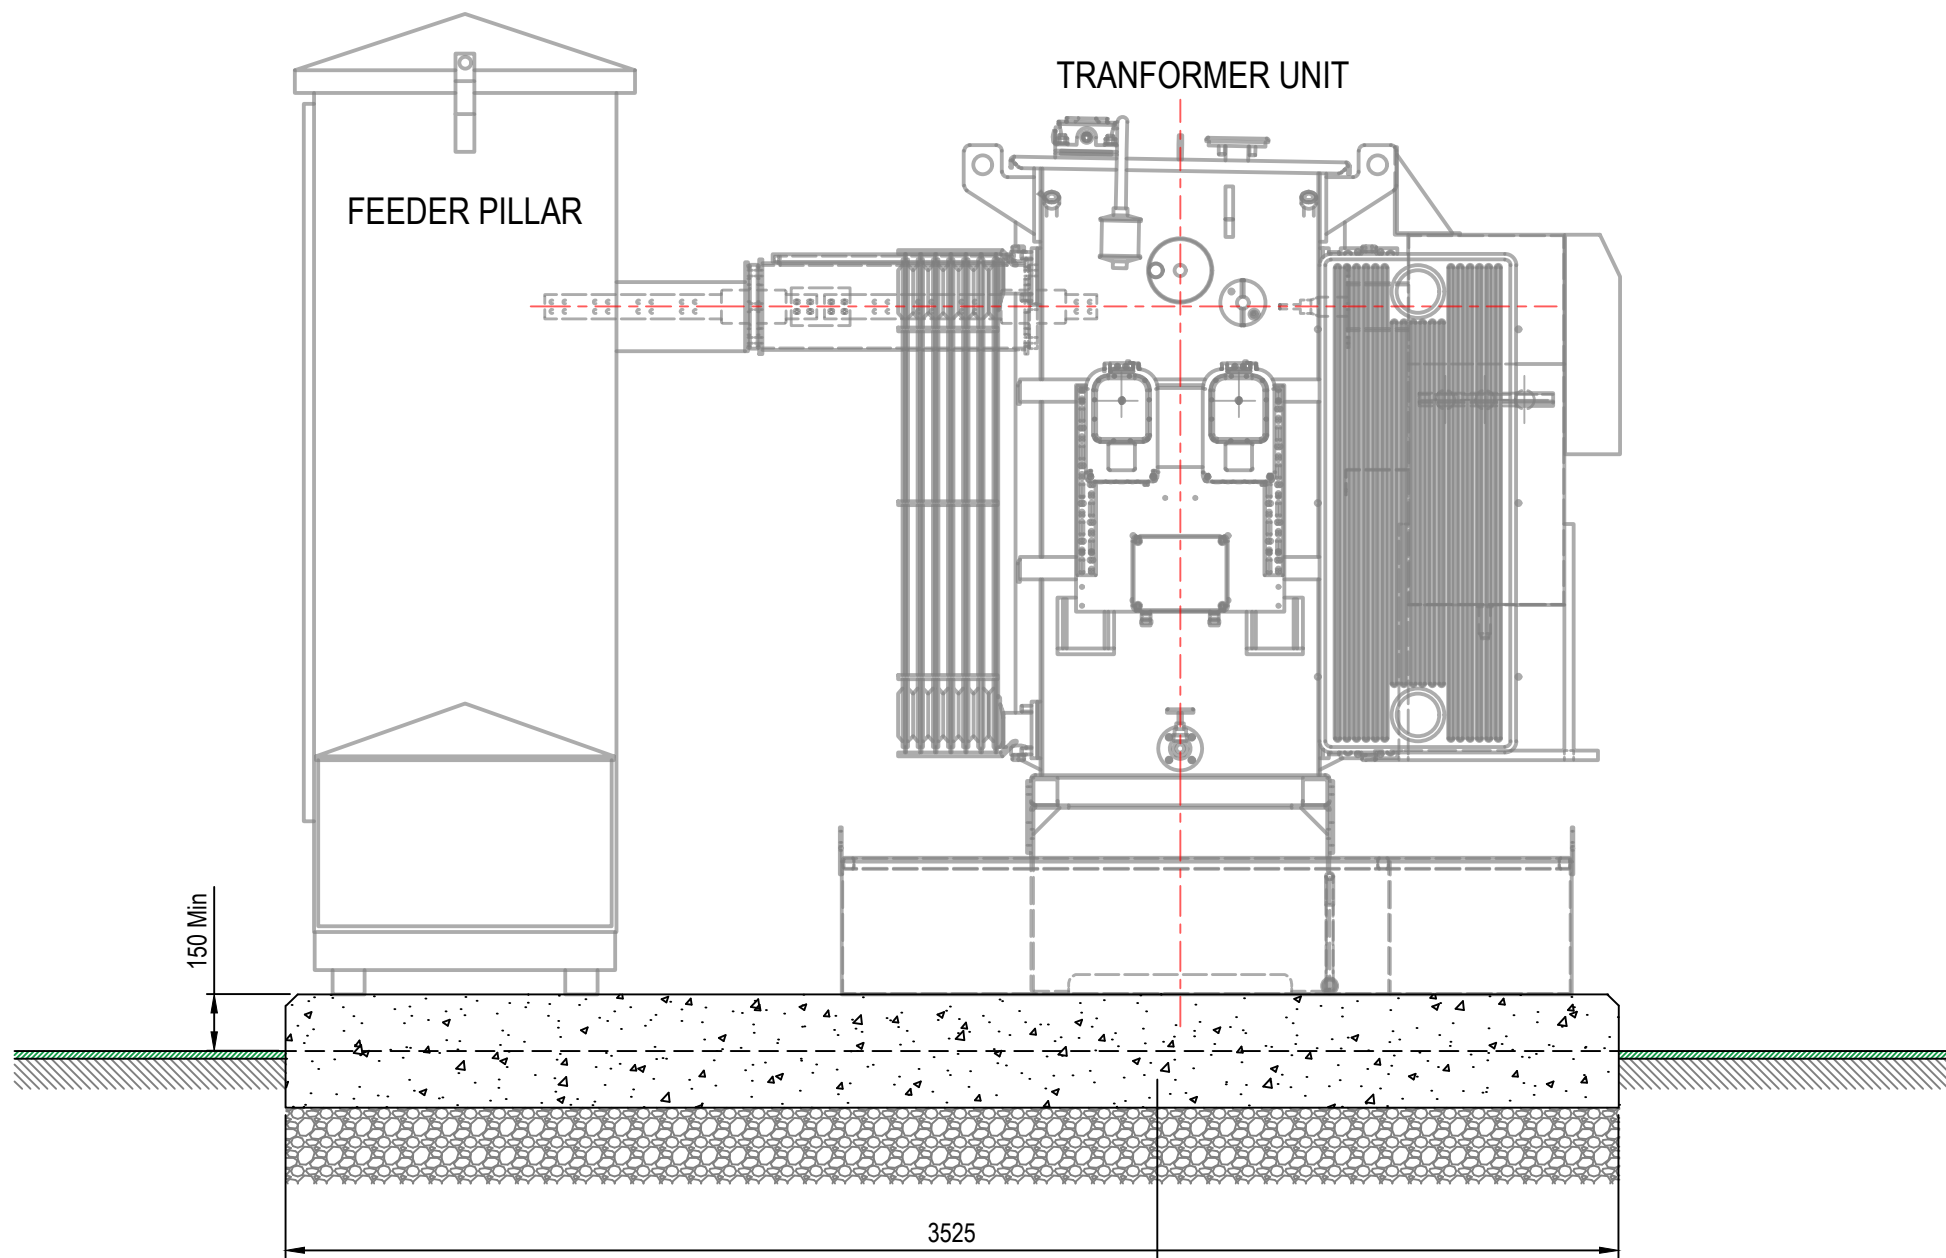


00E_22_V1_Plot02 By: William Evans on 25.09.2023 at 12:32 PM

THIS DRAWING REMAINS THE PROPERTY OF VITAL ENERGI AND MUST NOT BE REPRODUCED, COPIED, OR HANDED OVER TO A THIRD PARTY WITHOUT PRIOR WRITTEN CONSENT.

REFER TO VE ELECTRICAL DRAWINGS AND SPECIFICATIONS FOR FURTHER INFORMATION ON EQUIPMENT, CABLING AND PV ARRAY.

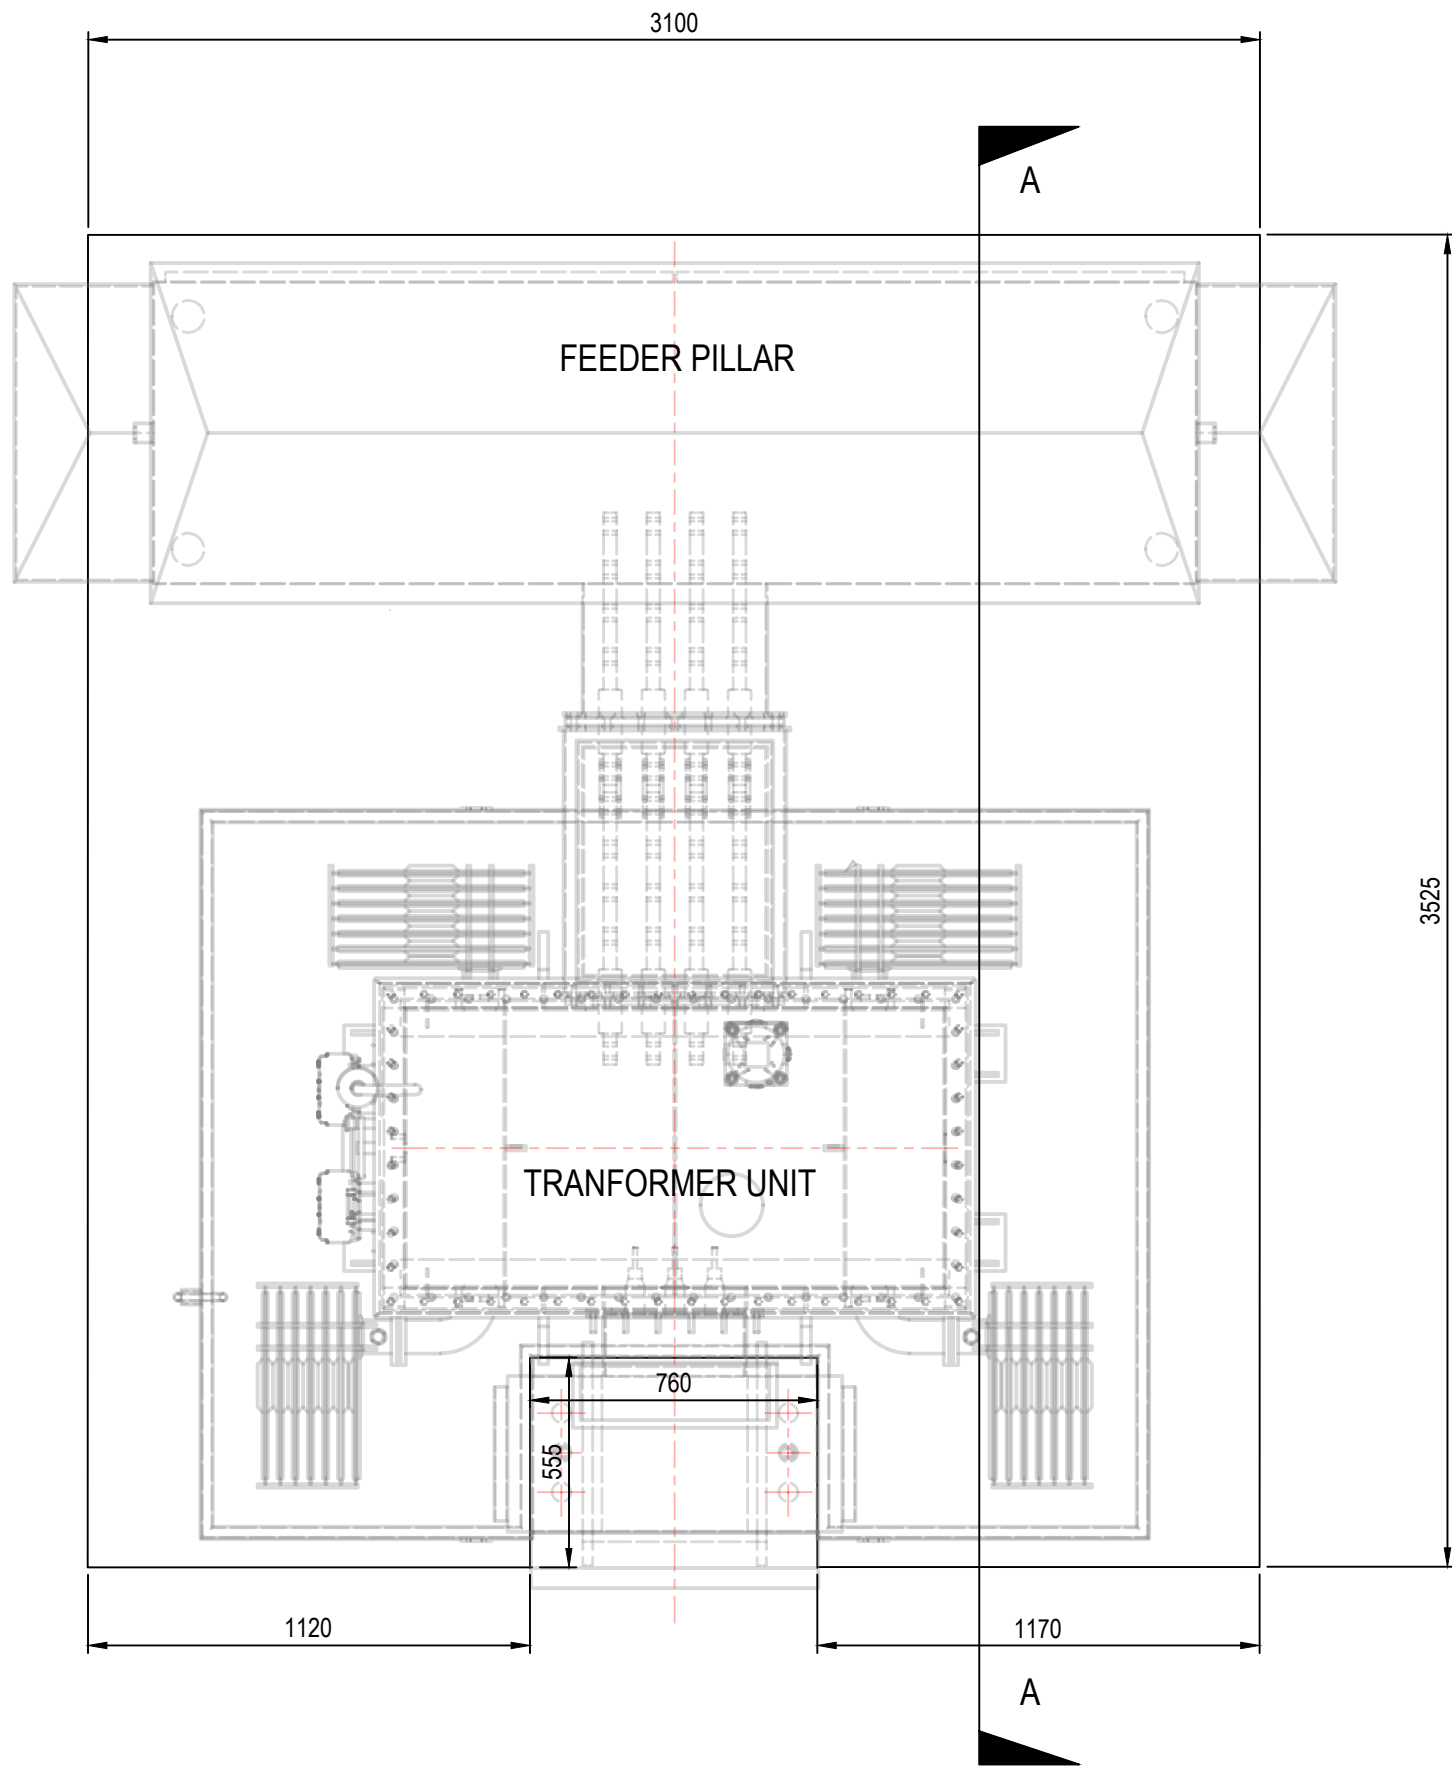

STRUCTURAL CONCRETE BASE INSTALLED TO ENGINEERS SPECIFICATION AND DETAILS ON 1200G VISQUEEN SHEET FOR MOISTURE CONTENT OVER ENGINEERING FILL TO STRUCTURAL ENGINEERS SPEC.

PROVIDED BRUSHED FINISH WITH CHAMFERED EDGE (30x30mm)

GENERAL NOTES:

ALL BUILDERS WORK IS TO BE CONSTRUCTED IN ACCORDANCE WITH THE CURRENT AND RELEVANT BUILDING REGULATIONS AND BRITISH STANDARDS. MANUFACTURERS INSTALLATION/ GUIDANCE NOTES ARE TO BE READ IN CONJUNCTION TO TASK BEING CARRIED OUT.

ALL DIMENSIONS ON DRAWING ARE IN MILLIMETERS UNLESS OTHERWISE STATED. ALL LEVELS ON DRAWING ARE IN METERS UNLESS OTHERWISE STATED.

THE CONTRACTOR SHALL BE RESPONSIBLE FOR THE ACCURACY OF ALL DIMENSIONS AND FOR THE CORRECT SETTING OUT OF WORK CARRIED OUT ON SITE.

THIS DRAWING IS TO BE READ IN CONJUNCTION WITH ALL RELEVANT ARCHITECTURAL, STRUCTURAL AND MECHANICAL DRAWINGS/ SPECIFICATIONS ISSUED.

ALL MATERIALS AND WORKMANSHIP SHALL BE IN ACCORDANCE WITH THE RELEVANT SPECIFICATIONS AND BRITISH STANDARDS

THE CONTRACTOR SHALL ENSURE THE STABILITY OF THE BUILDING AND ANY ADJOINING STRUCTURES IS MAINTAINED AT ALL STAGES OF CONSTRUCTION. THE CONTRACTOR SHALL DESIGN, INSTALL AND MAINTAIN ANY NECESSARY TEMPORARY WORKS.

CONTRACTOR TO PROVIDE METHOD STATEMENTS AND RISK ASSESSMENTS TO THE ENGINEER AND PLANNING SUPERVISOR A MINIMUM OF 14 DAYS BEFORE THE WORKS COMMENCE

OVERALL DEPTH IS DICTATED BY GROUND CONDITIONS AND EXISTING MAKE UP. FOR PRICING PURPOSES ASSUME EXCAVATION OF MADE GROUND TO 1.5m AND BACK FILL WITH ENGINEERING FILL IN 150. LAYERS WELL COMPACTED AND PROOF ROLLED. CAST 300mm THICK REINFORCED CONCRETE SLAB - REINFORCEMENT SPEC TO ENGINEERS DETAILS. FINAL DESIGN BY STRUCTURAL ENGINEER TO BE ISSUED FOR PRICING ONCE COMPLETE.

AS BUILT / HANDOVER



VITAL
ENERGI

VITAL ENERGI, Century House, Roman Road, Blackburn, Lancashire, United Kingdom, BB1 2LD. Tel: +44 (0)1254 296 000 Fax: +44 (0)1254 296 040

Project: CHAMBER HOUSE - ROCHDALE

Title: FEEDER PILLAR BASE LAYOUT & SECTION (SCOPE)



DATE 25.09.2023 SCALE 1:20 SHEET A2

AS-BUILT / HANDOVER Status: AB Stage: 6

Drg-No: 50716-VE-SW-XX-DR-A-XX08 Rev: AB

AB	25.09.23	AS-BUILT / HANDOVER	RJR	BP	BMc
REV	DATE	DESCRIPTION	DRW	CKD	APP