


This drawing is provided as a document to gain either Planning Permission or Building Regulation approval purposes only. It is not a guarantee that Planning Permission will be granted.

This drawing and all contents are the copyright of James Campbell Associates Ltd. No copies to be made from the drawing & details within unless authorised by James Campbell Associates Ltd.

The contract for the works is between the client and his / her contractor. Contractor to visit site, study the details provided within the drawing and be familiar with both the work to be carried out in accordance with the details provided. Any stated dimension must be checked prior to any form of construction. All works and materials to comply with all relevant British Standards and carry a genuine BBA certificate. The materials specified within this drawing are a guide for the contractor as they are recognised materials with genuine BBA certificate etc. Any contractor who decides to use any different materials than that noted on the drawing must inform James Campbell Associates Ltd.

Any discrepancies discovered or items found that where not visible at the time of the initial survey should be reported to James Campbell Associates Ltd for consultation with our client.

CONSTRUCTION NOTES:-

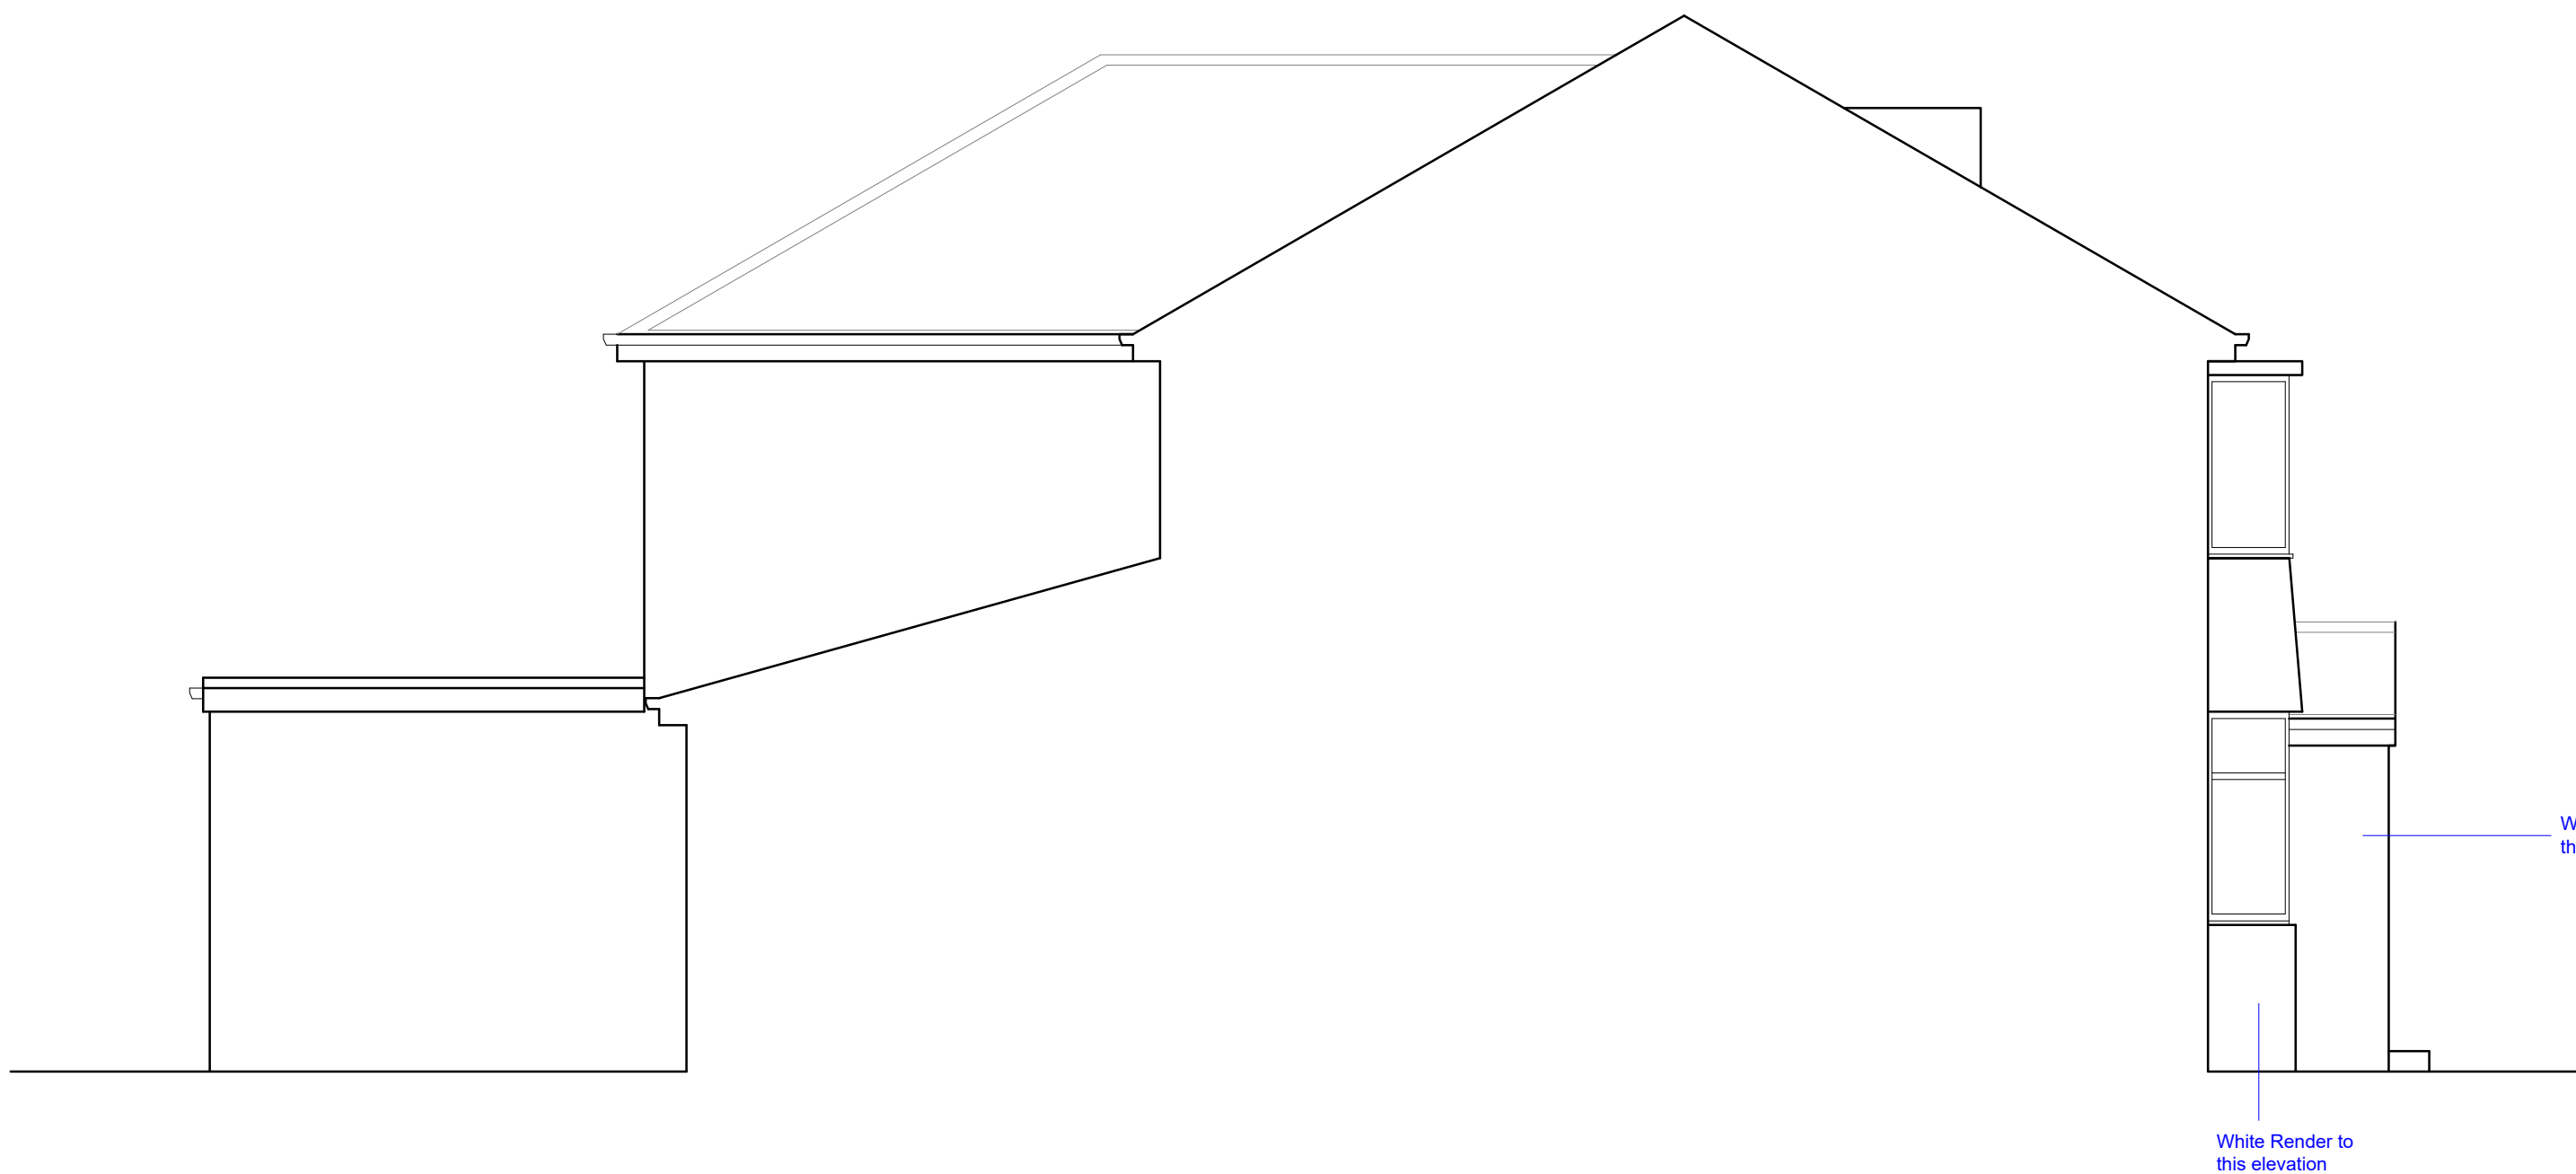

PROPOSED SIDE ELEVATION



PROPOSED SIDE ELEVATION



PROPOSED FRONT ELEVATION

NEW APPROVAL
SOUGHT FOR RENDER TO
FRONT ELEVATION.



AS BUILT REAR ELEVATION

DRAWING TITLE		
PROPOSED ELEVATIONS		
 JAMES CAMPBELL ASSOCIATES LTD CHARTERED ARCHITECTURAL SERVICES WWW.JAMESCAMPBELLASSOCIATES.CO.UK  Chartered Institute of Architectural Technologists		
Campbell House 173 Rochdale Road Firgrove Rochdale OL163BN Tel: 01706354888 Mob: 07817243398 Email: martin@jamescampbellassociates.co.uk Web: www.jamescampbellassociates.co.uk		
PROJECT		
RETROSPECTIVE FRONT PORCH & RENDER		
LOCATION		
450 Heywood Old Road Bowlee Middleton		
DRAWN:-	Martin D. Ashworth	DRAWING NUMBER:-
DATE:-	August 2022	22.2867.4
SCALE:-	1:50 @ A1	
ISSUE:-		