

As existing 2m brick wall forming end boundary

As existing 1.8m timber fence forming side boundary to #15

Brick and blockwork to DPC height only

As existing open back-of-pavement boundary

AS EXISTING GROUND FLOOR (BUILT TO DPC ONLY)

As existing 1.8m timber fence forming side boundary to #11


REVISIONS
Rev A: Planning Notes 16Jan23
Rev B: As built fence corrections 06Jul23

REVISION NOTES

PROJECT AND DETAILS:

Land adjacent 15 Hillcrest Road

SCALABLE IN METRES

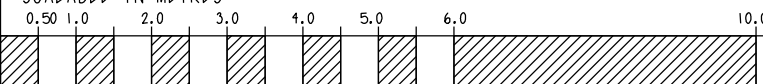

AT:

Rochdale, OL11 2QE

FOR:

L Wells

SCALE: 1:50 @ A1
1:100 @ A3

DRAWN: IB

DATE: 17 Nov 22

A B

DWG TITLE:
As Built Floor Plans

DWG NO:
499-PL03B

ATOLL
art and architecture collaborative

Ian Banks • Director
m 0771 7710014 • ian.banks@atolluk.com • www.atolluk.com