




THIS DRAWING IS THE PROPERTY OF PCG INTERIOR LTD. IT IS TO BE USED FOR THE PROJECT AND SITE SPECIFICALLY IDENTIFIED. IT IS NOT TO BE REPRODUCED, COPIED, OR TRANSMITTED IN ANY FORM OR BY ANY MEANS, WITHOUT THE WRITTEN PERMISSION OF PCG INTERIOR LTD. THE USER OF THIS DRAWING AGREES TO INDEMNIFY AND HOLD PCG INTERIOR LTD. HARMLESS FROM AND AGAINST ALL CLAIMS, DAMAGES, LOSSES AND EXPENSES, INCLUDING REASONABLE ATTORNEY'S FEES, THAT MAY BE ASSERTED AGAINST OR INCURRED BY PCG INTERIOR LTD. AS A RESULT OF THE USER'S NEGLIGENCE OR WILLFUL MISUSE OF THIS DRAWING.


Initials:
PJO

Date:
02.03.2022


Revision:
Rev A: Rear/side extension reduce to a single storey,
new windows to Oulder Street
Rev B: Extension material change to render
Rev C: Whole property rendered
Rev D: Revised Elevations to as-built/existing
Rev E: Render hatch amended

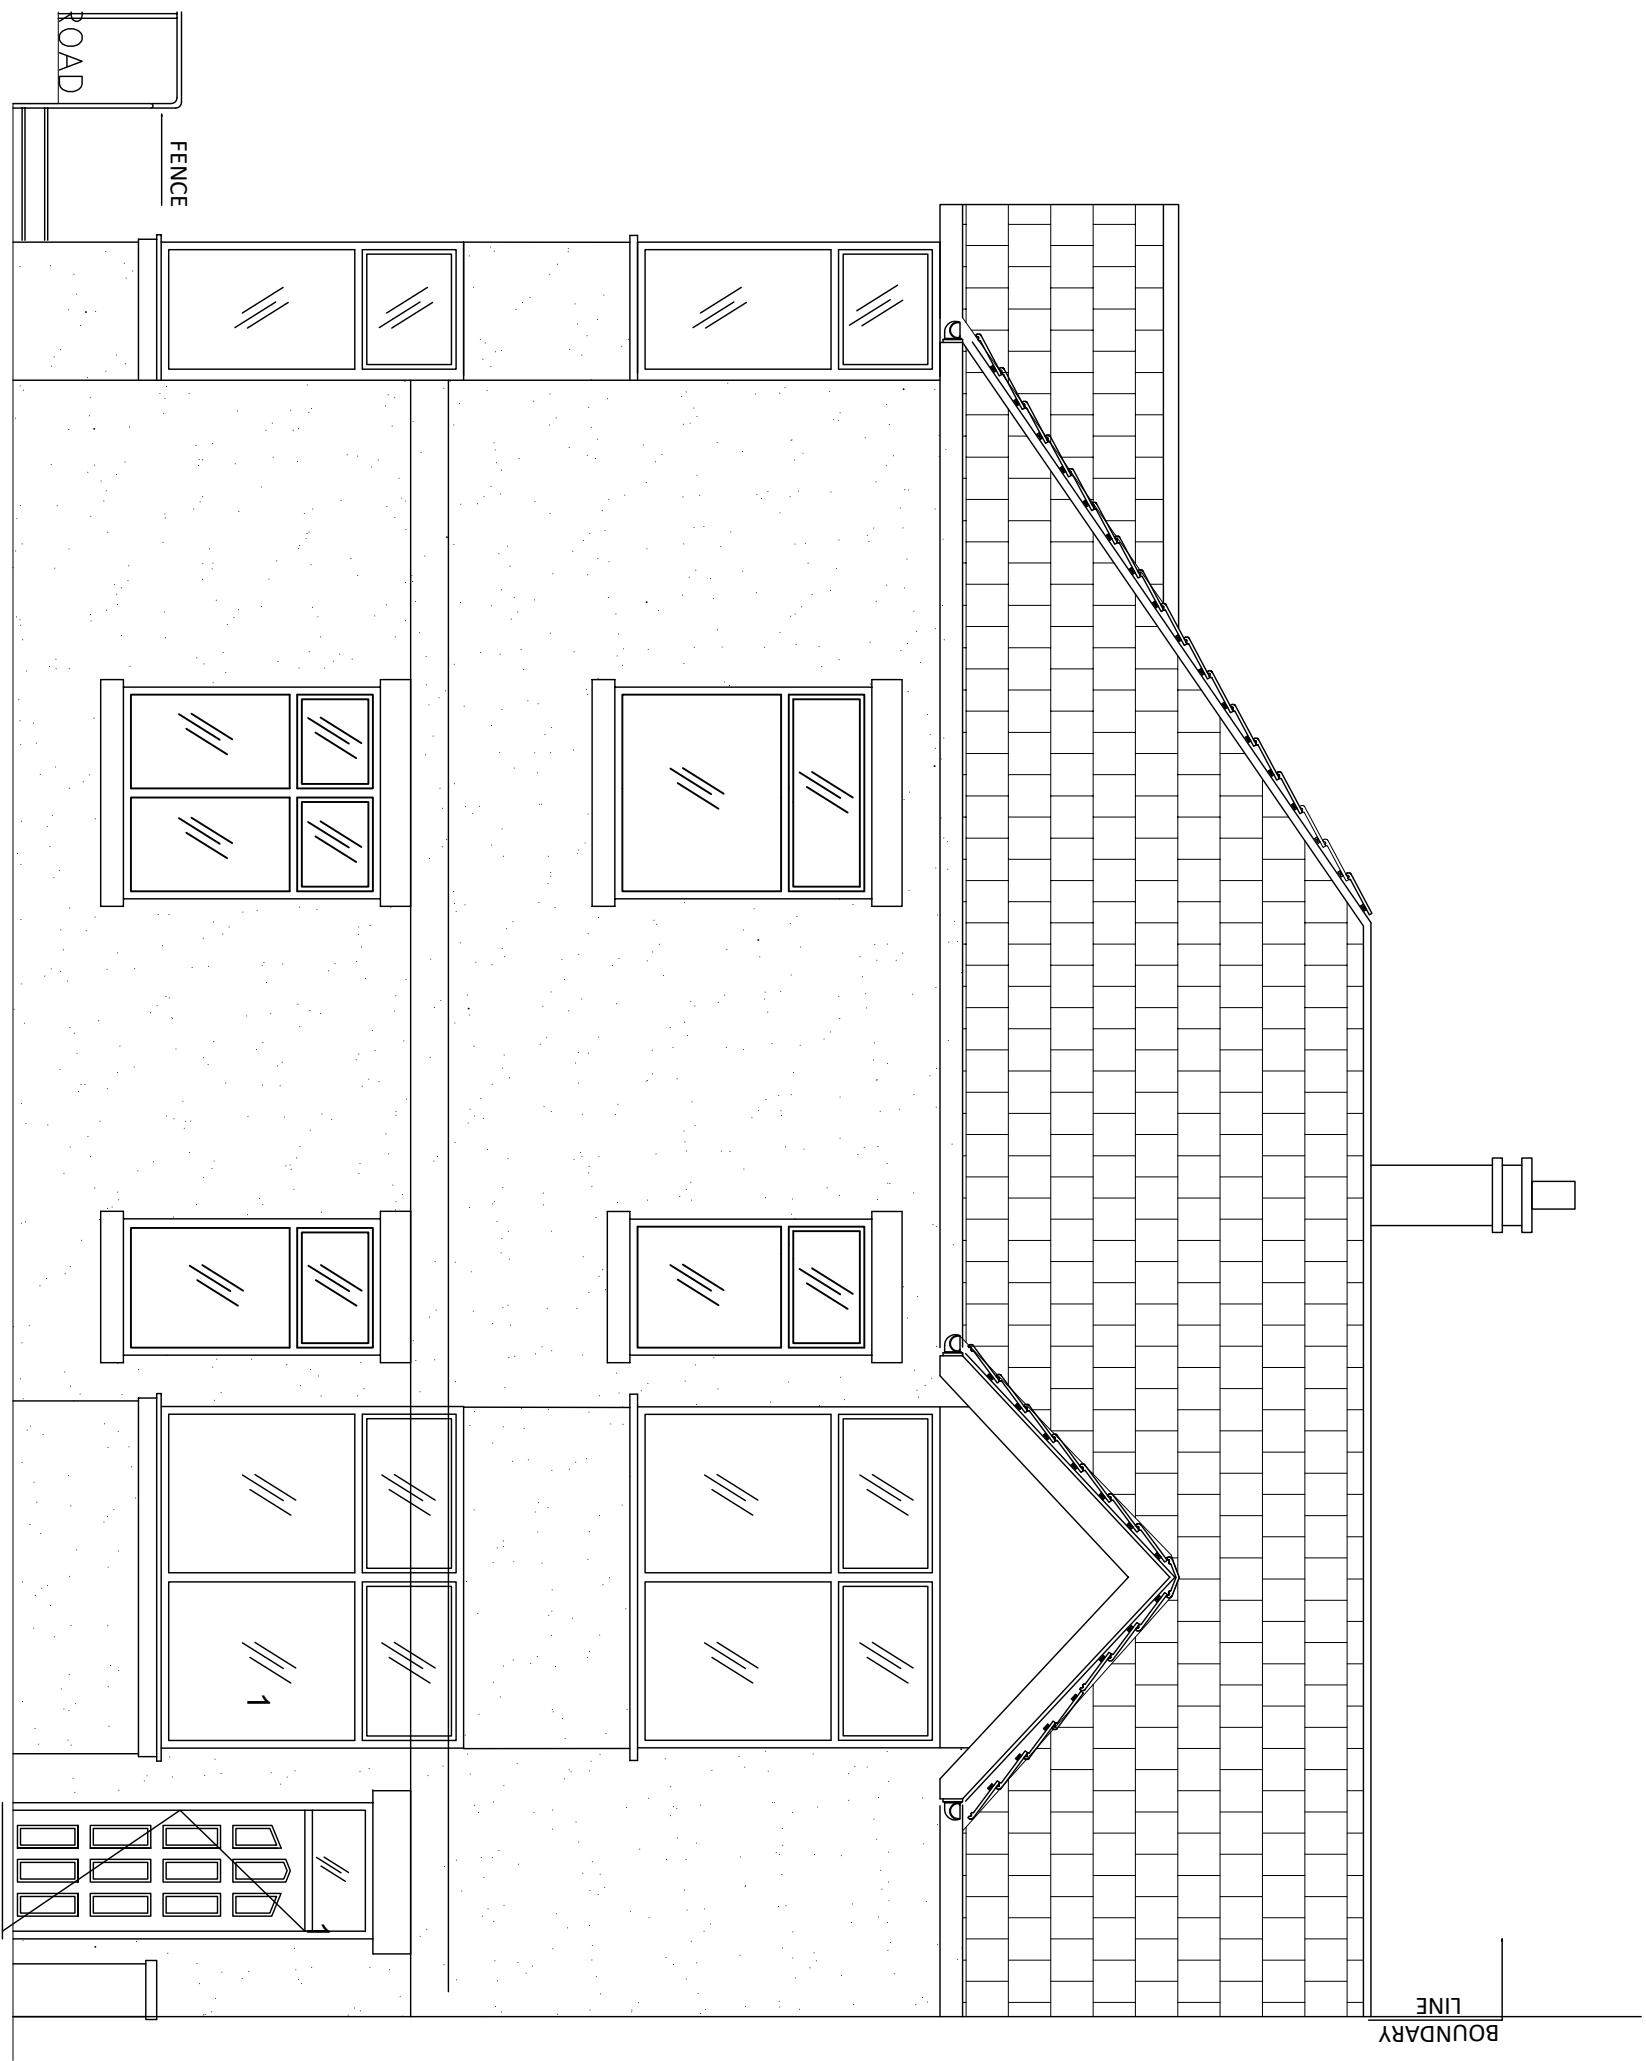


PROPOSED SIDE ELEVATION
(OULDER HILL DRIVE)

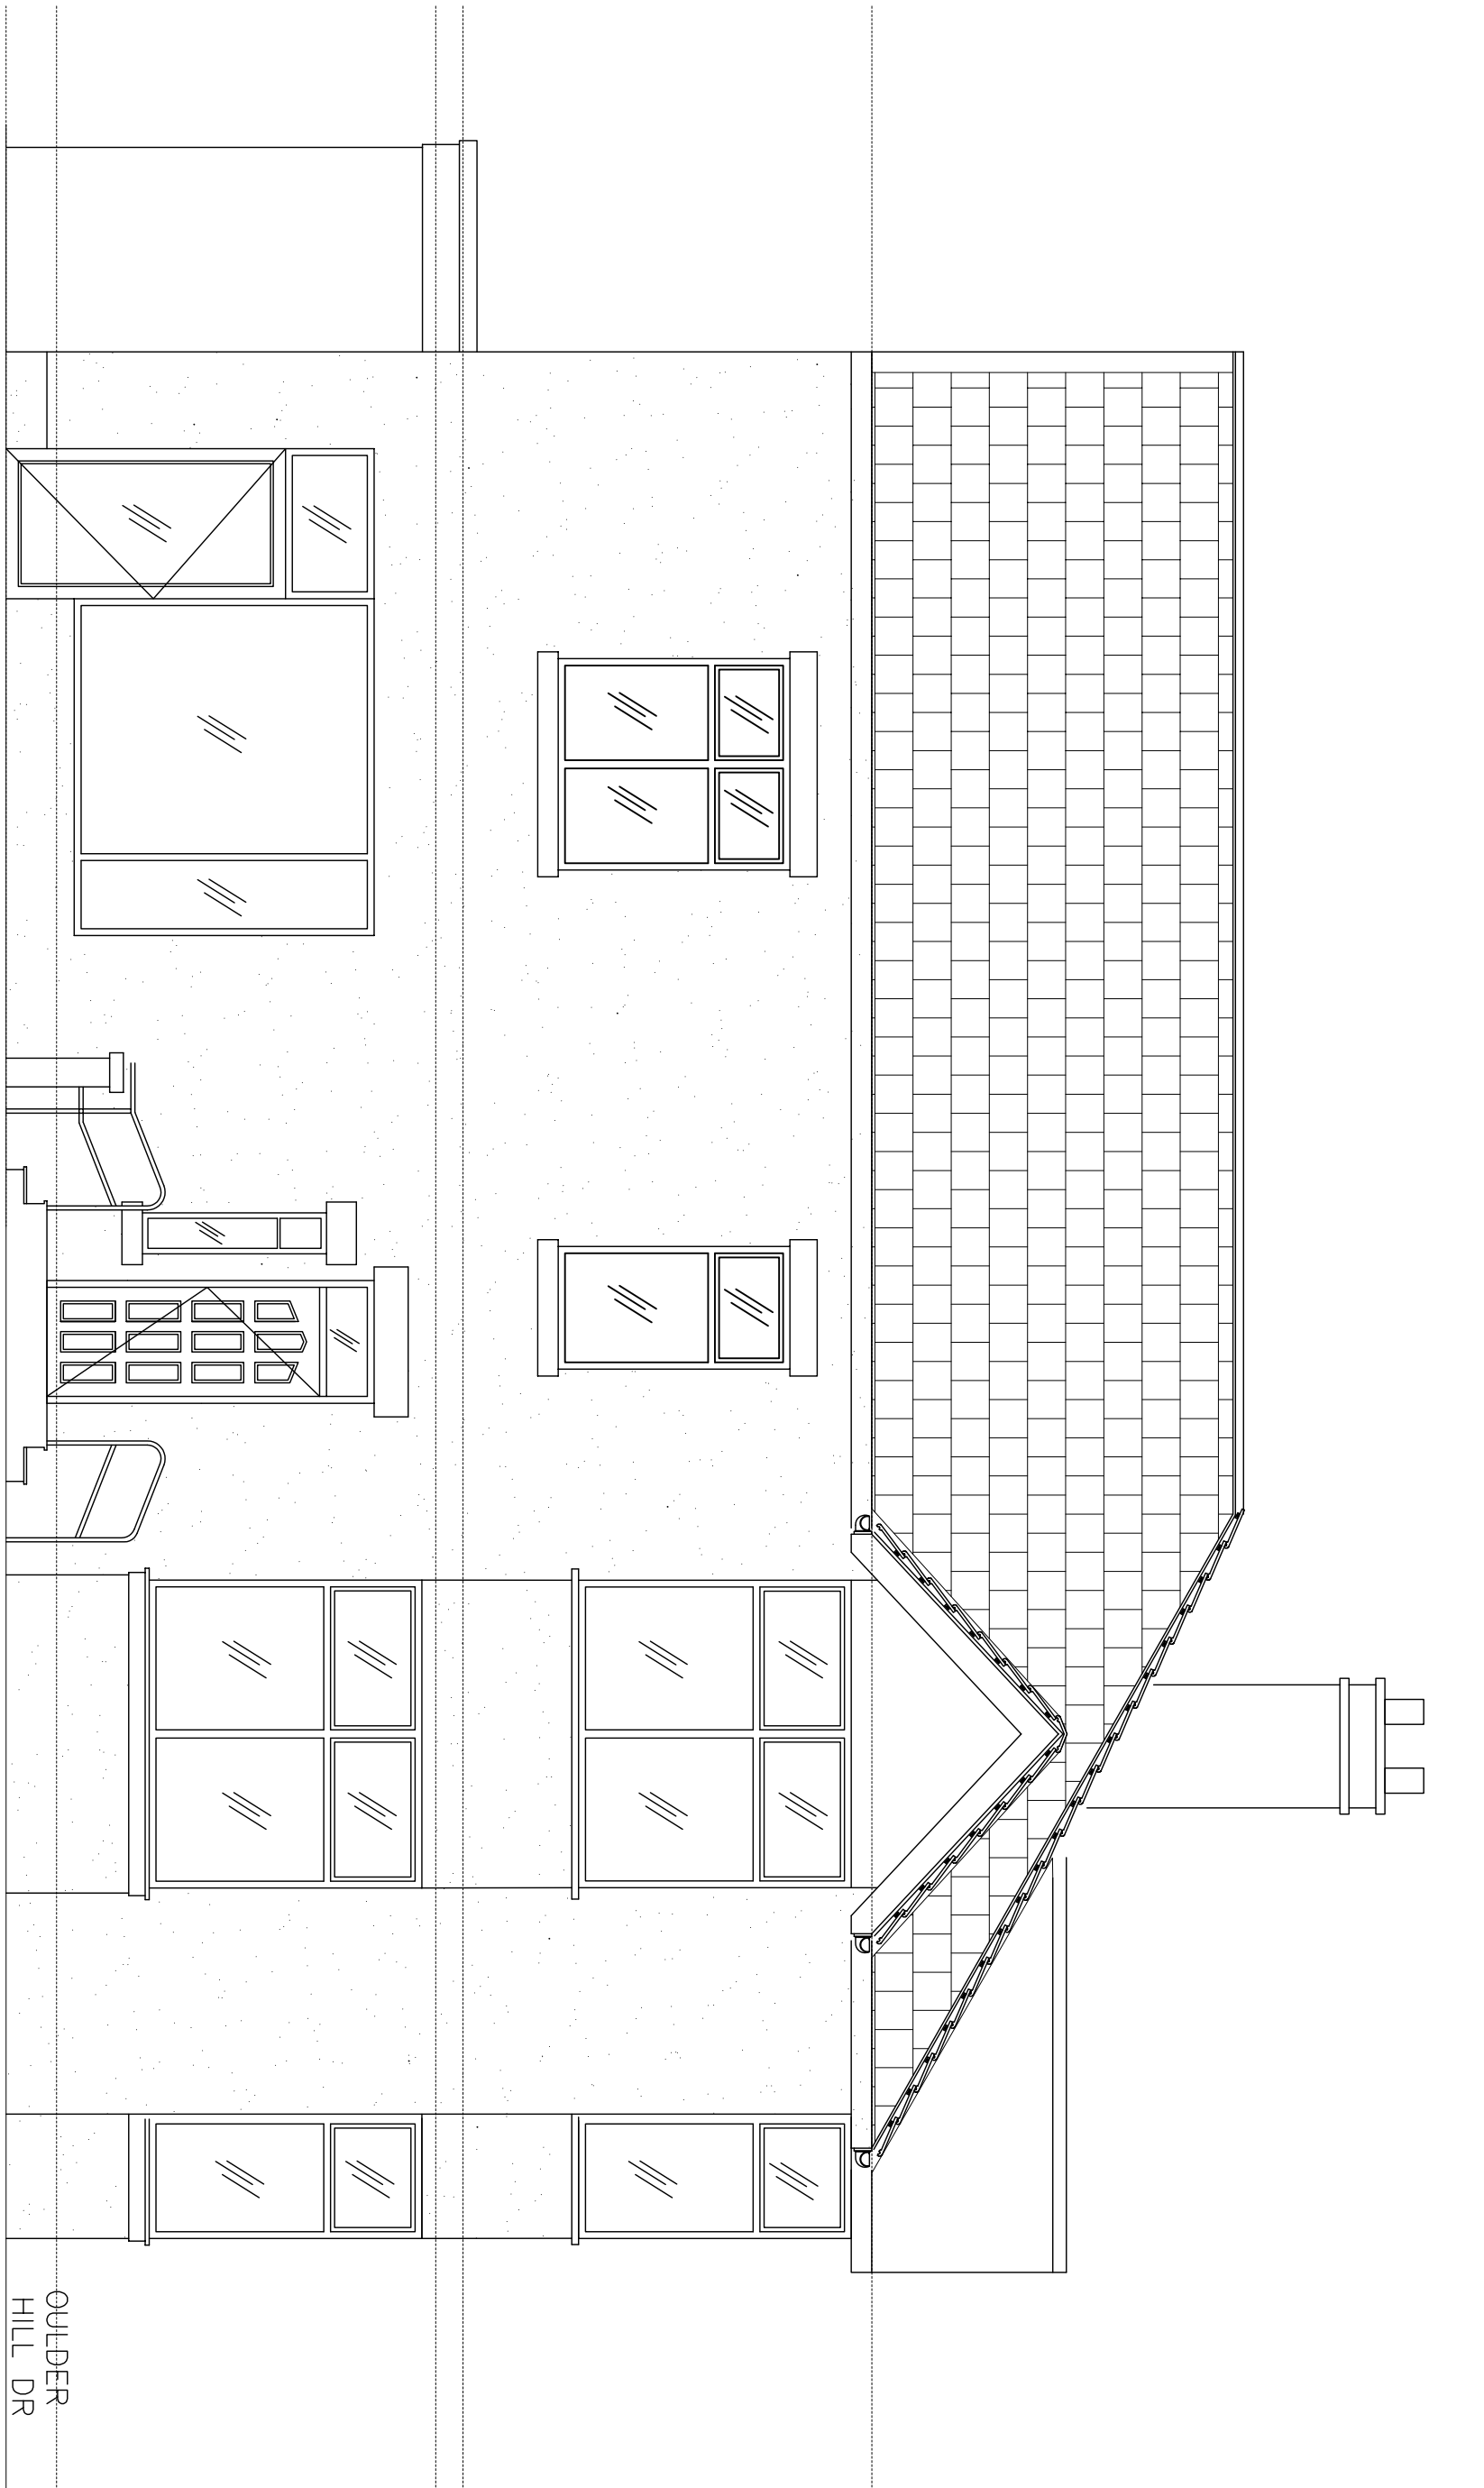


PROPOSED FRONT ELEVATION
(BURY ROAD)

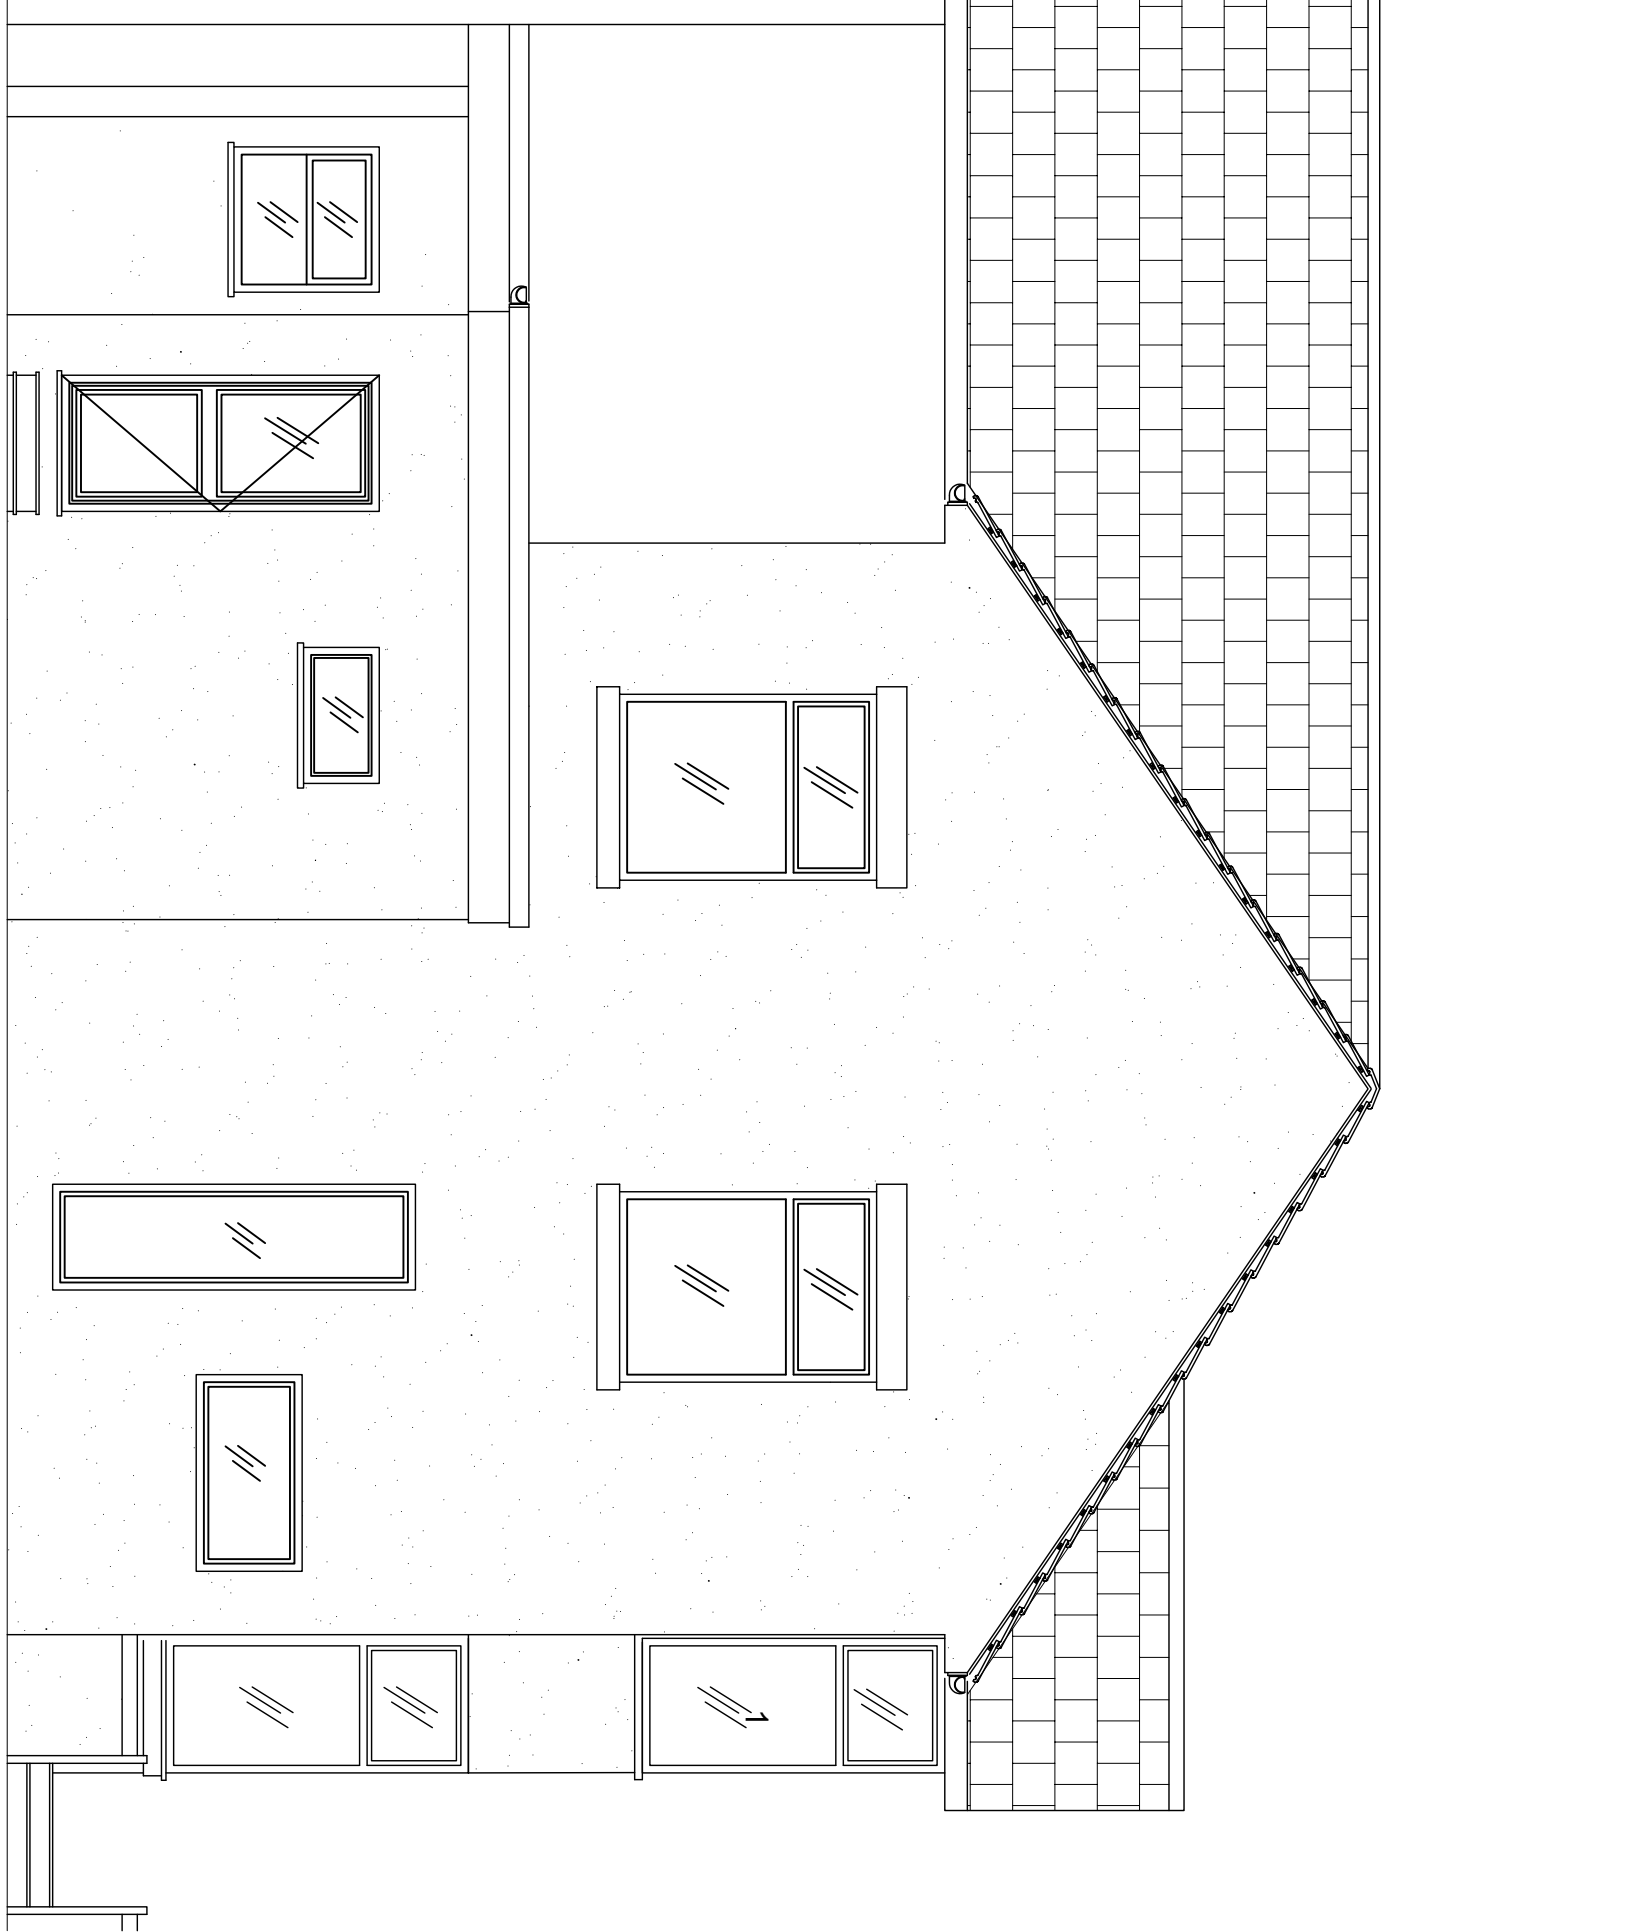

PROPOSED SIDE ELEVATION

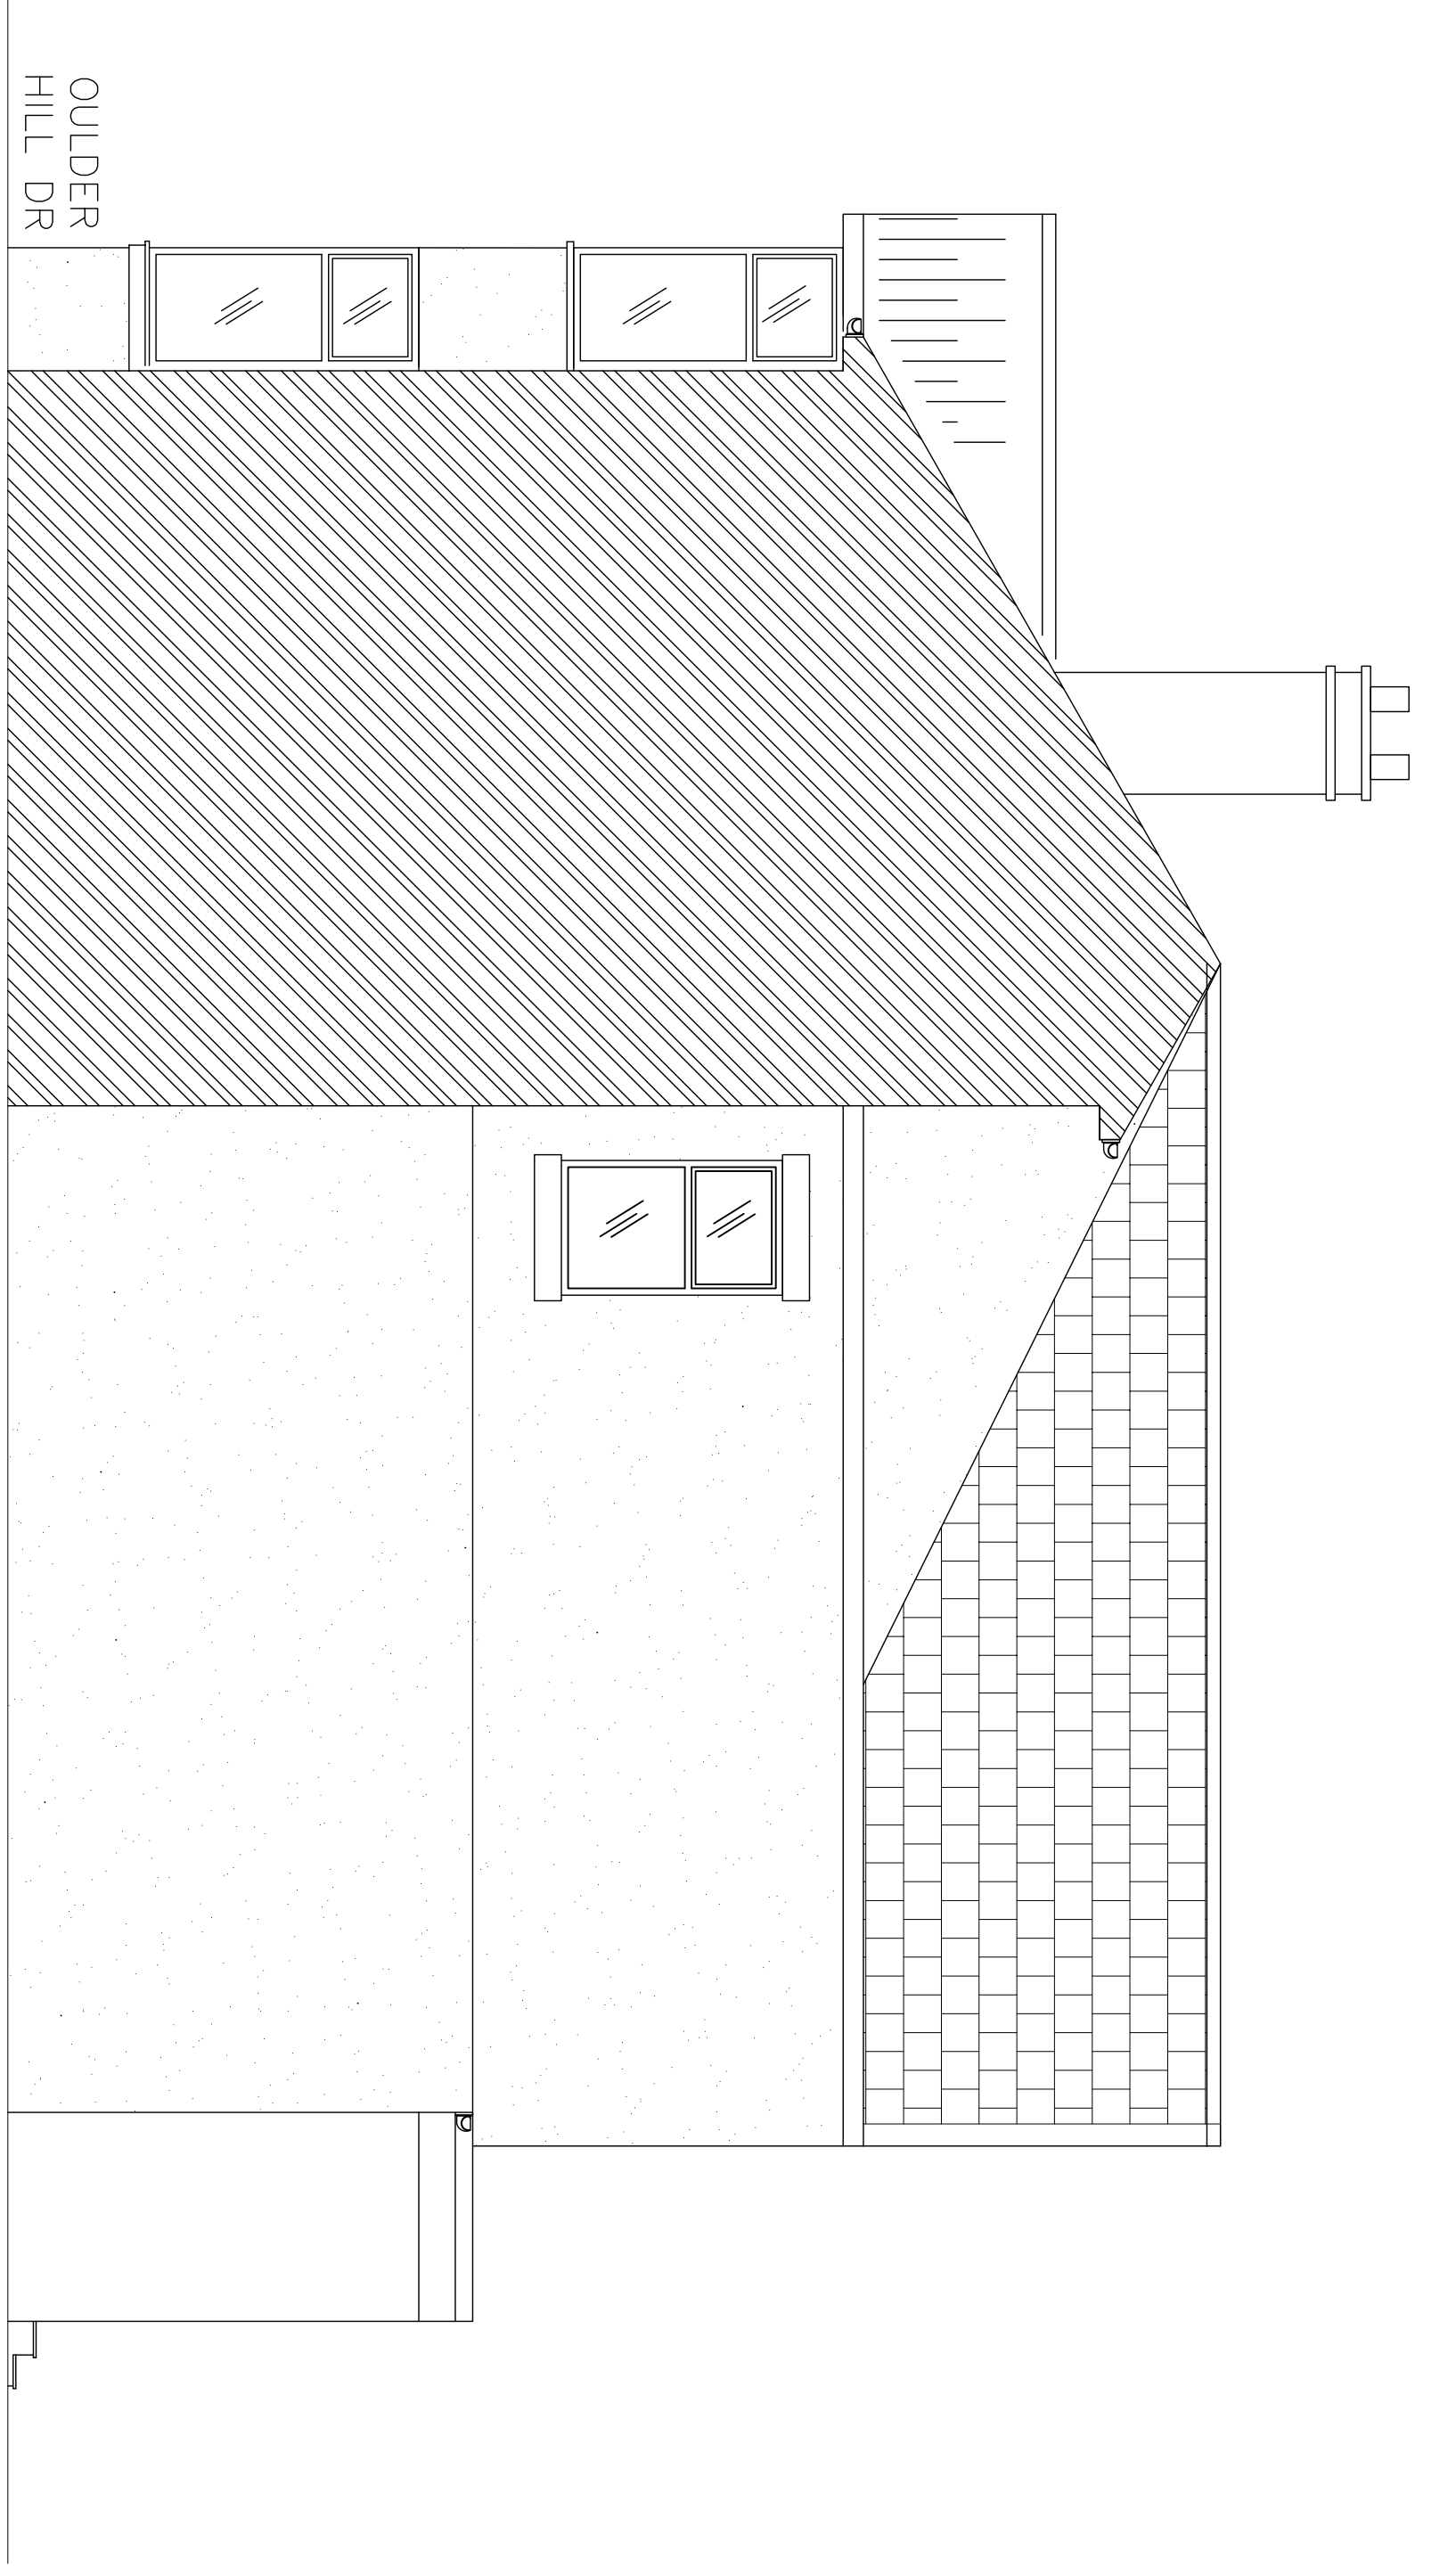

PROPOSED ADJOINING ELEVATION
(No.1. OULDER HILL DRIVE)

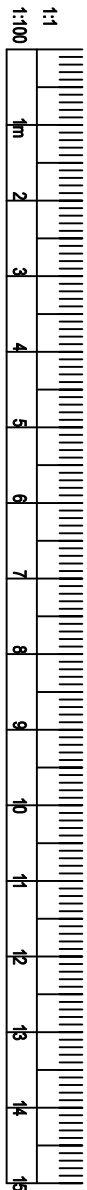

CLIENT:
Mr. S. Malik

PURPOSE:
PLANNING

Date:
Dec 2021

Scale@A1:
1:100

Drawn by:

Project:
518 Denial

518 Bury Road

Residence OL11 4DQ

Drawing Title:
Proposed Elevations
(Planning Only)

Project No.
21.195

Drawing No.
P-1001.16

Revision
E.