




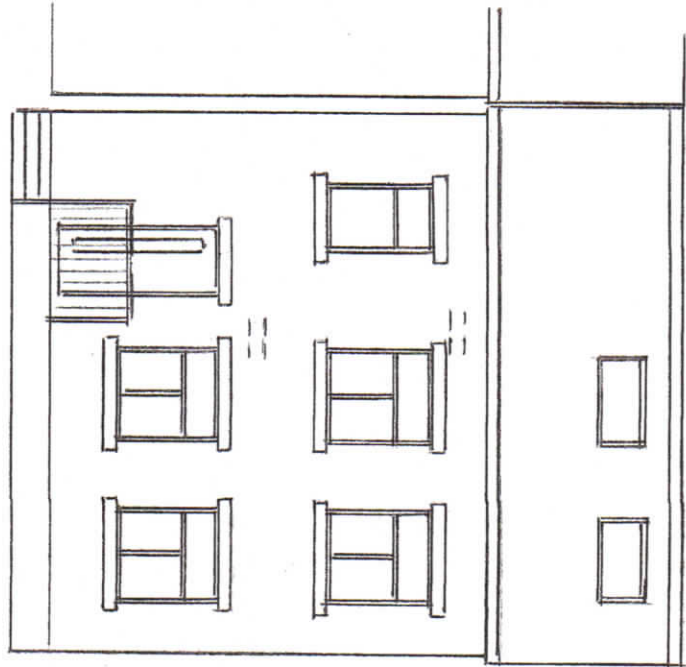


FRONT ELEVATION
AS PLANNING APPROVAL

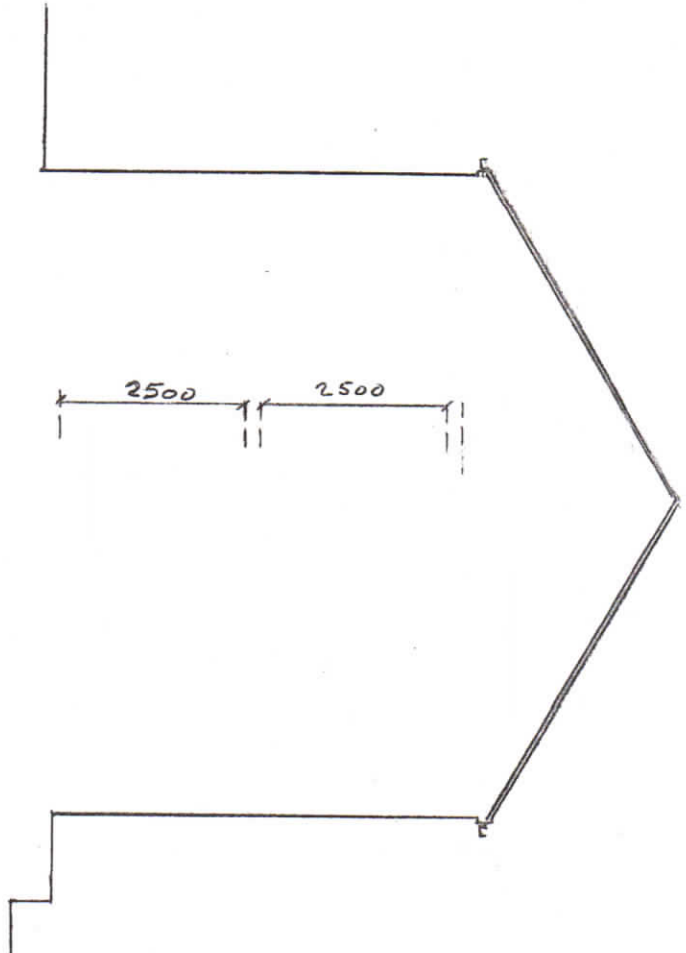


SIDE ELEVATION
AS PLANNING APPROVAL

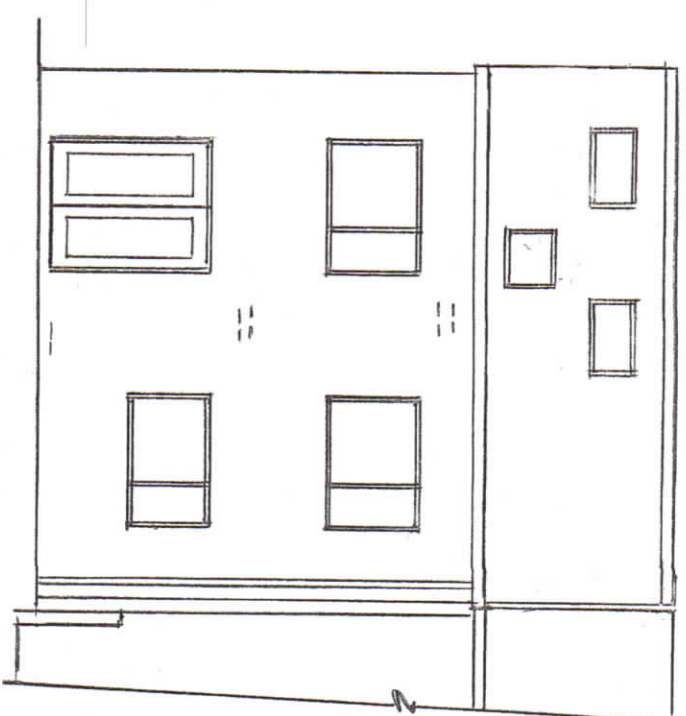


REAR ELEVATION
AS PLANNING APPROVAL

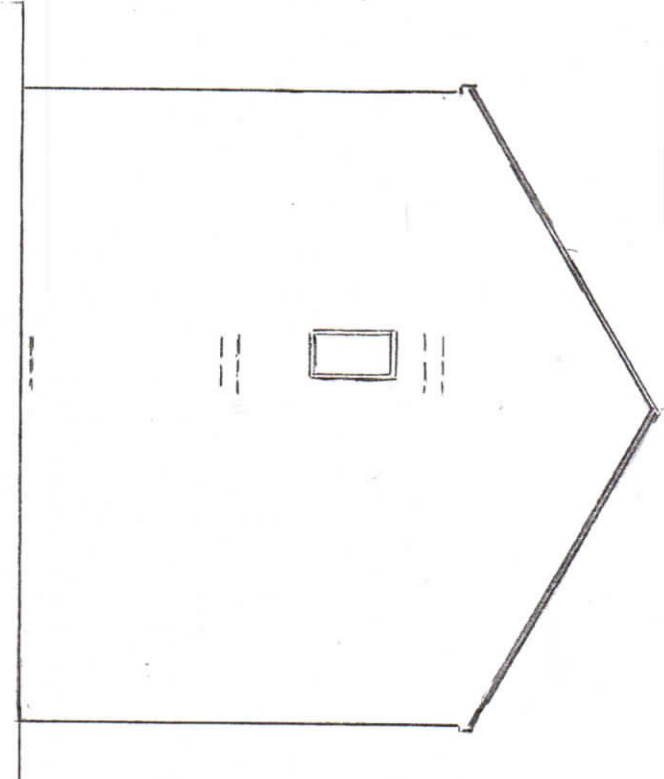


SIDE ELEVATION
AS PLANNING APPROVAL

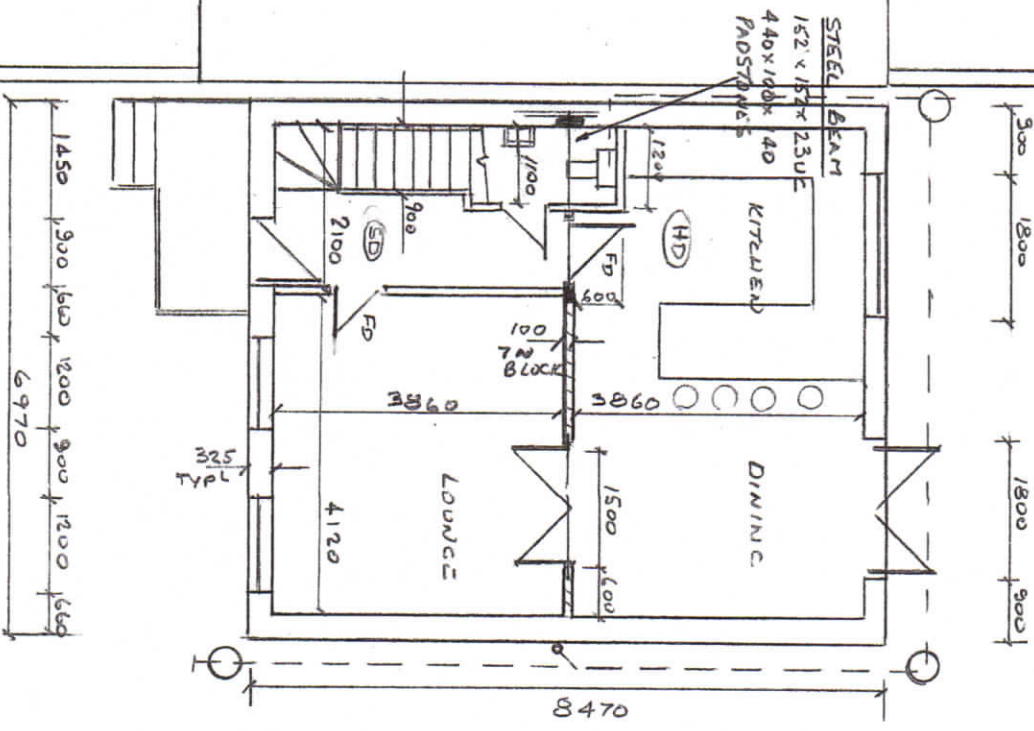

GROUND FLOOR PLAN
AS PLANNING APPROVAL

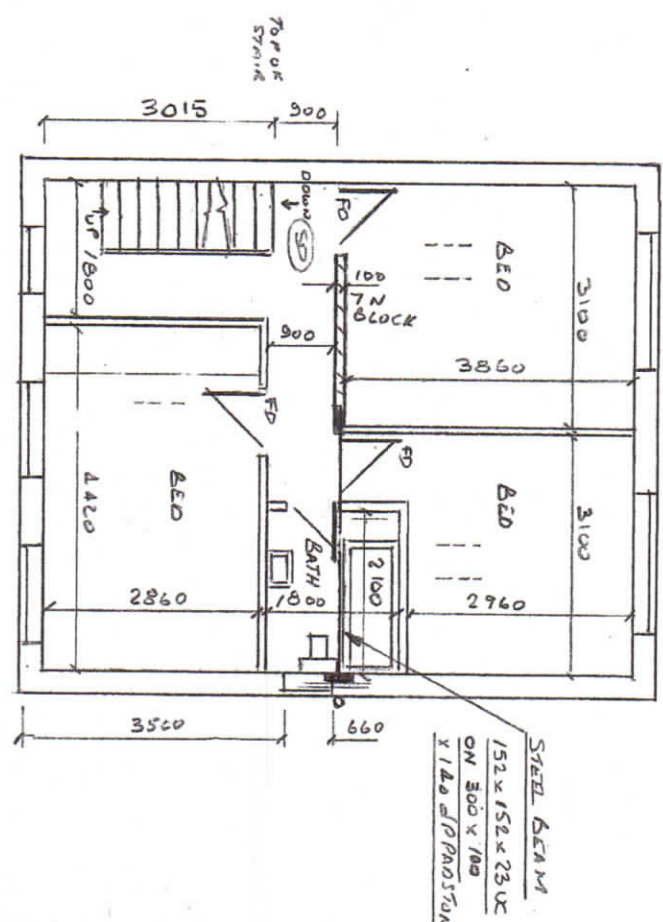

FIRST FLOOR PLAN
AS PLANNING APPROVAL

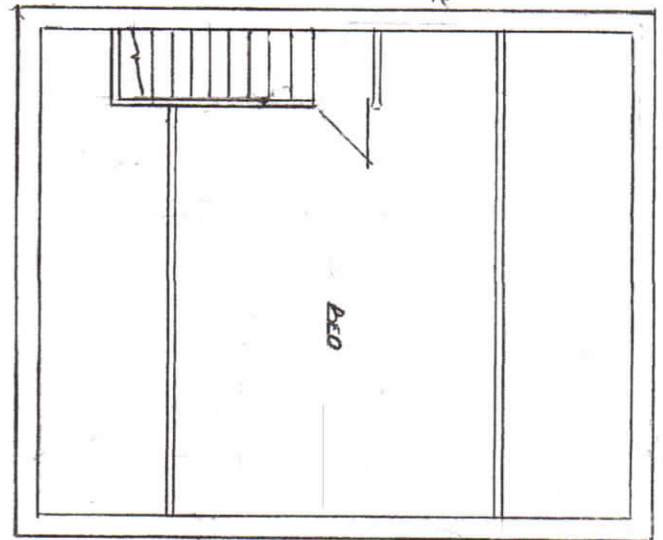


LOFT PLAN
AS PLANNING APPROVAL

Thompson Designs
Tel 0161 705 1458 Mob 07884 318634


PLANS AS PLANNING APPROVAL
49 LITTLEDALE STREET
BOCHDALE OL12 6SZ
AUG 2020 SCALE 1:100

REV 2

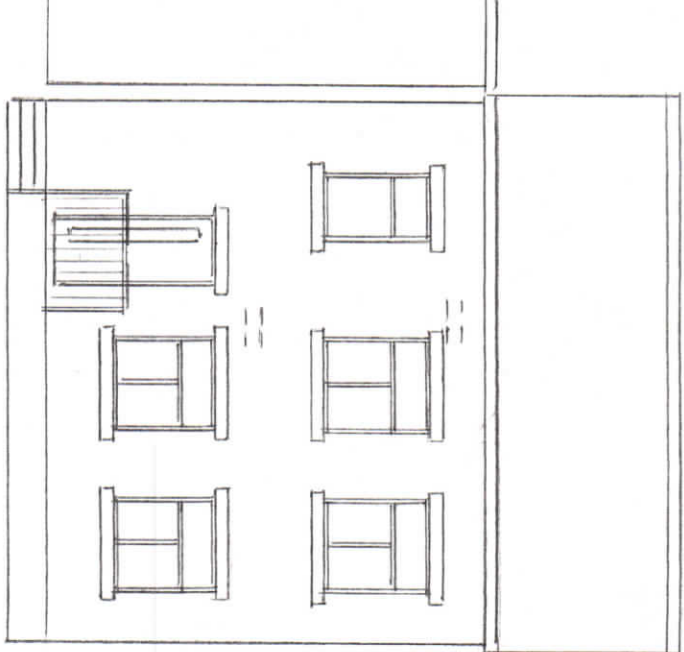


FRONT ELEVATION

AS BUILT

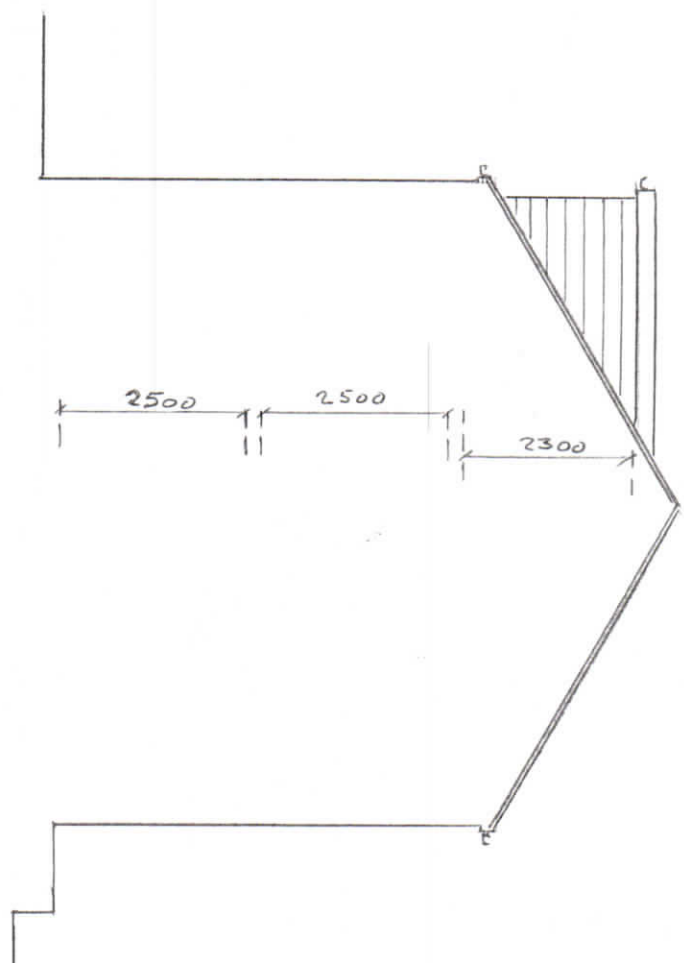

SIDE ELEVATION

AS BUILT

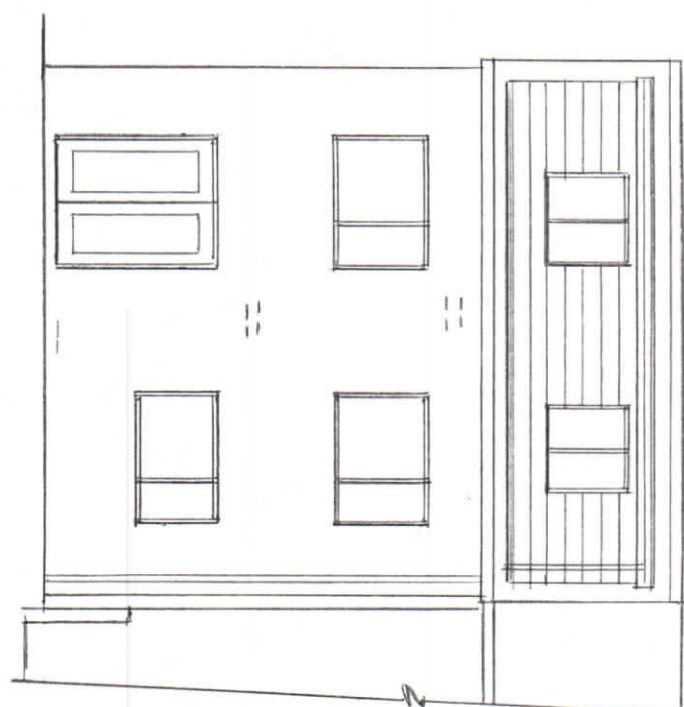

REAR ELEVATION


AS BUILT

300 1800 1800 900

1200 1200 1200 1200


RAFTERS 47x195 C24 @ 400 o/c

FLAT ROOF JOISTS 47x172 C16 @ 450 o/c

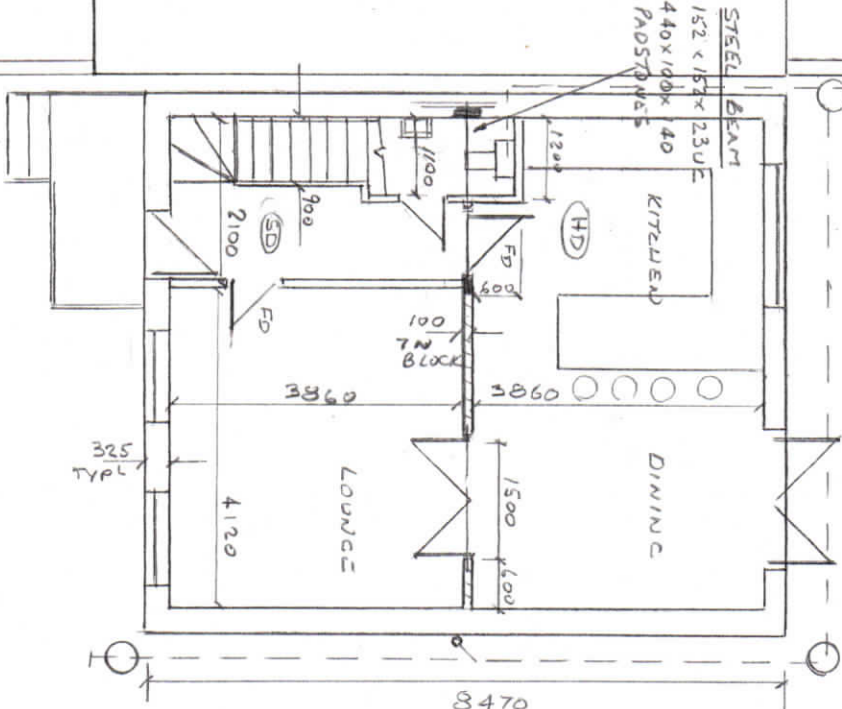


GROUND FLOOR PLAN

AS BUILT

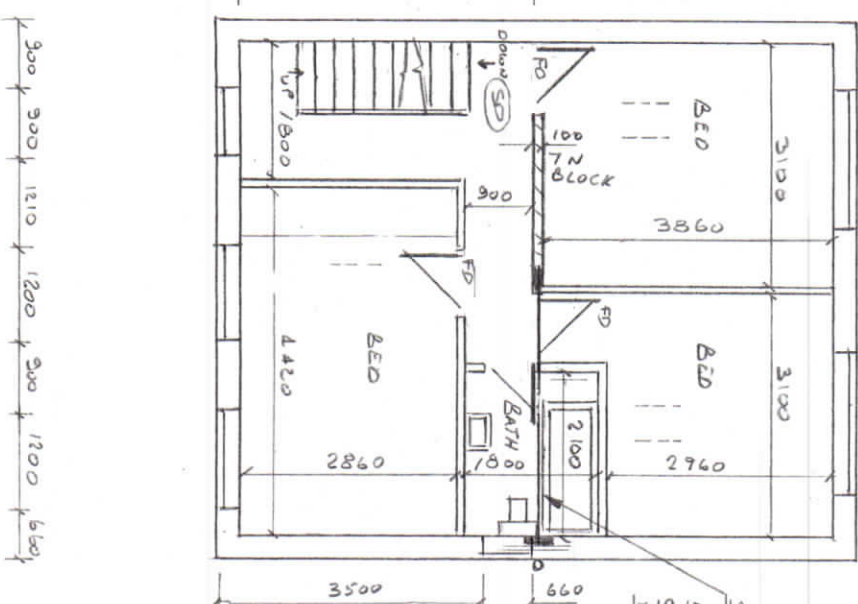

FIRST FLOOR PLAN

AS BUILT

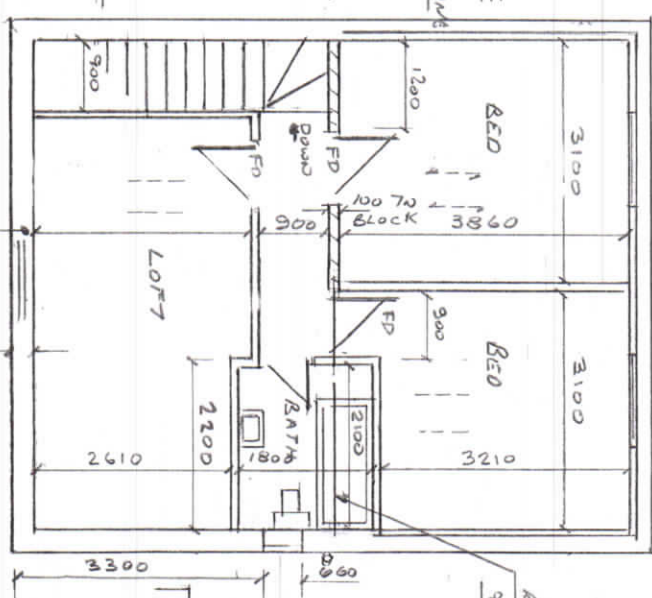

LOFT PLAN AS BUILT

ALL WALLS 100 G/L, 125 CAVITY

100 7U BLOCK

REV 2

Thompson Designs Tel 0161 705 1458 Mob 07884 318634	
PLANS AS BUILT 49 LITTLE DALE STREET BOCHDALE OL12 6SZ	AUG 2020 SCALE 1:100