




01 Existing Section A:A
Scale 1:100 @ A2

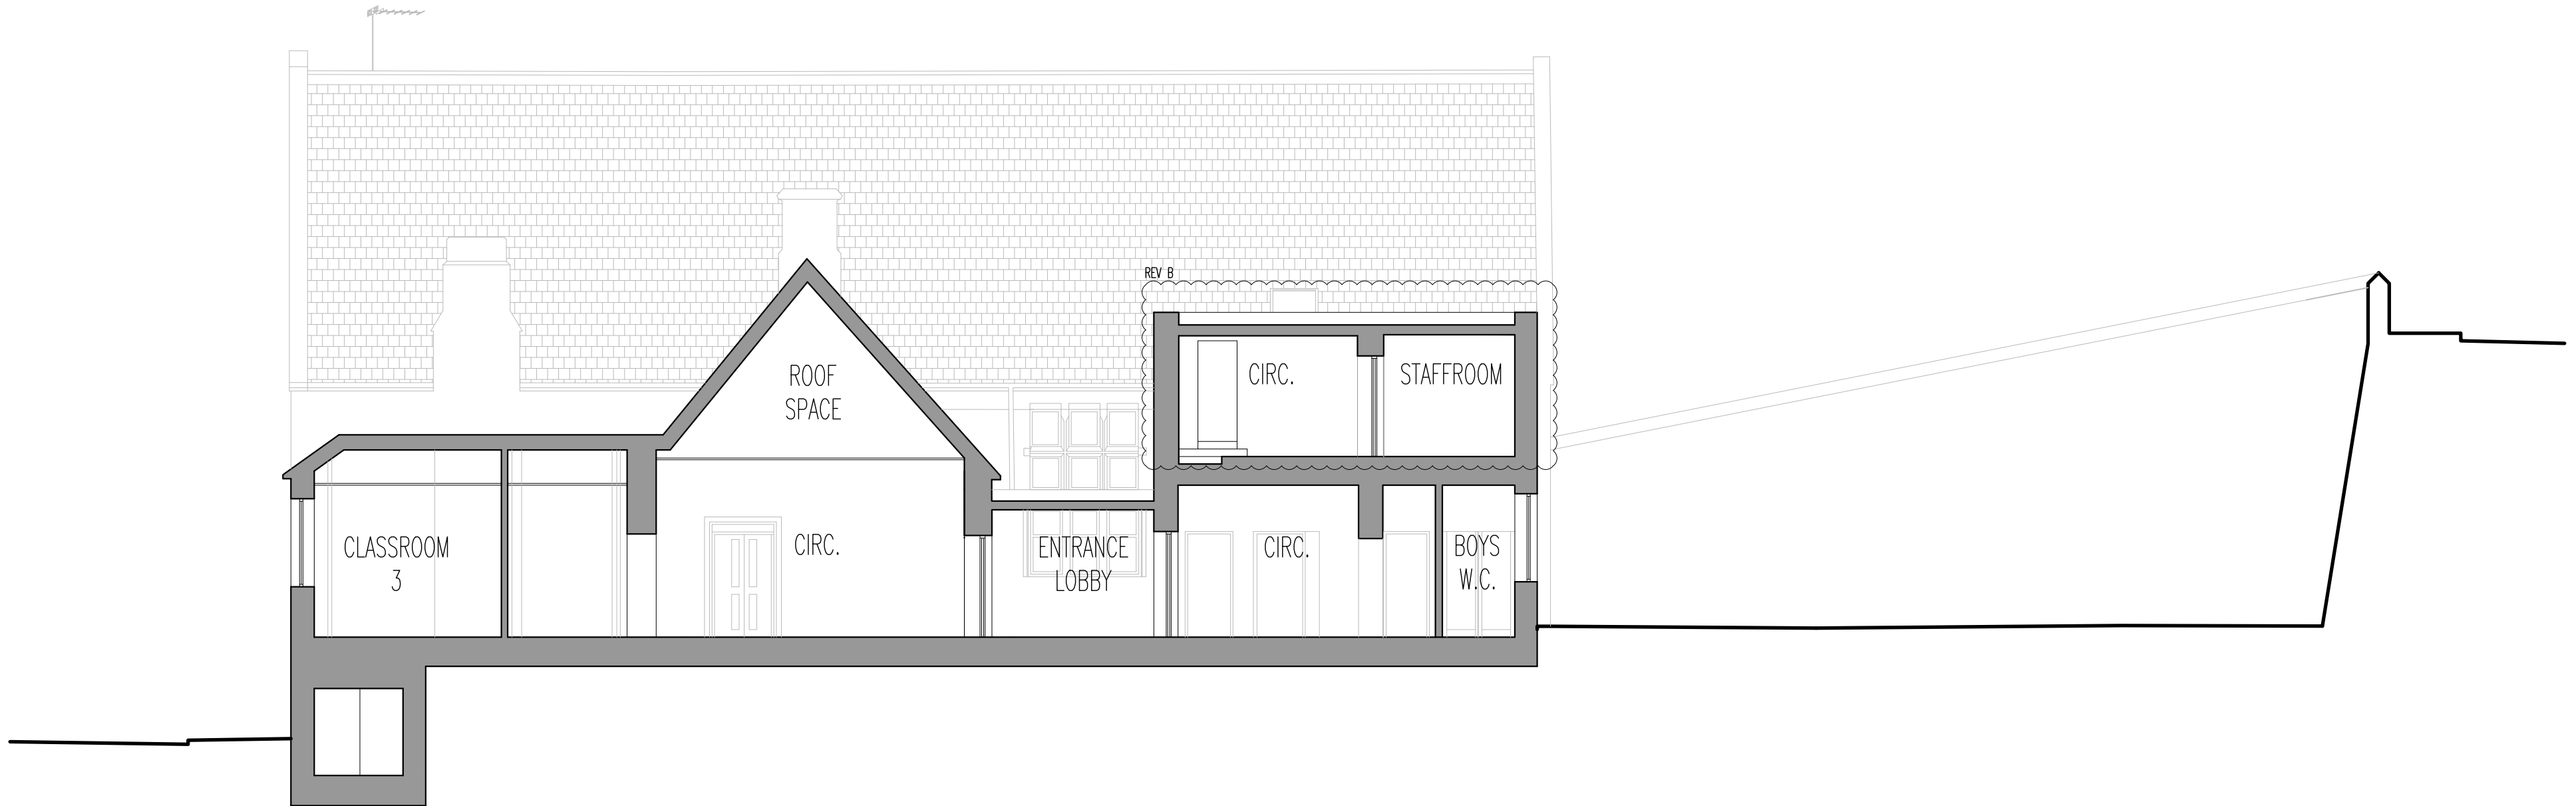

02 Existing Section B:B
Scale 1:100 @ A2

B	EXISTING ROOFLIGHT ADDED, STAIRWELL CEILING & PARAPETS CORRECTED.	20.05.24	RB	MT
A	LABELLING UPDATED FOR PLANNING.	25.10.23	RB	MT
Rev	Description	Date	By	Chk

Status	Purpose for Issue
Planning ☒	Tender ☐
Construction ☐	As Built ☐
PLANNING	

Client
THE GOVERNORS OF ST. THOMAS' C. OF E. PRIMARY SCHOOL

Contract
PROPOSED NEW ENTRANCE, ADMIN BLOCK STAFF AREAS + TOILETS

Drawing
EXISTING SECTIONS

bateandtaylor
architects

www.bate-taylor.co.uk

macintosh house
cambridge street
manchester m1 5gg

tel: 0161 236 0999
fax: 0161 236 0404
mail@bate-taylor.co.uk

Drawing No.	MH1393-07	Revision	B
Scales	1:100 @ A2	Date	SEPT '23
Drawn	SM	Checked	MDM

This drawing is the copyright of the Architect and may not be reproduced without licence.
DO NOT scale from this drawing.