



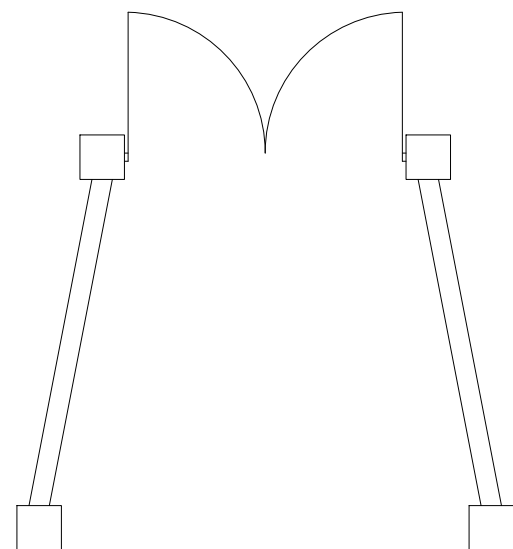


plan of entrance gates

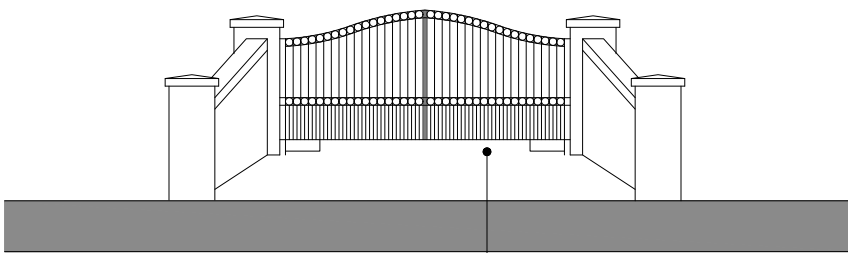


front elevation

wrought metal gates painted black

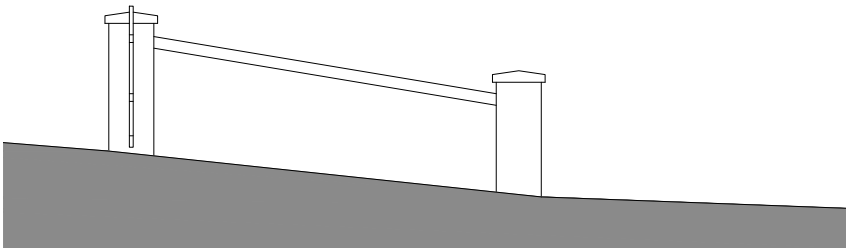


right-hand elevation

natural stone piers, walls, and copings

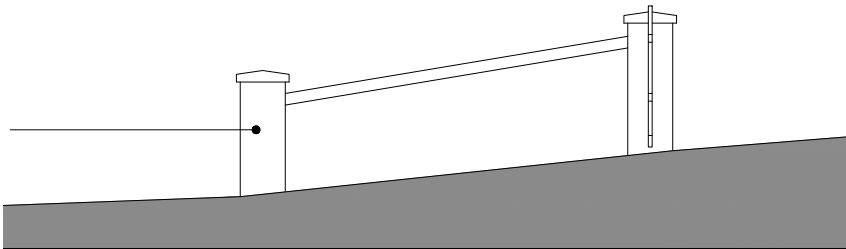

left-hand elevation

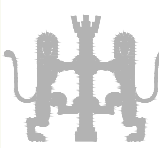Kieren and Jo McDonnell Proposed Eco Home Mill House Farm Overtown Lane Norden	Entrance Gates AS BUILT	contract no 3396	drawing no 22	revision	Blue Pit Mill Queensway Castleton Rochdale OL11 2PG +44 (0)1706 631347 info@cjpartnership.com www.cjpartnership.com	CJPARTNERSHIP ENVIRONMENTAL ARCHITECTS 
	work to figured dimensions	drawn by PDC	date June 2023	scale @ A3 1:100		
	© CJ Partnership owns the copyright of this design / drawing which must not be reproduced in whole or in part without the written permission of CJ Partnership			Revisions: A.		