



Conway Architectural Design shall have no responsibility for any use made of this document other than for that which it was prepared and issued. This drawing should not be scaled. Work to figured dimensions only. All dimensions and levels to be checked on site. No building work is to be started until all relevant approvals are in place. Any discrepancies should be reported to Conway Architectural Design. This drawing should not be reproduced without written permission from Conway Architectural Design. **Standard Building Regs Notes are to be provided by Conway Architectural Design prior to a building regs application being submitted.**




Site Plan
Scale 1:200

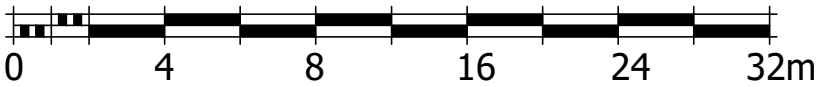

SCALE 1 : 2 0 0

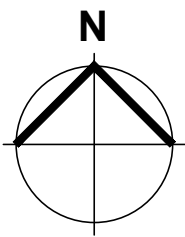

Block Plan
Scale 1:500

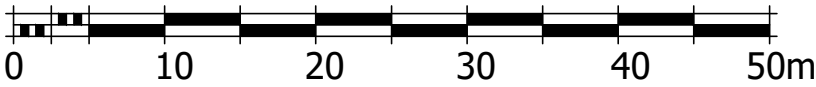

SCALE 1 : 5 0 0

Conway Architectural Design	6 Conway Close Alkrington Middleton Manchester, M24 1EW
	E: conway-design@outlook.com

JOB TITLE :	As Built Outbuildings
ADDRESS :	Glenmore, Alkrington Hall, Alkrington
DRAWING TITLE :	Site And Block Plans
SCALE :	As Noted @ A3
DRAWN : xxx	DATE : 24.05.24