


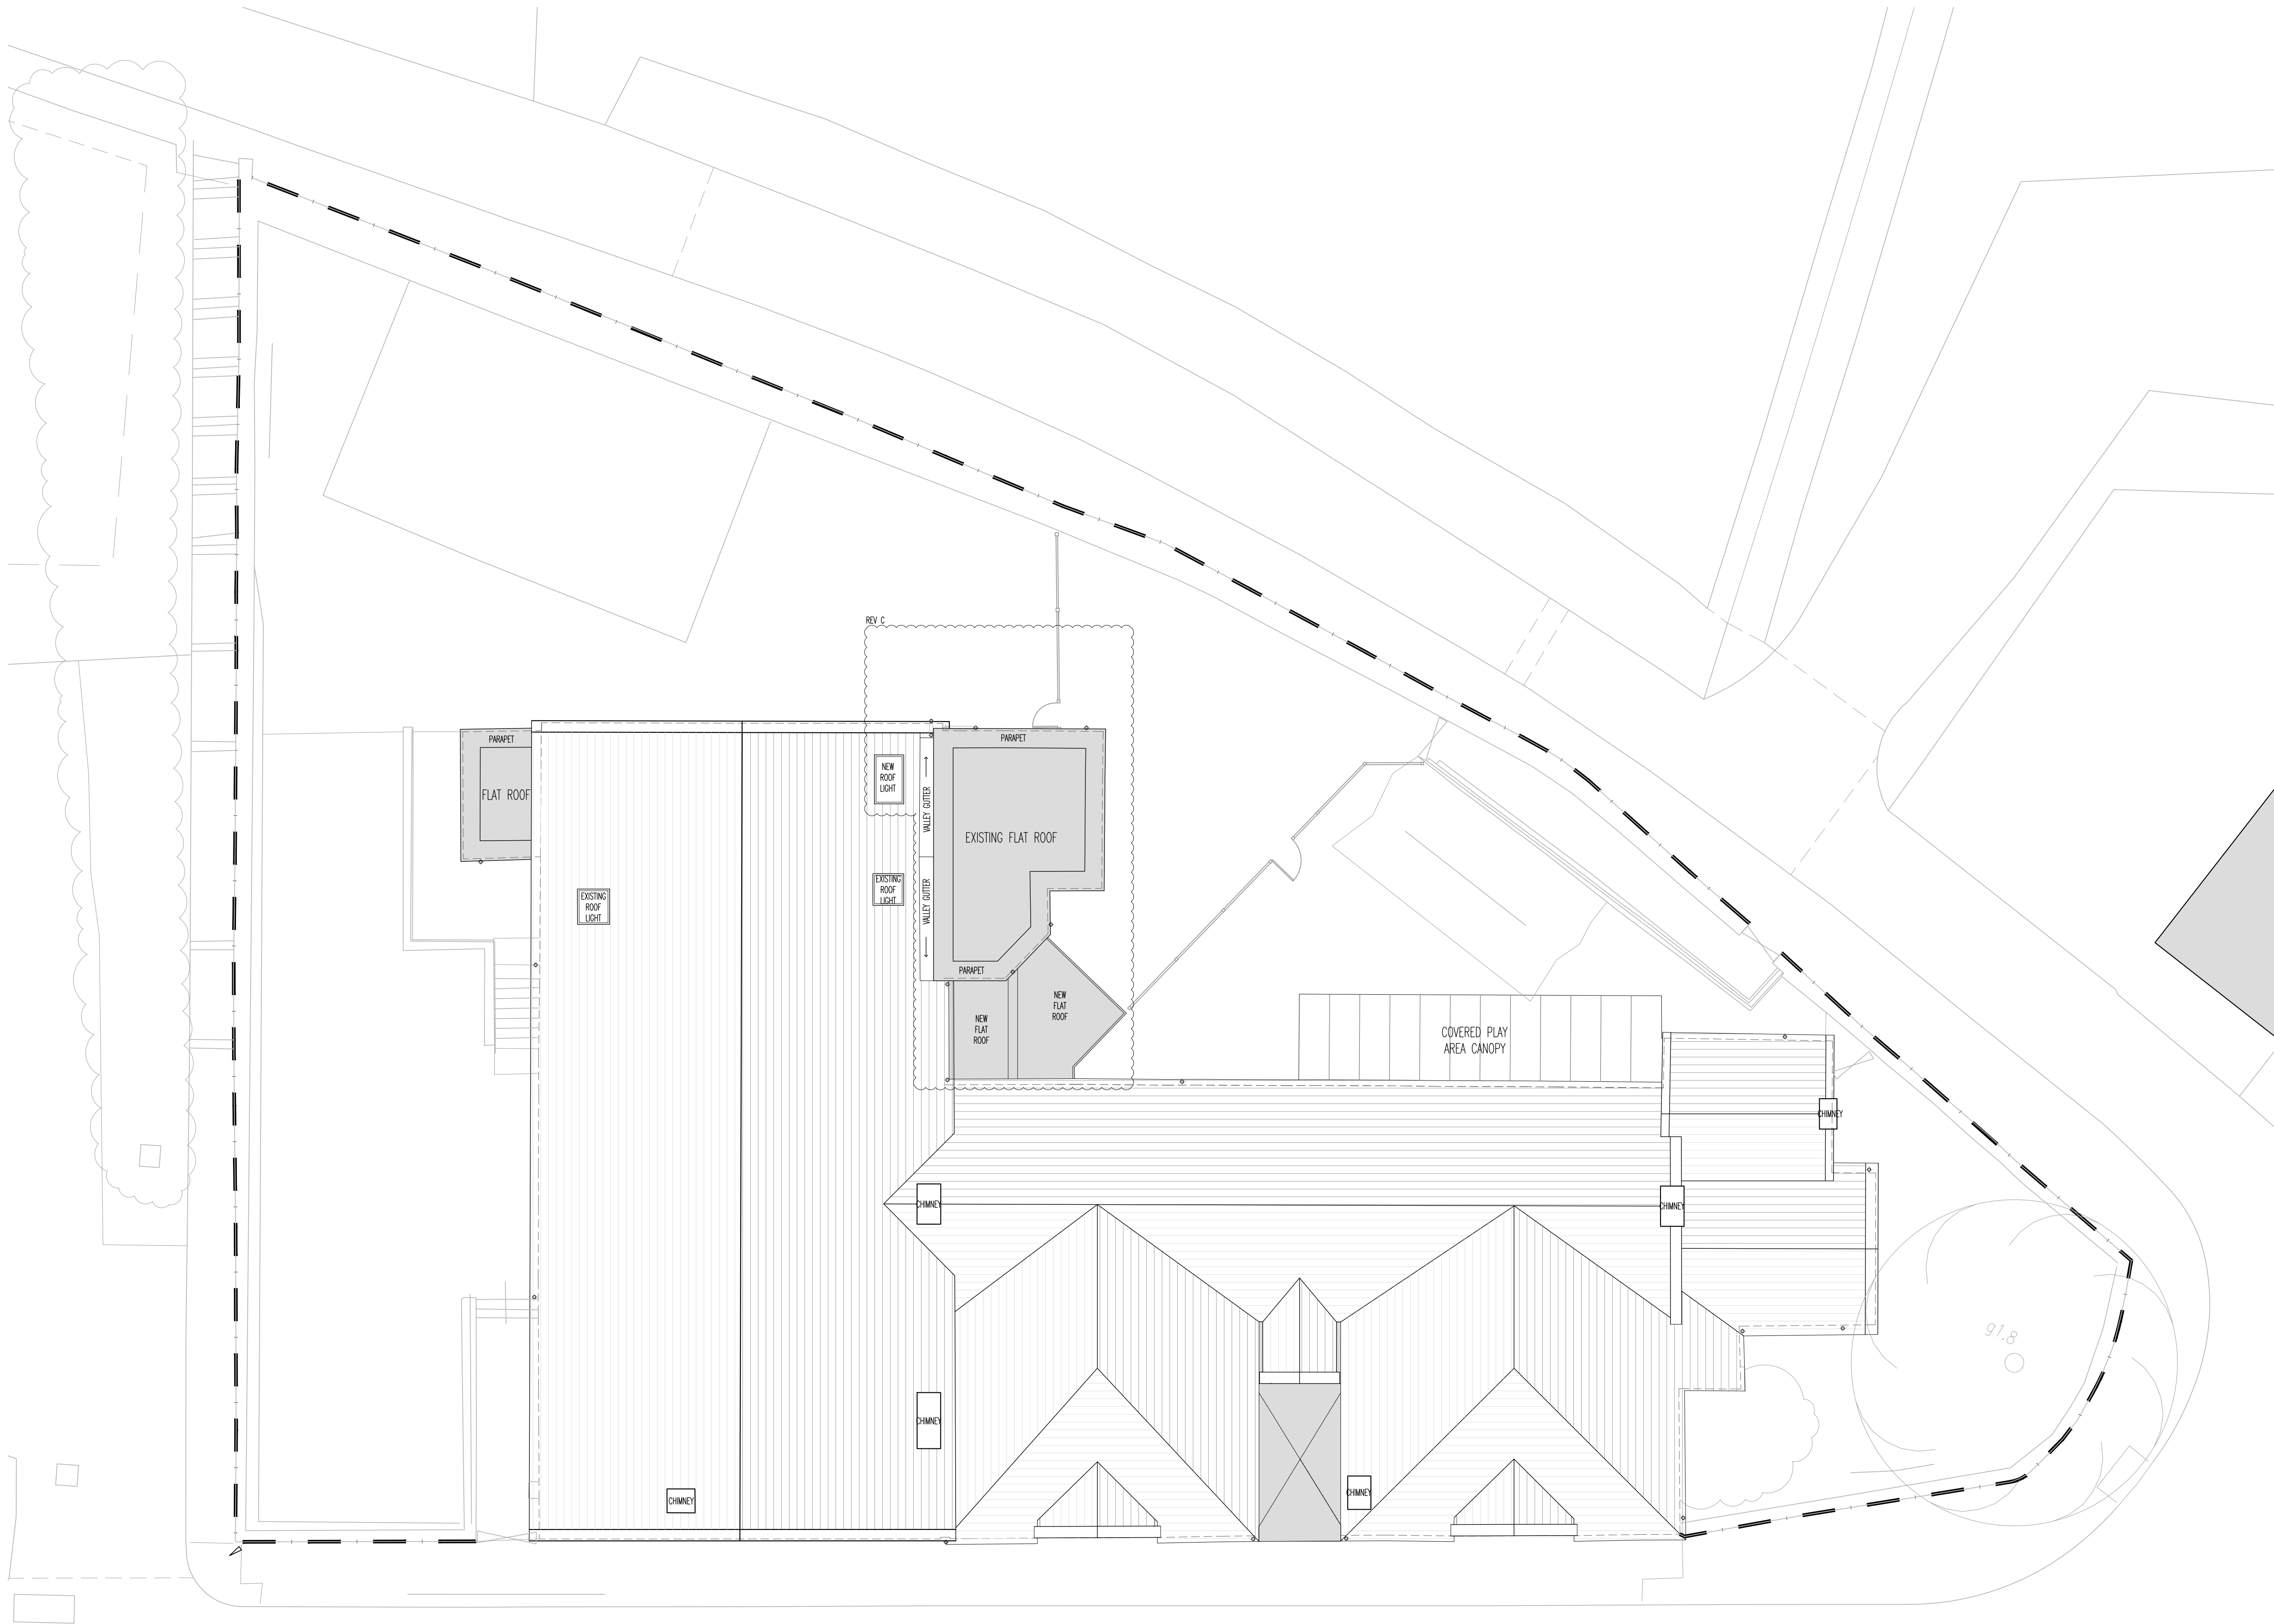

C	AREAS OF WORK REMOVED.	20.05.24	RB	MDM
B	AREAS OF WORK REMOVED.	25.10.23	RB	MDM
A	PROPOSED MAIN ENTRANCE ROOF UPDATED.	04.07.23	SM	MT
Rev	Description	Date	By	Chk

Status	Purpose for Issue
Planning ☒ Tender ☐	☐ PLANNING
Construction ☐ As Built ☐	

Client
THE GOVERNORS OF ST. THOMAS' C. OF E.
PRIMARY SCHOOL, NEWHEY, ROCHDALE

Contract
PROPOSED NEW ENTRANCE, ADMIN BLOCK
STAFF AREAS + TOILETS

Drawing
PROPOSED ROOF PLAN

bateandtaylor
architects
www.bate-taylor.co.uk
macintosh house
cambridge street
manchester m1 5gg
tel: 0161 236 0999
fax: 0161 236 0404
mail@bate-taylor.co.uk

Drawing No. MH1393-11
Scales 1:100 @ A1
Drawn SM
Revision C
Date SEPT '23
Checked MDM

This drawing is the copyright of the Architect and may not
be reproduced without licence.
DO NOT scale from this drawing.