


410 BIRCH ROAD
PROPOSED SITE & BOUNDARY, WITH EXISTING CULVERT MARKUP

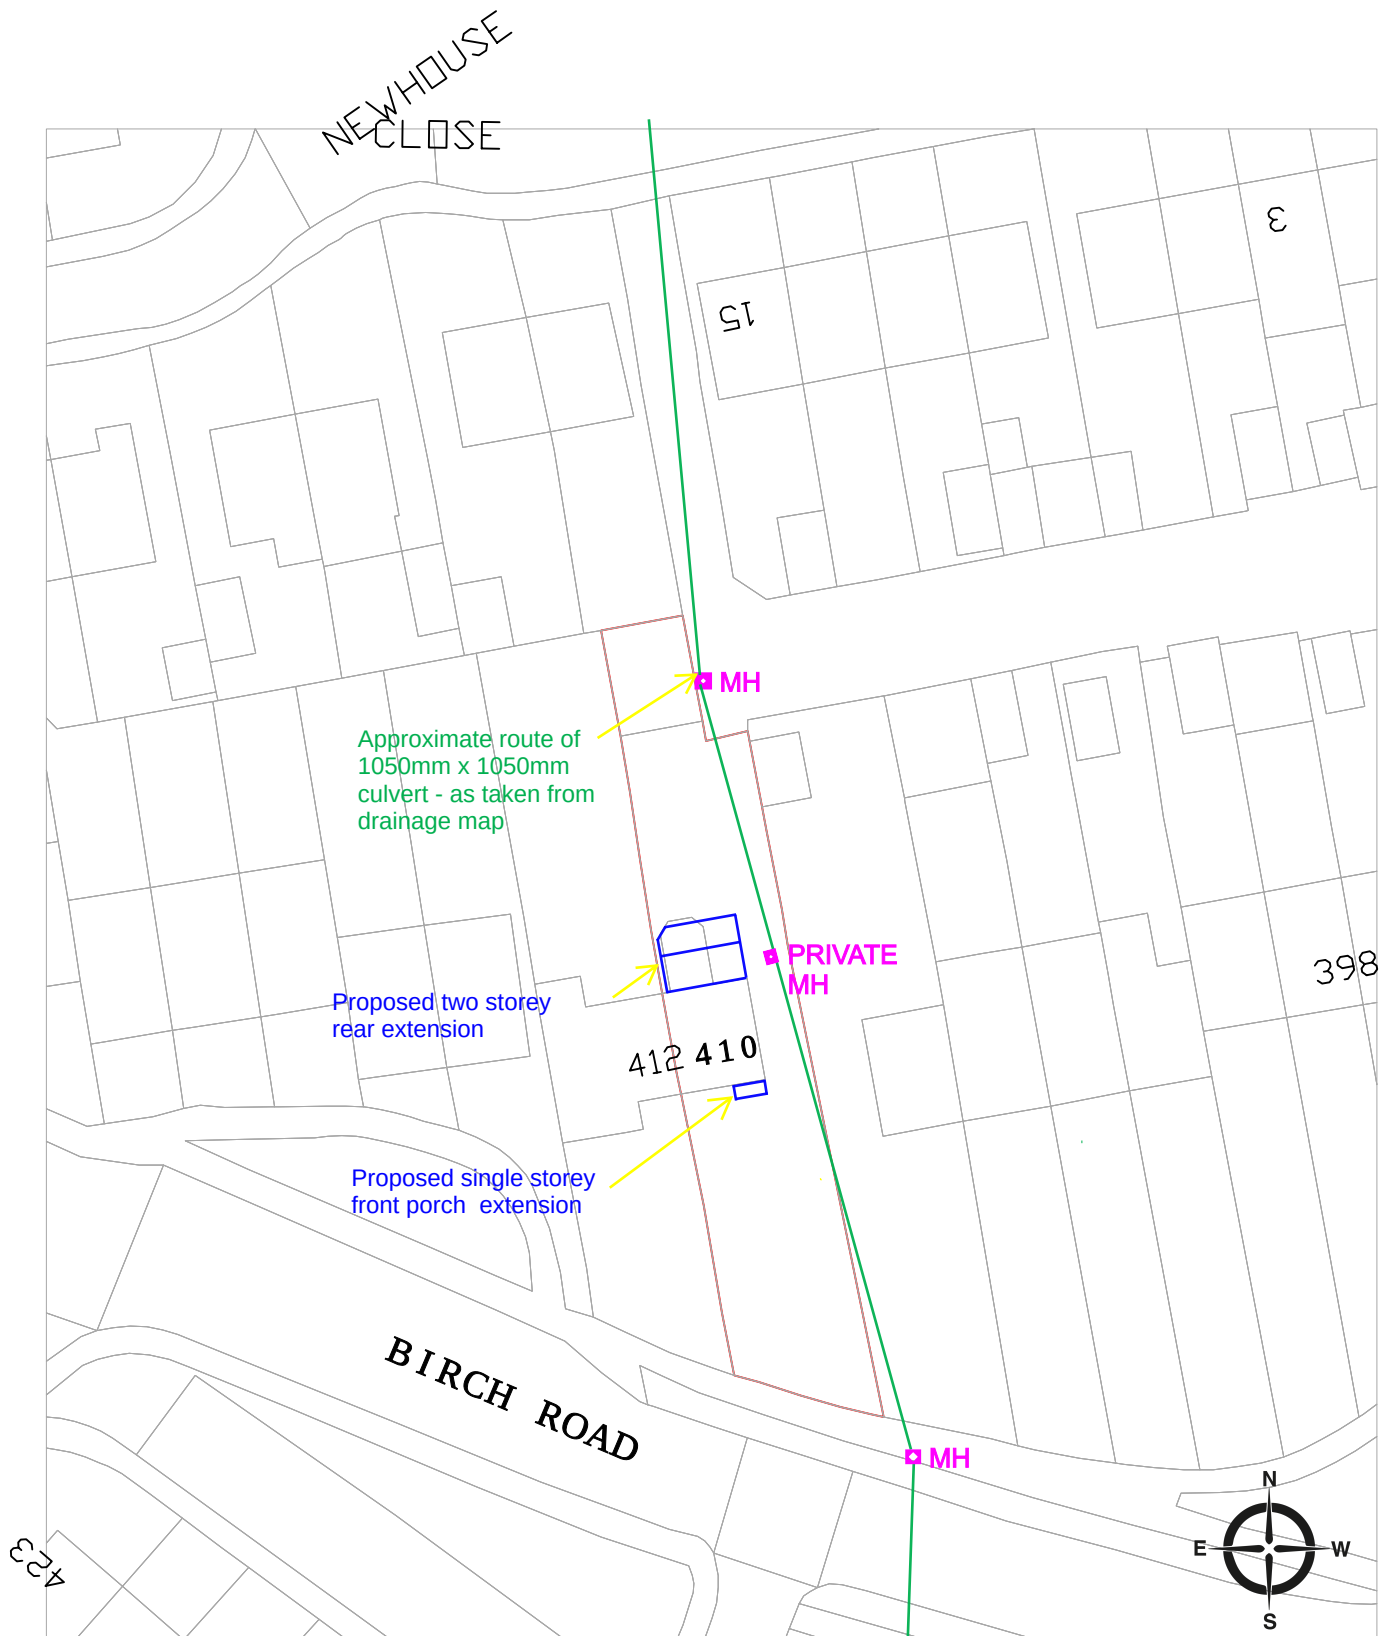

ReQuestAPlan
Map number: TQRQM2111122944718

Title: 410 Birch Road - Location / Site Plan
Map Produced For: RBC Development Management
? Crown copyright and database rights 2021 OS 100042766
Project ID:
Date of Purchase: 21-04-2021
1 Years subscription from 21-04-2021 for 1 workstation.

SCALE = 1:500

10 m