


PRE-
EXISTING
S/E ELEVATION 20/8/23

52 NEWHOUSE ROAD, HEYWOOD, OL10 2NU

EXISTING DORMERS FACED WITH
WHITE UPVC CLADDING

FACIAS AND SOFFITS UPVC
BRICKWORK WALLS

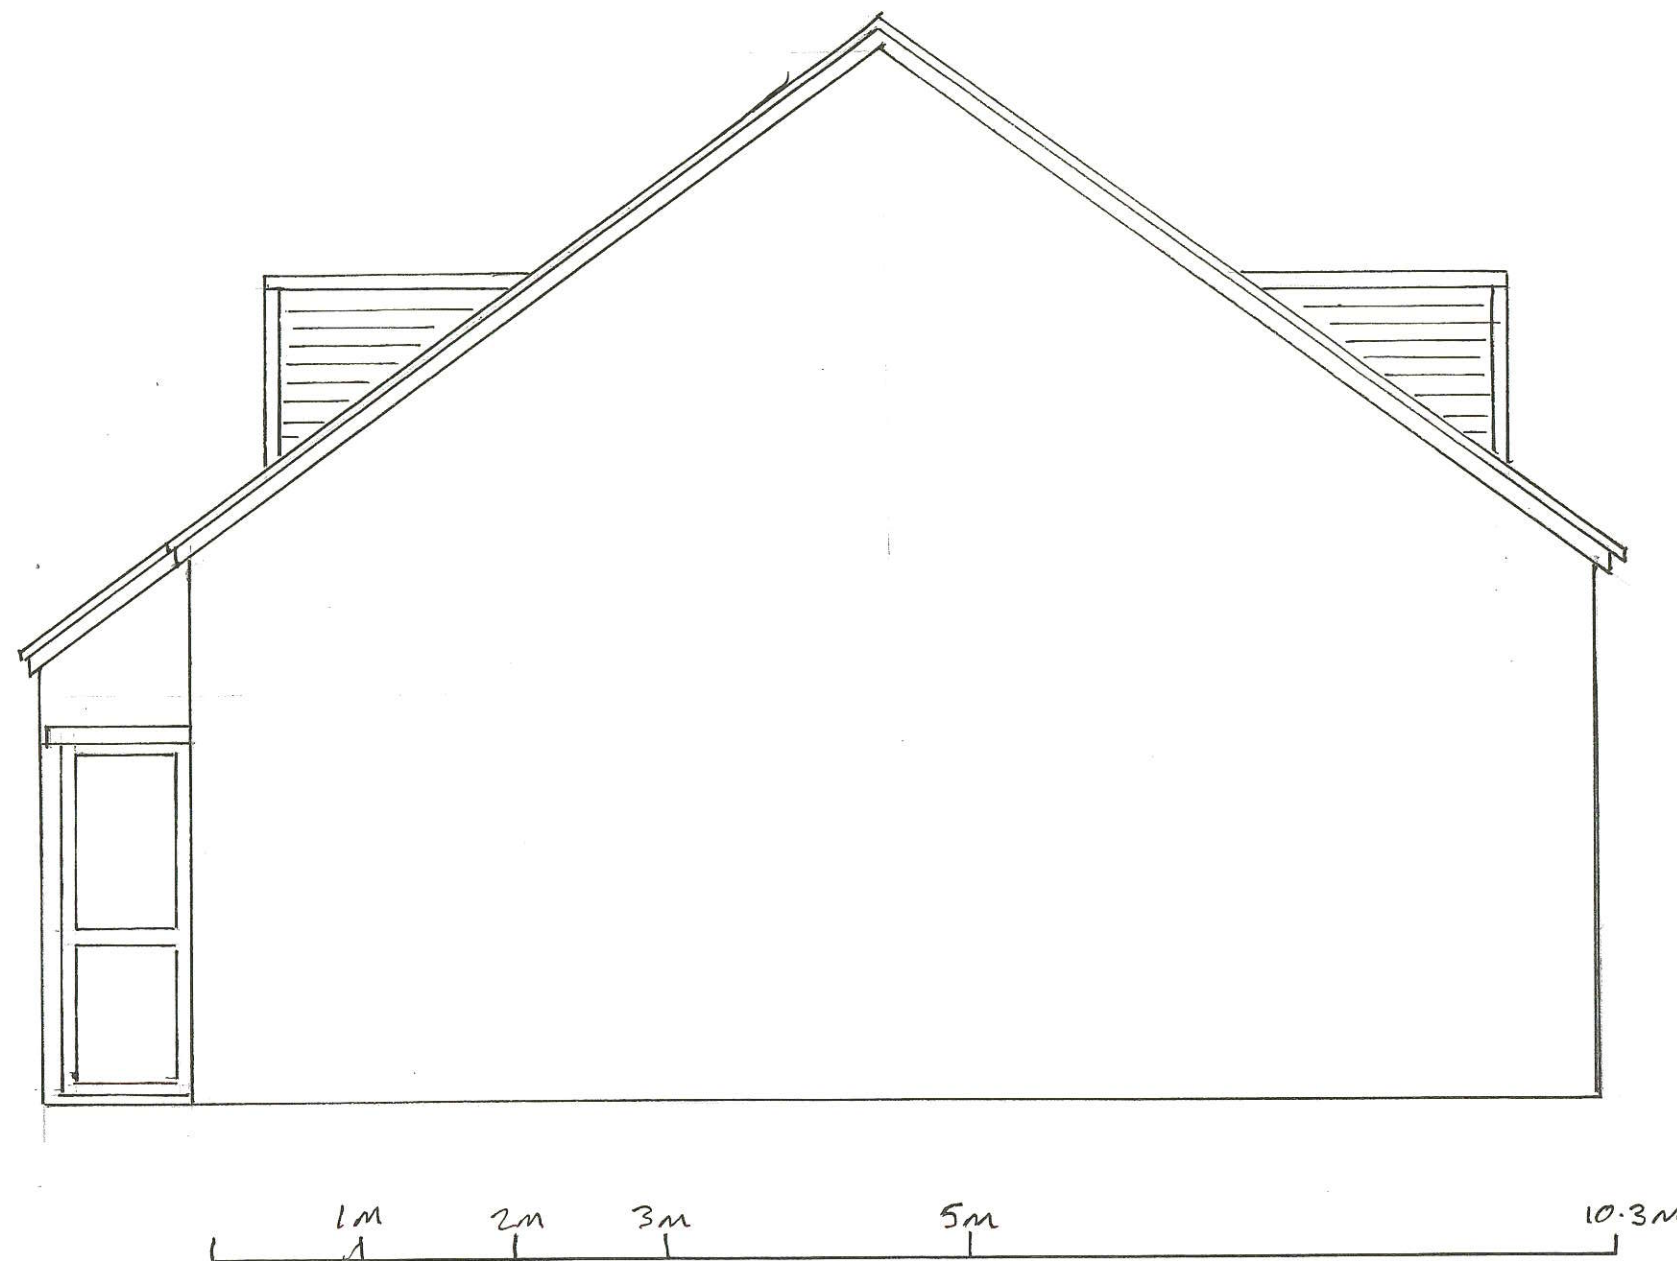

SCALE 1:50


DRAWING 11

AS BUILT AS BUILT
EXISTING ELEVATION AS OF
24/7/24 INSPECTION 026431

S/E ELEVATION

52 NEWHOUSE ROAD, HEYWOOD, OLIO 2MU

THIS WAS THE PROPOSED ELEVATION
AS OF 20/8/23. IT IS NOW THE
EXISTING ELEVATION, BEING PASSED
BY BUILDING CONTROL ON 24/7/24
TO BE COMPLIANT WITH CURRENT
REGULATIONS.

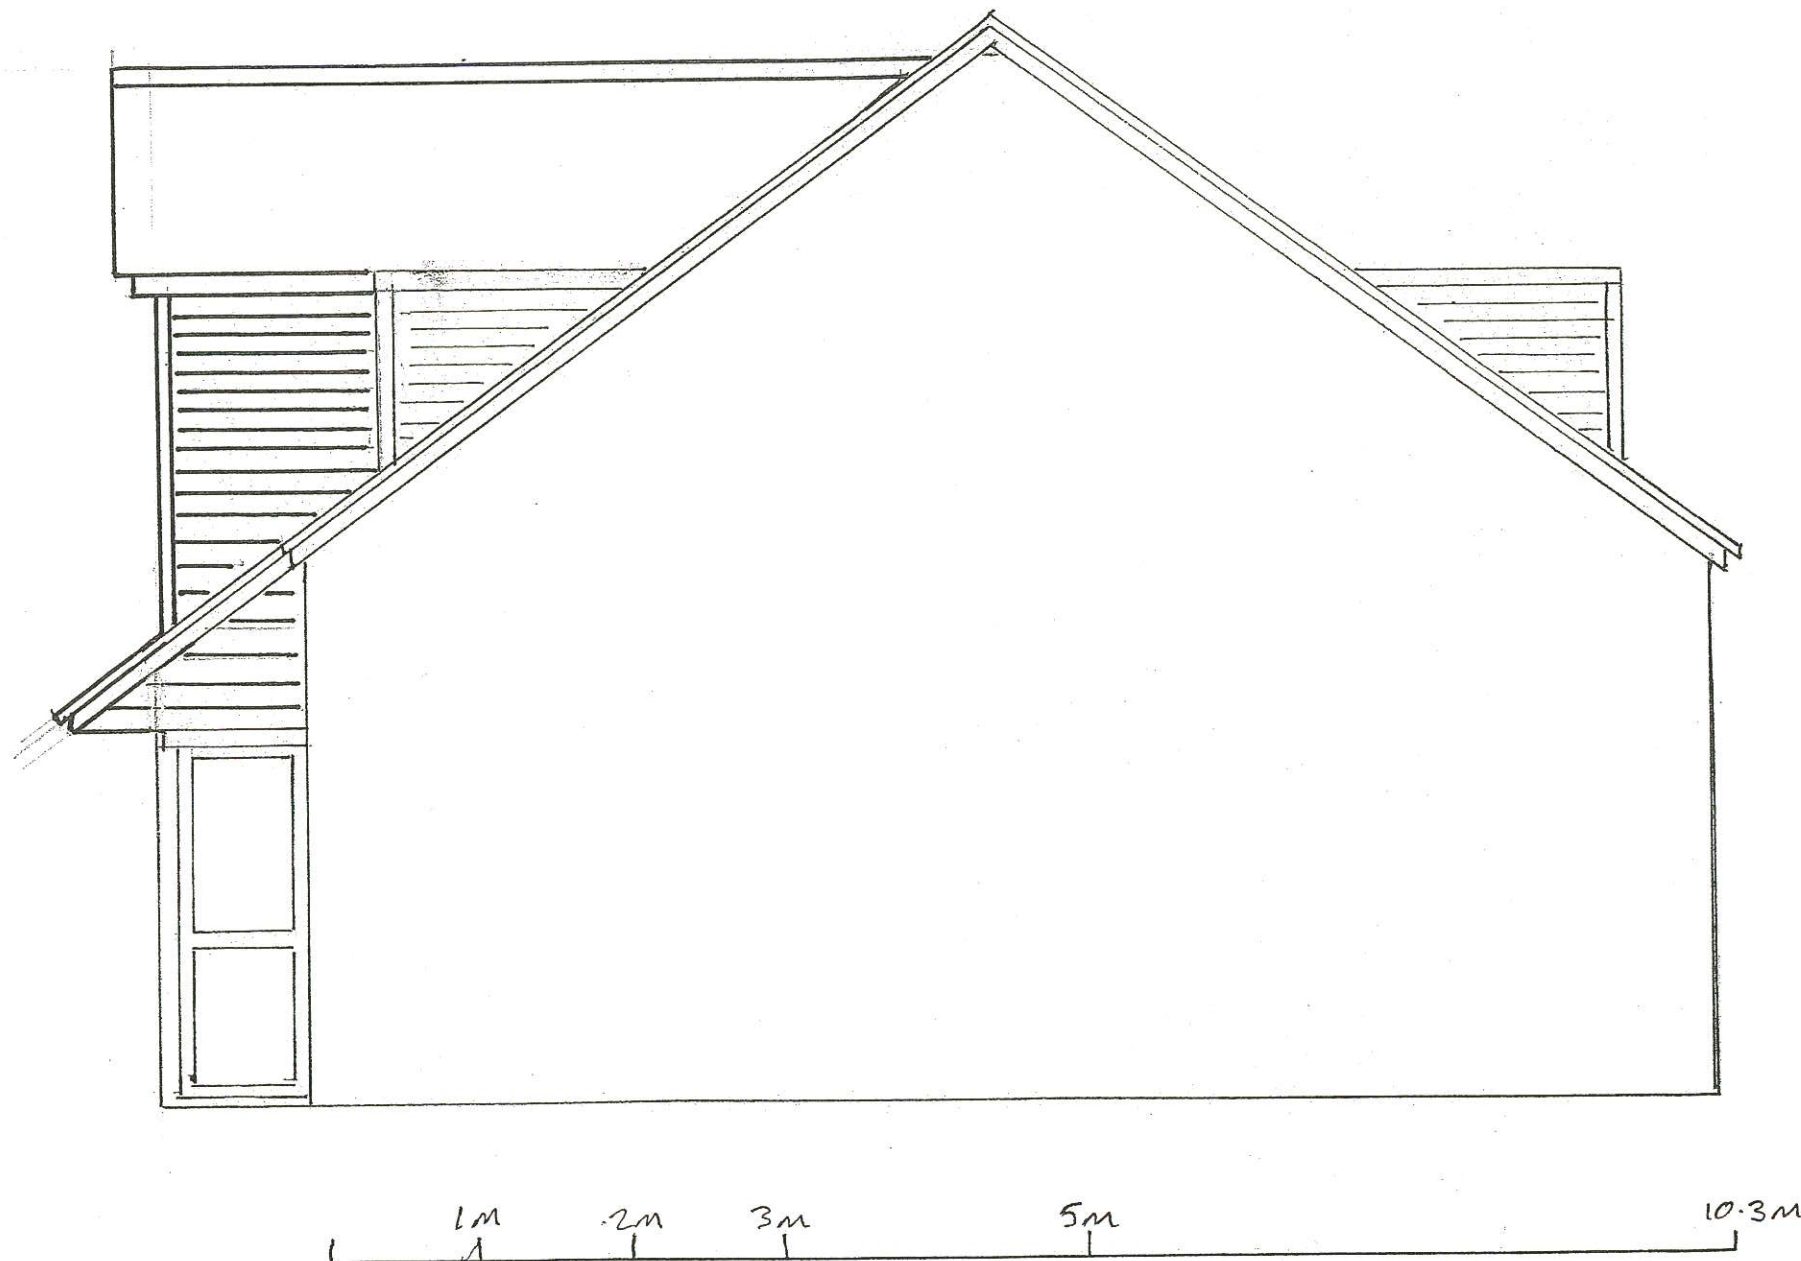

SCALE 1:50


DRAWING 12.

PROPOSED

PROPOSED CHANGES TO
52 NEWHOUSE ROAD
HEYWOOD OL10 2NU

S/E ELEVATION

26/8/24

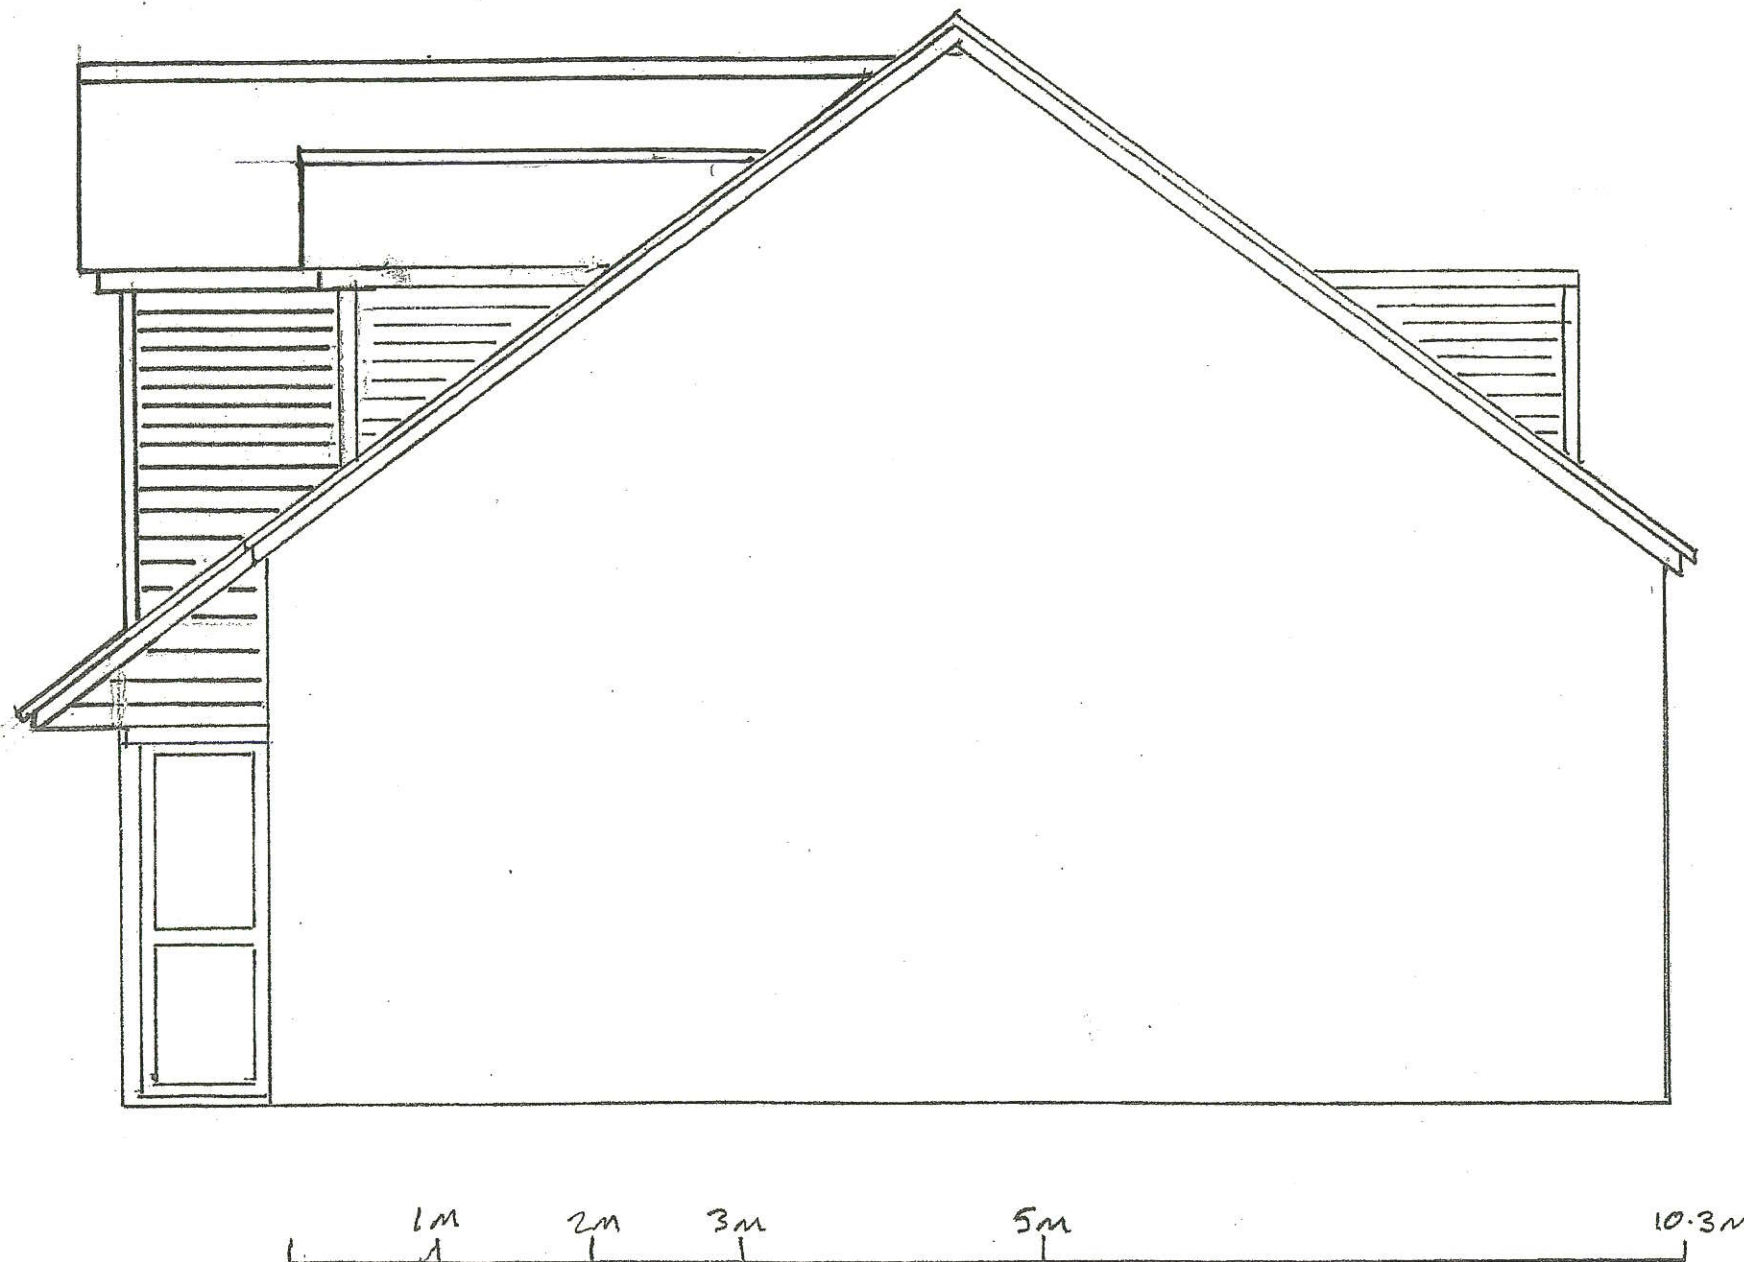

DRAWING 13