

soiltechnics

environmental • geotechnical • building fabric

Desktop Study: Site Review

Proposed Floodlit PlayZone Pitch

Stoneyfield Park, Rochdale

February 2024

Contents

Desk Study Information

Review and Recommendations

Statutory Undertaker Records



Desk Study Information

Proposal and Site Setting

The proposals are for a refurbishment of a 16m x 30m tarmacadam multi-use games area (MUGA) to an LED floodlit Polymeric PlayZone pitch for football, netball and basketball use.

The development lies within the grounds of Stoneyfield Park, Rochdale, approximately 1km to the southwest of Rochdale Town Centre. Boundary Street, located to the east of the site, provides access and the postcode is OL11 1AT. The existing MUGA is bound by steel fencing and a brick wall some 1m in height, and no floodlighting is currently present. Surface levels are flat across the MUGA.

The wider site comprises of grassed public space associated with Stoneyfield Park. The proposed PlayZone location is situated to the northeast of the site, adjacent to the existing play areas. Adjacent land uses comprise a railway line running beyond the northwest boundary with residential properties located on all other sides.

The closest surface water feature is Sudden Brook approximately 270m to the southeast of the site, which feeds into the Rochdale Canal.

A site location plan is presented below.



Figure 1-1: Aerial photography with approximate site boundary (red line) and proposed PlayZone (blue line)

Site History

An attempt to trace the history of the site has been carried out by reviewing readily available ordnance survey maps. Earliest records date back to the mid-1800s and show the proposed development area to comprise part of an agricultural field with a track. By the late 19th/early 20th century a marble works lies 20m north of the proposed PlayZone as well as a saw mill 40m east and a carriage shed and railway line 40m north of the area (see Figure 1-2).

Mapping from the mid-20th century shows the site remained as undeveloped public open space. A pond is noted within the wider site boundary (red line) 50m southwest of the proposed PlayZone location.

Aerial Imagery (Google Earth) indicates the construction of the existing MUGA pre-2000, with the surrounding area part of Stoneyfield Park.



Figure 1-2: 1892-1914 Historical map extract overlay showing the site boundary (red line) and proposed PlayZone (blue line)

Geology and Hydrogeology

Open-source British Geological Survey (BGS) mapping for the area shows superficial deposits to comprise Glaciofluvial Deposits across the wider site (see Figure 1-3 below). Made Ground is not anticipated to be present in significant thickness beyond that associated with the current MUGA formation. The site is recorded in a buried valley, with up to 20-30m depth of superficial deposits present. There is likely to be deposits of Devensian Till at depth also.

The underlying bedrock is recorded as the Pennine Lower Coal Measures Formation (see Figure 1-4 below). No historic BGS borehole records are situated within close proximity to the site.



Figure 1-3: *Superficial geology*



Figure 1-4: *Bedrock geology*

A summary of the anticipated geology within the wider site can be seen below.

Strata	Bedrock or superficial	Approximate thickness (m)	Typical soil type	Likely permeability	Aquifer Designation
Made Ground	-	<1	Variable	-	-
Glaciofluvial Deposits (Till at depth)	Superficial	Up to 20-30	Sand, gravelly (Till is clay)	Moderate (low in Till)	Secondary A
Pennine Lower Coal Measures Formation	Bedrock	Basal unit	Sandstone, mudstone, siltstone and coals	Low to moderate	Secondary A

Table 1: Summary of geology and hydrogeology

Coal Mining

Coal Authority mapping data shows the site lies within a coal mining reporting area but outside of a development high risk area (see Figure 1-5 below). Given there are no shallow recorded or unrecorded workings, coal seams, mine entries or opencast sites within 100m of the site boundary, the risk from coal mining related ground instability is considered to be low. However, we recommend obtaining a Coal Authority Consultants report to confirm such conclusions.



Figure 1-5: Coal Authority hazard map extract

Landfilling and ground gases

Open-source Environment Agency landfill mapping data indicates the proposed development is not located within 250m of a recorded landfill (see Figure 1-6 below). Given the nature of the proposed development (open air pitch) the risk from ground gases is considered to be very low.



Figure 1-6: Landfill mapping data

Flooding and Hydrology

According to Environment Agency flood maps, the PlayZone location and wider site lie within a Flood Zone 1, therefore the risk from surface water flooding is low.

Statutory Undertaker Records

We have contacted a number of Statutory Undertakers and obtained a Linesearch report to obtain copies of available records to avoid damaging buried apparatus during fieldwork activities. Copies of their records are appended; however, it should be noted that private runs are typically excluded from these records.

No statutory undertaker utilities runs are recorded underlying the proposed PlayZone area.

Review and Recommendations

The following site specific factors have been considered to determine the most appropriate ground investigation on site:

- Significant Made Ground is not anticipated based on the site history.
- Geological records indicate that the site is underlain by the Glaciofluvial Deposits, with Till at depth. Such deposits are likely to provide suitable support to proposed floodlight foundations and pitch formation.
- A tarmacadam refurbishment investigation comprising 6No. hand pits is recommended for the proposed PlayZone pitch to determine sub-base/subgrade conditions beneath the existing MUGA. Extension of 2No. pits to 1.2m depth will be undertaken to determine deeper ground conditions for floodlight foundation design.
- Glaciofluvial Deposits may exhibit some permeability, as such, may be amenable for soakaway and drainage systems. This would need to be confirmed through on-site investigation.
- The site lies within a coal reporting area. We recommend a Coal Authority Consultants report obtained to further assess the site. However, at this stage, the risk of land instability posed to the development is considered to be low.
- Given the proposed PlayZone pitch is unlikely to extend into the surrounding grassed areas, we have not made allowance for Topsoil testing at the stage.
- An allowance has been provided to test any Made Ground for waste disposal purposes.
- We have included for completion of a topographical survey of the pitch area and the immediate surroundings.
- As there is no existing electrical/floodlight infrastructure, therefore an electrical capacity survey is not recommended at this time.
- The site is located within a low risk UXO area. Consequently, it is not a necessity to obtain a preliminary UXO risk review to determine likelihood of encountering UXO during investigation.

Costs to complete the above are as follows, based on assessment of a single pitch area only;

Item	Service	Timescale (weeks)	Comments
1.0	Desktop Study Site Review	Complete	
2.3.2	Framework Tarmacadam Pitch Refurbishment inc drainage survey		6No. pits including 2No. extended to 1.2m depth for floodlights
2.4	Topographical Survey		Pitch area and marginal areas beyond.
3.1	Coal Mining Report and Review		Site lies within a coal mining reporting area.
3.5	Waste classification and WAC analysis		Classification of any Made Ground for waste disposal if present.
TOTAL			

Statutory Undertaker Records

Soiltechnics

**Soiltechnics
Cedar Barn,
Walgrave,
NN6 9PY**

FAO:

How to contact us:

**United Utilities Water Limited
Property Searches
Haweswater House
Lingley Mere Business Park
Great Sankey
Warrington
WA5 3LP**

Telephone: 0370 7510101

E-mail: propertysearches@uuplc.co.uk

**Your Ref: STW6382
Our Ref: UUPS-ORD-544256
Date: 24/01/2024**

Dear Sirs**Location: Stoneyfield**

I acknowledge with thanks your request dated 23/01/2024 for information on the location of our services.

Please find enclosed plans showing the approximate position of United Utilities' apparatus known to be in the vicinity of this site.

The enclosed plans are being provided to you subject to the United Utilities terms and conditions for both the wastewater and water distribution plans which are shown attached.

If you are planning works anywhere in the North West, please read United Utilities' access statement before you start work to check how it will affect our network. <http://www.unitedutilities.com/work-near-asset.aspx>.

I trust the above meets with your requirements and look forward to hearing from you should you need anything further.

If you have any queries regarding this matter please [contact us](#).

Yours Faithfully,



Karen McCormack
Property Searches Manager


TERMS AND CONDITIONS - WASTEWATER AND WATER DISTRIBUTION PLANS

These provisions apply to the public sewerage, water distribution and telemetry systems (including sewers which are the subject of an agreement under Section 104 of the Water Industry Act 1991 and mains installed in accordance with the agreement for the self construction of water mains) (UUWL apparatus) of United Utilities Water Limited "(UUWL)".

TERMS AND CONDITIONS:


- This Map and any information supplied with it is issued subject to the provisions contained below, to the exclusion of all others and no party relies upon any representation, warranty, collateral contract or other assurance of any person (whether party to this agreement or not) that is not set out in this agreement or the documents referred to in it.
- This Map and any information supplied with it is provided for general guidance only and no representation, undertaking or warranty as to its accuracy, completeness or being up to date is given or implied.
- In particular, the position and depth of any UUWL apparatus shown on the Map are approximate only. UUWL strongly recommends that a comprehensive survey is undertaken in addition to reviewing this Map to determine and ensure the precise location of any UUWL apparatus. The exact location, positions and depths should be obtained by excavation trial holes.
- The location and position of private drains, private sewers and service pipes to properties are not normally shown on this Map but their presence must be anticipated and accounted for and you are strongly advised to carry out your own further enquiries and investigations in order to locate the same.
- The position and depth of UUWL apparatus is subject to change and therefore this Map is issued subject to any removal or change in location of the same. The onus is entirely upon you to confirm whether any changes to the Map have been made subsequent to issue and prior to any works being carried out.
- This Map and any information shown on it or provided with it must not be relied upon in the event of any development, construction or other works (including but not limited to any excavations) in the vicinity of UUWL apparatus or for the purpose of determining the suitability of a point of connection to the sewerage or other distribution systems.
- No person or legal entity, including any company shall be relieved from any liability howsoever and whensoever arising for any damage caused to UUWL apparatus by reason of the actual position and/or depths of UUWL apparatus being different from those shown on the Map and any information supplied with it.
- If any provision contained herein is or becomes legally invalid or unenforceable, it will be taken to be severed from the remaining provisions which shall be unaffected and continue in full force and affect.
- This agreement shall be governed by English law and all parties submit to the exclusive jurisdiction of the English courts, save that nothing will prevent UUWL from bringing proceedings in any other competent jurisdiction, whether concurrently or otherwise.

Wastewater Symbolology

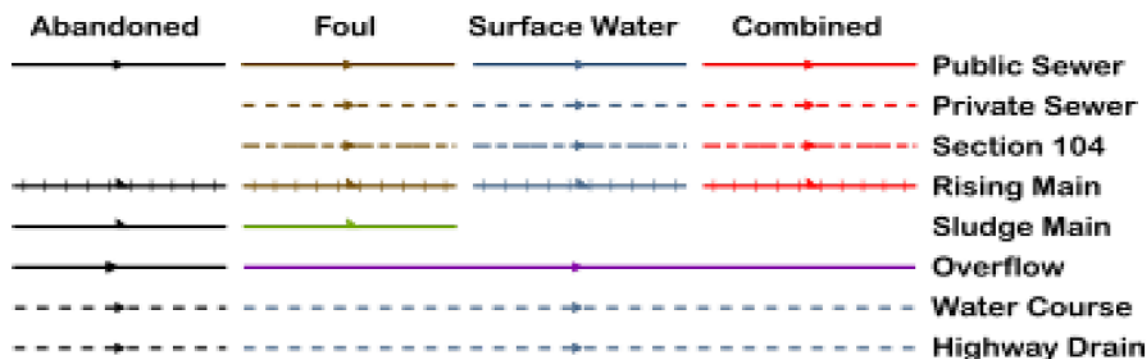

All point assets follow the standard colour convention: **red** – combined **brown** - foul
blue – surface water **purple** - overflow

Manhole	Side Entry Manhole
Head of System	Outfall
Extent of Survey	Screen Chamber
Rodding Eye	Inspection Chamber
Inlet	Bifurcation Chamber
Discharge Point	Lamp Hole
Vortex	T Junction / Saddle
Penstock	Catchpit
Washout Chamber	Valve Chamber
Valve	Vent Column
Air Valve	Vortex Chamber
Non Return Valve	Penstock Chamber
Soakaway	Network Storage Tank
Gully	Sewer Overflow
Cascade	Ww Treatment Works
Flow Meter	Ww Pumping Station
Hatch Box	Septic Tank
Oil Interceptor	Control Kiosk
Summit	
Drop Shaft	Change of Characteristic
Orifice Plate	

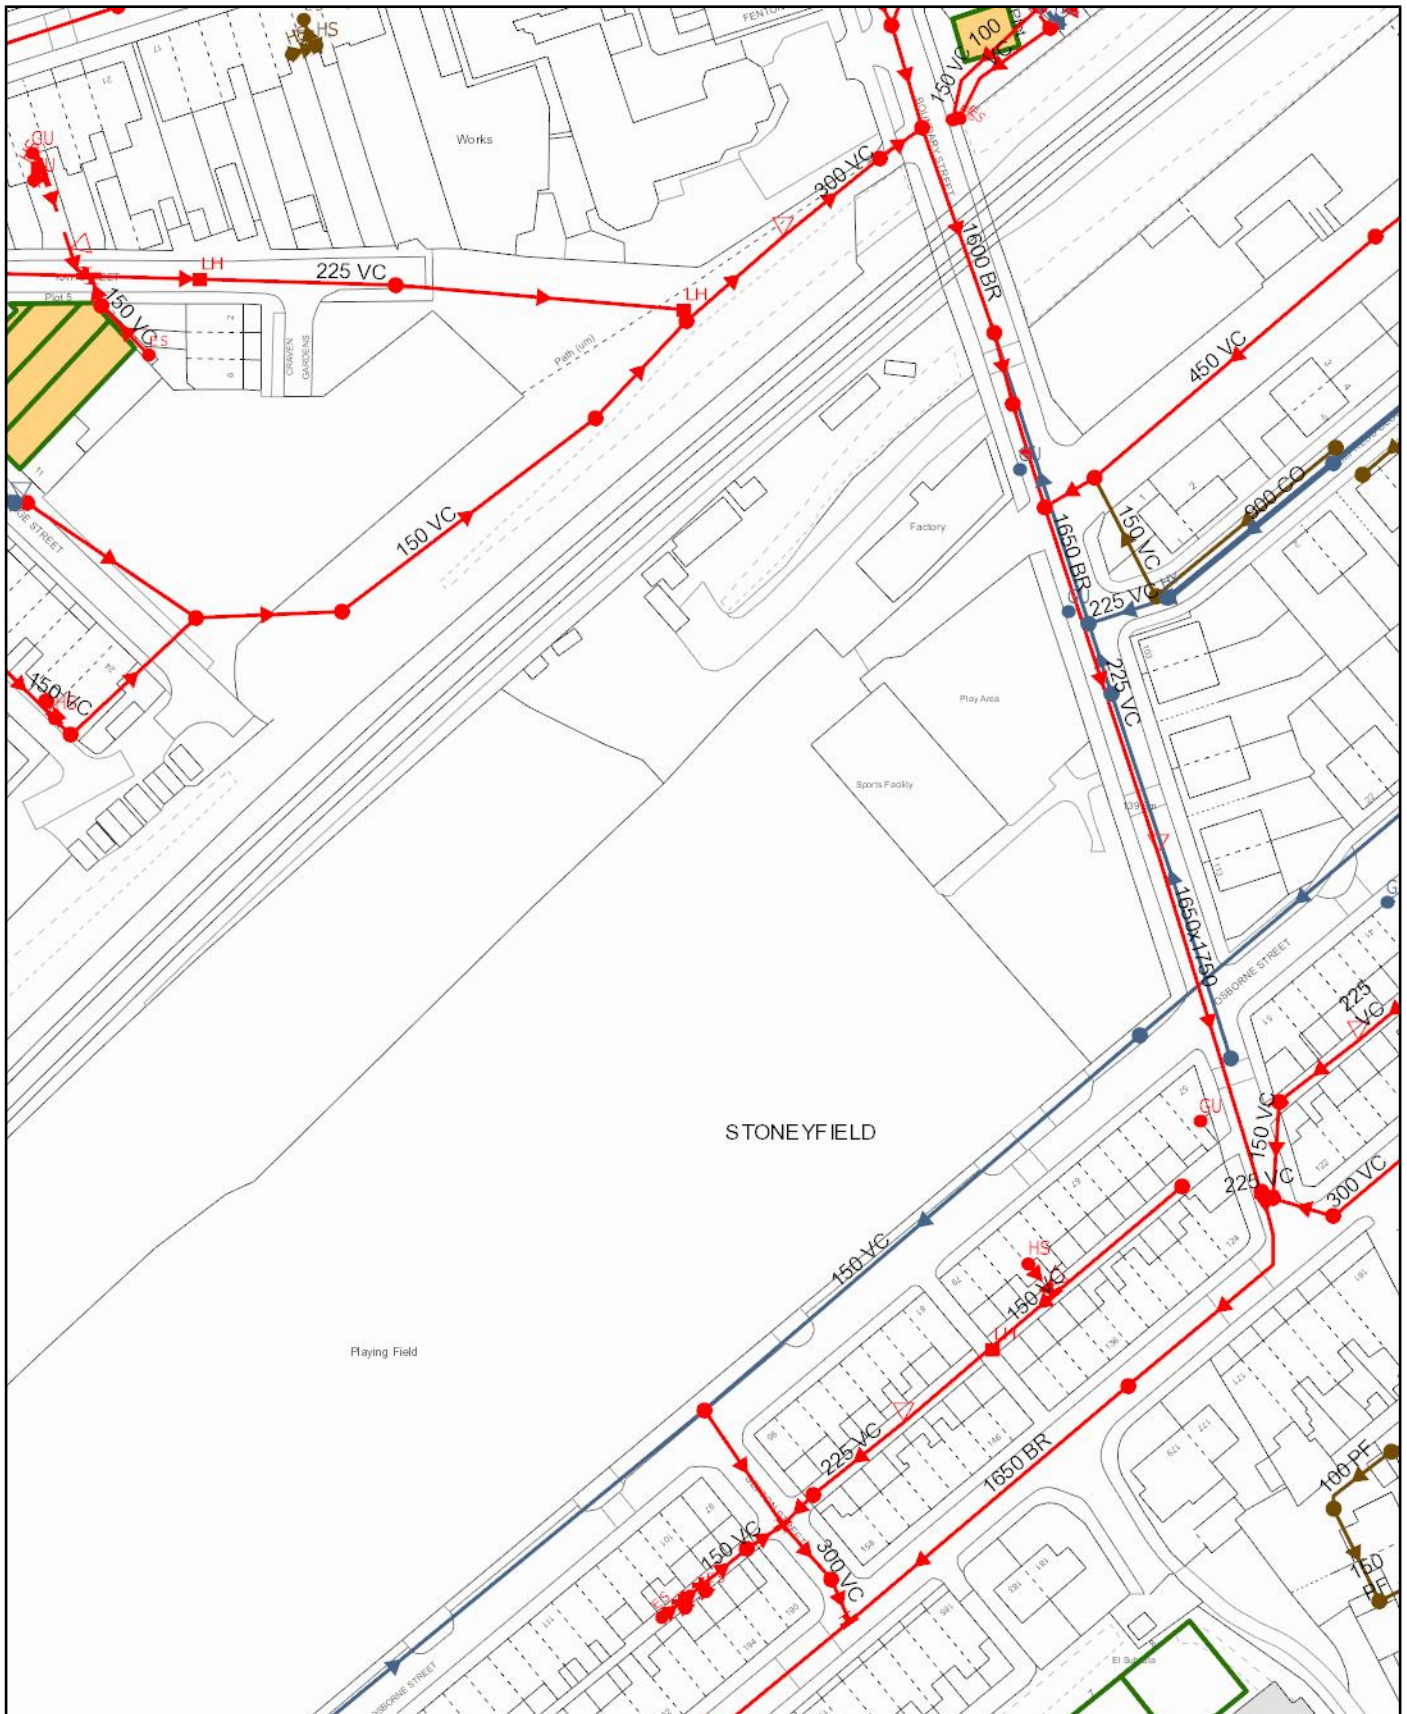

Scale: 1:1250
Date: 24/01/2024

SEWER RECORDS



Address or Site Reference: Stoneyfield
Printed by: Property Searches


The position of the underground apparatus shown on this plan is approximate only and is given in accordance with the best information currently available. United Utilities Water will not accept liability for any loss or damage caused by the actual position being different from those shown.

Crown copyright and database rights 2023 Ordnance Survey 100022432. Unauthorised reproduction will infringe these copyrights.

Clean Water Symbolology

Proposed	Abandoned	Live	
			Distribution Main
			Trunk Main
			Comms Pipe
			Private Pipe
			Concessionary Service
			Raw Water
			LDTM Raw Water
			LDTM Treated Water
			Air Valve
			AC Valve, open
			AC Valve, closed
			CC Valve, open
			CC Valve, closed
			Non Return Valve
			Pressure Management Valve
			OMS Valve
			Stop Tap
			Flow Meter
			Domestic Meter
			Commercial Meter
			Pump
			Hydrant
			Fire Hydrant
			Anode
			Chlorination Point
			De-chlorination Point
			Strainer Point
			Access Point
			Hatch Box
			IP Point
			Sampling Station
			Logger Box
			Bore Hole
			Inlet Point
			Bulk Supply Point
			End Cap
			Site Termination
			Change of Characteristic
			Condition Report
			<u>Property Types</u>
			Water Tower
			Valve House
			Booster Pumping Station
			Intake Pumping Station
			Water Treatment Works
			Supply Reservoir
			Service Reservoir
			Impounding Reservoir
			Pipe Bridge

Symbology for proposed assets is the same as above, but shown in **green**
 Symbology for abandoned assets is the same as above, but shown in **black**

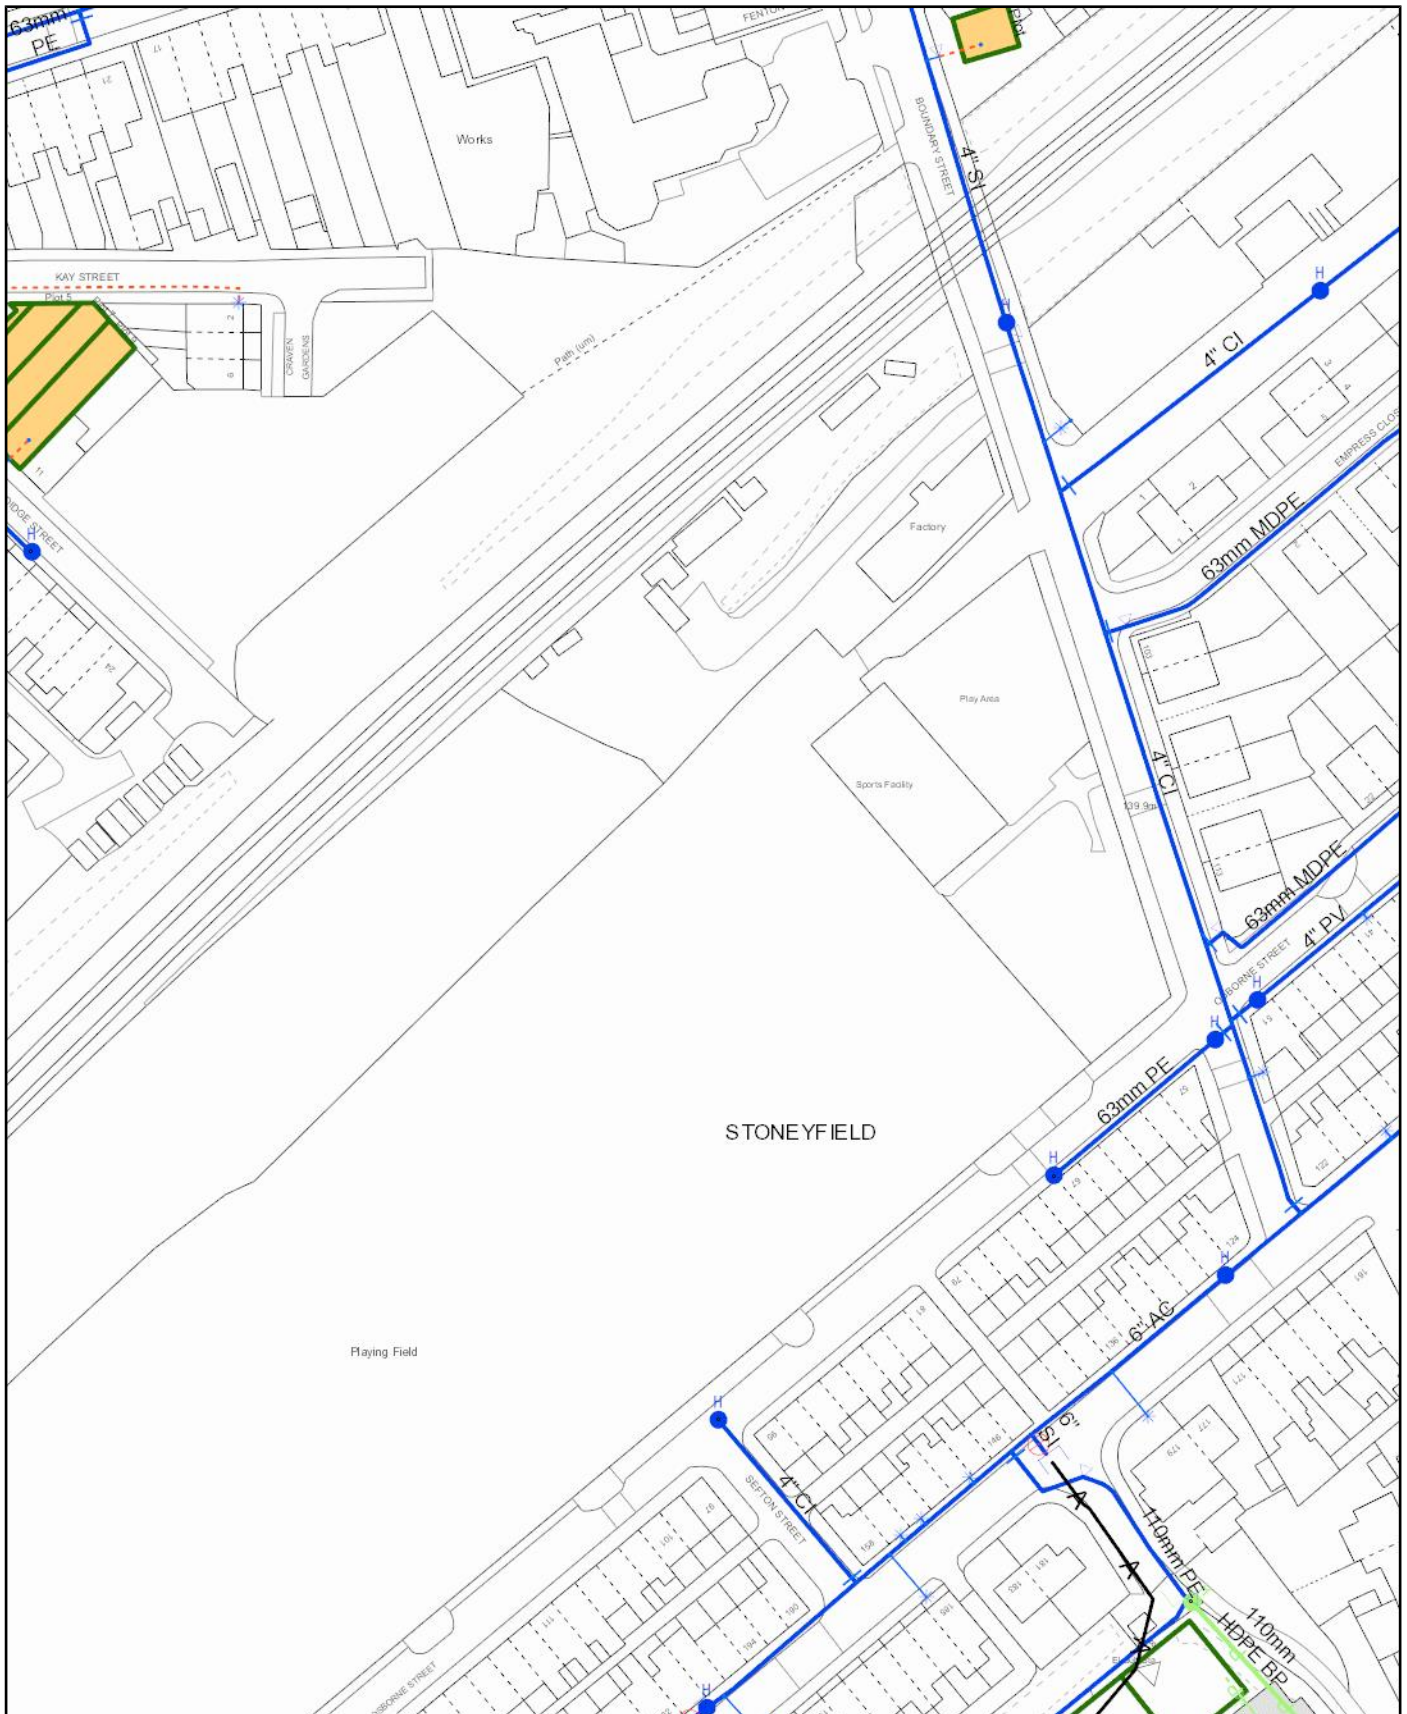

Scale: 1:1250
Date: 24/01/2024


WATER MAINS RECORDS




Address or Site Reference: Stoneyfield
Printed by: Property Searches

The position of the underground apparatus shown on this plan is approximate only and is given in accordance with the best information currently available. United Utilities Water will not accept liability for any loss or damage caused by the actual position being different from those shown.

Crown copyright and database rights 2023 Ordnance Survey 100022432. Unauthorised reproduction will infringe these copyrights.

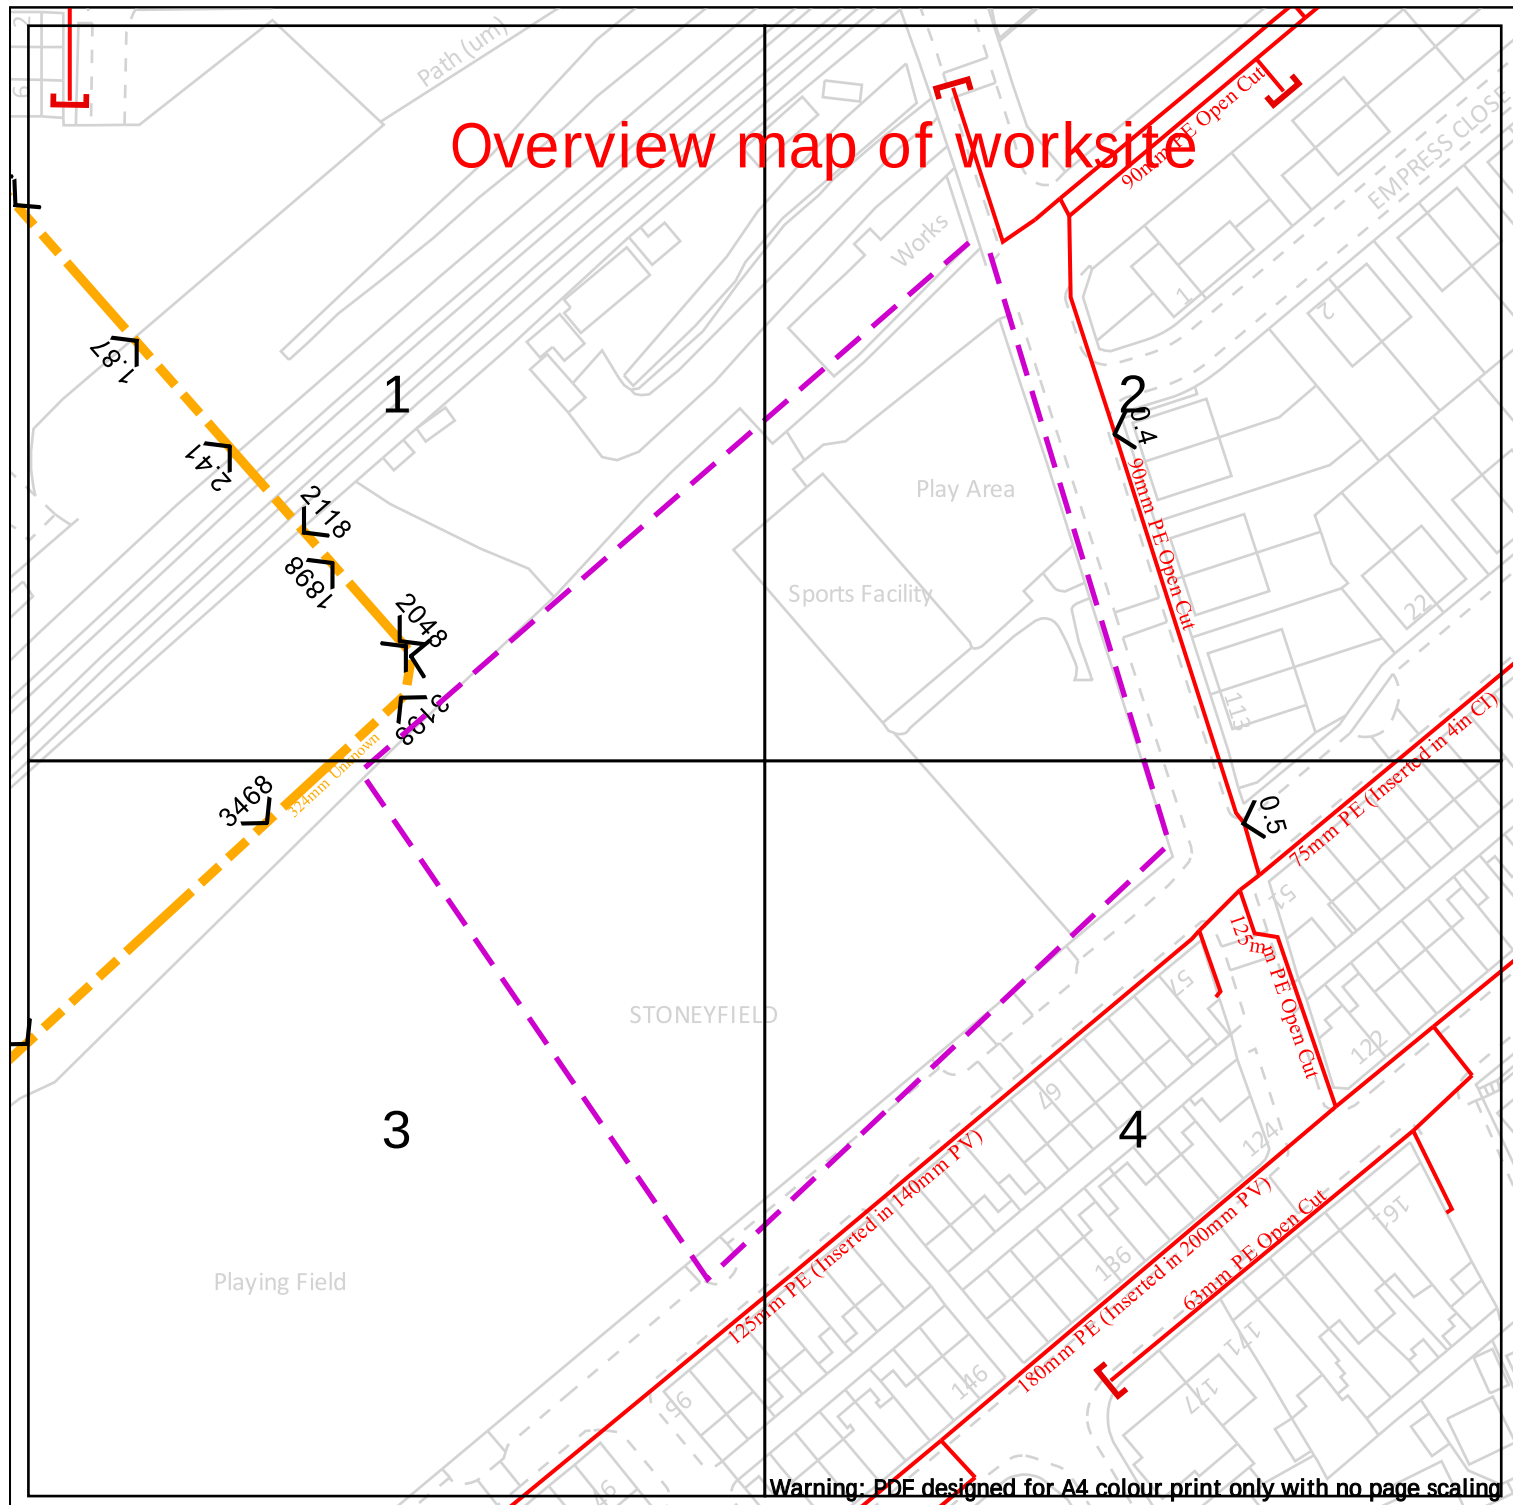

WARNING! This area contains Gas Mains Operating at High Pressure (in excess of 7 bar) and/or Intermediate Pressure (between 2 and 7 bar). Before excavating in the area contact the Plant Protection team on 0800 688 588 or plantprotection@cadentgas.com

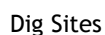

— — — — —



A perpendicular service/connection is laid in a straight line from the entry point at the property to the connection at the main – this includes a pipe that has a perpendicular connection and is not straight but does not deviate more than 1m off centre line.

IMPORTANT NOTICES


This plan shows these pipes owned by Cadent Gas Limited in its role as a Licensed Gas Transporter (GT). Gas pipes owned by other GT's or otherwise privately owned may be present in this area. Information with regards to such pipes should be obtained from the relevant owners. The information shown on this plan is given without warranty, the accuracy thereof cannot be guaranteed. Service pipes, valves, syphons, stub connections etc. are not shown but their presence should be anticipated. No liability of any kind whatsoever is accepted by Cadent Gas Limited or their agents, servants or contractors for any errors or omission. Safe digging practices, in accordance with HSG47, must be used to verify and establish the actual position of mains, pipes, services and other apparatus on site before any mechanical plant is used. It is your responsibility to ensure that this information is provided to all persons (either direct labour or contractors) working for you on or near gas apparatus. The information included on this plan should not be referred to beyond a period of 28 days from the date of issue.

View extent: 100m, 100m

Scale: 1:1025 (When plotted at A4)

Crown Copyright © - This plan is reproduced from or based on the OS map by Cadent Gas Limited, with the sanction of the controller of HM Stationary Office. Crown Copyright Reserved. Ordnance Survey Licence number 100024886

In case of emergency call - 0800 111 999

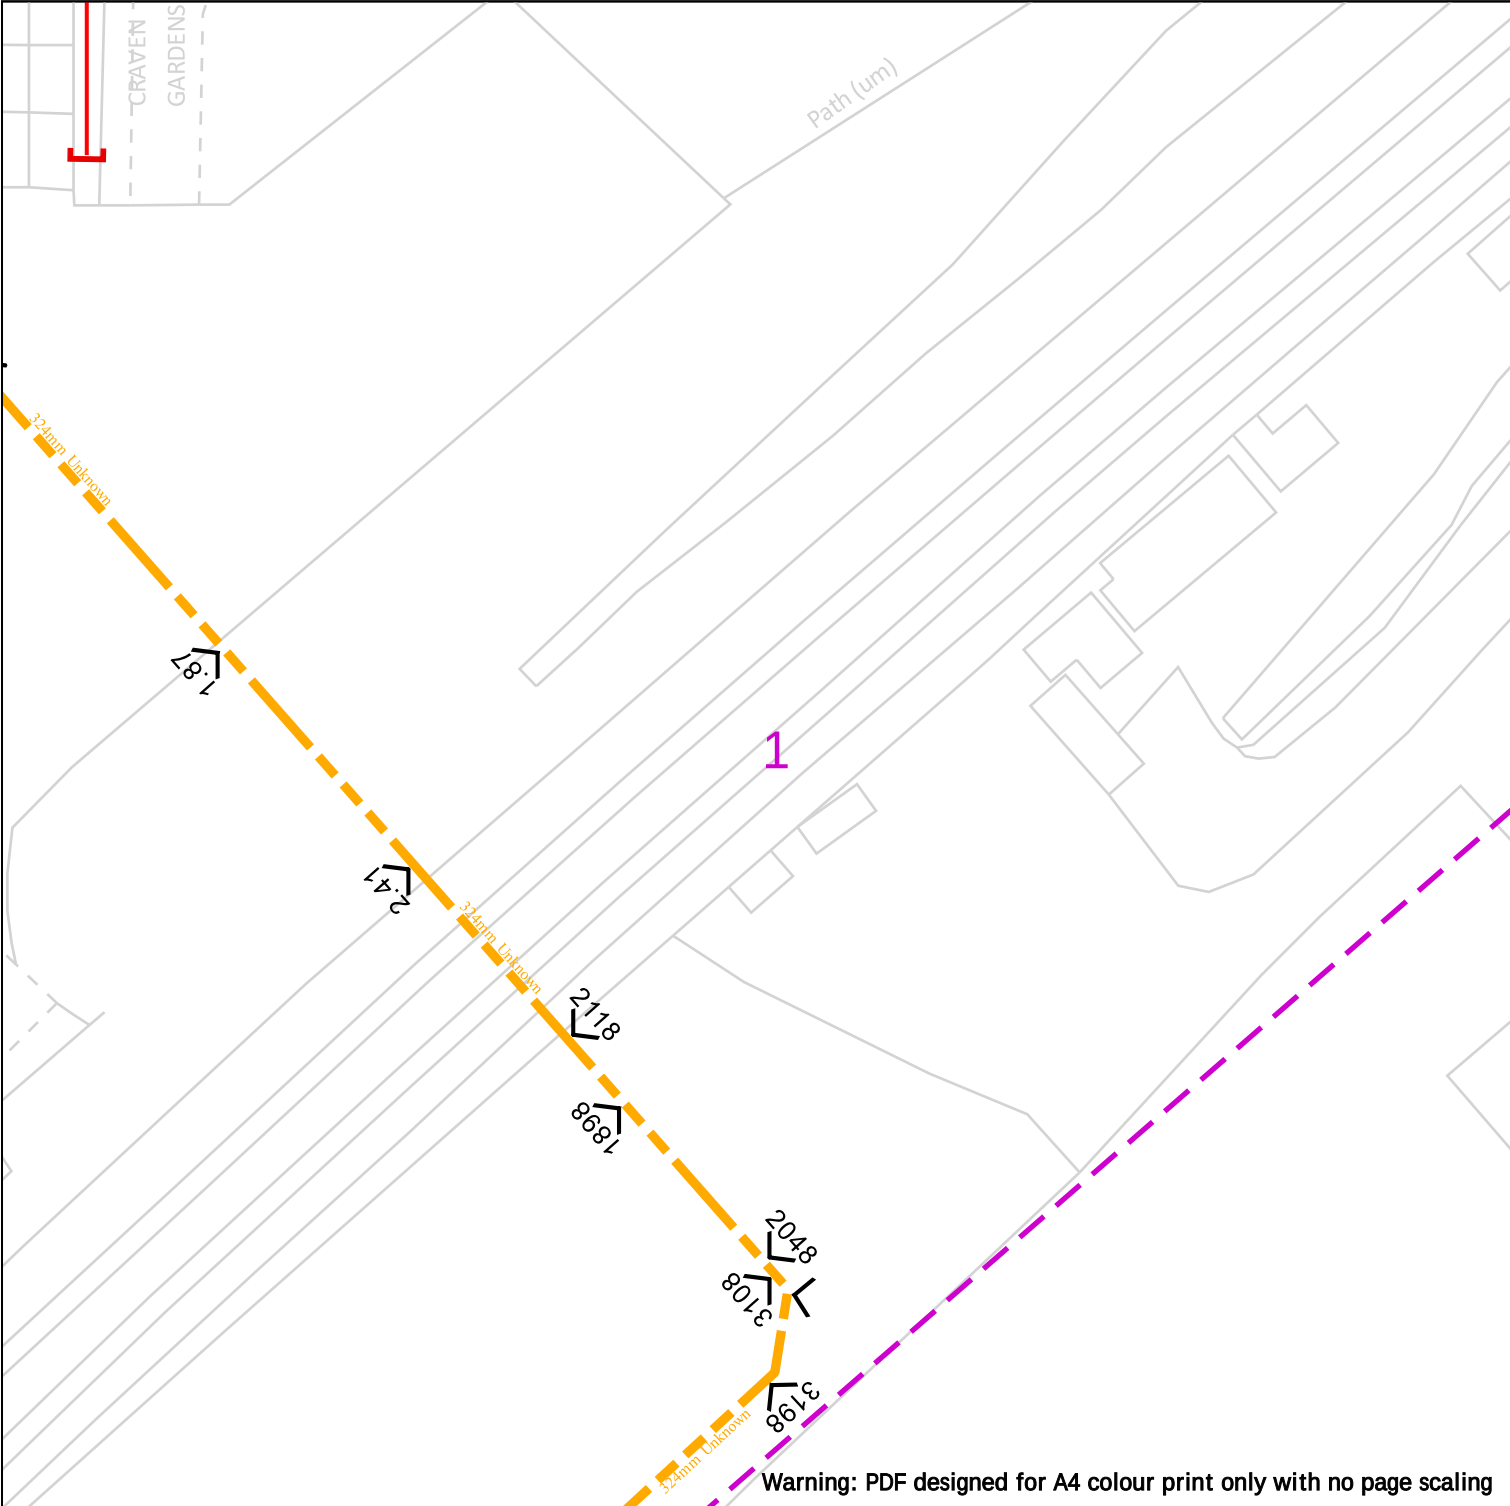

WARNING! This area contains Gas Mains Operating at High Pressure (in excess of 7 bar) and/or Intermediate Pressure (between 2 and 7 bar). Before excavating in the area contact the Plant Protection team on 0800 688 588 or plantprotection@cadentgas.com



Date Requested: 23/01/2024
Job Reference: 32214546
Site Location: 389515 412131
Requested by: Miss Lauren Wenham
Your Scheme/Reference: STW6382

View extent: 100m, 100m

Scale: 1:500 (When plotted at A4)

Dig Sites

Area:

Line:

LP Mains

MP Mains

IP Mains

LHP Mains

Valve

Depth of cover

Syphon

Diameter Change

Material Change

Out of Standard Service

IMPORTANT NOTICES

This plan shows these pipes owned by Cadent Gas Limited in its role as a Licensed Gas Transporter (GT). Gas pipes owned by other GT's or otherwise privately owned may be present in this area. Information with regards to such pipes should be obtained from the relevant owners. The information shown on this plan is given without warranty, the accuracy thereof cannot be guaranteed. Service pipes, valves, syphons, stub connections etc. are not shown but their presence should be anticipated. No liability of any kind whatsoever is accepted by Cadent Gas Limited or their agents, servants or contractors for any errors or omission. Safe digging practices, in accordance with HS(G)47, must be used to verify and establish the actual position of mains, pipes, services and other apparatus on site before any mechanical plant is used. It is your responsibility to ensure that this information is provided to all persons (either direct labour or contractors) working for you on or near gas apparatus. The information included on this plan should not be referred to beyond a period of 28 days from the date of issue.

In case of emergency call - 0800 111 999


Crown Copyright © - This plan is reproduced from or based on the OS map by Cadent Gas Limited, with the sanction of the controller of HM Stationary Office. Crown Copyright Reserved. Ordnance Survey Licence number 100024886

Where an out-of-standard service is present please contact plant protection 0800 688 588 for further information.

Out-of-standard service symbology may be used to indicate one or more of the following:

- Identification of shallow services
- Identification of dual services
- Recording of non-perpendicular services

A perpendicular service/connection is laid in a straight line from the entry point at the property to the connection at the main – this includes a pipe that has a perpendicular connection and is not straight but does not deviate more than 1m off centre line.

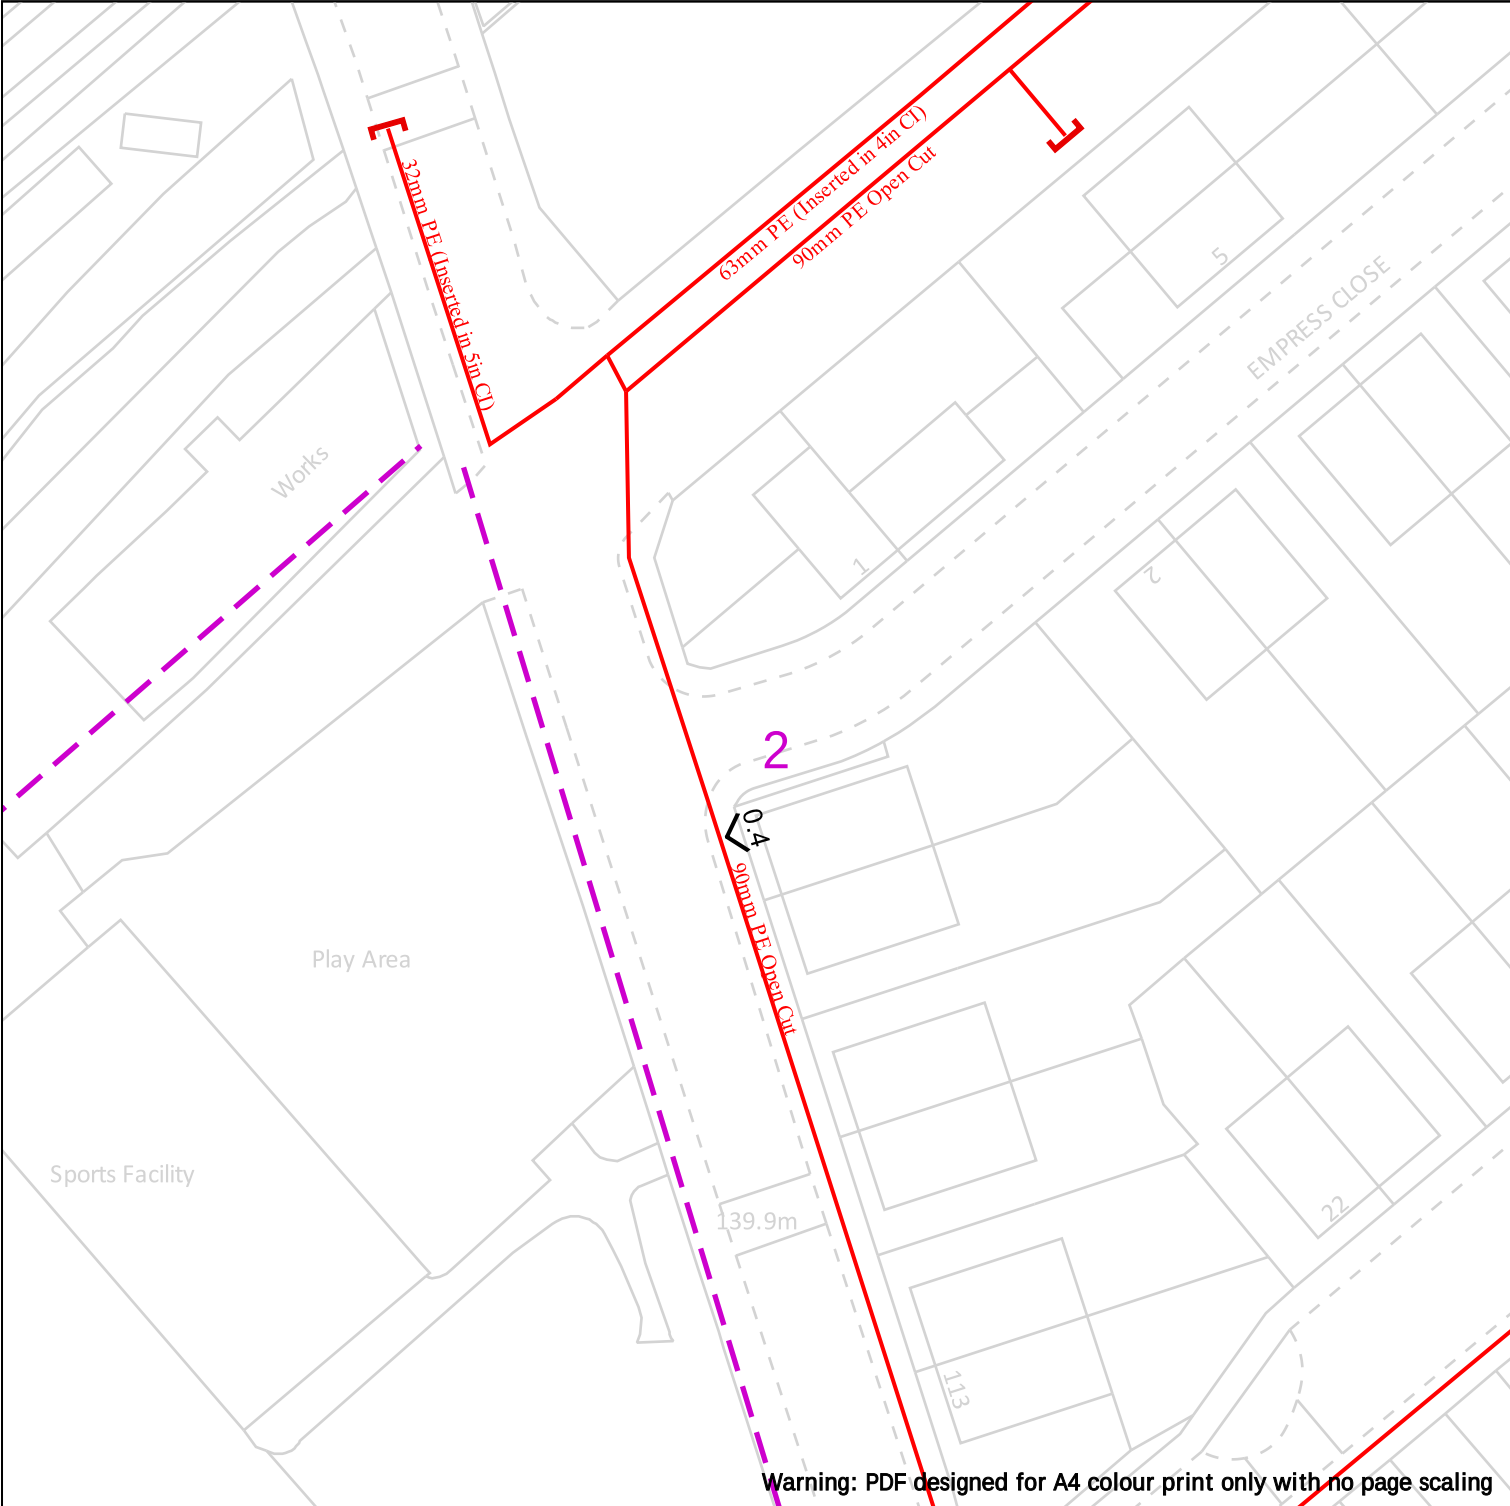

Warning: PDF designed for A4 colour print only with no page scaling

WARNING! This area contains Gas Mains Operating at High Pressure (in excess of 7 bar) and/or Intermediate Pressure (between 2 and 7 bar). Before excavating in the area contact the Plant Protection team on 0800 688 588 or plantprotection@cadentgas.com



Date Requested: 23/01/2024
Job Reference: 32214546
Site Location: 389515 412131
Requested by: Miss Lauren Wenham
Your Scheme/Reference: STW6382

View extent: 100m, 100m

Scale: 1:500 (When plotted at A4)

Dig Sites	Area:	Line:	
	LP Mains		
	MP Mains		
	IP Mains		
	LHP Mains		

Where an out-of-standard service is present please contact plant protection 0800 688 588 for further information.

Out-of-standard service symbology may be used to indicate one or more of the following:


- Identification of shallow services
- Identification of dual services
- Recording of non-perpendicular services

A perpendicular service/connection is laid in a straight line from the entry point at the property to the connection at the main – this includes a pipe that has a perpendicular connection and is not straight but does not deviate more than 1m off centre line.

IMPORTANT NOTICES

This plan shows these pipes owned by Cadent Gas Limited in its role as a Licensed Gas Transporter (GT). Gas pipes owned by other GT's or otherwise privately owned may be present in this area. Information with regards to such pipes should be obtained from the relevant owners. The information shown on this plan is given without warranty, the accuracy thereof cannot be guaranteed. Service pipes, valves, syphons, stub connections etc. are not shown but their presence should be anticipated. No liability of any kind whatsoever is accepted by Cadent Gas Limited or their agents, servants or contractors for any errors or omission. Safe digging practices, in accordance with HS(G)47, must be used to verify and establish the actual position of mains, pipes, services and other apparatus on site before any mechanical plant is used. It is your responsibility to ensure that this information is provided to all persons (either direct labour or contractors) working for you on or near gas apparatus. The information included on this plan should not be referred to beyond a period of 28 days from the date of issue.

In case of emergency call - 0800 111 999

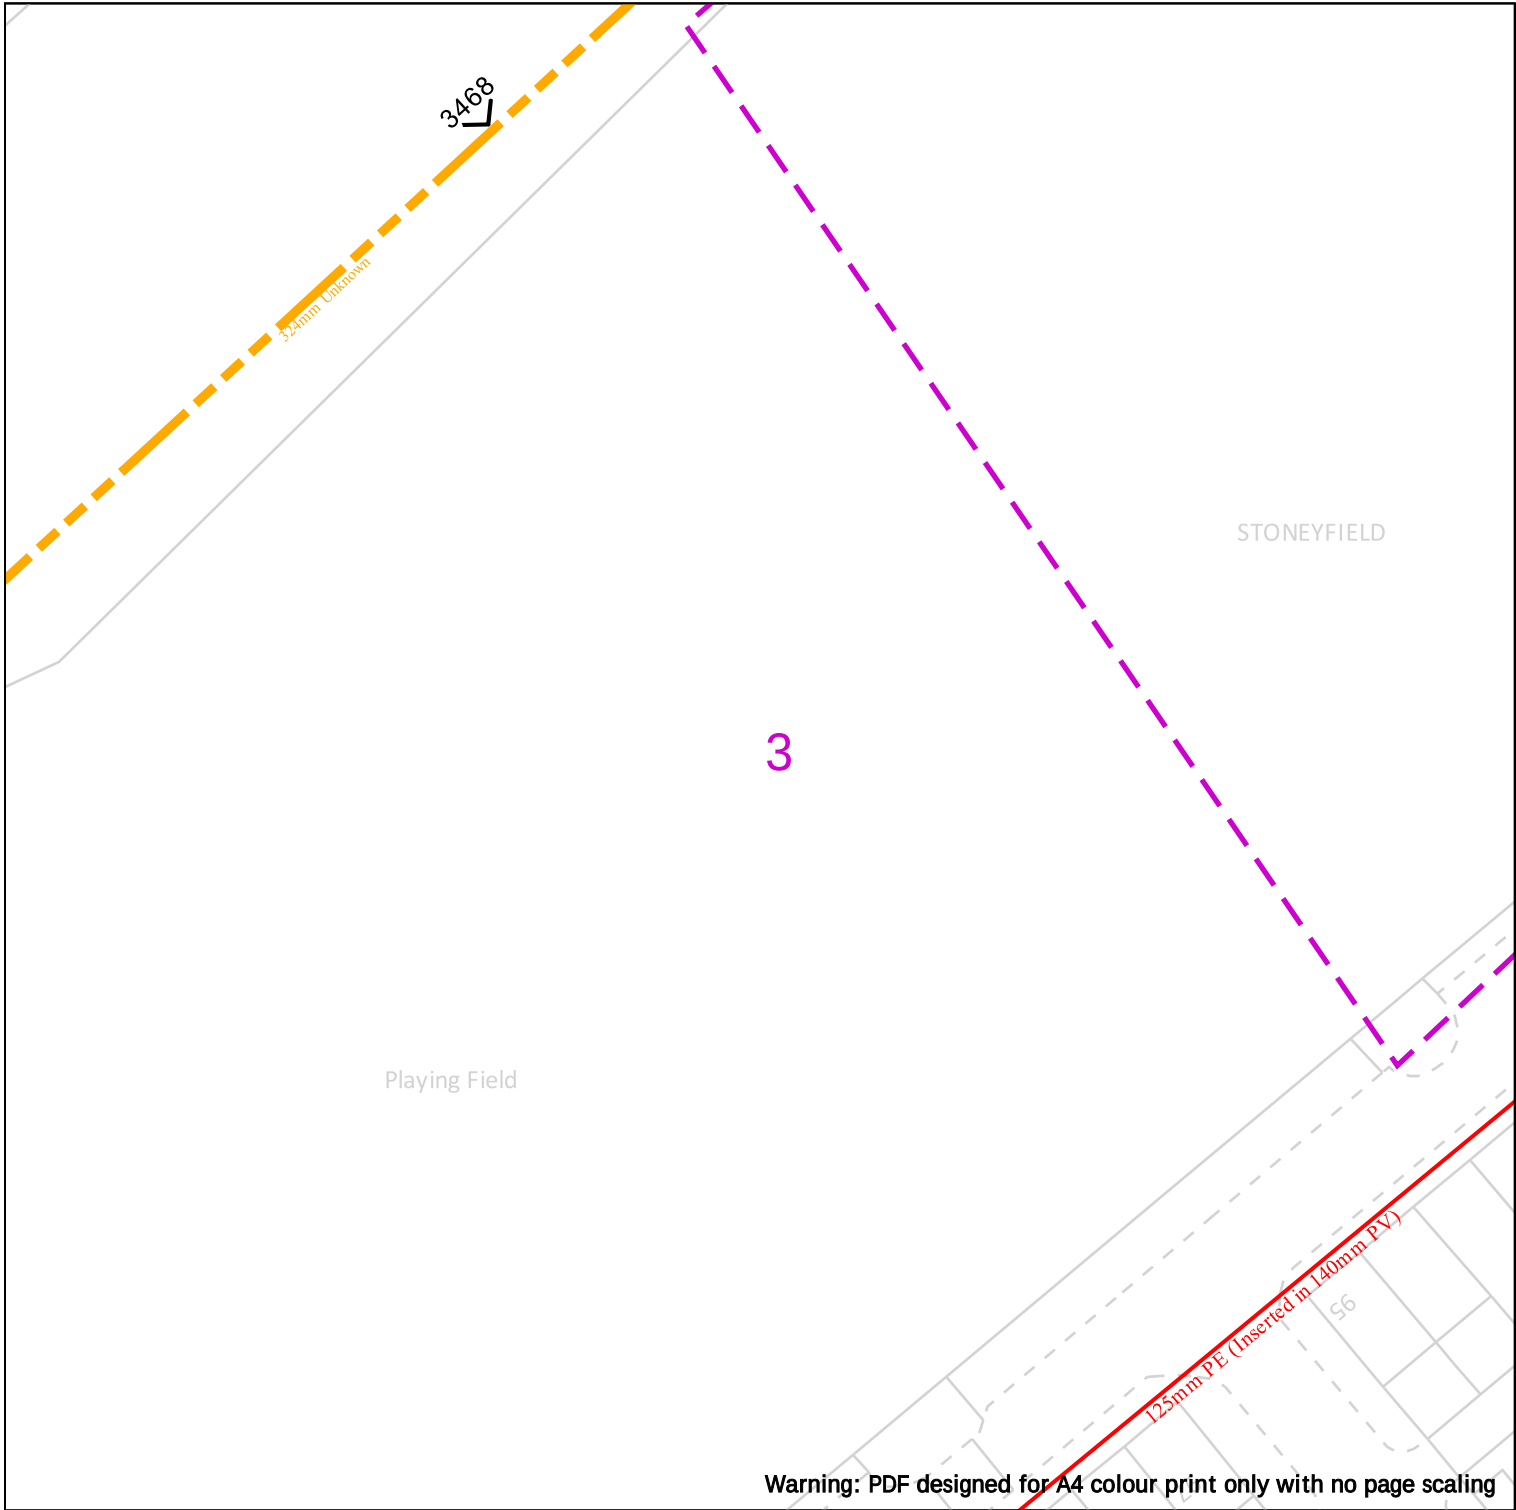

WARNING! This area contains Gas Mains Operating at High Pressure (in excess of 7 bar) and/or Intermediate Pressure (between 2 and 7 bar). Before excavating in the area contact the Plant Protection team on 0800 688 588 or plantprotection@cadentgas.com



Date Requested: 23/01/2024
Job Reference: 32214546
Site Location: 389515 412131
Requested by: Miss Lauren Wenham
Your Scheme/Reference: STW6382

View extent: 100m, 100m

Scale: 1:500 (When plotted at A4)

25m

Dig Sites

LP Mains

MP Mains

IP Mains

LHP Mains

Area:

Line:

Valve

Depth of cover

Syphon

Diameter Change

Material Change

Out of Standard Service

Where an out-of-standard service is present please contact plant protection 0800 688 588 for further information.

Out-of-standard service symbology may be used to indicate one or more of the following:

- Identification of shallow services
- Identification of dual services
- Recording of non-perpendicular services


A perpendicular service/connection is laid in a straight line from the entry point at the property to the connection at the main – this includes a pipe that has a perpendicular connection and is not straight but does not deviate more than 1m off centre line.

IMPORTANT NOTICES

This plan shows these pipes owned by Cadent Gas Limited in its role as a Licensed Gas Transporter (GT). Gas pipes owned by other GT's or otherwise privately owned may be present in this area. Information with regards to such pipes should be obtained from the relevant owners. The information shown on this plan is given without warranty, the accuracy thereof cannot be guaranteed. Service pipes, valves, syphons, stub connections etc. are not shown but their presence should be anticipated. No liability of any kind whatsoever is accepted by Cadent Gas Limited or their agents, servants or contractors for any errors or omission. Safe digging practices, in accordance with HS(G)47, must be used to verify and establish the actual position of mains, pipes, services and other apparatus on site before any mechanical plant is used. It is your responsibility to ensure that this information is provided to all persons (either direct labour or contractors) working for you on or near gas apparatus. The information included on this plan should not be referred to beyond a period of 28 days from the date of issue.

In case of emergency call - 0800 111 999

Crown Copyright © - This plan is reproduced from or based on the OS map by Cadent Gas Limited, with the sanction of the controller of HM Stationary Office. Crown Copyright Reserved. Ordnance Survey Licence number 100024886

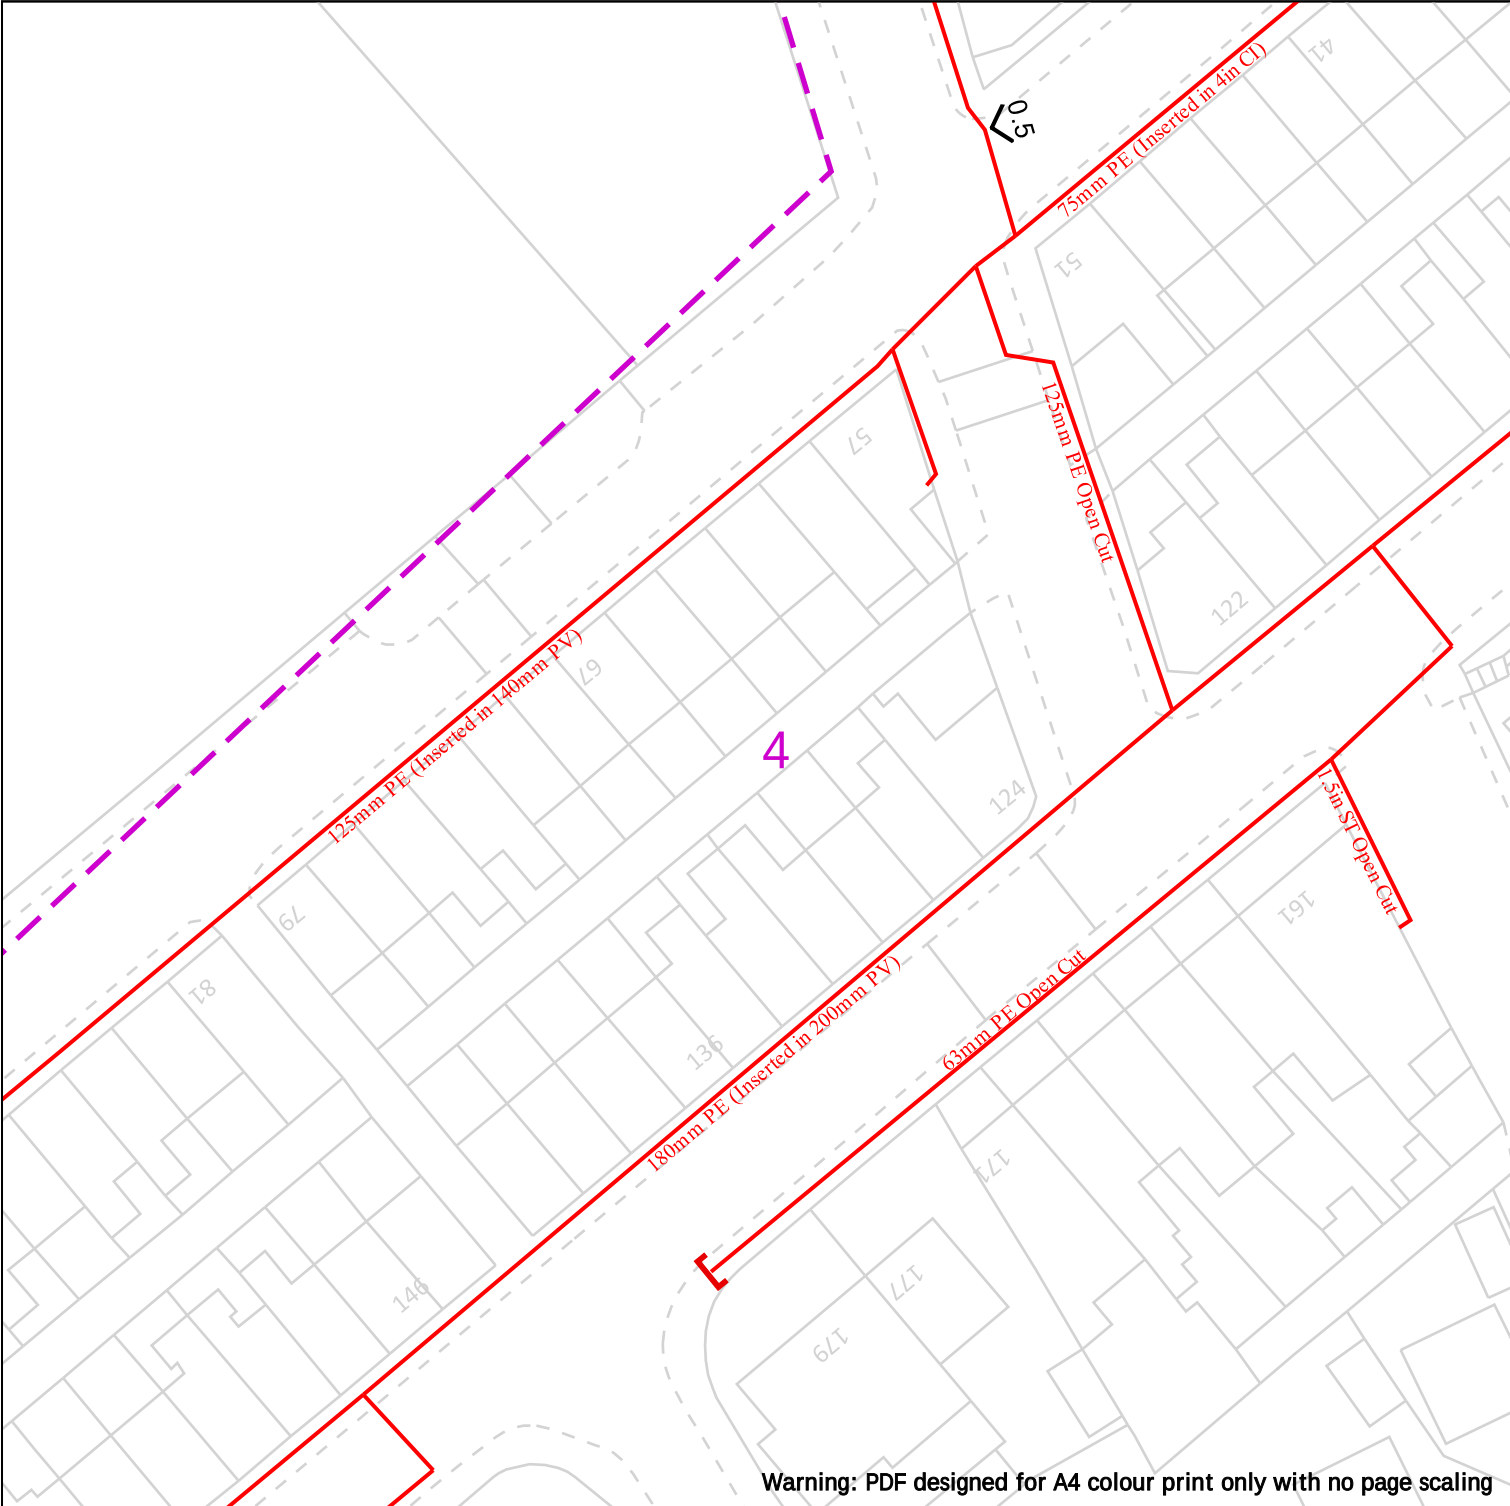

Warning: PDF designed for A4 colour print only with no page scaling

WARNING! This area contains Gas Mains Operating at High Pressure (in excess of 7 bar) and/or Intermediate Pressure (between 2 and 7 bar). Before excavating in the area contact the Plant Protection team on 0800 688 588 or plantprotection@cadentgas.com



Date Requested: 23/01/2024
Job Reference: 32214546
Site Location: 389515 412131
Requested by: Miss Lauren Wenham
Your Scheme/Reference: STW6382

View extent: 100m, 100m

Scale: 1:500 (When plotted at A4)

Dig Sites

Area:

Line:

LP Mains

MP Mains

IP Mains

LHP Mains

Valve

Depth of cover

Syphon

Diameter Change

Material Change

Out of Standard Service

Where an out-of-standard service is present please contact plant protection 0800 688 588 for further information.

Out-of-standard service symbology may be used to indicate one or more of the following:

- Identification of shallow services
- Identification of dual services
- Recording of non-perpendicular services


A perpendicular service/connection is laid in a straight line from the entry point at the property to the connection at the main – this includes a pipe that has a perpendicular connection and is not straight but does not deviate more than 1m off centre line.

IMPORTANT NOTICES

This plan shows these pipes owned by Cadent Gas Limited in its role as a Licensed Gas Transporter (GT). Gas pipes owned by other GT's or otherwise privately owned may be present in this area. Information with regards to such pipes should be obtained from the relevant owners. The information shown on this plan is given without warranty, the accuracy thereof cannot be guaranteed. Service pipes, valves, syphons, stub connections etc. are not shown but their presence should be anticipated. No liability of any kind whatsoever is accepted by Cadent Gas Limited or their agents, servants or contractors for any errors or omission. Safe digging practices, in accordance with HS(G)47, must be used to verify and establish the actual position of mains, pipes, services and other apparatus on site before any mechanical plant is used. It is your responsibility to ensure that this information is provided to all persons (either direct labour or contractors) working for you on or near gas apparatus. The information included on this plan should not be referred to beyond a period of 28 days from the date of issue.


In case of emergency call - 0800 111 999

Crown Copyright © - This plan is reproduced from or based on the OS map by Cadent Gas Limited, with the sanction of the controller of HM Stationary Office. Crown Copyright Reserved. Ordnance Survey Licence number 100024886

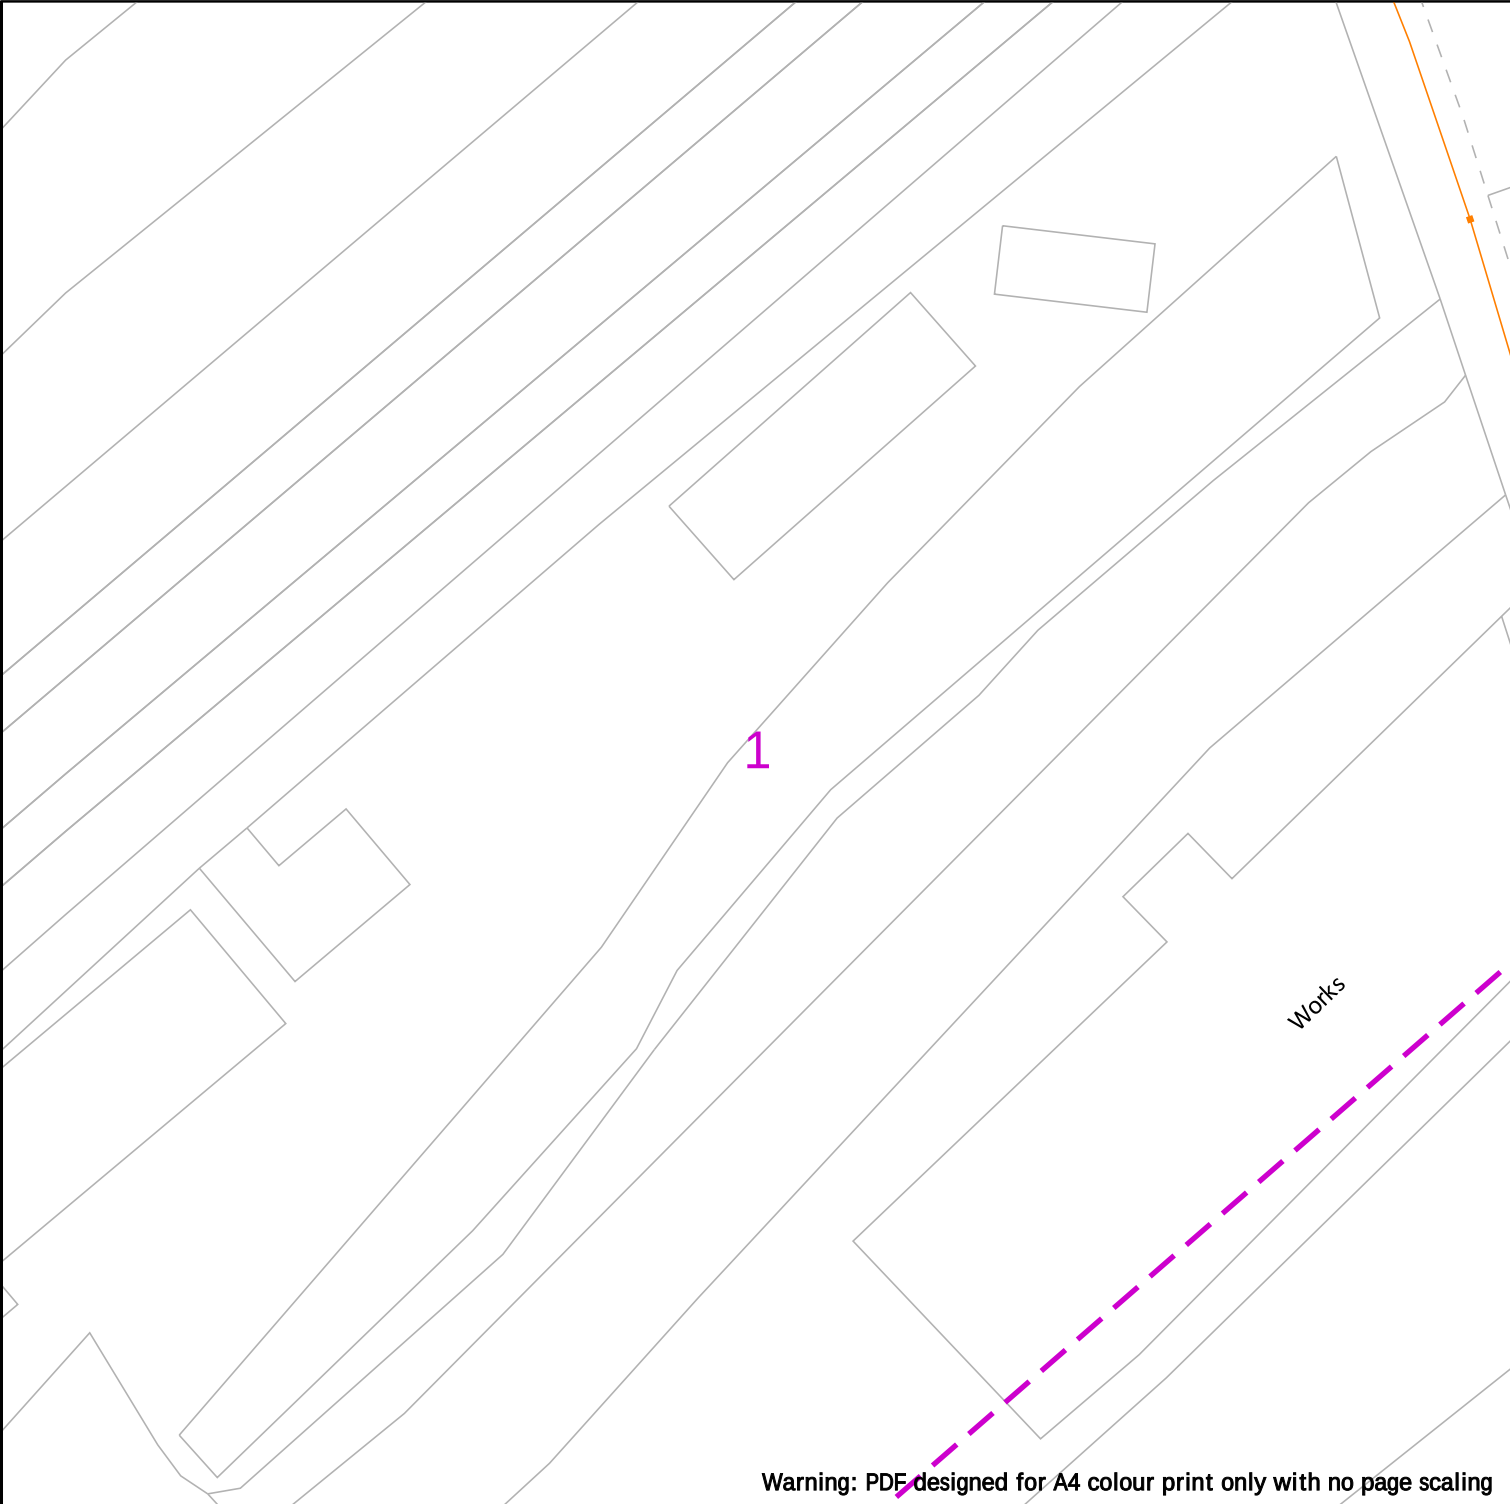

Warning: PDF designed for A4 colour print only with no page scaling

	Operating Voltage	Colour Code	Line Colour	In an emergency call 105, 24 hours a day	Dig Sites
	132kV	Black			Line: 
	33kV	Green			Area: 
	22kV-25kV	Yellow			
	11kV	Red			
	6kV-6.6kV	Blue			
	1kV-6kV	Violet			
	LV	Orange			
Date Requested: 23/01/2024	Unknown Voltage	Brown			
Job Reference: 32214546	IMPORTANT INFO				
Site Location: 389515 412131	Unless otherwise indicated the depth of Electricity North West Limited cables are in accordance with NJUG (450mm for Low Voltage & 600mm for 11kV cables) 33kV and 132kV cables are laid at depths as marked. The depth and positions of Electricity North West Limited equipment was accurate as shown when the equipment was installed. However third parties may have altered the level & other reference data. Therefore Electricity North West Limited accept no responsibility for the position of Electricity North West Limited equipment being different from shown. No person, body or company, shall be relieved from liability for damage caused to Electricity North West Limited equipment by reason of being located differently to the indications on this drawing or from any regulatory loss of income or incentive, or expense, which may be suffered by Electricity North West Limited and which is caused or contributed to by any loss of supply as a result of any damage caused to Electricity North West Limited's equipment. Service cables are not necessarily shown but must be assumed to exist to all premises, streetlights and signs. There may be other Electricity North West Limited apparatus in the vicinity which is not indicated on the cable records. Other apparatus may also be present which is owned by a third party other than Electricity North West Limited.				
Requested by: Miss Lauren Wenham	Reference should be made to HSE Guidance, HS(G)47 "Avoiding Danger from Underground Services" and GS6 "Avoidance of Danger from Overhead Power Lines".				
Your Scheme/Reference: STW6382	Electricity North West Limited 304 Bridgewater Place, Birchwood Park, Warrington WA3 6XG. Registered in England and Wales. Registered No 02366949				
Scale: 1:250 (When plotted at A4)	Reproduced from or based upon Ordnance Survey's map with the permission of Her Majesty's Stationary Office. Crown Copyright Reserved. LICENCE No. 100017892.				

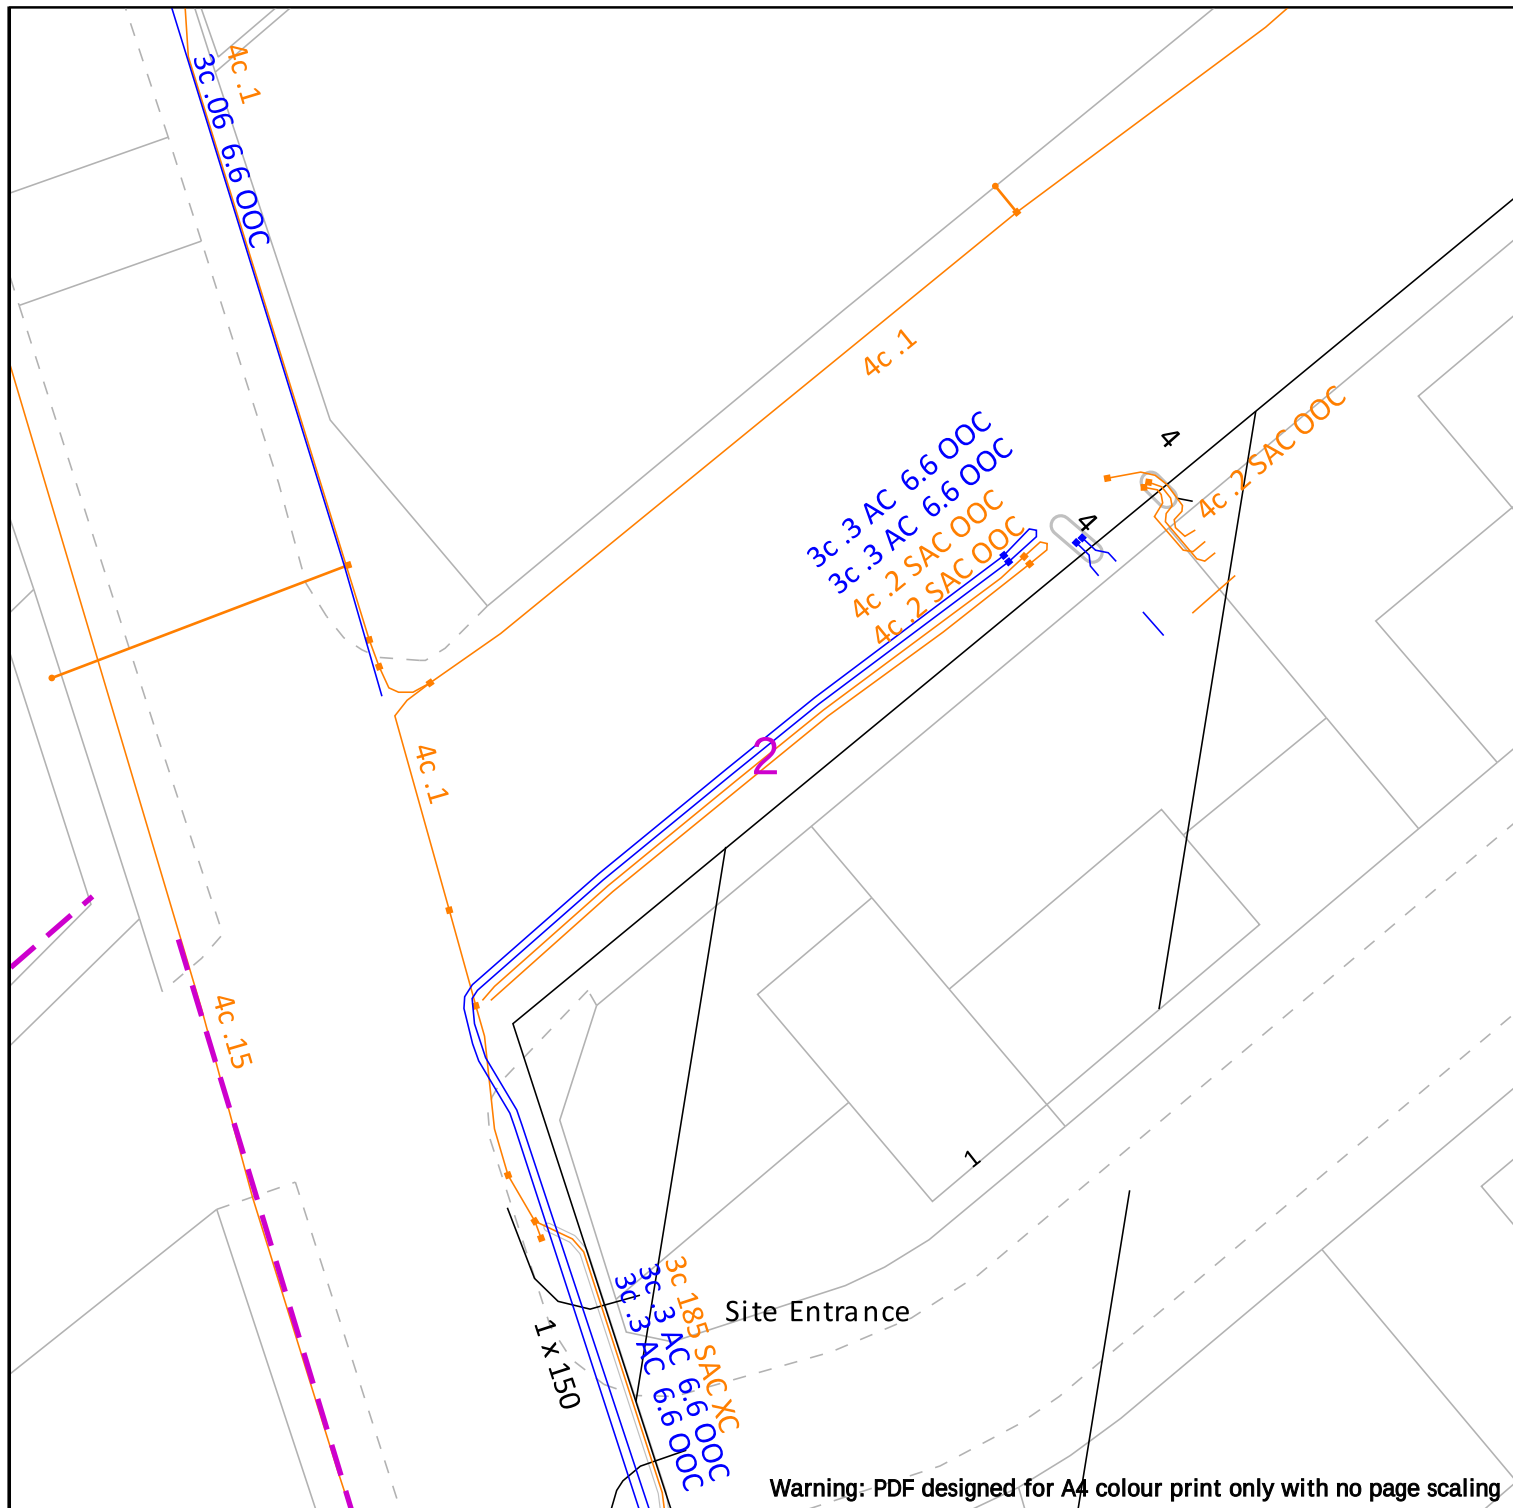

Data Management
Electricity North West
Linley House
Dickinson Street
Manchester, M1 4LF
Phone: 0800 195 4141
Email: planrequest@enwl.co.uk

Operating Voltage

132kV	Black
33kV	Green
22kV-25kV	Yellow
11kV	Red
6kV-6.6kV	Blue
1kV-6kV	Violet
LV	Orange
Unknown Voltage	Brown

Colour Code

Line Colour

In an emergency call 105,
24 hours a day

Dig Sites

Line: - - - -

Area: [] [] [] []


Date Requested: 23/01/2024
Job Reference: 32214546
Site Location: 389515 412131
Requested by: Miss Lauren Wenham
Your Scheme/Reference: STW6382

IMPORTANT INFO

Unless otherwise indicated the depth of Electricity North West Limited cables are in accordance with NJUG (450mm for Low Voltage & 600mm for 11kV cables) 33kV and 132kV cables are laid at depths as marked. The depth and positions of Electricity North West Limited equipment was accurate as shown when the equipment was installed. However third parties may have altered the level & other reference data. Therefore Electricity North West Limited accept no responsibility for the position of Electricity North West Limited equipment being different from shown. No person, body or company, shall be relieved from liability for damage caused to Electricity North West Limited equipment by reason of being located differently to the indications on this drawing or from any regulatory loss of income or incentive, or expense, which may be suffered by Electricity North West Limited and which is caused or contributed to by any loss of supply as a result of any damage caused to Electricity North West Limited's equipment. Service cables are not necessarily shown but must be assumed to exist to all premises, streetlights and signs. There may be other Electricity North West Limited apparatus in the vicinity which is not indicated on the cable records. Other apparatus may also be present which is owned by a third party other than Electricity North West Limited. Reference should be made to HSE Guidance, HS(G)47 "Avoiding Danger from Underground Services" and GS6 "Avoidance of Danger from Overhead Power Lines". Electricity North West Limited 304 Bridgewater Place, Birchwood Park, Warrington WA3 6XG. Registered in England and Wales. Registered No 02366949


Scale: 1:250 (When plotted at A4)

Reproduced from or based upon Ordnance Survey's map with the permission of Her Majesty's Stationary Office. Crown Copyright Reserved. LICENCE No. 100017892.

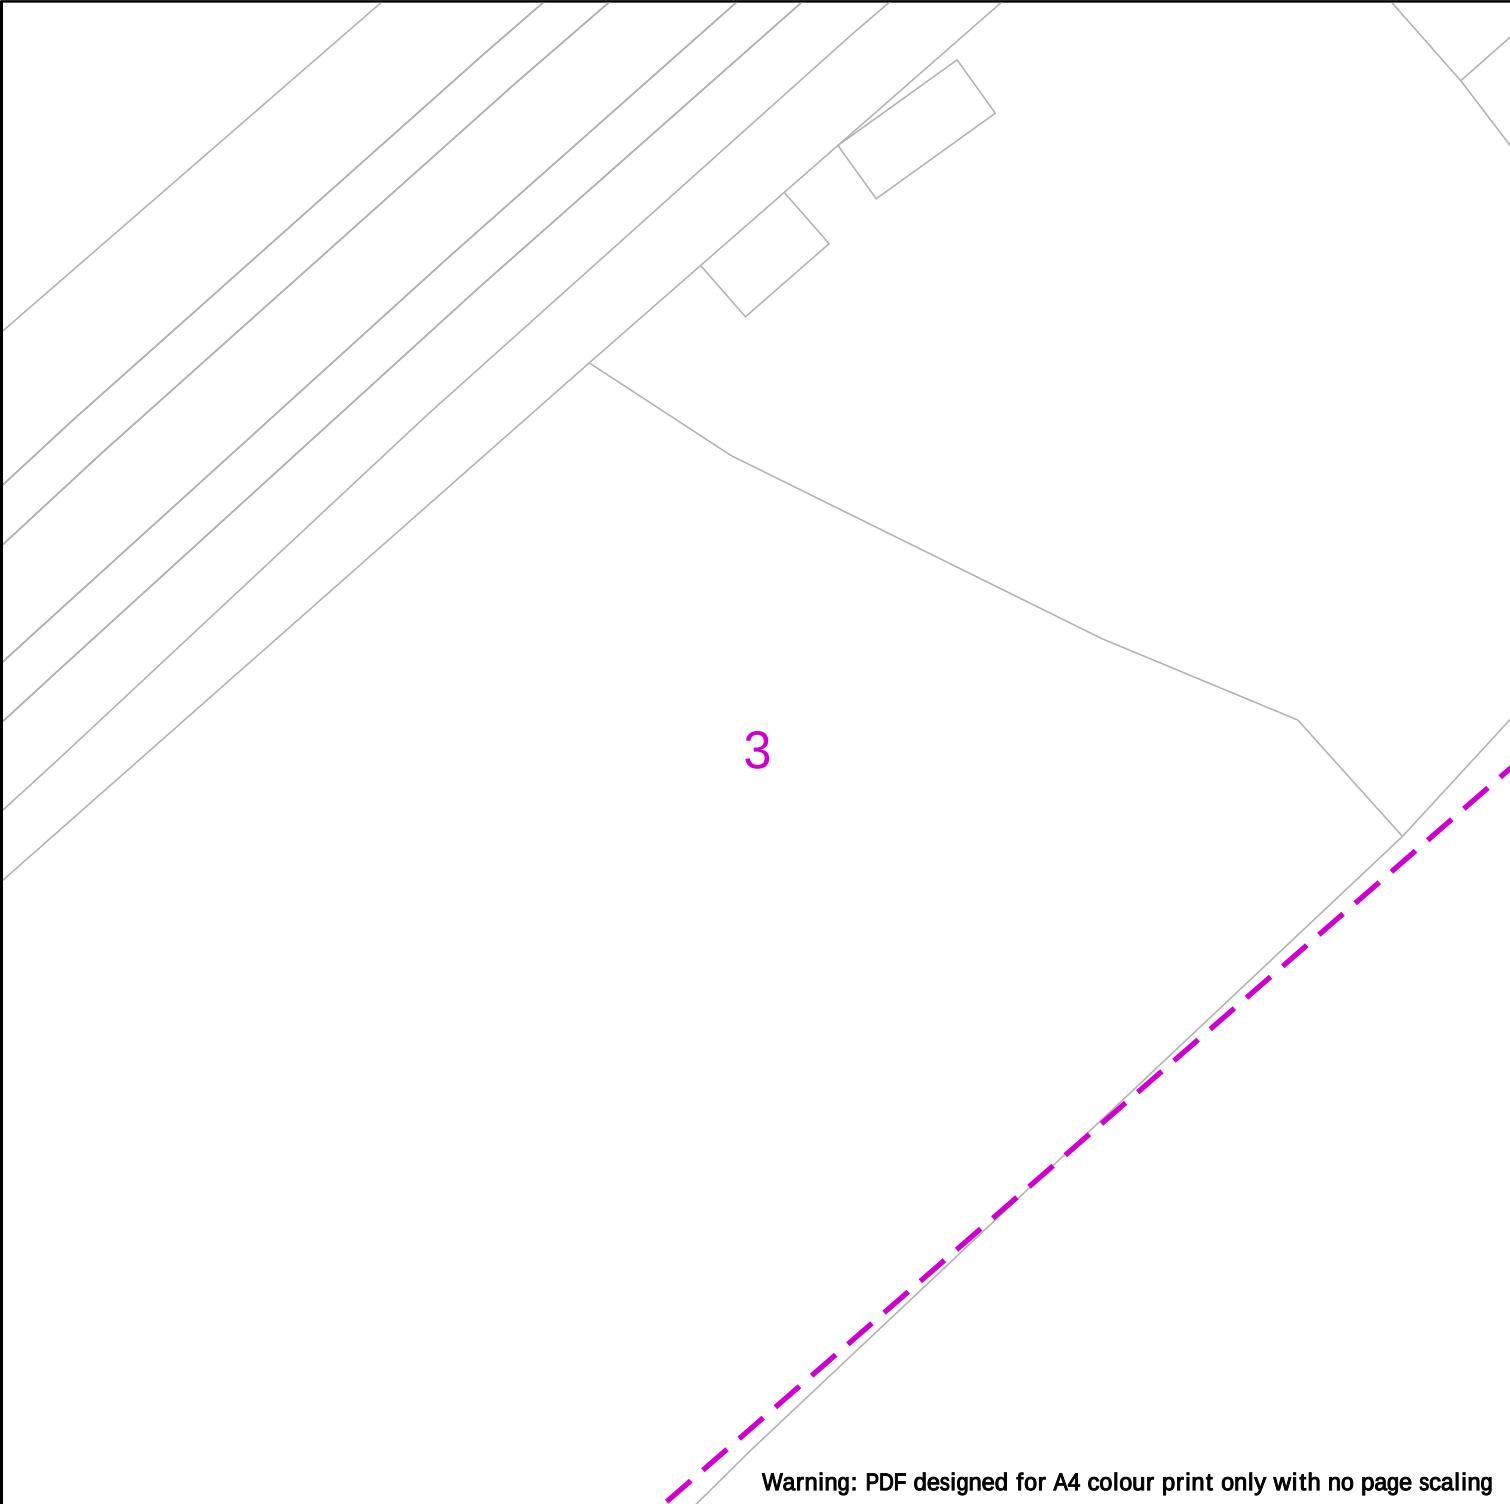



Warning: PDF designed for A4 colour print only with no page scaling

 Data Management Electricity North West Linley House Dickinson Street Manchester, M1 4LF Phone: 0800 195 4141 Email: planrequest@enwl.co.uk	Operating Voltage	Colour Code	Line Colour	In an emergency call 105, 24 hours a day	Dig Sites
	132kV	Black			Line: 
Date Requested: 23/01/2024 Job Reference: 32214546 Site Location: 389515 412131 Requested by: Miss Lauren Wenham Your Scheme/Reference: STW6382 Scale: 1:250 (When plotted at A4)	33kV	Green			Area: 
	22kV-25kV	Yellow			
	11kV	Red			
	6kV-6.6kV	Blue			
	1kV-6kV	Violet			
	LV	Orange			
	Unknown Voltage	Brown			
IMPORTANT INFO Unless otherwise indicated the depth of Electricity North West Limited cables are in accordance with NJUG (450mm for Low Voltage & 600mm for 11kV cables) 33kV and 132kV cables are laid at depths as marked. The depth and positions of Electricity North West Limited equipment was accurate as shown when the equipment was installed. However third parties may have altered the level & other reference data. Therefore Electricity North West Limited accept no responsibility for the position of Electricity North West Limited equipment being different from shown. No person, body or company, shall be relieved from liability for damage caused to Electricity North West Limited equipment by reason of being located differently to the indications on this drawing or from any regulatory loss of income or incentive, or expense, which may be suffered by Electricity North West Limited and which is caused or contributed to by any loss of supply as a result of any damage caused to Electricity North West Limited's equipment. Service cables are not necessarily shown but must be assumed to exist to all premises, streetlights and signs. There may be other Electricity North West Limited apparatus in the vicinity which is not indicated on the cable records. Other apparatus may also be present which is owned by a third party other than Electricity North West Limited. Reference should be made to HSE Guidance, HS(G)47 "Avoiding Danger from Underground Services" and GS6 "Avoidance of Danger from Overhead Power Lines". Electricity North West Limited 304 Bridgewater Place, Birchwood Park, Warrington WA3 6XG. Registered in England and Wales. Registered No 02366949					
Reproduced from or based upon Ordnance Survey's map with the permission of Her Majesty's Stationary Office. Crown Copyright Reserved. LICENCE No. 100017892.					

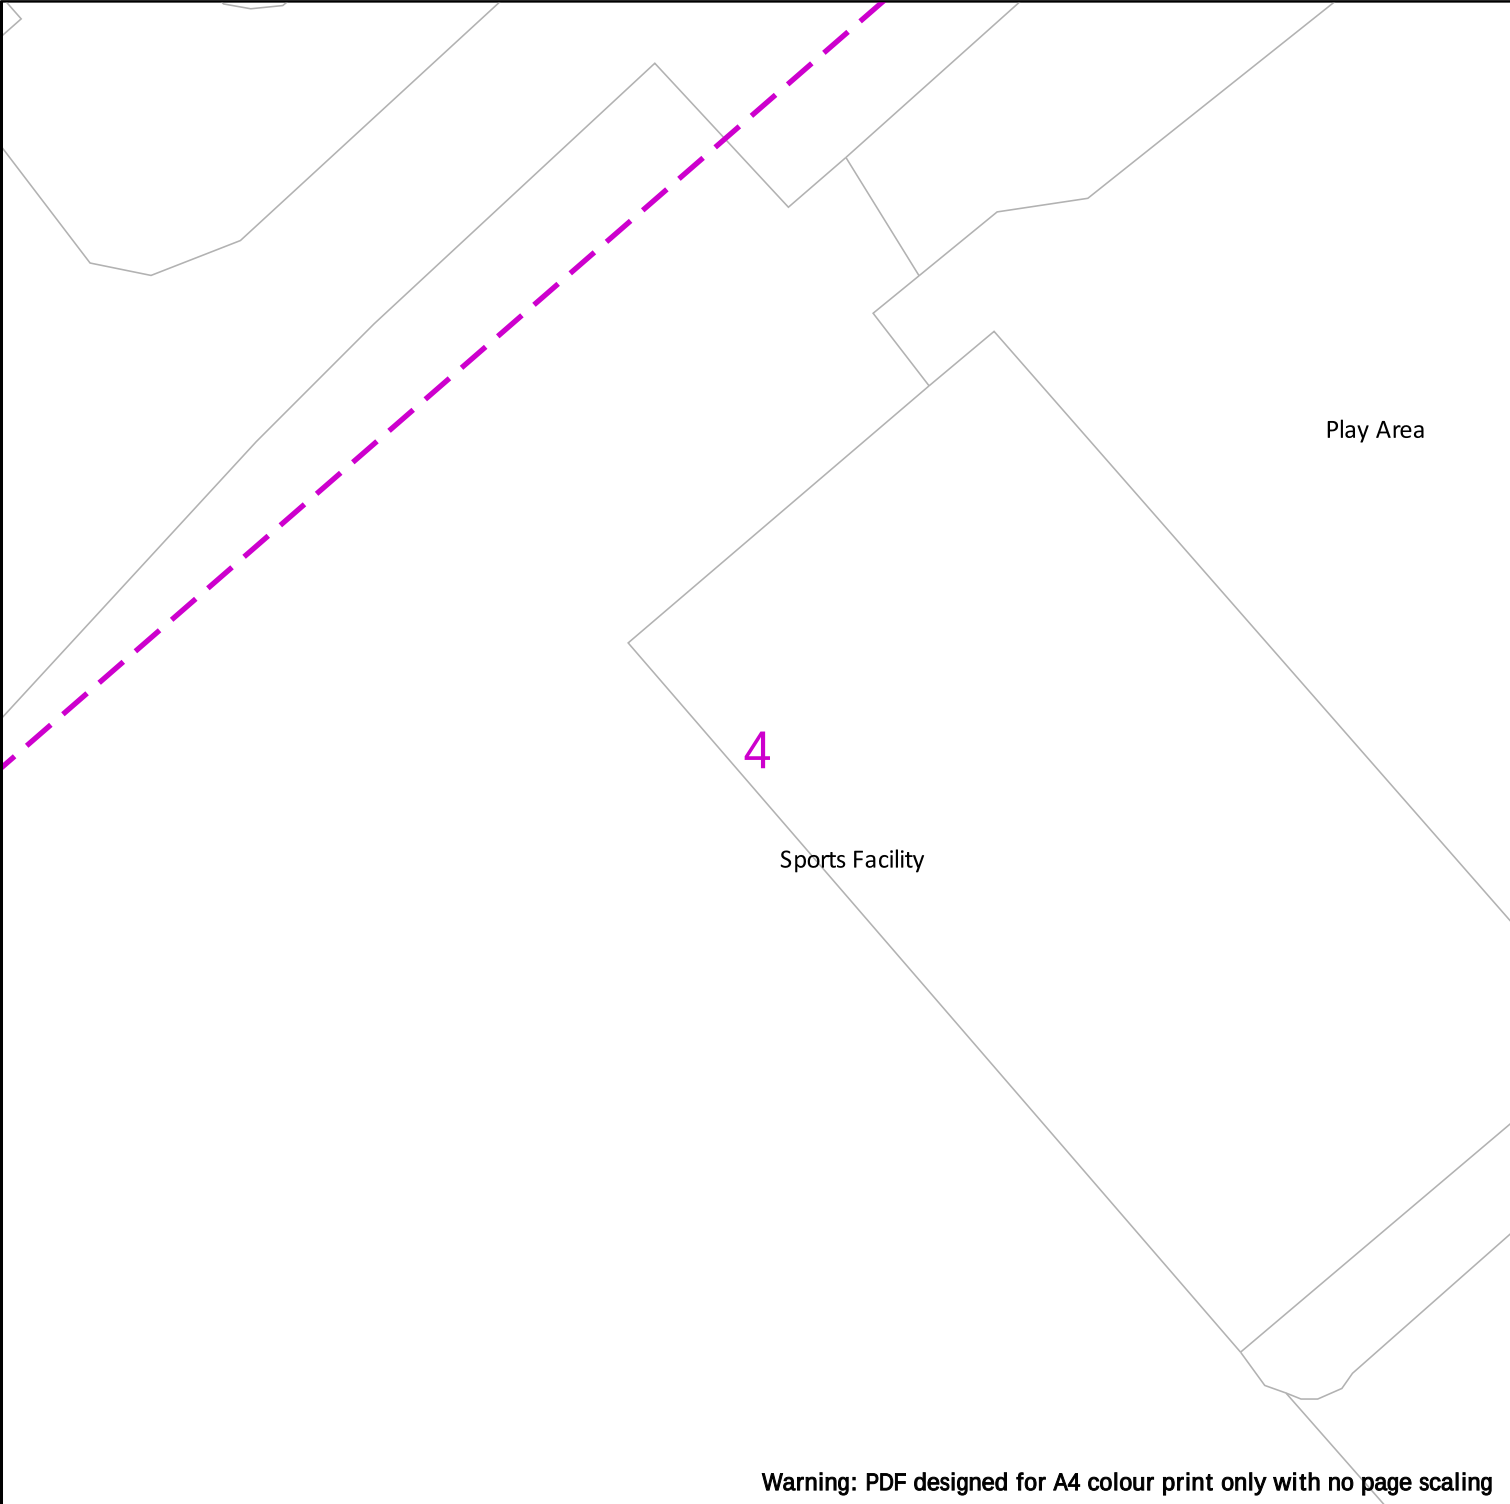

 Warning: PDF designed for A4 colour print only with no page scaling

 Data Management Electricity North West Linley House Dickinson Street Manchester, M1 4LF Phone: 0800 195 4141 Email: planrequest@enwl.co.uk	Operating Voltage	Colour Code	Line Colour	In an emergency call 105, 24 hours a day	Dig Sites
	132kV	Black			Line: 
	33kV	Green			Area: 
	22kV-25kV	Yellow			
	11kV	Red			
	6kV-6.6kV	Blue			
	1kV-6kV	Violet			
	LV	Orange			
Date Requested: 23/01/2024 Job Reference: 32214546 Site Location: 389515 412131 Requested by: Miss Lauren Wenham Your Scheme/Reference: STW6382 Scale: 1:250 (When plotted at A4)	Unknown Voltage	Brown			
	IMPORTANT INFO Unless otherwise indicated the depth of Electricity North West Limited cables are in accordance with NJUG (450mm for Low Voltage & 600mm for 11kV cables) 33kV and 132kV cables are laid at depths as marked. The depth and positions of Electricity North West Limited equipment was accurate as shown when the equipment was installed. However third parties may have altered the level & other reference data. Therefore Electricity North West Limited accept no responsibility for the position of Electricity North West Limited equipment being different from shown. No person, body or company, shall be relieved from liability for damage caused to Electricity North West Limited equipment by reason of being located differently to the indications on this drawing or from any regulatory loss of income or incentive, or expense, which may be suffered by Electricity North West Limited and which is caused or contributed to by any loss of supply as a result of any damage caused to Electricity North West Limited's equipment. Service cables are not necessarily shown but must be assumed to exist to all premises, streetlights and signs. There may be other Electricity North West Limited apparatus in the vicinity which is not indicated on the cable records. Other apparatus may also be present which is owned by a third party other than Electricity North West Limited. Reference should be made to HSE Guidance, HS(G)47 "Avoiding Danger from Underground Services" and GS6 "Avoidance of Danger from Overhead Power Lines". Electricity North West Limited 304 Bridgewater Place, Birchwood Park, Warrington WA3 6XG. Registered in England and Wales. Registered No 02366949				
Reproduced from or based upon Ordnance Survey's map with the permission of Her Majesty's Stationary Office. Crown Copyright Reserved. LICENCE No. 100017892.					

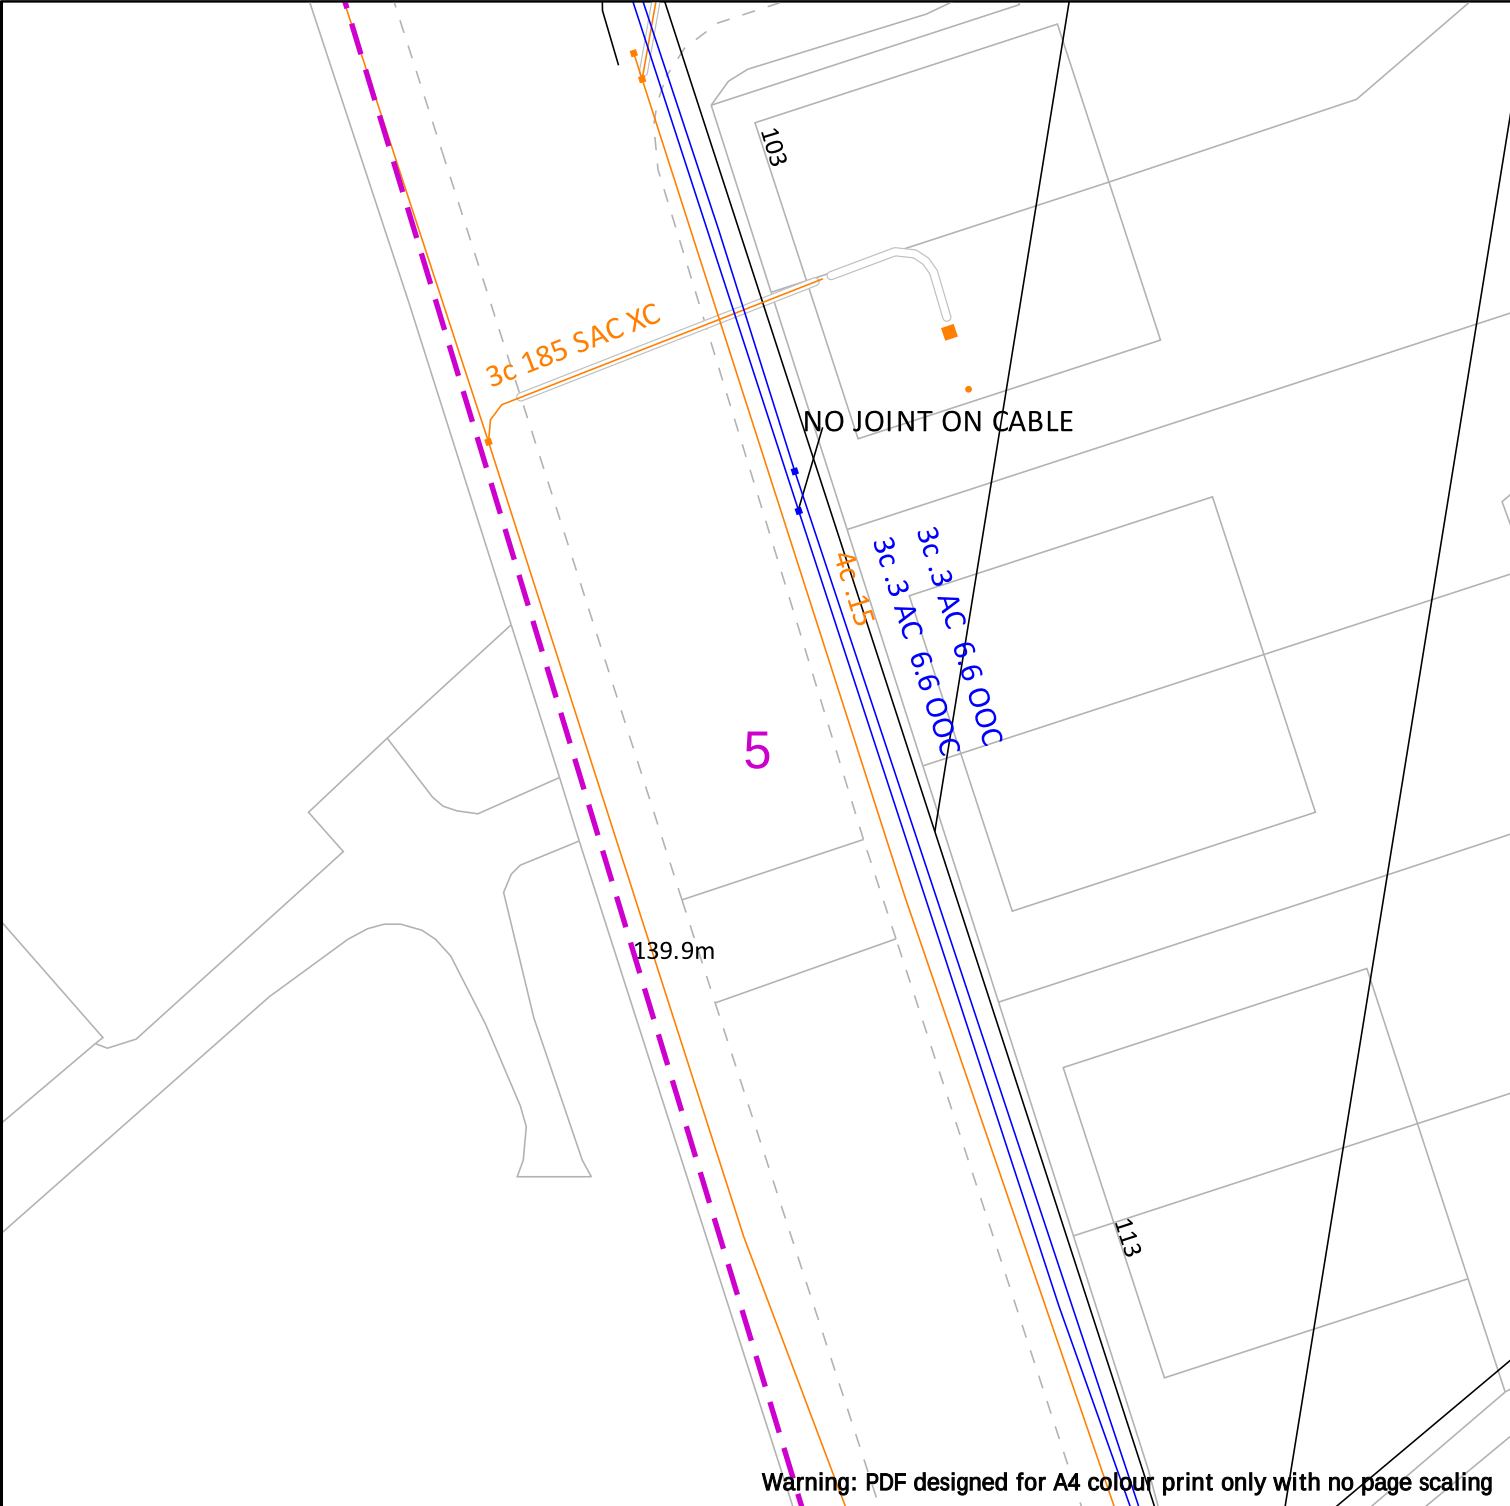



Data Management
Electricity North West
Linley House
Dickinson Street
Manchester, M1 4LF
Phone: 0800 195 4141
Email: planrequest@enwl.co.uk


Date Requested: 23/01/2024
Job Reference: 32214546
Site Location: 389515 412131
Requested by: Miss Lauren Wenham
Your Scheme/Reference: STW6382

Operating Voltage	Colour Code	Line Colour	In an emergency call 105, 24 hours a day	Dig Sites
132kV	Black			Line: 
33kV	Green			Area: 
22kV-25kV	Yellow			
11kV	Red			
6kV-6.6kV	Blue			
1kV-6kV	Violet			
LV	Orange			
Unknown Voltage	Brown			


IMPORTANT INFO
Unless otherwise indicated the depth of Electricity North West Limited cables are in accordance with NJUG (450mm for Low Voltage & 600mm for 11kV cables) 33kV and 132kV cables are laid at depths as marked. The depth and positions of Electricity North West Limited equipment was accurate as shown when the equipment was installed. However third parties may have altered the level & other reference data. Therefore Electricity North West Limited accept no responsibility for the position of Electricity North West Limited equipment being different from shown. No person, body or company, shall be relieved from liability for damage caused to Electricity North West Limited equipment by reason of being located differently to the indications on this drawing or from any regulatory loss of income or incentive, or expense, which may be suffered by Electricity North West Limited and which is caused or contributed to by any loss of supply as a result of any damage caused to Electricity North West Limited's equipment. Service cables are not necessarily shown but must be assumed to exist to all premises, streetlights and signs. There may be other Electricity North West Limited apparatus in the vicinity which is not indicated on the cable records. Other apparatus may also be present which is owned by a third party other than Electricity North West Limited.
Reference should be made to HSE Guidance, HS(G)47 "Avoiding Danger from Underground Services" and GS6 "Avoidance of Danger from Overhead Power Lines".
Electricity North West Limited 304 Bridgewater Place, Birchwood Park, Warrington WA3 6XG. Registered in England and Wales. Registered No 02366949

Scale: 1:250 (When plotted at A4)

Reproduced from or based upon Ordnance Survey's map with the permission of Her Majesty's Stationary Office. Crown Copyright Reserved. LICENCE No. 100017892.

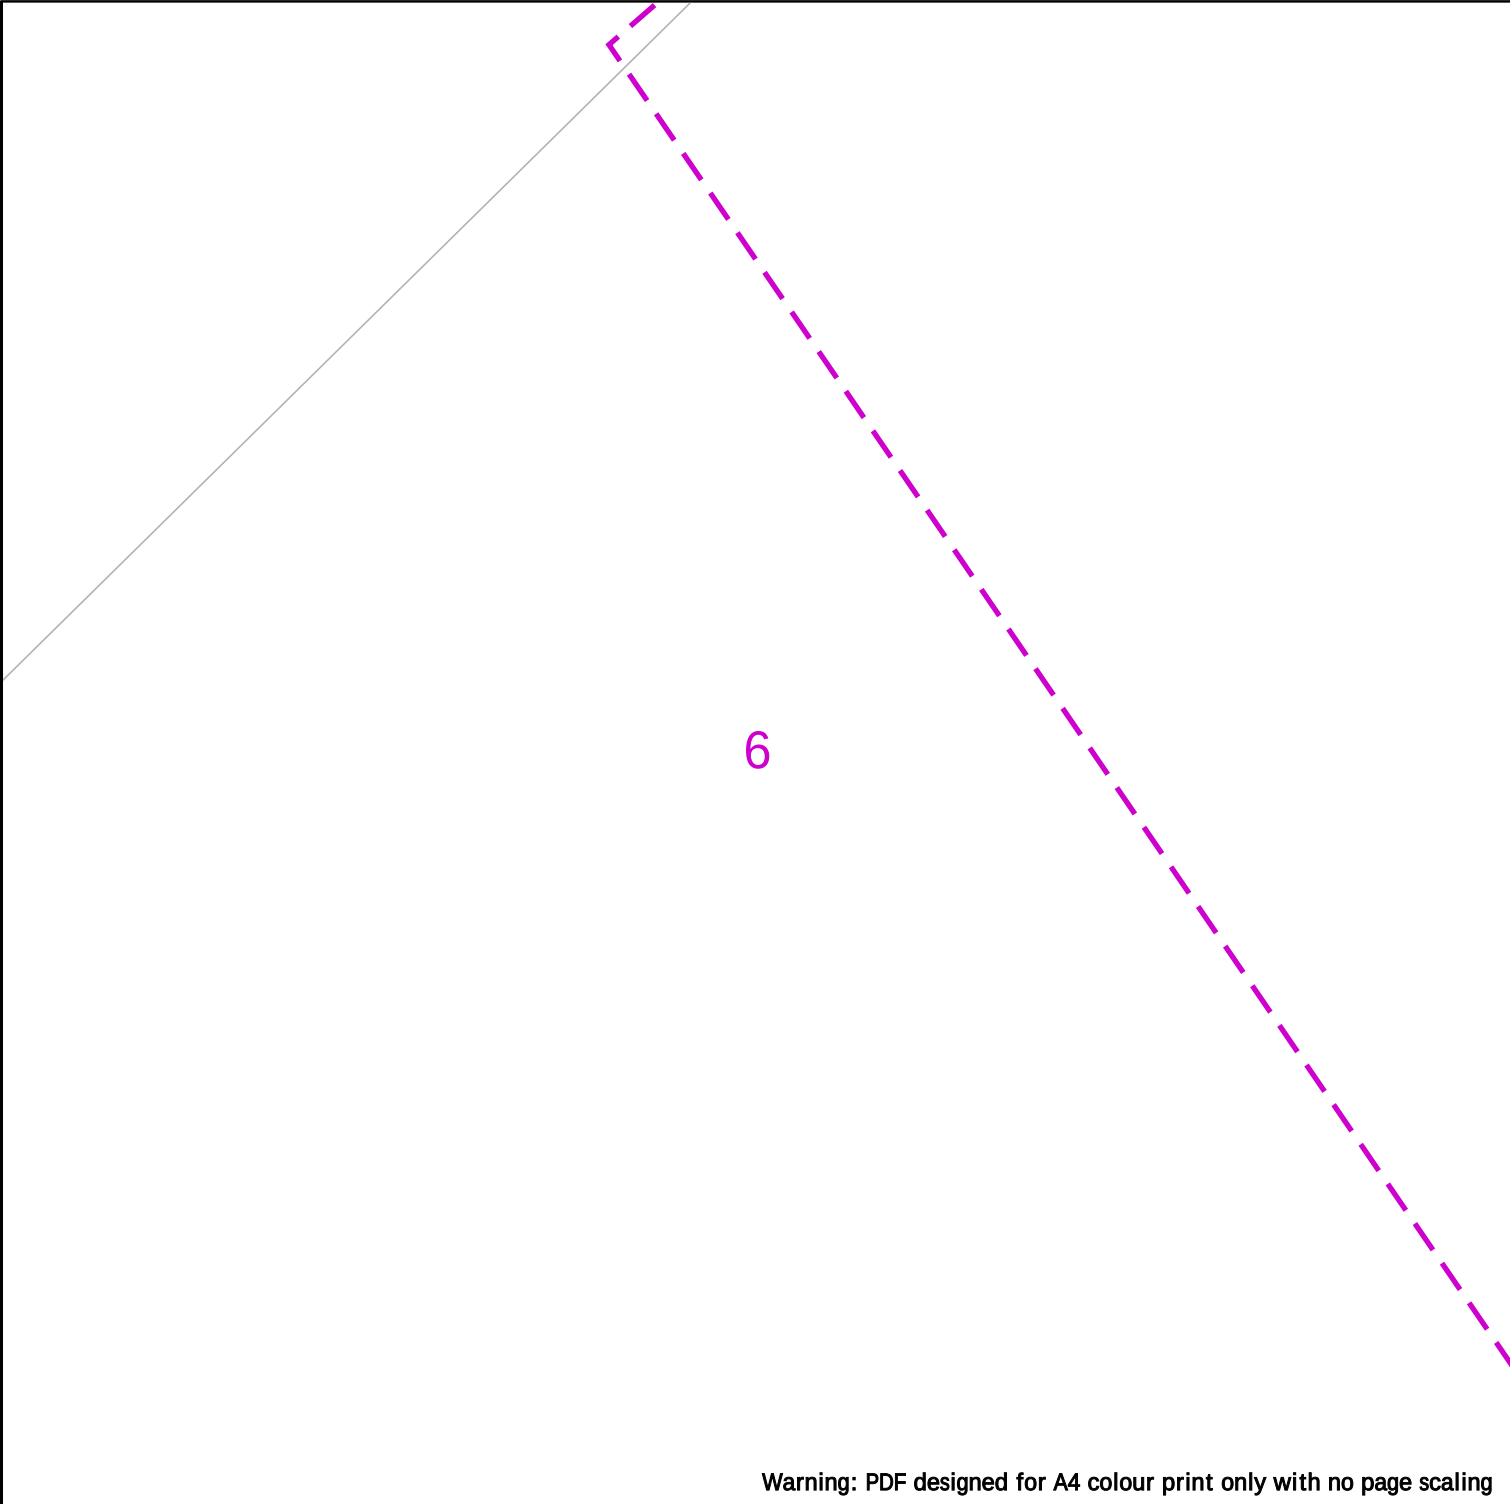

 Warning: PDF designed for A4 colour print only with no page scaling

 Data Management Electricity North West Linley House Dickinson Street Manchester, M1 4LF Phone: 0800 195 4141 Email: planrequest@enwl.co.uk	Operating Voltage 132kV 33kV 22kV-25kV 11kV 6kV-6.6kV 1kV-6kV LV Unknown Voltage	Colour Code Black Green Yellow Red Blue Violet Orange Brown	Line Colour        	In an emergency call 105, 24 hours a day	Dig Sites Line:  Area: 
	IMPORTANT INFO Unless otherwise indicated the depth of Electricity North West Limited cables are in accordance with NJUG (450mm for Low Voltage & 600mm for 11kV cables) 33kV and 132kV cables are laid at depths as marked. The depth and positions of Electricity North West Limited equipment was accurate as shown when the equipment was installed. However third parties may have altered the level & other reference data. Therefore Electricity North West Limited accept no responsibility for the position of Electricity North West Limited equipment being different from shown. No person, body or company, shall be relieved from liability for damage caused to Electricity North West Limited equipment by reason of being located differently to the indications on this drawing or from any regulatory loss of income or incentive, or expense, which may be suffered by Electricity North West Limited and which is caused or contributed to by any loss of supply as a result of any damage caused to Electricity North West Limited's equipment. Service cables are not necessarily shown but must be assumed to exist to all premises, streetlights and signs. There may be other Electricity North West Limited apparatus in the vicinity which is not indicated on the cable records. Other apparatus may also be present which is owned by a third party other than Electricity North West Limited. Reference should be made to HSE Guidance, HS(G)47 "Avoiding Danger from Underground Services" and GS6 "Avoidance of Danger from Overhead Power Lines". Electricity North West Limited 304 Bridgewater Place, Birchwood Park, Warrington WA3 6XG. Registered in England and Wales. Registered No 02366949				
Date Requested: 23/01/2024 Job Reference: 32214546 Site Location: 389515 412131 Requested by: Miss Lauren Wenham Your Scheme/Reference: STW6382 Scale: 1:250 (When plotted at A4)	Reproduced from or based upon Ordnance Survey's map with the permission of Her Majesty's Stationary Office. Crown Copyright Reserved. LICENCE No. 100017892.				

STONEFIELD

Warning: PDF designed for A4 colour print only with no page scaling



Data Management
Electricity North West
Linley House
Dickinson Street
Manchester, M1 4LF
Phone: 0800 195 4141
Email: planrequest@enwl.co.uk

Operating Voltage

132kV

33kV

22kV-25kV

11kV

6kV-6.6kV

1kV-6kV

LV

Unknown Voltage

Colour Code

Black

Green

Yellow

Red

Blue

Violet

Orange

Brown

Line Colour

In an emergency call 105,
24 hours a day

Dig Sites

Line:

Area:

IMPORTANT INFO

Unless otherwise indicated the depth of Electricity North West Limited cables are in accordance with NJUG (450mm for Low Voltage & 600mm for 11kV cables) 33kV and 132kV cables are laid at depths as marked. The depth and positions of Electricity North West Limited equipment was accurate as shown when the equipment was installed. However third parties may have altered the level & other reference data. Therefore Electricity North West Limited accept no responsibility for the position of Electricity North West Limited equipment being different from shown. No person, body or company, shall be relieved from liability for damage caused to Electricity North West Limited equipment by reason of being located differently to the indications on this drawing or from any regulatory loss of income or incentive, or expense, which may be suffered by Electricity North West Limited and which is caused or contributed to by any loss of supply as a result of any damage caused to Electricity North West Limited's equipment. Service cables are not necessarily shown but must be assumed to exist to all premises, streetlights and signs. There may be other Electricity North West Limited apparatus in the vicinity which is not indicated on the cable records. Other apparatus may also be present which is owned by a third party other than Electricity North West Limited.

Reference should be made to HSE Guidance, HS(G)47 "Avoiding Danger from Underground Services" and GS6 "Avoidance of Danger from Overhead Power Lines".
Electricity North West Limited 304 Bridgewater Place, Birchwood Park, Warrington WA3 6XG. Registered in England and Wales. Registered No 02366949

Reproduced from or based upon Ordnance Survey's map with the permission of Her Majesty's Stationary Office. Crown Copyright Reserved. LICENCE No. 100017892.

Date Requested: 23/01/2024

Job Reference: 32214546

Site Location: 389515 412131

Requested by: Miss Lauren Wenham

Your Scheme/Reference: STW6382

Scale: 1:250 (When plotted at A4)



Warning: PDF designed for A4 colour print only with no page scaling



Data Management
Electricity North West
Linley House
Dickinson Street
Manchester, M1 4LF
Phone: 0800 195 4141
Email: planrequest@enwl.co.uk

Date Requested: 23/01/2024
Job Reference: 32214546
Site Location: 389515 412131
Requested by: Miss Lauren Wenham
Your Scheme/Reference: STW6382

Scale: 1:250 (When plotted at A4)

Operating Voltage

132kV

33kV

22kV-25kV

11kV

6kV-6.6kV

1kV-6kV

LV

Unknown Voltage

Colour Code

Black

Green

Yellow

Red

Blue

Violet

Orange

Brown

Line Colour



In an emergency call 105,
24 hours a day

Dig Sites

Line:


Area:

IMPORTANT INFO

Unless otherwise indicated the depth of Electricity North West Limited cables are in accordance with NJUG (450mm for Low Voltage & 600mm for 11kV cables) 33kV and 132kV cables are laid at depths as marked. The depth and positions of Electricity North West Limited equipment was accurate as shown when the equipment was installed. However third parties may have altered the level & other reference data. Therefore Electricity North West Limited accept no responsibility for the position of Electricity North West Limited equipment being different from shown. No person, body or company, shall be relieved from liability for damage caused to Electricity North West Limited equipment by reason of being located differently to the indications on this drawing or from any regulatory loss of income or incentive, or expense, which may be suffered by Electricity North West Limited and which is caused or contributed to by any loss of supply as a result of any damage caused to Electricity North West Limited's equipment. Service cables are not necessarily shown but must be assumed to exist to all premises, streetlights and signs. There may be other Electricity North West Limited apparatus in the vicinity which is not indicated on the cable records. Other apparatus may also be present which is owned by a third party other than Electricity North West Limited.

Reference should be made to HSE Guidance, HS(G)47 "Avoiding Danger from Underground Services" and GS6 "Avoidance of Danger from Overhead Power Lines".
Electricity North West Limited 304 Bridgewater Place, Birchwood Park, Warrington WA3 6XG. Registered in England and Wales. Registered No 02366949

Reproduced from or based upon Ordnance Survey's map with the permission of Her Majesty's Stationary Office. Crown Copyright Reserved. LICENCE No. 100017892.

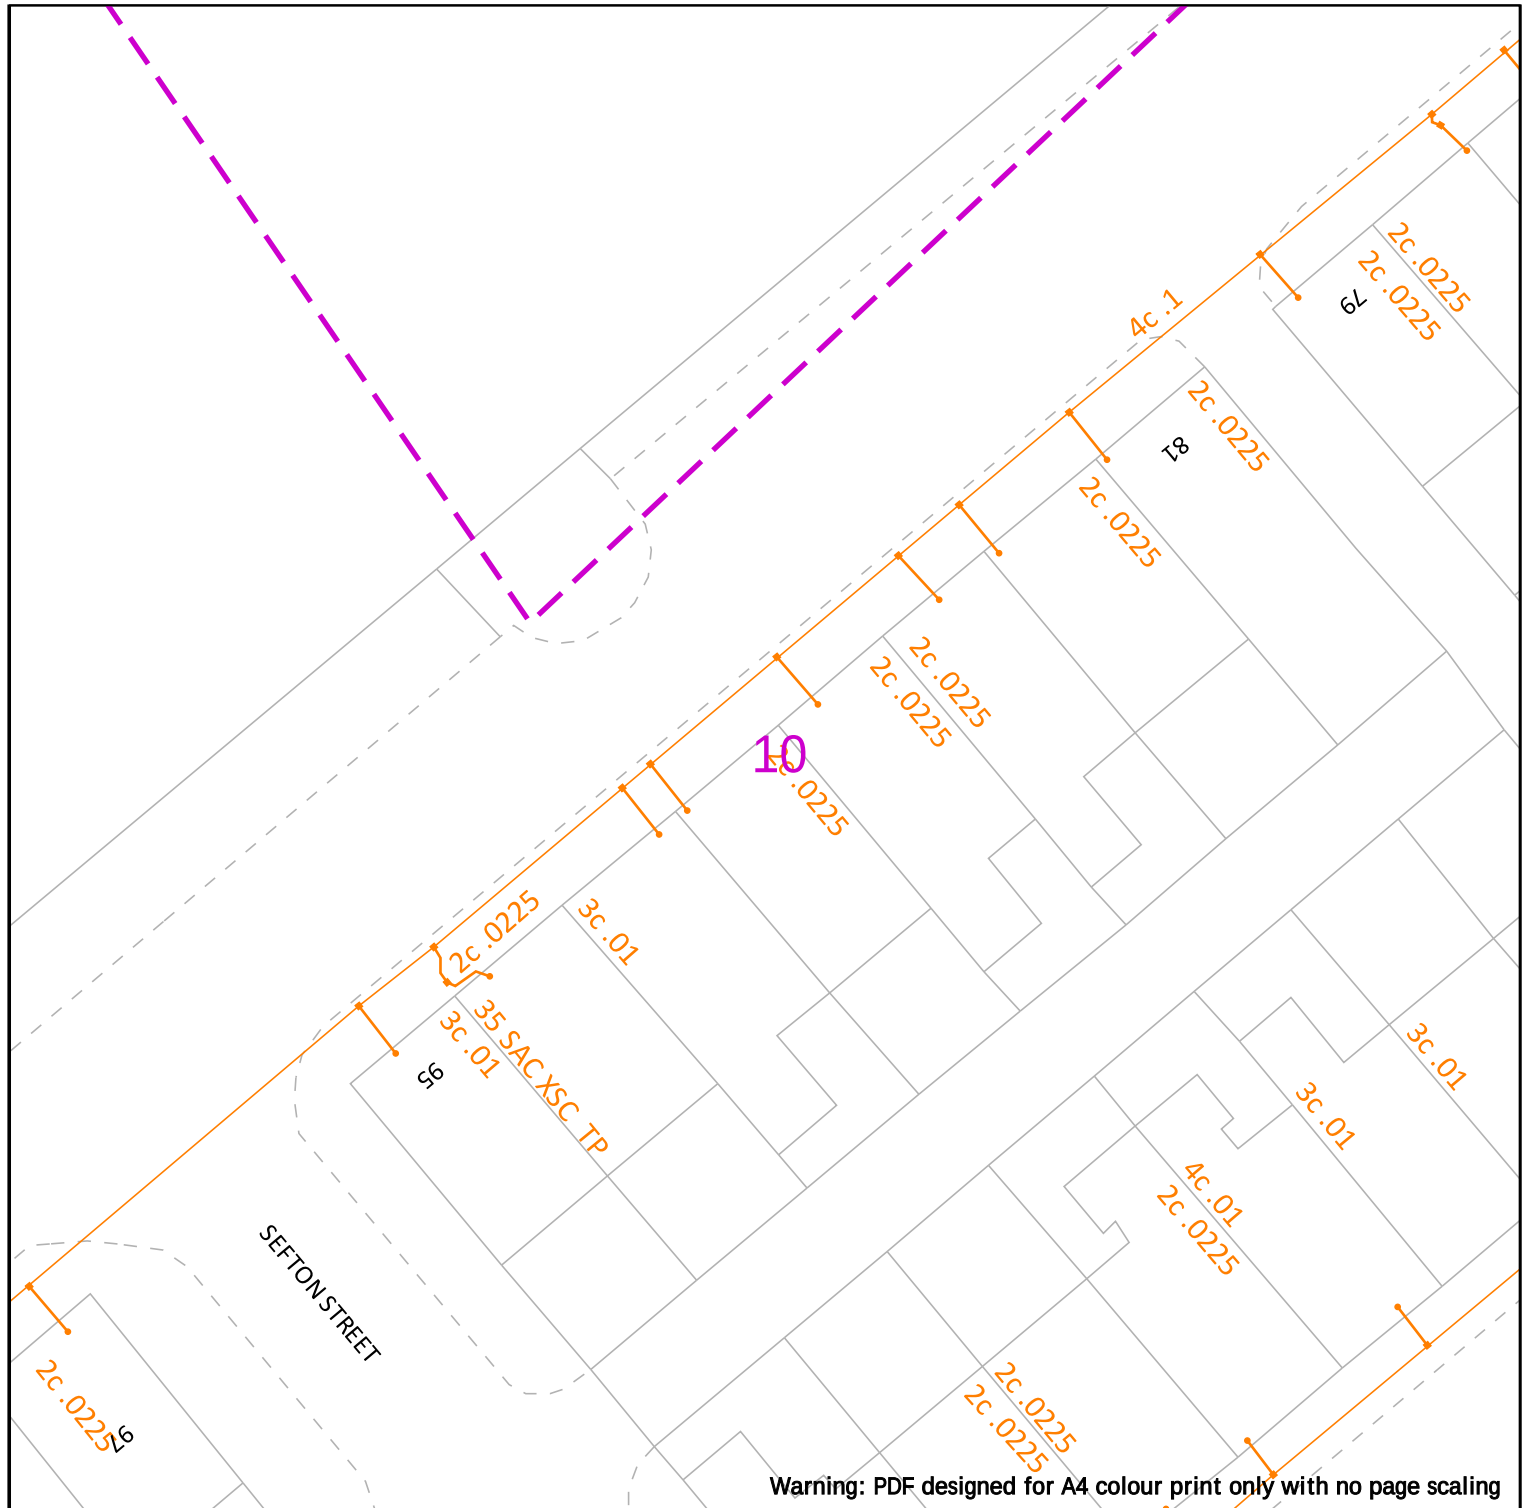

Warning: PDF designed for A4 colour print only with no page scaling



Data Management
Electricity North West
Linley House
Dickinson Street
Manchester, M1 4LF
Phone: 0800 195 4141
Email: planrequest@enwl.co.uk

Operating Voltage

132kV
33kV
22kV-25kV
11kV
6kV-6.6kV
1kV-6kV
LV

Unknown Voltage

Colour Code

Black
Green
Yellow
Red
Blue
Violet
Orange
Brown

Line Colour



In an emergency call 105,
24 hours a day

Dig Sites

Line: - - - -

Area: [] [] [] []


IMPORTANT INFO

Unless otherwise indicated the depth of Electricity North West Limited cables are in accordance with NJUG (450mm for Low Voltage & 600mm for 11kV cables) 33kV and 132kV cables are laid at depths as marked. The depth and positions of Electricity North West Limited equipment was accurate as shown when the equipment was installed. However third parties may have altered the level & other reference data. Therefore Electricity North West Limited accept no responsibility for the position of Electricity North West Limited equipment being different from shown. No person, body or company, shall be relieved from liability for damage caused to Electricity North West Limited equipment by reason of being located differently to the indications on this drawing or from any regulatory loss of income or incentive, or expense, which may be suffered by Electricity North West Limited and which is caused or contributed to by any loss of supply as a result of any damage caused to Electricity North West Limited's equipment. Service cables are not necessarily shown but must be assumed to exist to all premises, streetlights and signs. There may be other Electricity North West Limited apparatus in the vicinity which is not indicated on the cable records. Other apparatus may also be present which is owned by a third party other than Electricity North West Limited. Reference should be made to HSE Guidance, HS(G)47 "Avoiding Danger from Underground Services" and GS6 "Avoidance of Danger from Overhead Power Lines". Electricity North West Limited 304 Bridgewater Place, Birchwood Park, Warrington WA3 6XG. Registered in England and Wales. Registered No 02366949

Reproduced from or based upon Ordnance Survey's map with the permission of Her Majesty's Stationary Office. Crown Copyright Reserved. LICENCE No. 100017892.

Date Requested: 23/01/2024
Job Reference: 32214546
Site Location: 389515 412131
Requested by: Miss Lauren Wenham
Your Scheme/Reference: STW6382

Scale: 1:250 (When plotted at A4)

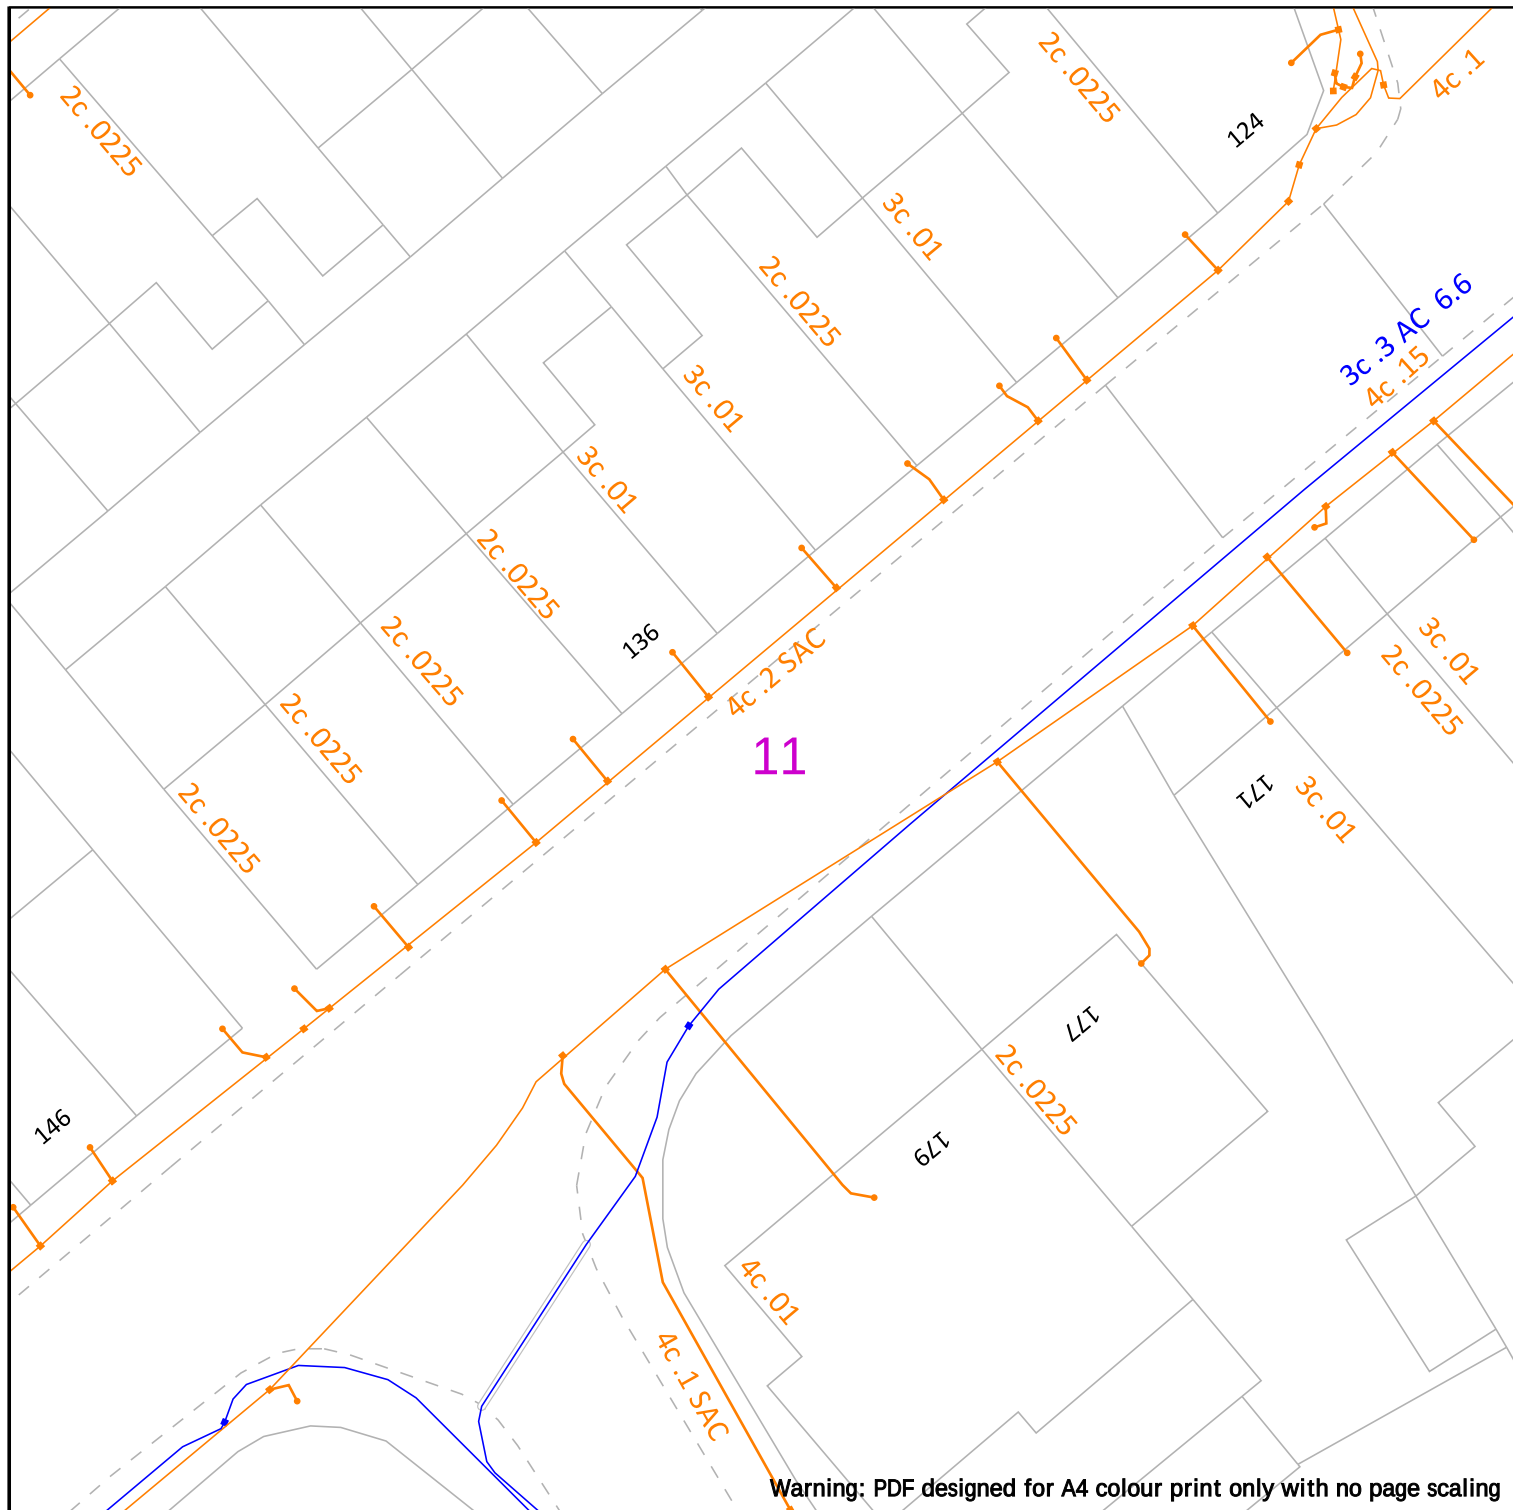

Warning: PDF designed for A4 colour print only with no page scaling



Data Management
Electricity North West
Linley House
Dickinson Street
Manchester, M1 4LF
Phone: 0800 195 4141
Email: planrequest@enwl.co.uk

Operating Voltage

132kV
33kV
22kV-25kV
11kV
6kV-6.6kV
1kV-6kV
LV
Unknown Voltage

Colour Code

Black
Green
Yellow
Red
Blue
Violet
Orange
Brown

Line Colour



In an emergency call 105,
24 hours a day

Dig Sites

Line: - - - -

Area: [] [] [] []

Date Requested: 23/01/2024
Job Reference: 32214546
Site Location: 389515 412131
Requested by: Miss Lauren Wenham
Your Scheme/Reference: STW6382


IMPORTANT INFO

Unless otherwise indicated the depth of Electricity North West Limited cables are in accordance with NJUG (450mm for Low Voltage & 600mm for 11kV cables) 33kV and 132kV cables are laid at depths as marked. The depth and positions of Electricity North West Limited equipment was accurate as shown when the equipment was installed. However third parties may have altered the level & other reference data. Therefore Electricity North West Limited accept no responsibility for the position of Electricity North West Limited equipment being different from shown. No person, body or company, shall be relieved from liability for damage caused to Electricity North West Limited equipment by reason of being located differently to the indications on this drawing or from any regulatory loss of income or incentive, or expense, which may be suffered by Electricity North West Limited and which is caused or contributed to by any loss of supply as a result of any damage caused to Electricity North West Limited's equipment. Service cables are not necessarily shown but must be assumed to exist to all premises, streetlights and signs. There may be other Electricity North West Limited apparatus in the vicinity which is not indicated on the cable records. Other apparatus may also be present which is owned by a third party other than Electricity North West Limited. Reference should be made to HSE Guidance, HS(G)47 "Avoiding Danger from Underground Services" and GS6 "Avoidance of Danger from Overhead Power Lines". Electricity North West Limited 304 Bridgewater Place, Birchwood Park, Warrington WA3 6XG. Registered in England and Wales. Registered No 02366949

Scale: 1:250 (When plotted at A4)

Reproduced from or based upon Ordnance Survey's map with the permission of Her Majesty's Stationary Office. Crown Copyright Reserved. LICENCE No. 100017892.

Overview map of worksite

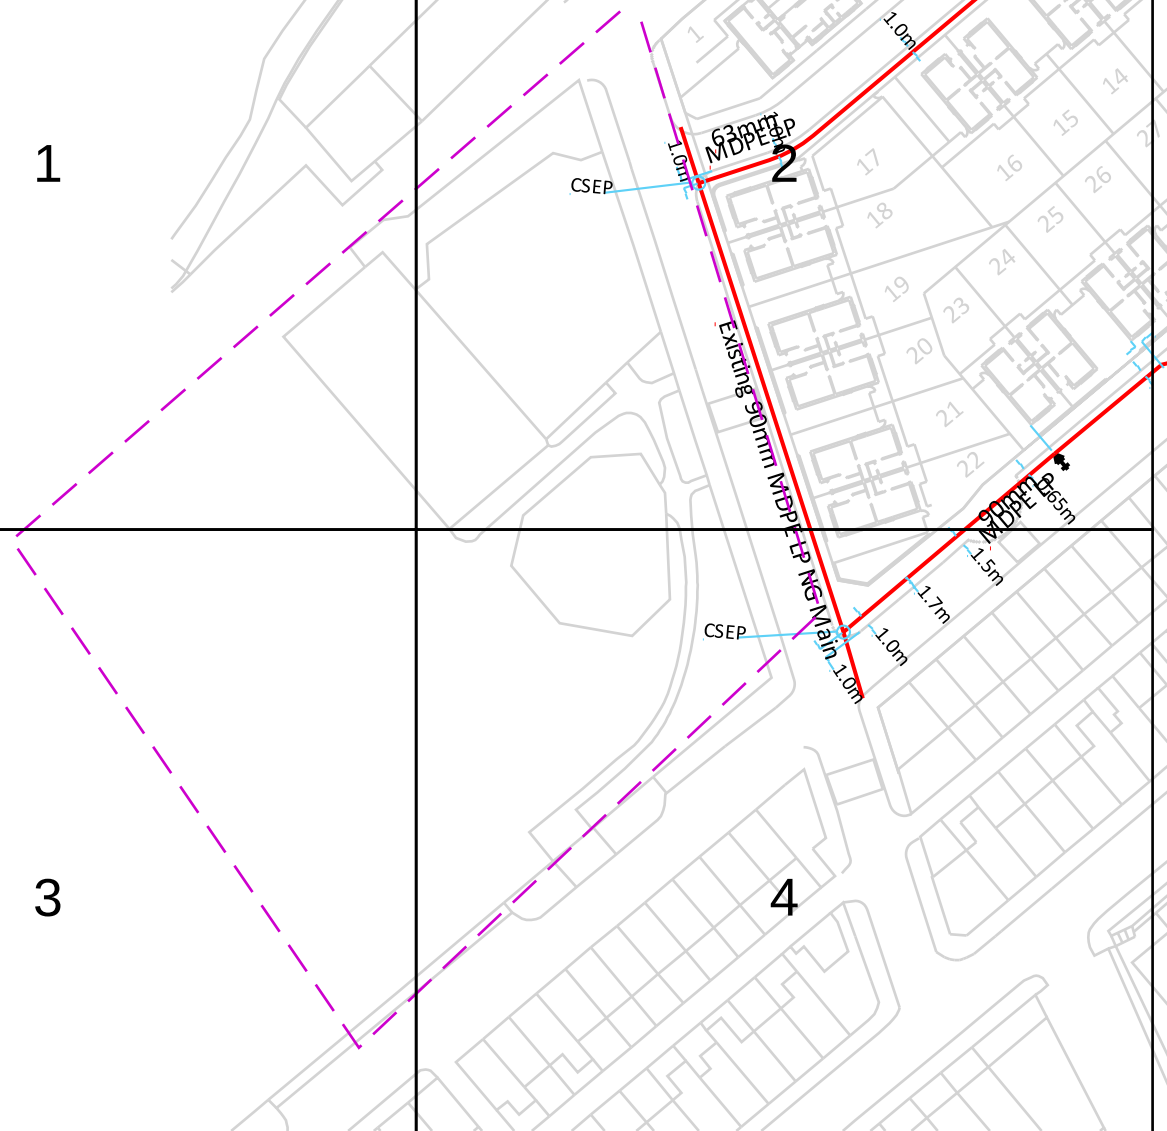


**Last Mile Asset Management
Limited**
Fenick House, Lister Way
Hamilton International Technology
Park
Glasgow G72 0FT
Telephone 03300 587 443

Date Requested: 23/01/2024
Job Reference: 32214546
Site Location: 389515 412131
Requested by: Miss Lauren Wenham
Your Scheme/Reference: STW6382

Scale: 1:1025 (When plotted at A4)

GAS KEY

PROPOSED LP SERVICE	-----	PIPE TO BE DECOMMISSIONED
INSTALLED LP SERVICE	-----	DIAMETER CHANGE
PROPOSED MP SERVICE	-----	CAP END
PROPOSED LP MAINS	-----	VALVE
INSTALLED LP MAINS	-----	GAS METERBOX/KIOSK
PROPOSED MP MAINS	-----	GAS RISER
PROPOSED IP MAINS	-----	GAS METER
EXISTING/AS LAID LP SERVICE	-----	CATHODIC PROTECTION
EXISTING/AS LAID MP SERVICE	-----	PRESSURE REDUCTION INSTALLATION (P.R.I)
EXISTING/AS LAID LP MAINS	-----	MEDIUM PRESSURE SERVICE EXCESS FLOW VALVE
EXISTING/AS LAID MP MAINS	-----	PRESSURE PROTECTION
INSTALLED MP MAINS	-----	RIDER PURGE POINT
EXISTING/AS LAID IP MAINS	-----	PLOTS WITH CONNECTIONS OFF OTHER GT/EXISTING GAS NETWORKS
EXISTING HP MAINS	-----	
DECOMMISSIONED PIPE	-----	

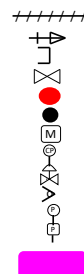

Dig Sites

Line:


Area:

This plan shows those pipes owned by Last Mile Gas Limited in their role as a Licensed Gas Transporter (GT). Gas pipes owned by other GTs, or otherwise privately owned (or, indeed, any other apparatus, equipment or infrastructure may be present in this area. Information regarding such pipes (or any such other apparatus, equipment, or infrastructure) should be obtained from the relevant owners.

The information shown on these plans is provided for general information purposes only and should not be relied on or treated as a substitute for your own enquiries. We make no warranty, representation, or guarantee, whether express or implied, regarding the content of the plans or that the content is accurate, complete, or up to date. No liability of any kind whatsoever is accepted by Last Mile Asset Management Limited, or their agents, servants or contractors for any error, omission, or misstatement.

Safe digging practices, in accordance with HS(G)47, must be used to verify and establish the actual position of mains, pipes, services and other apparatus on site before any mechanical plant is used. It is your responsibility to ensure that this information is provided to all persons (either direct labour or contractors) working for you on or near gas apparatus. The information included on this plan should not be referred to beyond a period of 28 days from the date of issue.

In an emergency call 0800 111 999, 24 hours a day

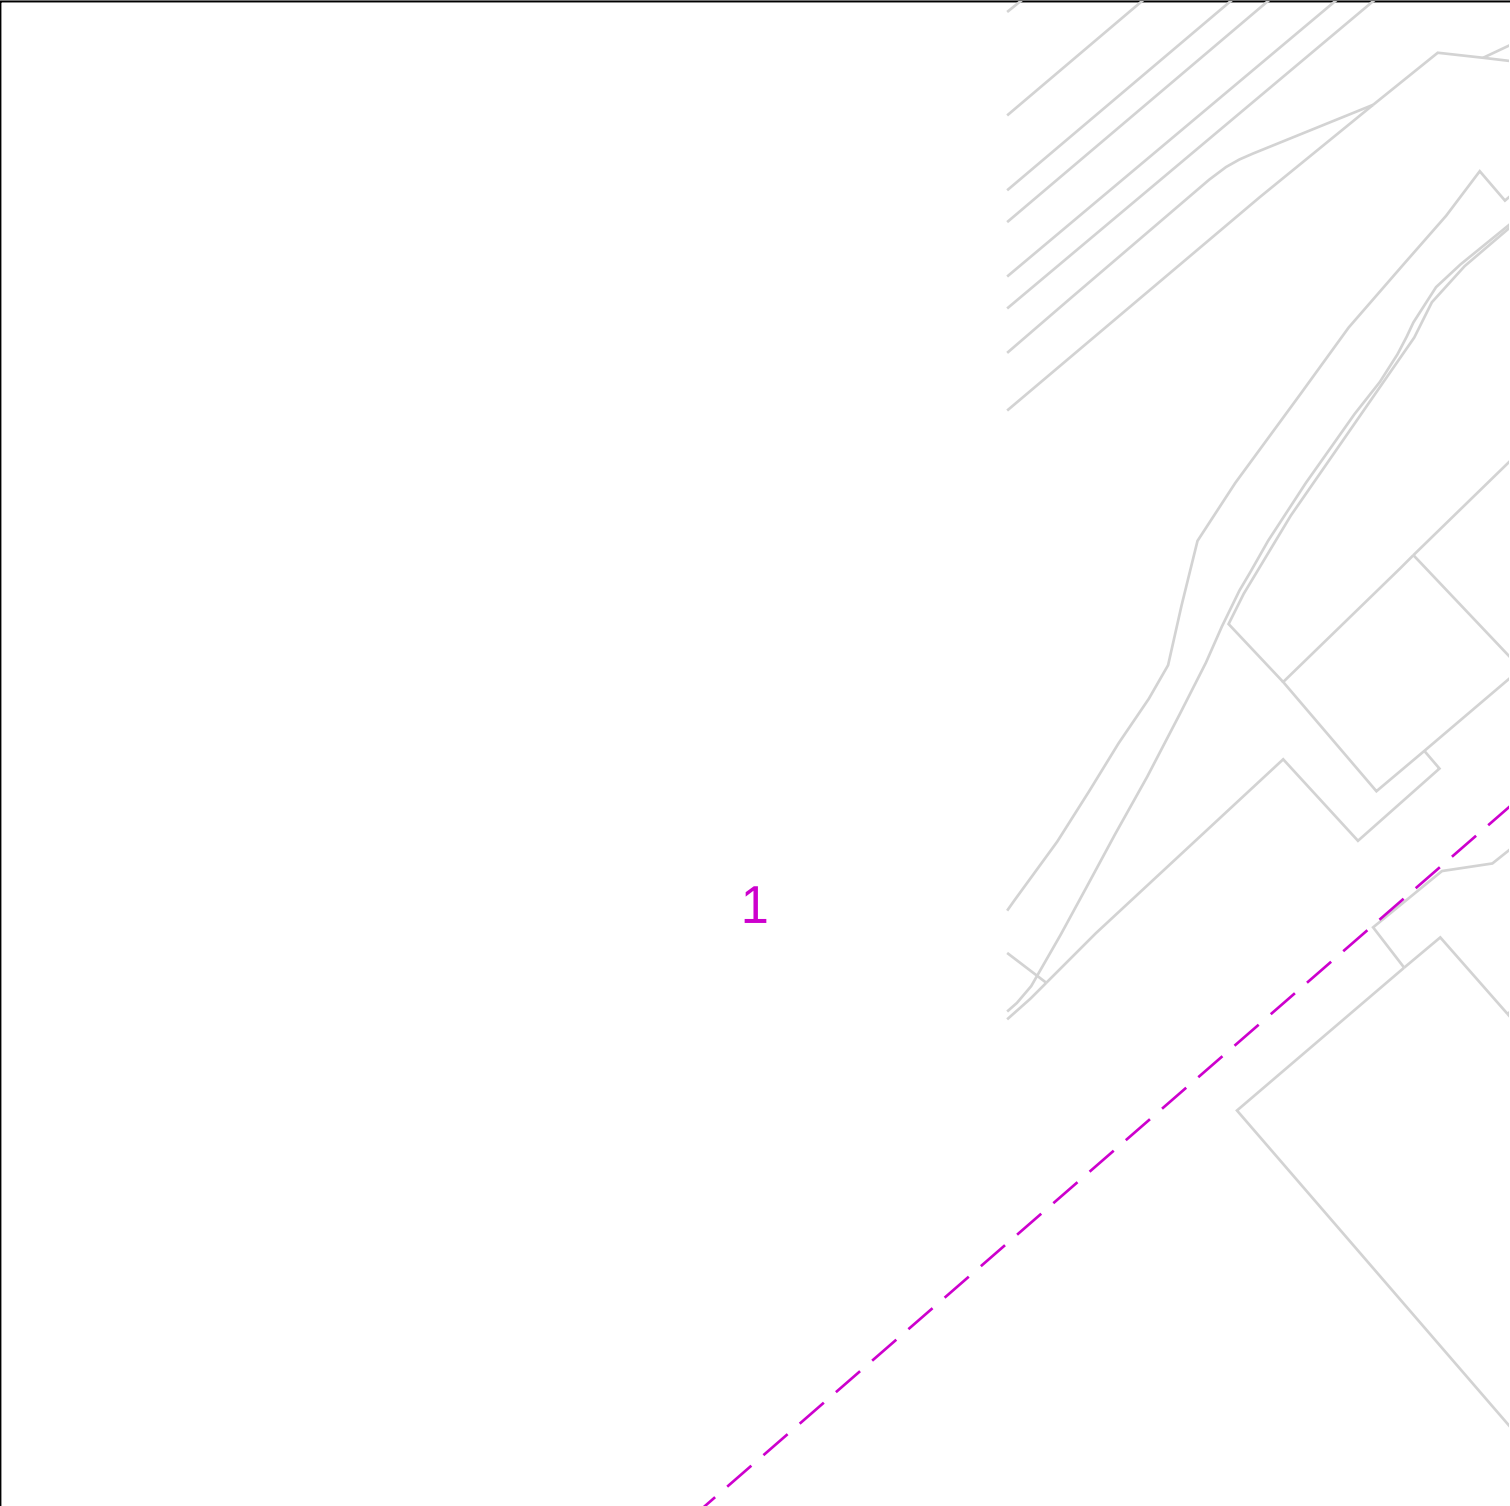



Last Mile Asset Management
Limited

Fenick House, Lister Way
Hamilton International Technology
Park
Glasgow G72 0FT
Telephone 03300 587 443

PROPOSED LP SERVICE	-----	PIPE TO BE DECOMMISSIONED	++++++
INSTALLED LP SERVICE	-----	DIAMETER CHANGE	↑
PROPOSED MP SERVICE	-----	CAP END	⊥
PROPOSED LP MAINS	-----	VALVE	⊕
INSTALLED LP MAINS	-----	GAS METERBOX/KIOSK	⊙
PROPOSED MP MAINS	-----	GAS RISER	●
PROPOSED IP MAINS	-----	GAS METER	⊖
EXISTING/AS LAID LP SERVICE	-----	CATHODIC PROTECTION	⊕
EXISTING/AS LAID MP SERVICE	-----	PRESSURE REDUCTION INSTALLATION (P.R.I)	⊕
EXISTING/AS LAID LP MAINS	-----	MEDIUM PRESSURE SERVICE EXCESS FLOW VALVE	⊕
EXISTING/AS LAID MP MAINS	-----	PRESSURE PROTECTION	⊕
INSTALLED MP MAINS	-----	RIDER PURGE POINT	⊕
EXISTING/AS LAID IP MAINS	-----	PLOTS WITH CONNECTIONS OFF OTHER GT/EXISTING GAS NETWORKS	⊕
EXISTING HP MAINS	-----		
DECOMMISSIONED PIPE	-----		

100m

Dig Sites

Line: -----

Area: -----

Date Requested: 23/01/2024
Job Reference: 32214546
Site Location: 389515 412131
Requested by: Miss Lauren Wenham
Your Scheme/Reference: STW6382

Scale: 1:500 (When plotted at A4)


This plan shows those pipes owned by Last Mile Gas Limited in their role as a Licensed Gas Transporter (GT). Gas pipes owned by other GTs, or otherwise privately owned (or, indeed, any other apparatus, equipment or infrastructure) may be present in this area. Information regarding such pipes (or any such other apparatus, equipment, or infrastructure) should be obtained from the relevant owners.

The information shown on these plans is provided for general information purposes only and should not be relied on or treated as a substitute for your own enquiries. We make no warranty, representation, or guarantee, whether express or implied, regarding the content of the plans or that the content is accurate, complete, or up to date. No liability of any kind whatsoever is accepted by Last Mile Asset Management Limited, or their agents, servants or contractors for any error, omission, or misstatement.

Safe digging practices, in accordance with HS(G)47, must be used to verify and establish the actual position of mains, pipes, services and other apparatus on site before any mechanical plant is used. It is your responsibility to ensure that this information is provided to all persons (either direct labour or contractors) working for you on or near gas apparatus. The information included on this plan should not be referred to beyond a period of 28 days from the date of issue.

In an emergency call 0800 111 999, 24 hours a day

Crown Copyright © - Reproduced by permission of Ordnance Survey on behalf of HMSO. And database right 2023. All rights reserved. Ordnance Survey Licence number 100061801

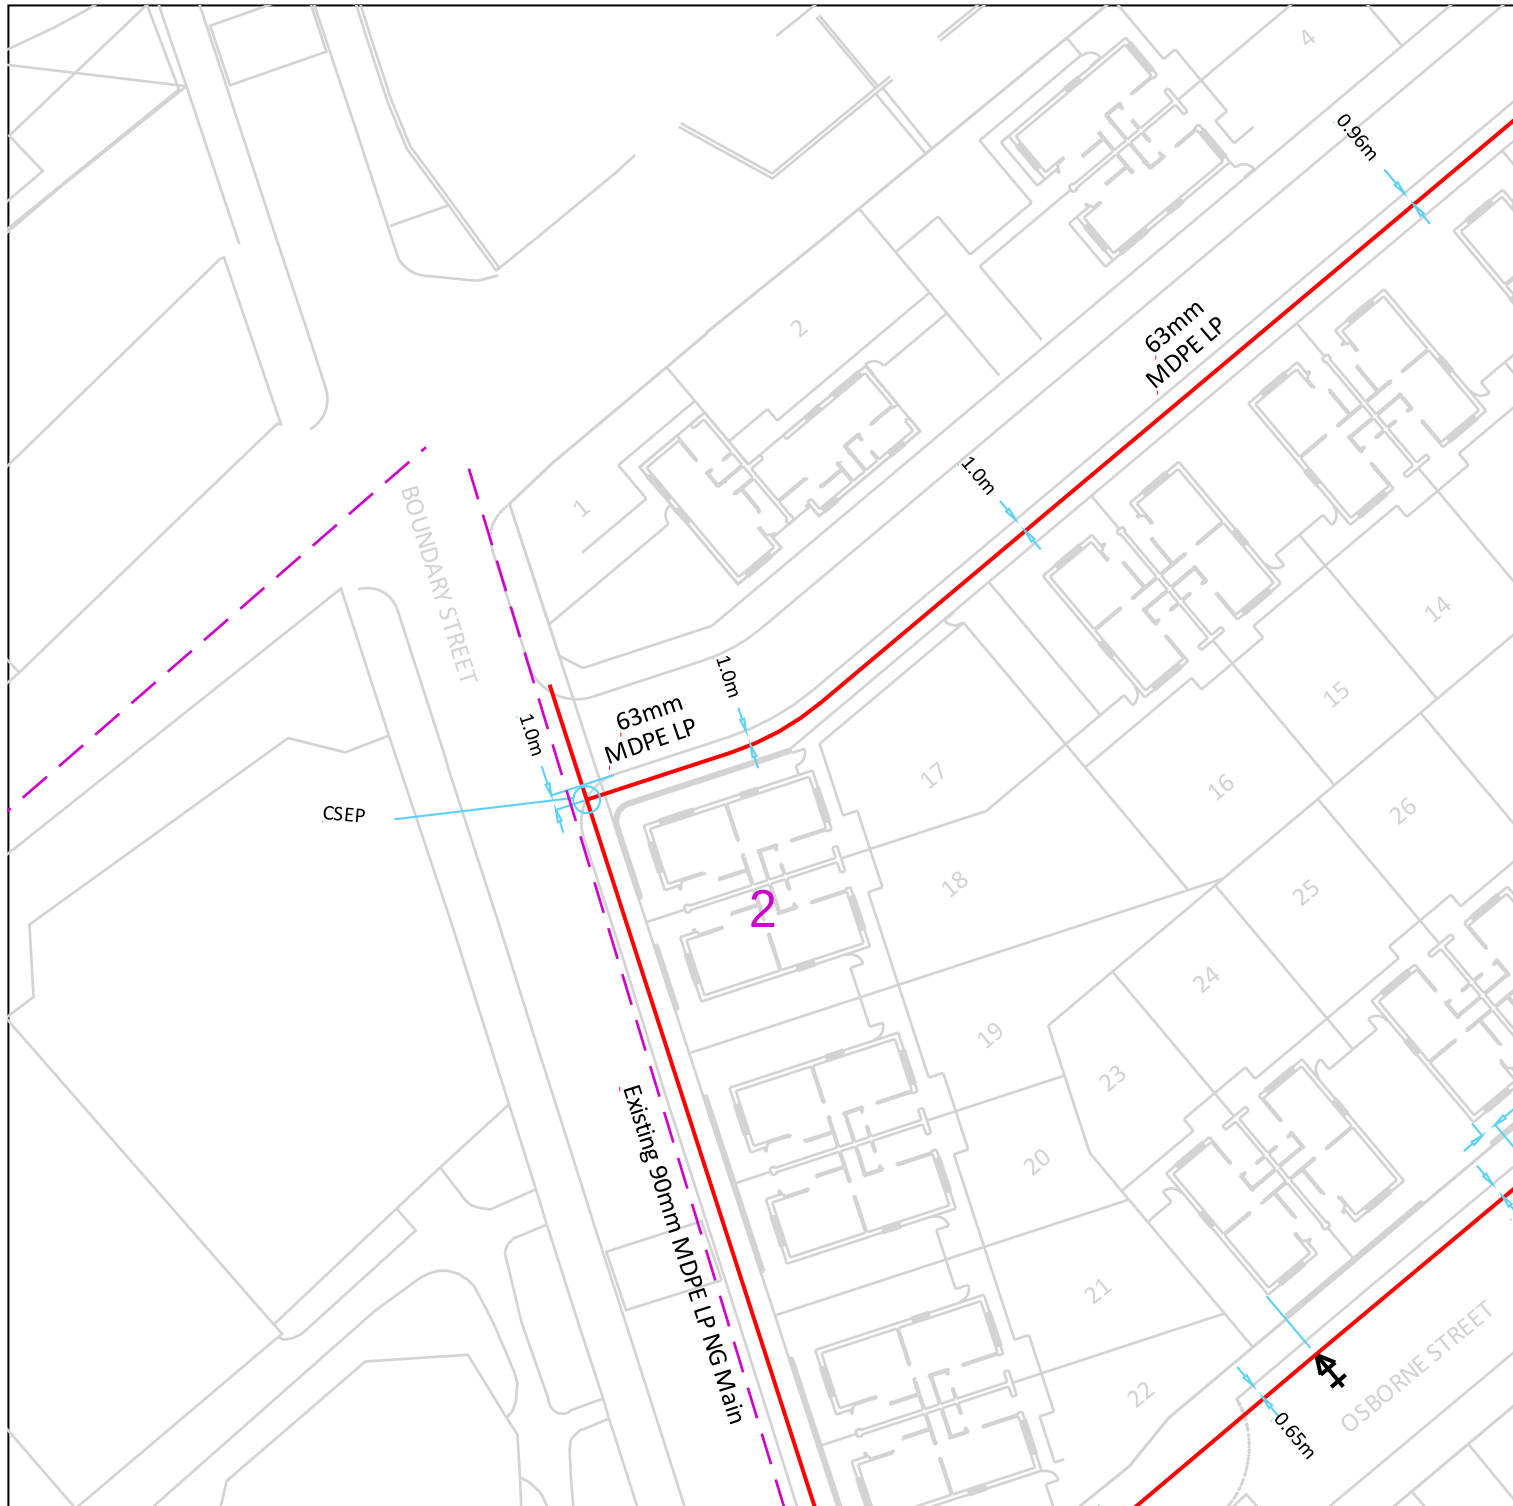

Last Mile Asset Management Limited
Fenick House, Lister Way
Hamilton International Technology Park
Glasgow G72 0FT
Telephone 03300 587 443

PROPOSED LP SERVICE
INSTALLED LP SERVICE
PROPOSED MP SERVICE
PROPOSED LP MAINS
INSTALLED LP MAINS
PROPOSED MP MAINS
PROPOSED IP MAINS
EXISTING/AS LAID LP SERVICE
EXISTING/AS LAID MP SERVICE
EXISTING/AS LAID LP MAINS
EXISTING/AS LAID MP MAINS
INSTALLED MP MAINS
EXISTING/AS LAID IP MAINS
EXISTING HP MAINS
DECOMMISSIONED PIPE

GAS KEY
PIPE TO BE DECOMMISSIONED
DIAMETER CHANGE
CAP END
VALVE
GAS METERBOX/KIOSK
GAS RISER
GAS METER
CATHODIC PROTECTION
PRESSURE REDUCTION INSTALLATION (P.R.I.)
MEDIUM PRESSURE SERVICE EXCESS FLOW VALVE
PRESSURE PROTECTION
RIDER PURGE POINT
PLOTS WITH CONNECTIONS OFF OTHER GT/EXISTING GAS NETWORKS

Dig Sites
Line: ---
Area: []

Date Requested: 23/01/2024
Job Reference: 32214546
Site Location: 389515 412131
Requested by: Miss Lauren Wenham
Your Scheme/Reference: STW6382

Scale: 1:500 (When plotted at A4)


This plan shows those pipes owned by Last Mile Gas Limited in their role as a Licensed Gas Transporter (GT). Gas pipes owned by other GTs, or otherwise privately owned (or, indeed, any other apparatus, equipment or infrastructure) may be present in this area. Information regarding such pipes (or any such other apparatus, equipment, or infrastructure) should be obtained from the relevant owners.

The information shown on these plans is provided for general information purposes only and should not be relied on or treated as a substitute for your own enquiries. We make no warranty, representation, or guarantee, whether express or implied, regarding the content of the plans or that the content is accurate, complete, or up to date. No liability of any kind whatsoever is accepted by Last Mile Asset Management Limited, or their agents, servants or contractors for any error, omission, or misstatement.


Safe digging practices, in accordance with HS(G)47, must be used to verify and establish the actual position of mains, pipes, services and other apparatus on site before any mechanical plant is used. It is your responsibility to ensure that this information is provided to all persons (either direct labour or contractors) working for you on or near gas apparatus. The information included on this plan should not be referred to beyond a period of 28 days from the date of issue.

In an emergency call 0800 111 999, 24 hours a day

Crown Copyright © - Reproduced by permission of Ordnance Survey on behalf of HMSO. And database right 2023. All rights reserved. Ordnance Survey Licence number 100061801

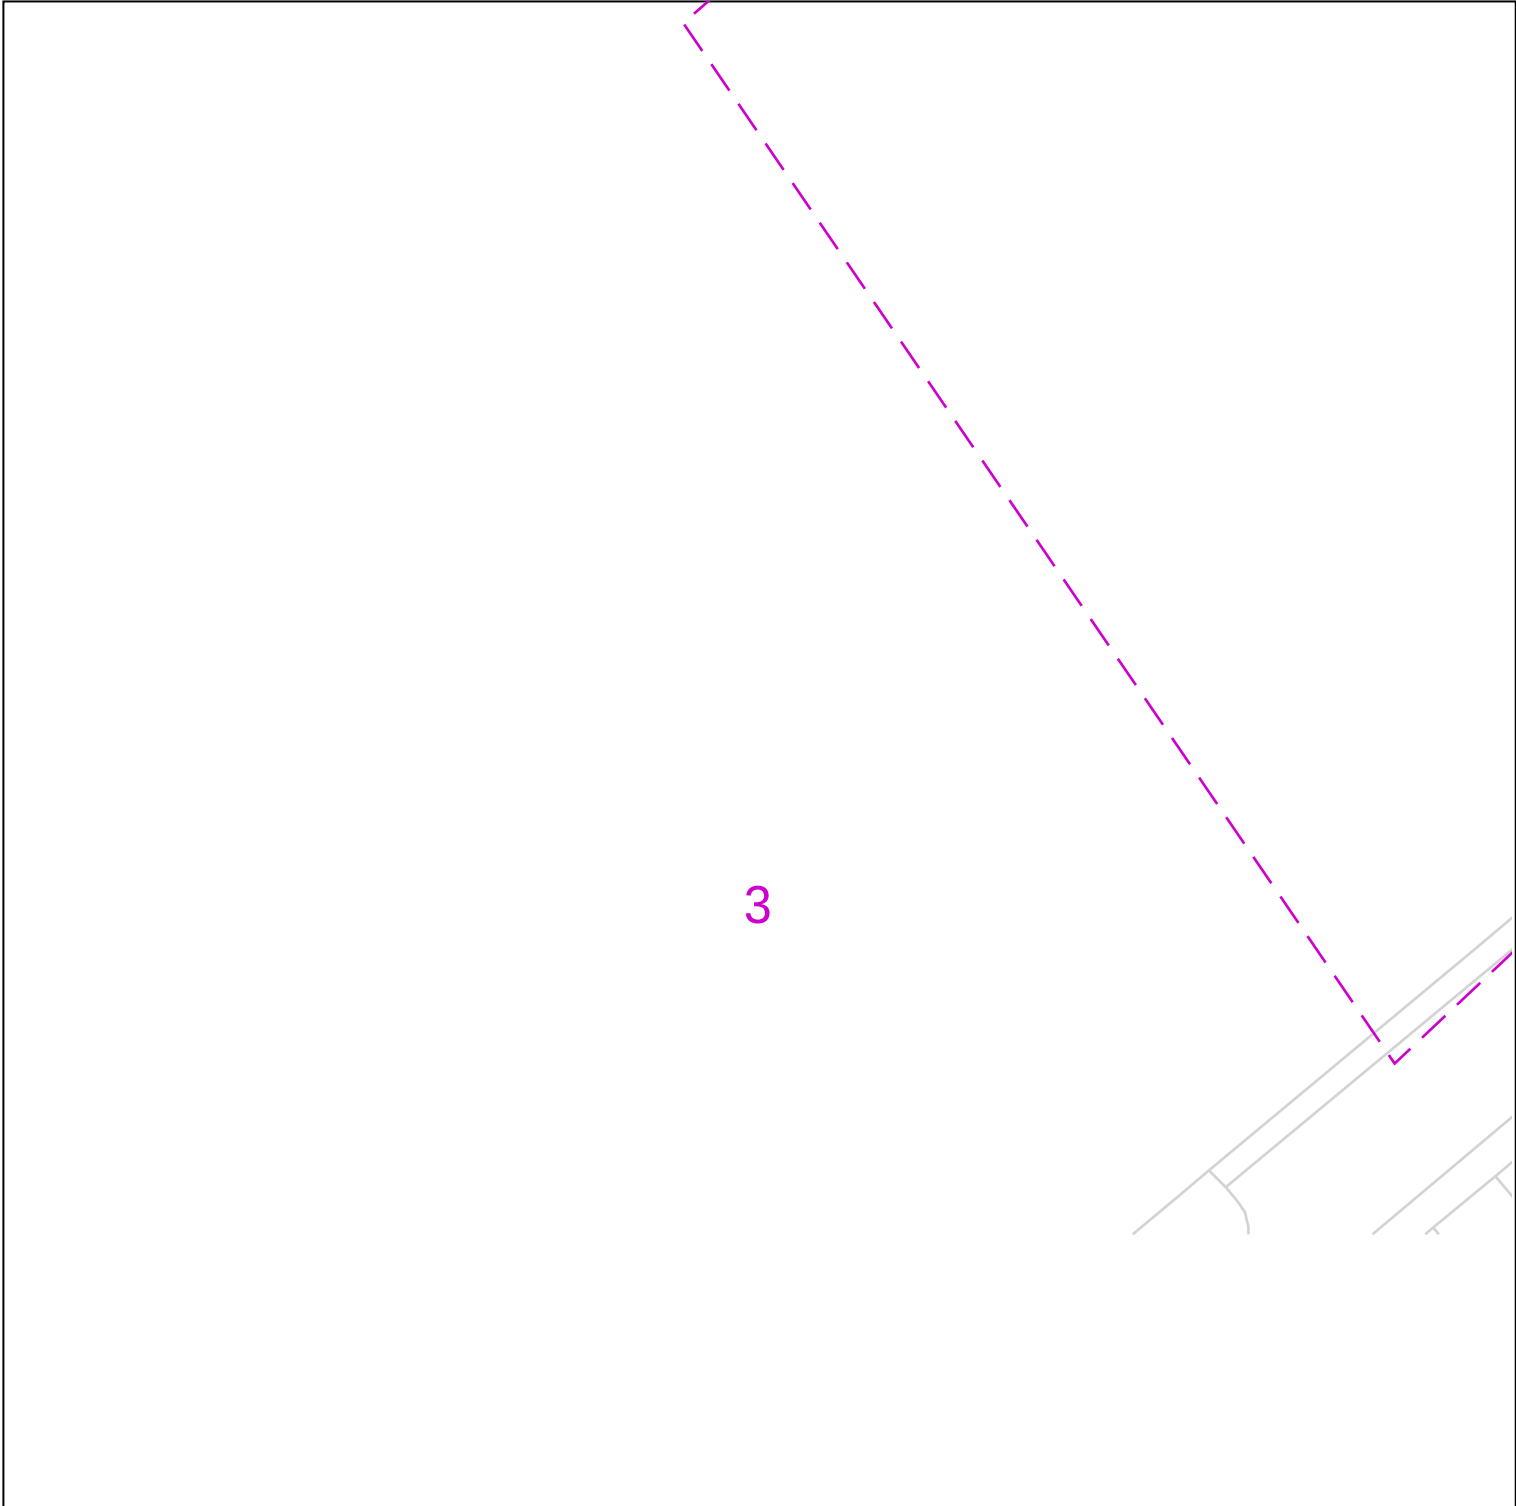

 Last Mile Asset Management Limited Fenick House, Lister Way Hamilton International Technology Park Glasgow G72 0FT Telephone 03300 587 443	PROPOSED LP SERVICE INSTALLED LP SERVICE PROPOSED MP SERVICE PROPOSED LP MAINS INSTALLED LP MAINS PROPOSED MP MAINS PROPOSED IP MAINS EXISTING/AS LAID LP SERVICE EXISTING/AS LAID MP SERVICE EXISTING/AS LAID LP MAINS EXISTING/AS LAID MP MAINS INSTALLED MP MAINS EXISTING/AS LAID IP MAINS EXISTING HP MAINS DECOMMISSIONED PIPE --- <
---	--

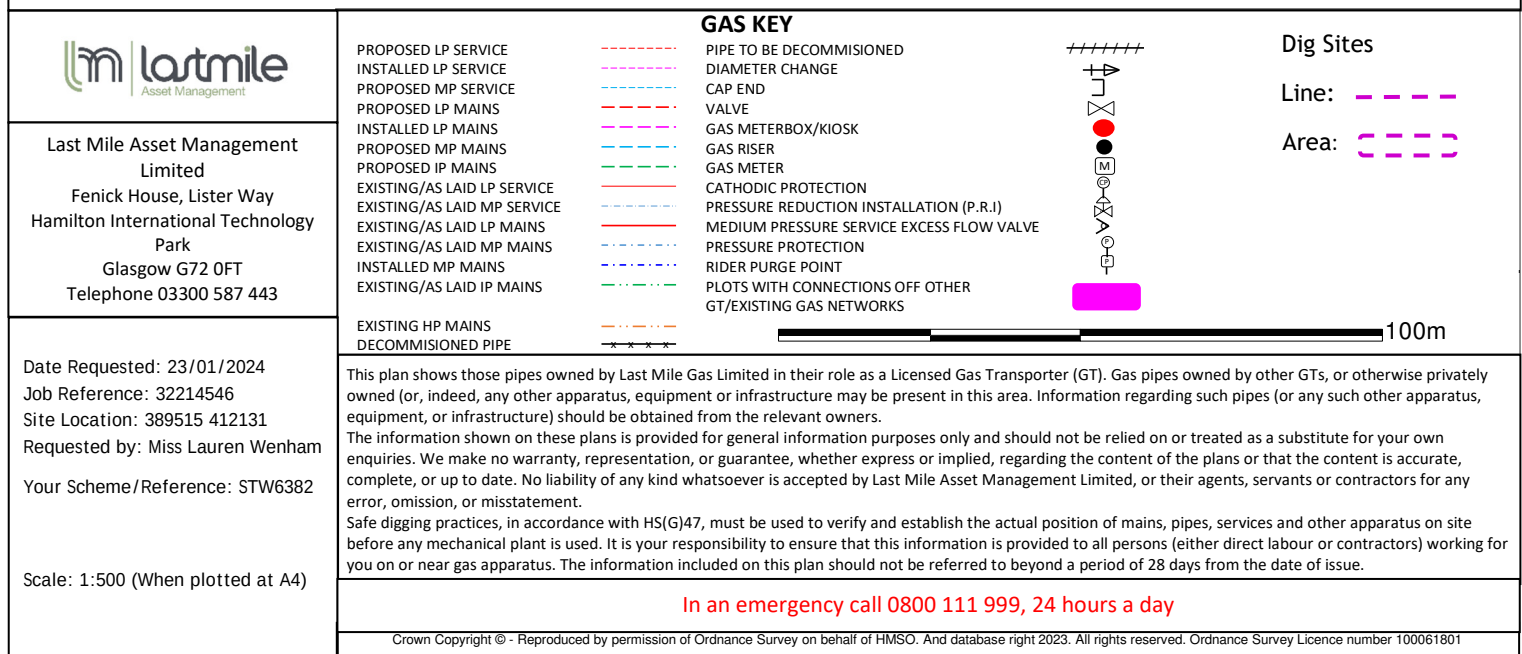

Overview map of worksite

1

3

4

Empress Close
OL11 MP1559

ASHFIELD ROAD



Last Mile Asset Management
Limited
Fenick House, Lister Way
Hamilton International Technology
Park
Glasgow G72 0FT
Telephone 03300 587 443

Date Requested: 23/01/2024
Job Reference: 32214546
Site Location: 389515 412131
Requested by: Miss Lauren Wenham
Your Scheme/Reference: STW6382

Scale: 1:1025 (When plotted at A4)

ELECTRIC KEY

PROPOSED LV SERVICE	---	LV STRAIGHT JOINT
PROPOSED LV	---	LV BREACH JOINT
PROPOSED HV	---	HV STRAIGHT JOINT
PROPOSED EHV (UG)	---	HV BREACH JOINT
EXISTING/AS LAID LV SERVICE	---	STREET LIGHTING C.P
EXISTING/AS LAID LV (UG)	---	MINI PILLAR
EXISTING/AS LAID HV (UG)	---	LINK BOX
EXISTING/AS LAID EHV (UG)	---	EARTH SPIKE
EXISTING LV OVERHEAD	---	POT END
EXISTING HV OVERHEAD	---	SERVICE JOINT
EXISTING EHV OVERHEAD	---	
PROPOSING DISCONNECTED	---	



Dig Sites

Line: ---


Area: ---

This plan shows cables owned by Last Mile Electricity Limited in their role as a Licensed Distributor (IDNO). Cables owned by other Distributors or privately owned cables (or, indeed, any other apparatus, equipment or infrastructure) may also be present in the area. Information regarding such cables (or any such other apparatus, equipment, or infrastructure) should be obtained from the relevant owners.


The information shown on these plans is provided for general information purposes only and should not be relied on or treated as a substitute for your own enquiries. We make no warranty, representation, or guarantee, whether express or implied, regarding the content of the plans or that the content is accurate, complete, or up to date. No liability of any kind whatsoever is accepted by Last Mile Asset Management Limited, or their agents, servants or contractors for any error, omission, or misstatement.

Safe digging practices, in accordance with HS(G)47, must be used to verify and establish the actual position of all electrical cables and apparatus on site before any mechanical plant is used. It is your responsibility to ensure that this information is provided to all persons on or near electrical cables or apparatus. The information included on this plan should not be referred to beyond a period of 3 months from the date of issue.

In an emergency call 105, 24 hours a day

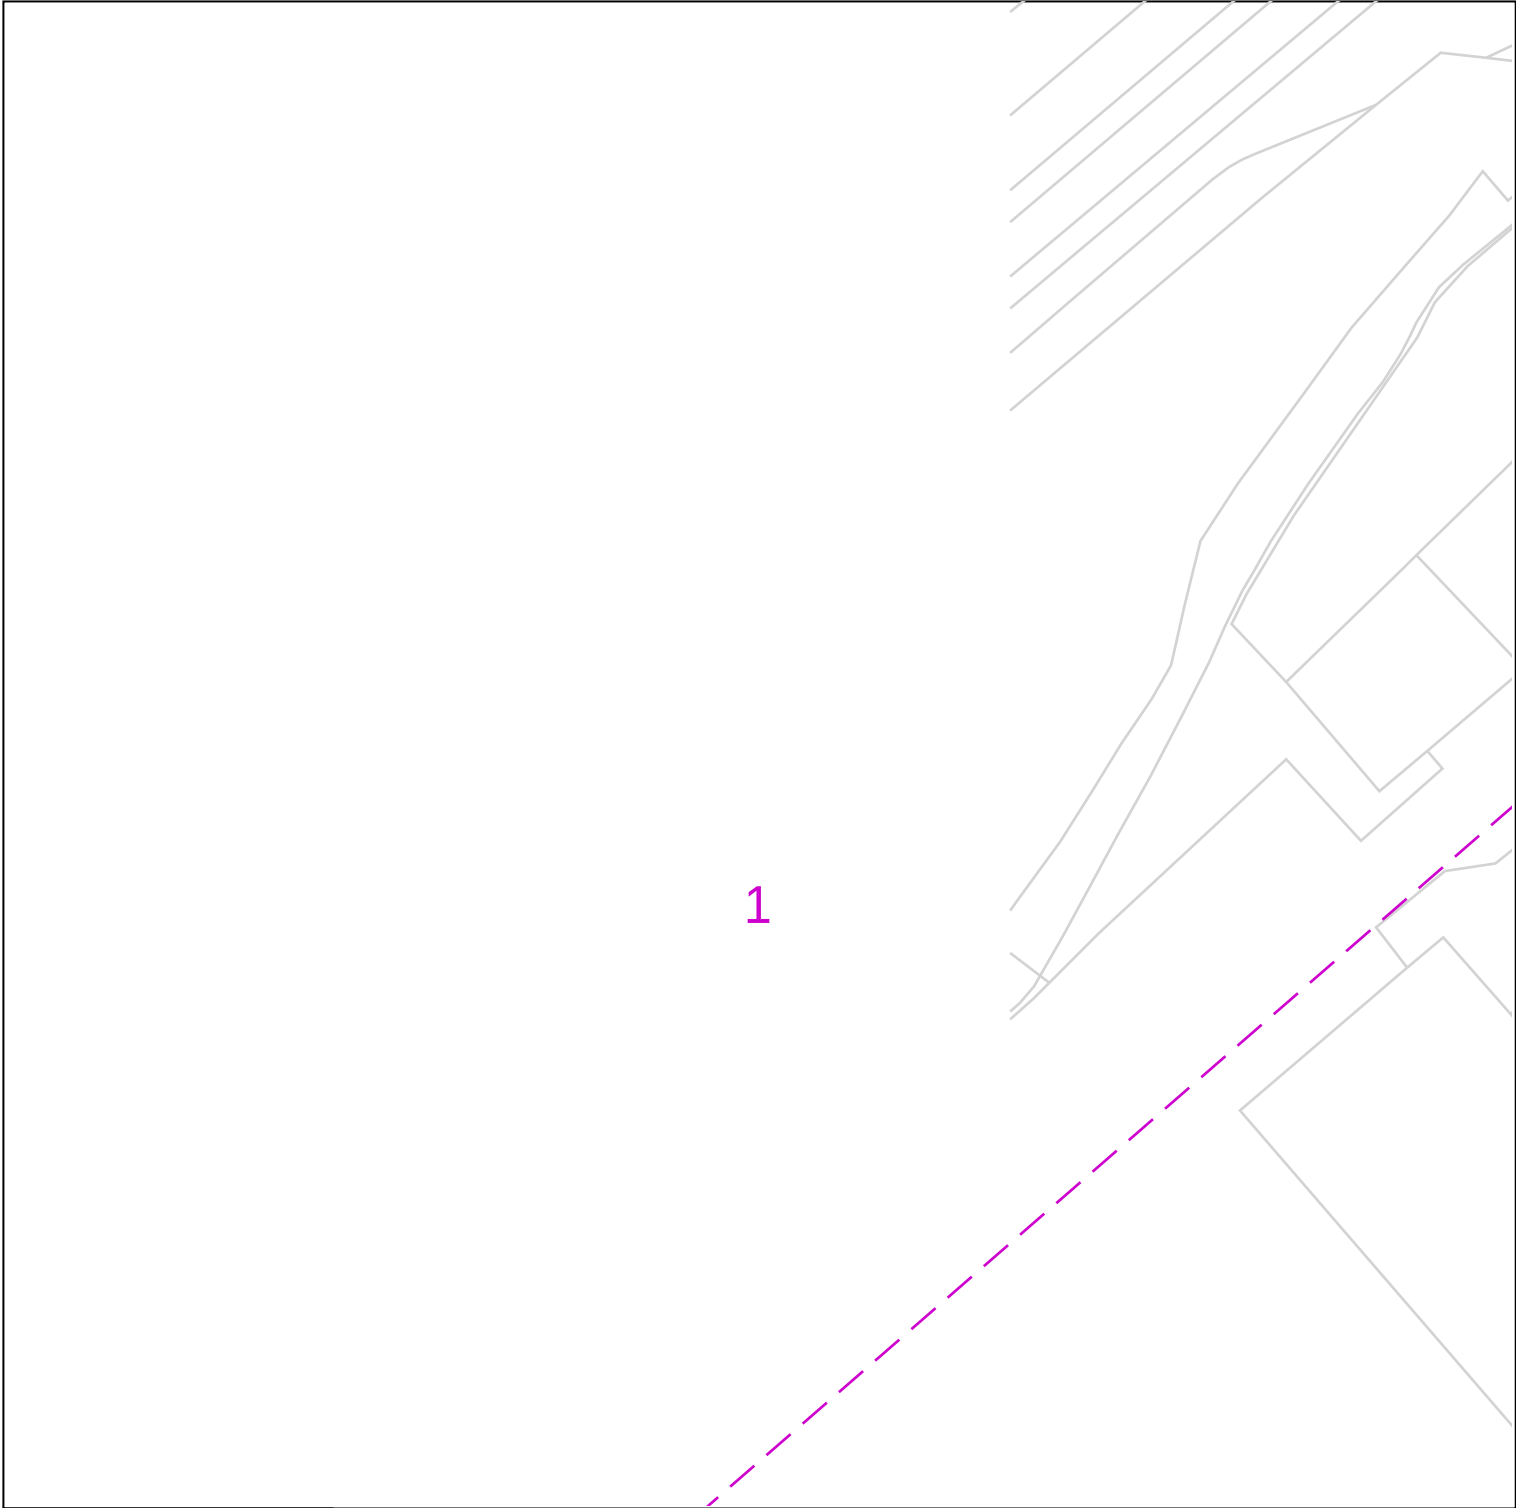

	PROPOSED LV SERVICE PROPOSED LV PROPOSED HV PROPOSED EHV (UG) EXISTING/AS LAID LV SERVICE EXISTING/AS LAID LV (UG) EXISTING/AS LAID HV (UG) EXISTING/AS LAID EHV (UG) EXISTING LV OVERHEAD EXISTING HV OVERHEAD EXISTING EHV OVERHEAD PROPOSING DISCONNECTED ----- ----- ----- ----- ----- ----- ----- ----- ----- ----- ----- ----- LV STRAIGHT JOINT LV BREACH JOINT HV STRAIGHT JOINT HV BREACH JOINT STREET LIGHTING C.P MINI PILLAR LINK BOX EARTH SPIKE POT END SERVICE JOINT Dig Sites Line: ----- Area: ----- Date Requested: 23/01/2024 Job Reference: 32214546 Site Location: 389515 412131 Requested by: Miss Lauren Wenham Your Scheme/Reference: STW6382 This plan shows cables owned by Last Mile Electricity Limited in their role as a Licensed Distributor (IDNO). Cables owned by other Distributors or privately owned cables (or, indeed, any other apparatus, equipment or infrastructure) may also be present in the area. Information regarding such cables (or any such other apparatus, equipment, or infrastructure) should be obtained from the relevant owners. The information shown on these plans is provided for general information purposes only and should not be relied on or treated as a substitute for your own enquiries. We make no warranty, representation, or guarantee, whether express or implied, regarding the content of the plans or that the content is accurate, complete, or up to date. No liability of any kind whatsoever is accepted by Last Mile Asset Management Limited, or their agents, servants or contractors for any error, omission, or misstatement. Safe digging practices, in accordance with HS(G)47, must be used to verify and establish the actual position of all electrical cables and apparatus on site before any mechanical plant is used. It is your responsibility to ensure that this information is provided to all persons on or near electrical cables or apparatus. The information included on this plan should not be referred to beyond a period of 3 month from the date of issue. In an emergency call 105, 24 hours a day Crown Copyright © - Reproduced by permission of Ordnance Survey on behalf of HMSO. And database right 2023. All rights reserved. Ordnance Survey Licence number 100061801
--	---

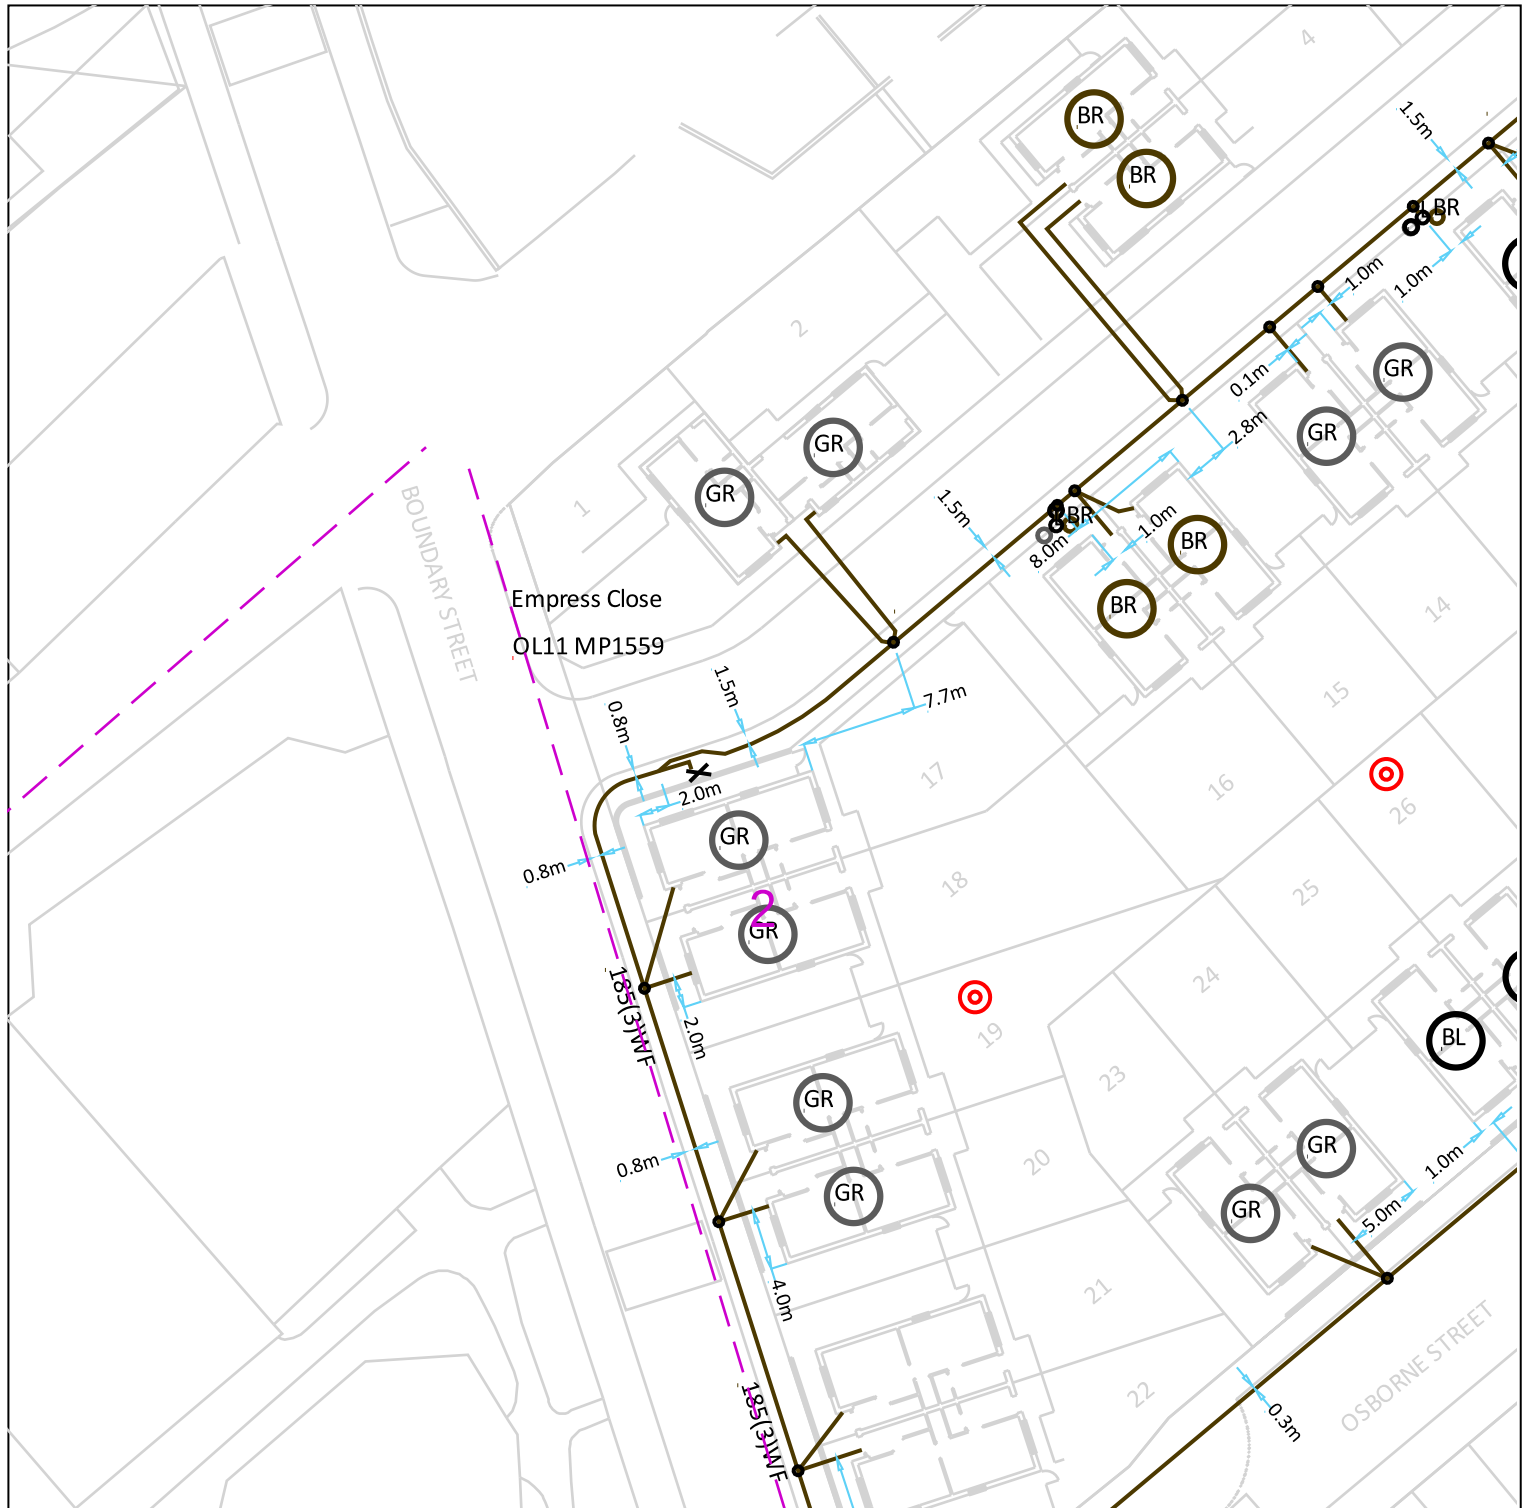

Last Mile Asset Management
Limited
Fenick House, Lister Way
Hamilton International Technology
Park
Glasgow G72 0FT
Telephone 03300 587 443

Date Requested: 23/01/2024
Job Reference: 32214546
Site Location: 389515 412131
Requested by: Miss Lauren Wenham
Your Scheme/Reference: STW6382

Scale: 1:500 (When plotted at A4)

ELECTRIC KEY

PROPOSED LV SERVICE	-----	LV STRAIGHT JOINT
PROPOSED LV	-----	LV BREACH JOINT
PROPOSED HV	-----	HV STRAIGHT JOINT
PROPOSED EHV (UG)	-----	HV BREACH JOINT
EXISTING/AS LAID LV SERVICE	-----	STREET LIGHTING C.P
EXISTING/AS LAID LV (UG)	-----	MINI PILLAR
EXISTING/AS LAID HV (UG)	-----	LINK BOX
EXISTING/AS LAID EHV (UG)	-----	EARTH SPIKE
EXISTING LV OVERHEAD	-----	POT END
EXISTING HV OVERHEAD	-----	SERVICE JOINT
EXISTING EHV OVERHEAD	-----	
PROPOSING DISCONNECTED	-----	



Dig Sites

Line: -----

Area: -----


100m

This plan shows cables owned by Last Mile Electricity Limited in their role as a Licensed Distributor (IDNO). Cables owned by other Distributors or privately owned cables (or, indeed, any other apparatus, equipment or infrastructure) may also be present in the area. Information regarding such cables (or any such other apparatus, equipment, or infrastructure) should be obtained from the relevant owners.

The information shown on these plans is provided for general information purposes only and should not be relied on or treated as a substitute for your own enquiries. We make no warranty, representation, or guarantee, whether express or implied, regarding the content of the plans or that the content is accurate, complete, or up to date. No liability of any kind whatsoever is accepted by Last Mile Asset Management Limited, or their agents, servants or contractors for any error, omission, or misstatement.

Safe digging practices, in accordance with HS(G)47, must be used to verify and establish the actual position of all electrical cables and apparatus on site before any mechanical plant is used. It is your responsibility to ensure that this information is provided to all persons on or near electrical cables or apparatus. The information included on this plan should not be referred to beyond a period of 3 months from the date of issue.

In an emergency call 105, 24 hours a day

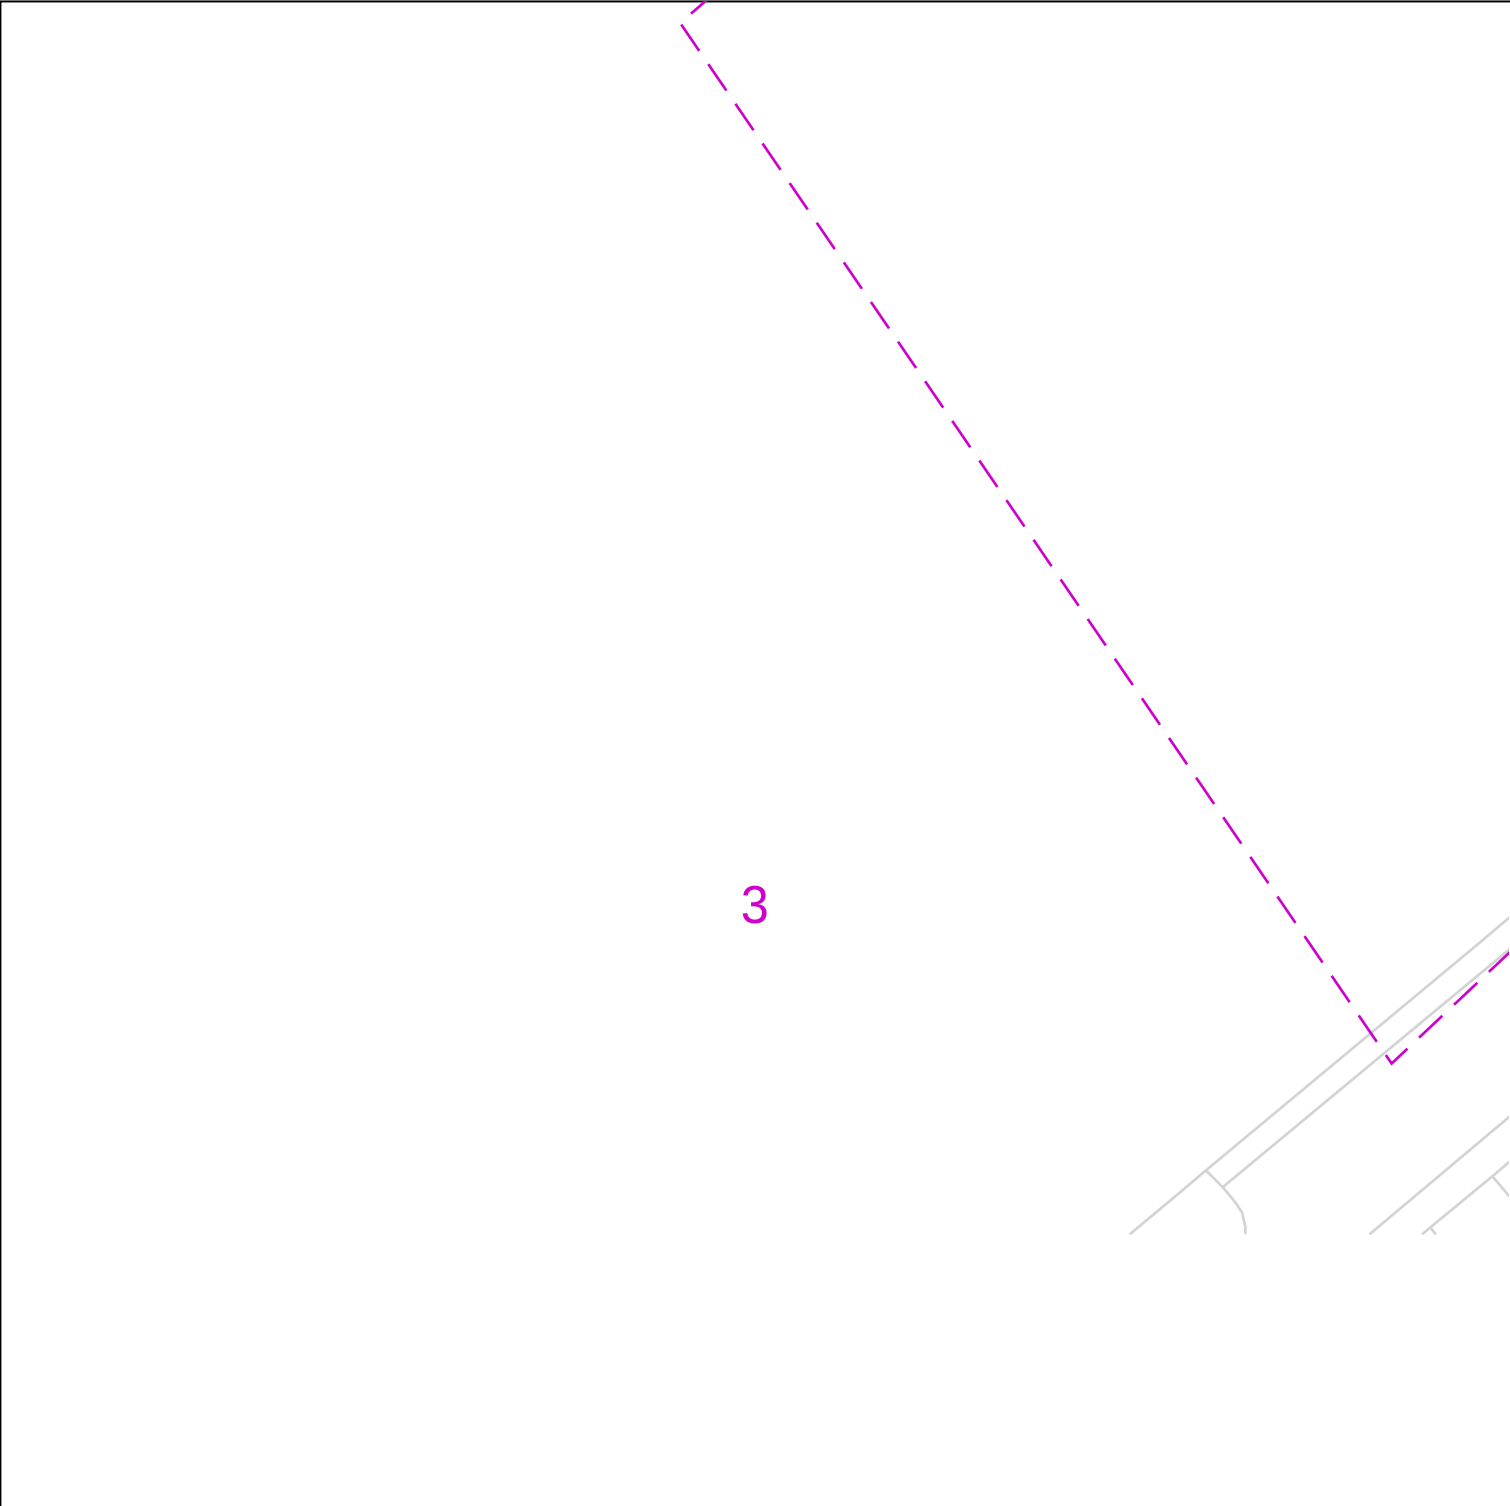



Last Mile Asset Management Limited

Fenick House, Lister Way

Hamilton International Technology Park

Glasgow G72 0FT

Telephone 03300 587 443

Date Requested: 23/01/2024

Job Reference: 32214546

Site Location: 389515 412131

Requested by: Miss Lauren Wenham

Your Scheme/Reference: STW6382

Scale: 1:500 (When plotted at A4)

PROPOSED LV SERVICE

PROPOSED LV

PROPOSED HV

PROPOSED EHV (UG)

EXISTING/AS LAID LV SERVICE

EXISTING/AS LAID LV (UG)

EXISTING/AS LAID HV (UG)

EXISTING/AS LAID EHV (UG)

EXISTING LV OVERHEAD

EXISTING HV OVERHEAD

EXISTING EHV OVERHEAD

PROPOSING DISCONNECTED

LV STRAIGHT JOINT

LV BREACH JOINT

HV STRAIGHT JOINT

HV BREACH JOINT

STREET LIGHTING C.P

MINI PILLAR

LINK BOX

EARTH SPIKE

POT END

SERVICE JOINT

Dig Sites

Line: -----

Area: -----

100m


This plan shows cables owned by Last Mile Electricity Limited in their role as a Licensed Distributor (IDNO). Cables owned by other Distributors or privately owned cables (or, indeed, any other apparatus, equipment or infrastructure may also be present in the area. Information regarding such cables (or any such other apparatus, equipment, or infrastructure) should be obtained from the relevant owners.

The information shown on these plans is provided for general information purposes only and should not be relied on or treated as a substitute for your own enquiries. We make no warranty, representation, or guarantee, whether express or implied, regarding the content of the plans or that the content is accurate, complete, or up to date. No liability of any kind whatsoever is accepted by Last Mile Asset Management Limited, or their agents, servants or contractors for any error, omission, or misstatement.

Safe digging practices, in accordance with HS(G)47, must be used to verify and establish the actual position of all electrical cables and apparatus on site before any mechanical plant is used. It is your responsibility to ensure that this information is provided to all persons on or near electrical cables or apparatus. The information included on this plan should not be referred to beyond a period of 3 month from the date of issue.

In an emergency call 105, 24 hours a day

Crown Copyright © - Reproduced by permission of Ordnance Survey on behalf of HMSO. And database right 2023. All rights reserved. Ordnance Survey Licence number 100061801

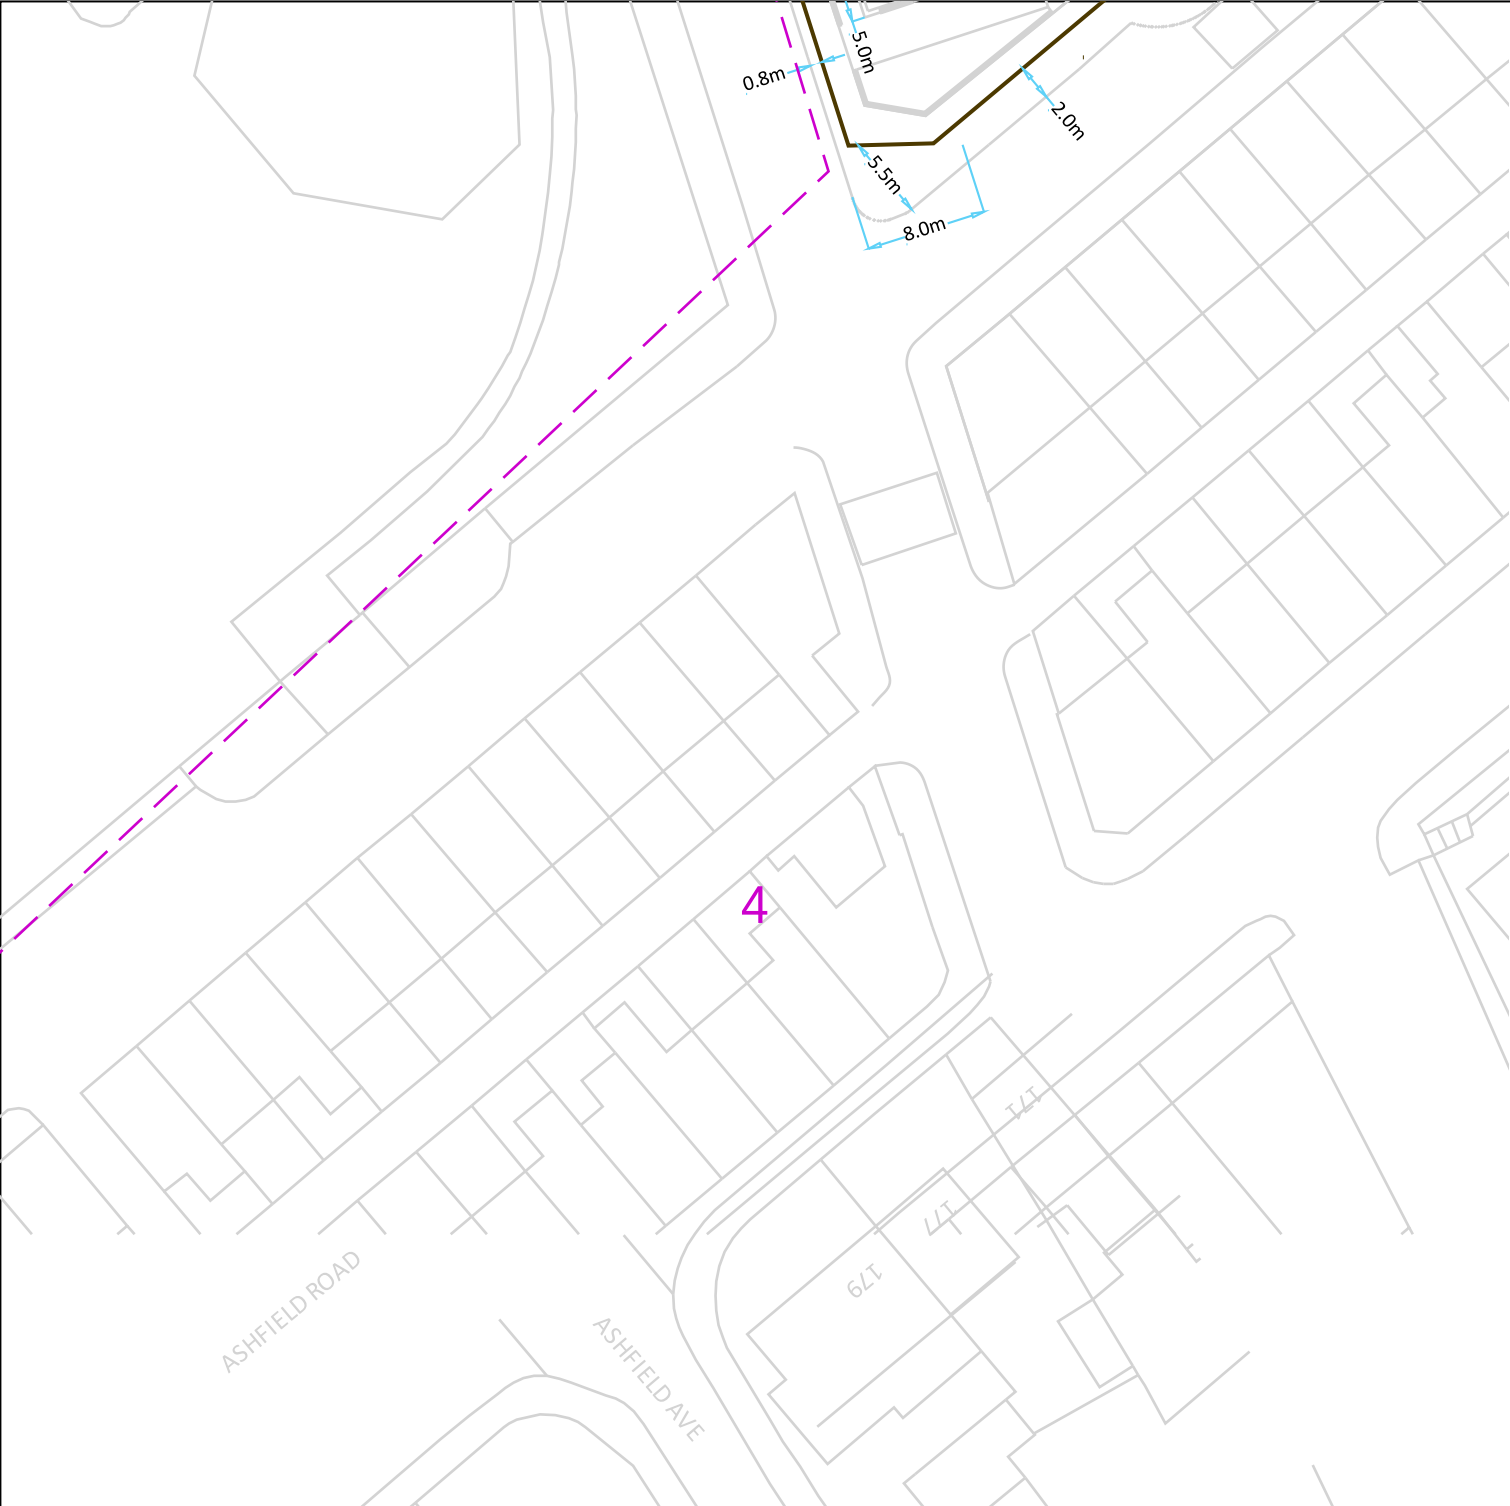



Last Mile Asset Management
Fenick House, Lister Way
Hamilton International Technology Park
Glasgow G72 0FT
Telephone 03300 587 443

Date Requested: 23/01/2024
Job Reference: 32214546
Site Location: 389515 412131
Requested by: Miss Lauren Wenham
Your Scheme/Reference: STW6382

Scale: 1:500 (When plotted at A4)

ELECTRIC KEY

PROPOSED LV SERVICE	-----	LV STRAIGHT JOINT
PROPOSED LV	-----	LV BREACH JOINT
PROPOSED HV	-----	HV STRAIGHT JOINT
PROPOSED EHV (UG)	-----	HV BREACH JOINT
EXISTING/AS LAID LV SERVICE	-----	STREET LIGHTING C.P
EXISTING/AS LAID LV (UG)	-----	MINI PILLAR
EXISTING/AS LAID HV (UG)	-----	LINK BOX
EXISTING/AS LAID EHV (UG)	-----	EARTH SPIKE
EXISTING LV OVERHEAD	-----	POT END
EXISTING HV OVERHEAD	-----	SERVICE JOINT
EXISTING EHV OVERHEAD	-----	
PROPOSING DISCONNECTED	-----	

Dig Sites

Line: -----

Area: -----



This plan shows cables owned by Last Mile Electricity Limited in their role as a Licensed Distributor (IDNO). Cables owned by other Distributors or privately owned cables (or, indeed, any other apparatus, equipment or infrastructure) may also be present in the area. Information regarding such cables (or any such other apparatus, equipment, or infrastructure) should be obtained from the relevant owners.

The information shown on these plans is provided for general information purposes only and should not be relied on or treated as a substitute for your own enquiries. We make no warranty, representation, or guarantee, whether express or implied, regarding the content of the plans or that the content is accurate, complete, or up to date. No liability of any kind whatsoever is accepted by Last Mile Asset Management Limited, or their agents, servants or contractors for any error, omission, or misstatement.

Safe digging practices, in accordance with HS(G)47, must be used to verify and establish the actual position of all electrical cables and apparatus on site before any mechanical plant is used. It is your responsibility to ensure that this information is provided to all persons on or near electrical cables or apparatus. The information included on this plan should not be referred to beyond a period of 3 months from the date of issue.

In an emergency call 105, 24 hours a day

Crown Copyright © - Reproduced by permission of Ordnance Survey on behalf of HMSO. And database right 2023. All rights reserved. Ordnance Survey Licence number 100061801

Enquirer

Name	Miss Lauren Wenham	Phone	01604 781877
Company	Soiltechnics Ltd	Mobile	Not Supplied
Address	Cedar Barn Cedar Barn White Lodge Walgrave Northamptonshire NN6 9PY		
Email	admin@soiltechnics.net		

Enquiry Details

Enquiry type	Planned Works
Work category	Development Projects
Work type	Commercial/industrial
Work type buffer*	75 metres
Start date	24/01/2024
End date	24/01/2024
Scheme/Reference	STW6382
Search location	OL111QU
Confirmed location	-02 54
Site size	0 metres square
Site Contact Name	Admin Soiltechnics
Site Phone No.	01604781877
Description of Works	NA

* The WORK TYPE BUFFER is a distance added to your search area based on the Work type you have chosen.

Site Map



Please note that the above map only displays the location of the proposed work site and will not display any of the Members' pipes and cables. It is imperative that this area accurately reflects the proposed work site.

Affected LSBUD members

(LSBUD Members who have assets registered on LSBUD within the vicinity of your search area.)

Asset Owner	Phone/Email	Emergency Only	Status
Cadent Gas	0800688588	0800111999	Await response
Electricity North West Limited	08001954141	08001954141	Await response
Last Mile	plantenquiries@lastmile-uk.com	0800111999	Await response

Status explanation

Await Response means that the asset owner will contact you. This is typically by sending the plan response but they may ask for further information before being able to do so, particularly if any payments or authorisations are required.

Email Additional Info means that the asset owner needs further information about your works to assess your enquiry before providing a response. Please provide any details you have available including plans, method statements etc. if available.

Important notices

It is very important that you correctly understand what the service does and the procedures in order for you to work safely. Please refer to the LSBUD Support Page (www.lsbud.co.uk/lineasearchbeforeudig-support) for further guidance.

This information includes how to provide additional information to the LSBUD Members who request it to provide a response to your enquiry.

Validity and search criteria. The results of this enquiry are based on the confirmed information you entered and are valid only as at the date and time of the enquiry. It is your responsibility to ensure that the Enquiry Details are correct, and LineasearchbeforeUdig (LSBUD) accepts no responsibility for any errors or omissions in the Enquiry Details or any consequences thereof. LSBUD Members update their asset information on a regular basis so you are advised to consider this when undertaking any works. It is your responsibility to choose the period of time after which you need to resubmit any enquiry but the maximum time (after which your enquiry will no longer be dealt with by the LSBUD Helpdesk and LSBUD Members) is 28 days. If any details of the enquiry change, particularly including, but not limited to, the location of the work, then a further enquiry must be made.

Terms and Conditions. Please note that this enquiry is subject always to our standard terms and conditions available at www.lsbud.co.uk ("Terms of Use") and the disclaimer at the end of this document. Please note that in the event of any conflict or ambiguity between the terms of this Enquiry Confirmation and the Terms of Use, the Terms of Use shall take precedence.

List of not affected LSBUD members (LSBUD Members who do not have assets registered on the LSBUD service within the vicinity of your search area.)

Angus Energy	AWE Pipeline	B & D Energy Limited
Balfour Beatty Investments Limited	BOC Limited (A Member of the Linde Group)	Box Broadband
BP Exploration Operating Company Limited	BPA	Cambridgeshire County Council Climate Change and Energy Services
CATS Pipeline c/o Wood Group PSN	Cemex	Centrica Storage Ltd
CNG Services Ltd	Concept Solutions People Ltd	ConocoPhillips (UK) Teesside Operator Ltd
D.S.Smith	Diamond Transmission Corporation	DIO (MOD Abandoned Pipelines)
DIO (MOD Live Pipelines)	Drax Power Limited	E.ON UK CHP Limited
EDF Energy Renewables Ltd	EirGrid	Eleclink Limited
Energy Assets Networks	ENI & Himor c/o Penspen Ltd	EnQuest NNS Limited
EP Langage Limited	ESB CCGT Power station (Carrington Gas Pipeline)	ESP Utilities Group
ESSAR	Esso Petroleum Company Limited	euNetworks Fiber UK Ltd
EXA Infrastructure	Exolum Pipeline System	Fulcrum Electricity Assets Limited
Fulcrum Pipelines Limited	Gamma	Gas Networks Ireland (UK)
Gateshead Energy Company	Gigaclear Ltd	Harbour Energy
Heathrow Airport LTD	Humbly Grove Energy	IGas Energy
INEOS FPS Pipelines	INEOS Manufacturing (Scotland and TSEP)	INOVYN ChlorVinyls Limited
INOVYN Enterprises Limited	Intergen (Coryton Energy or Spalding Energy)	Jurassic Fibre Ltd
Kensa Utilities	Mainline Pipelines Limited	Manchester Jetline Limited
Manx Cable Company	Marchwood Power Ltd (Gas Pipeline)	Melbourn Solar Limited
MUA Group Limited	National Gas Transmission	National Grid Electricity Distribution
National Grid Electricity Transmission	National Grid Ventures	Neos Networks
Northern Gas Networks Limited	Northumbrian Water Group	NPower CHP Pipelines
NTT Global Data Centers EMEA UK Ltd	NYnet Ltd	Ogi
Oikos Storage Limited	Ørsted	Palm Paper Ltd
Perenco UK Limited (Purbeck Southampton Pipeline)	Petroineos	Phillips 66
Portsmouth Water	Premier Transmission Ltd (SNIP)	Redundant Pipelines - LPDA
RWE - Great Yarmouth Pipeline (Bacton to Great Yarmouth Power Station)	RWEnpower (Little Barford and South Haven)	SABIC UK Petrochemicals
SAS Utility Services Ltd	Scottish and Southern Electricity Networks	Scottish Power Generation
Seabank Power Ltd	SES Water	SGN
Shell	Shell NOP	SP Energy Networks
Spring Fibre Limited	Squire Energy Networks	SSE Generation Ltd
SSE Transmission	SSE Utility Solutions Limited	Storengy

Tata Communications (c/o JSM Construction Ltd)	TfL – London Underground HV Cables (Road Side Cables)	Total Colnbrook Pipelines
Total Finaline Pipelines	Transmission Capital	Trojan Energy Limited
UK Power Networks	Uniper UK Ltd	University of Cambridge Granta Backbone Network
Vattenfall	Veolia ES SELCHP Limited	Veolia ES Sheffield Ltd
Voneus Limited	VPI Power Limited	Wales and West Utilities
West of Duddon Sands Transmission Ltd	West Sussex OpenNetwork (Cooperative National Infrastructure)	Westminster City Council
Zayo Group UK Ltd c/o JSM Group Ltd		

Non-LSBUD members (Asset owners not registered on LSBUD)

(The following Non-LSBUD Members may have assets in your search area. It is YOUR RESPONSIBILITY to contact them before proceeding.

Please be aware this list is not exhaustive and it is your responsibility to identify and contact all asset owners within your search area.)


Asset Owner	Preferred contact method	Phone	Status
BT	https://www.swns.bt.com/pls/mbe/welcome.home	08000232023	Not Notified
CityFibre	asset.team@cityfibre.com	033 3150 7282	Not Notified
Colt	plantenquiries@catelecomuk.com	01227768427	Not Notified
Equans	nrsua.uk@equans.com	0800 130 3600	Not Notified
GTC	https://pe.gtc-uk.co.uk/PlantEnqMembership	01359240363	Not Notified
Lumen Technologies	plantenquiries@ocugroup.com	02087314613	Not Notified
Mobile Broadband Network Limited	mbnl.plant.enquiries@turntown.com	01212 621 100	Not Notified
Network Rail	OPBuriedServicesEnquiries@networkrail.co.uk	01904523401	Not Notified
Sky UK Limited	nrsua@sky.uk	02070323234	Not Notified
Sota	sota.plantenquiries@ocugroup.com		Not Notified
United Utilities	WastewaterDeveloperServices@uuplc.co.uk	08707510101	Not Notified
Utility assets Ltd	assetrecords@utilityassets.co.uk		Not Notified
Verizon Business	osp-team@uk.verizonbusiness.com	01293611736	Not Notified
Virgin Media	http://www.digdat.co.uk	08708883116	Not Notified
Vodafone	osm.enquiries@atkinsglobal.com	01454662881	Not Notified

Disclaimer

Please refer to LSBUD's Terms of Use for full terms of use available at www.lsbud.co.uk

The results of this Enquiry are personal to the Enquirer and shall not be shared with or relied upon by any other party. The asset information on which the Enquiry results are based has been provided by LSBUD Members, therefore LSBUD will provide no guarantee that such information is accurate or reliable nor does it monitor such asset information for accuracy and reliability going forward. There may also be asset owners which do not participate in the enquiry service operated by LSBUD, including but not exclusively those set out above. Therefore, LSBUD cannot make any representation or give any guarantee or warranty as to the completeness of the information contained in the enquiry results or accept any responsibility for the accuracy of the mapping images used. LSBUD and its employees, agents and consultants accept no liability (save that nothing in this Enquiry Confirmation excludes or limits our liability for death or personal injury arising from our negligence, or our fraud or fraudulent misrepresentation, or any other liability that cannot be excluded or limited by English law) arising in respect thereof or in any other way for errors or omissions including responsibility to any person by reason of negligence.

Maps by email Plant Information Reply

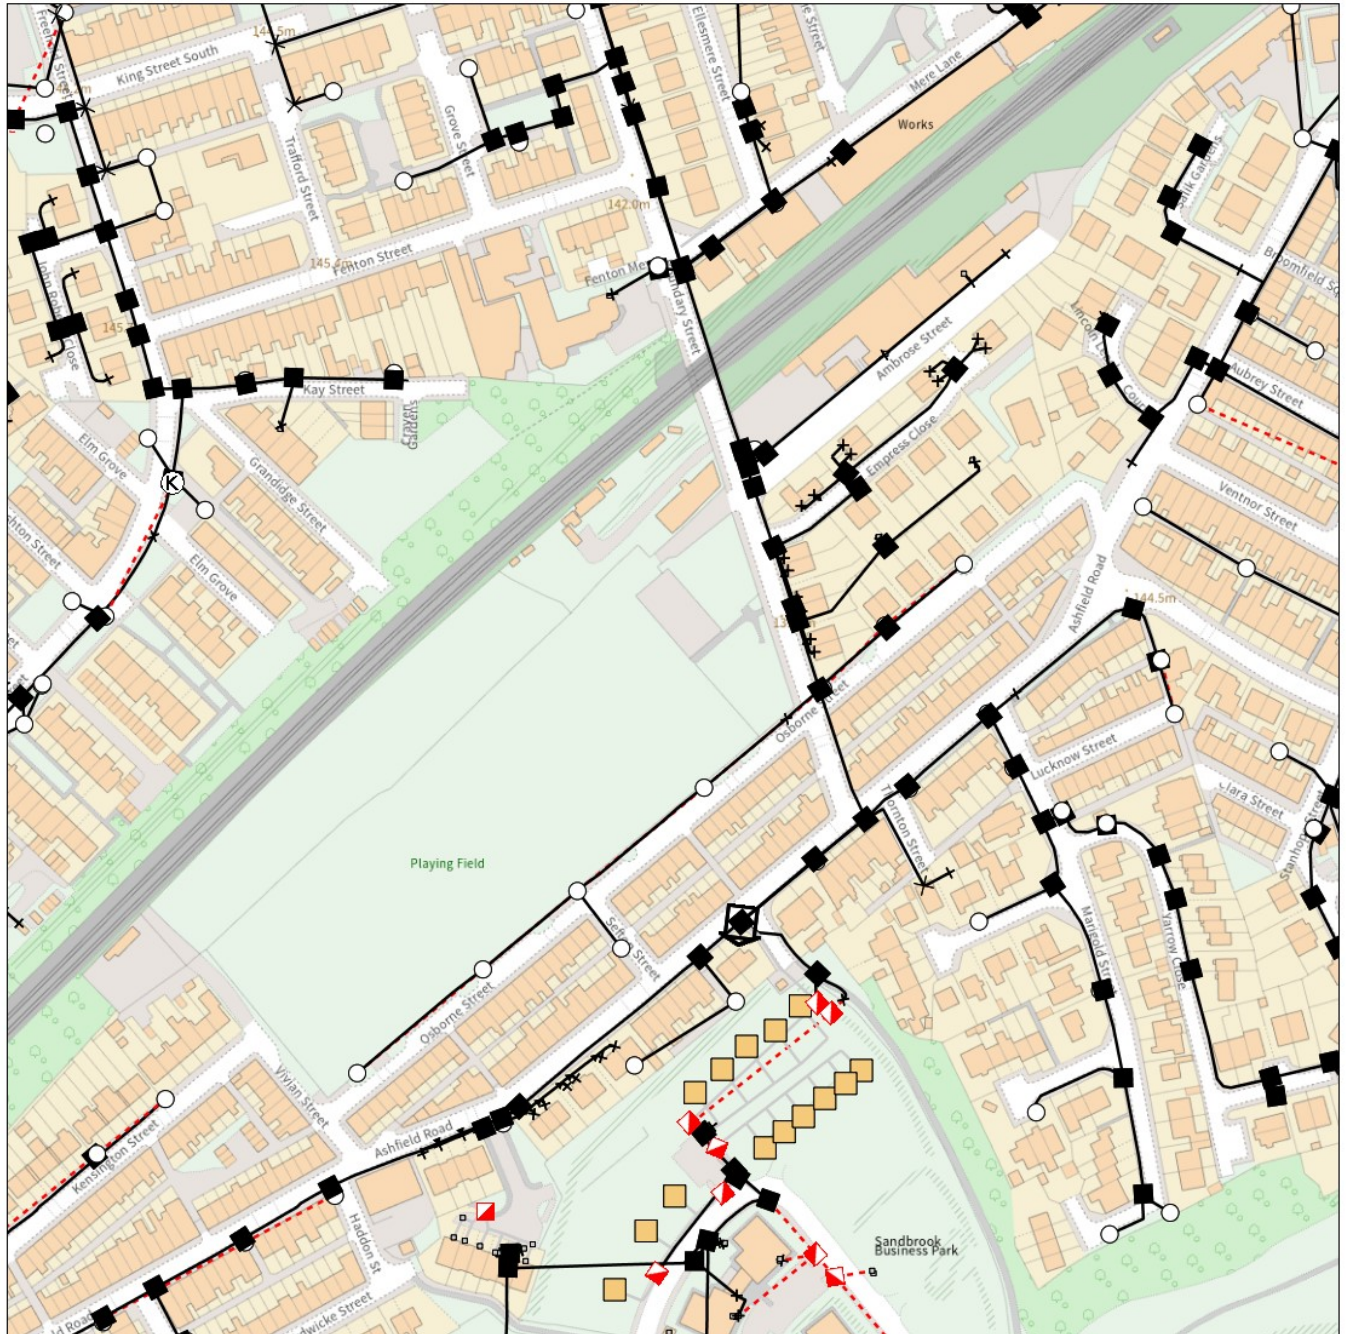

IMPORTANT WARNING

Information regarding the location of BT apparatus is given for your assistance and is intended for general guidance only. No guarantee is given of its accuracy. It should not be relied upon in the event of excavations or other works being made near to BT apparatus which may exist at various depths and may deviate from the marked route.



openreach

CLICK BEFORE YOU DIG

FOR PROFESSIONAL FREE ON SITE ASSISTANCE PRIOR TO COMMENCEMENT OF EXCAVATION WORKS INCLUDING LOCATE AND MARKING SERVICE

email cbyd@openreach.co.uk

ADVANCE NOTICE REQUIRED
(Office hours: Monday - Friday 08.00 to 17.00)
www.openreach.co.uk/cbyd

Accidents happen

If you do damage any Openreach equipment please let us know by calling 0800 023 2023 (opt 1 + opt 1) and we can get it fixed ASAP

KEY TO BT SYMBOLS

	Planned	Live	Change Of State	+	Hatchings	
PCP			Split Coupling		Built	
Pole			Duct Tee		Planned	
Box			Building		Inferred	
Manhole			Kiosk		Duct	
Cabinet			Other proposed plant is shown using dashed lines. BT Symbols not listed above may be disregarded. Existing BT Plant may not be recorded. Information valid at time of preparation. Maps are only valid for 90 days after the date of publication.			
	Pending Add	In Place	Pending Remove	Not In Use		
Power Cable						
Power Duct				N/A		

Reproduced from the Ordnance Survey map by BT by permission of Ordnance Survey on behalf of the Controller of Her Majesty's Stationary Office
(C) Crown Copyright British Telecommunications plc 100028040

BT Ref : SJK02384V
Map Reference : (centre) SD8953212202
Easting/Northing : (centre) 389532, 412202
Issued : 23/01/2024 14:38:22

WARNING: IF PLANNED WORKS FALL INSIDE HATCHED AREA IT IS ESSENTIAL BEFORE PROCEEDING THAT YOU CONTACT THE NATIONAL NOTICE HANDLING CENTRE. PLEASE SEND E-MAIL TO: nnhc@openreach.co.uk