


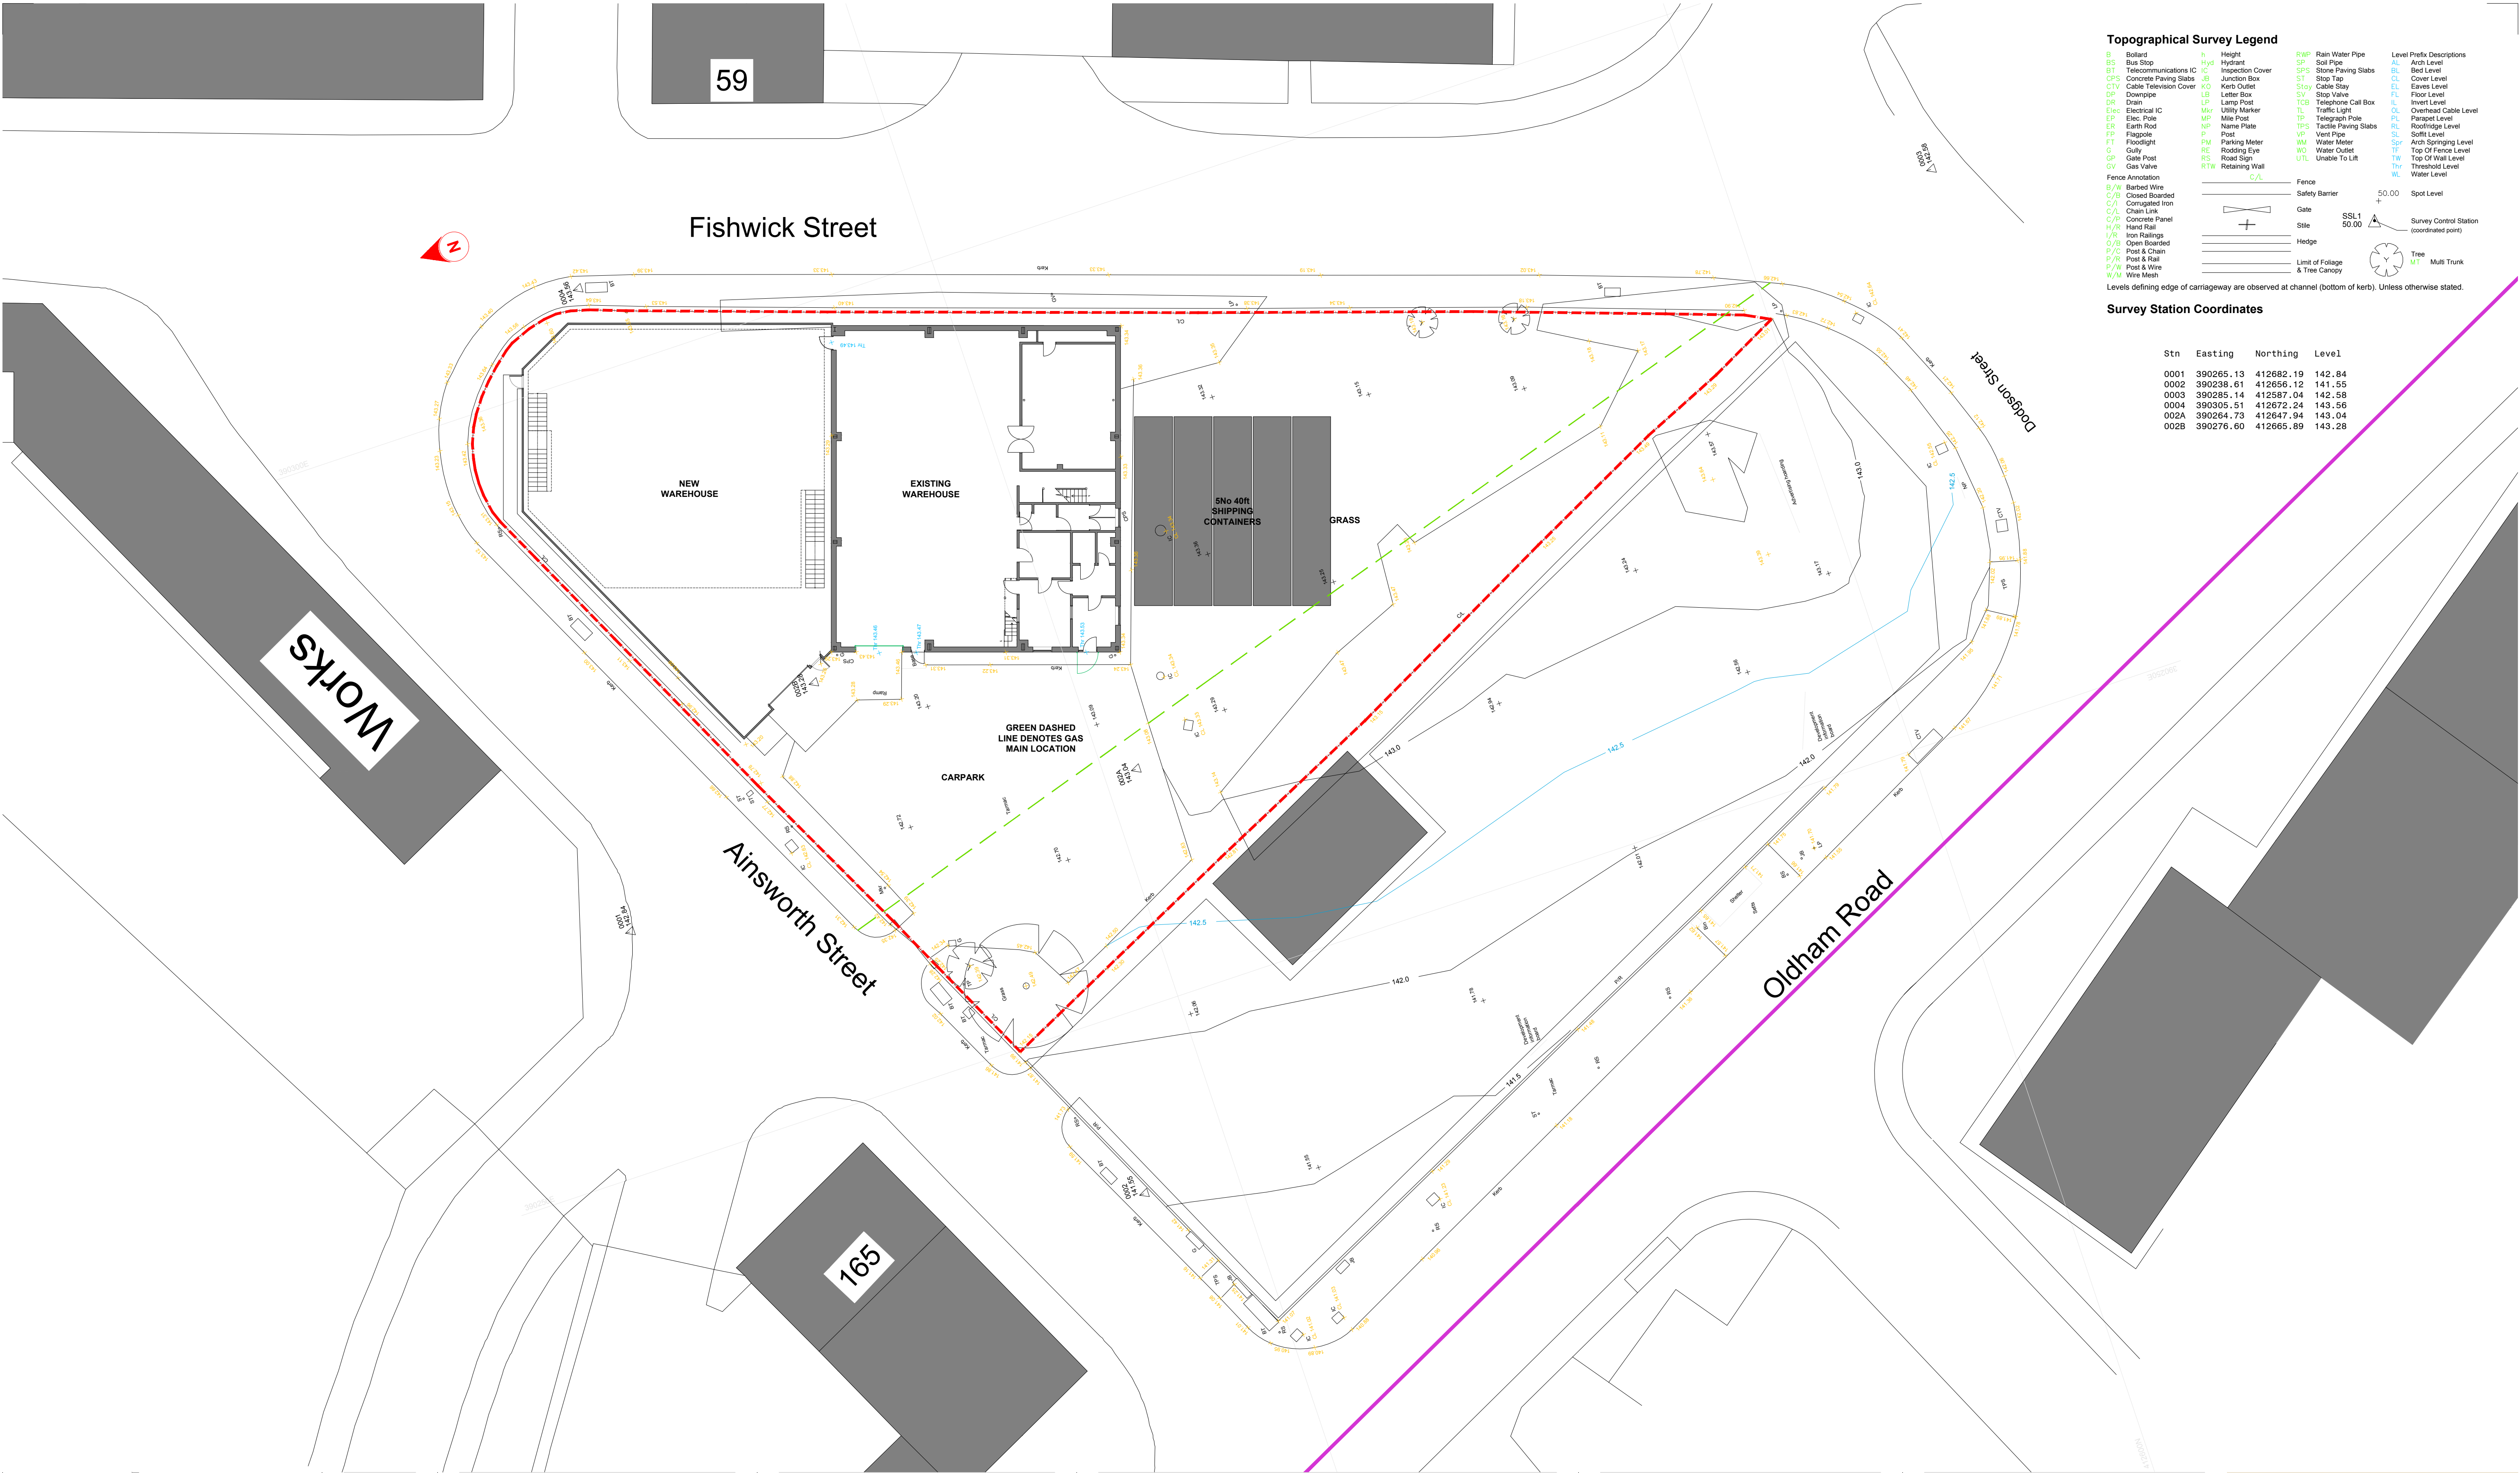

Topographical Survey Legend			
B	Barbed	H	Height
BS	Bus Stop	Hyd	Hydrant
BT	Telecommunications IC	IC	Inspection Cover
CPS	Concrete Paving Slabs	JB	Junction Box
CTV	Cable Television Cover	KO	Kerb Outlet
DP	Downpipe	LB	Letter Box
DR	Drain	LP	Lamp Post
ELC	Electrical IC	MU	Utility Marker
EP	Elec. Pole	MP	Mile Post
ER	Earth Rod	NP	Name Plate
FP	Flagpole	P	Post
FT	Floodlight	PM	Parking Meter
G	Gully	RE	Rodding Eye
GP	Gate Post	RS	Road Sign
GV	Gas Valve	RTW	Retaining Wall
Fence Annotation			
B/W	Barbed Wire	C/A	Closed Boarded
C/I	Corrugated Iron	C/L	Chain Link
C/P	Concrete Panel	H/R	Hand Rail
I/R	Iron Railings	O/B	Open Boarded
P/C	Post & Chain	P/R	Post & Rail
P/W	Post & Wire	W/W	Wire Mesh
R/W	Rain Water Pipe	SP	Soil Pipe
S/S	Stone Paving Slabs	ST	Stop Tap
SL	Stop Valve	T/CB	Telephone Call Box
TL	Traffic Light	TP	Telegraph Pole
TP	Traffic Pole	TPS	Tactile Paving Slabs
VP	Vent Pipe	WM	Water Meter
WO	Water Outlet	UTL	Unable To Lift
WL	Water Level		
Level Prefix Descriptions			
AL	Arch Level		
BL	Bed Level		
CL	Cover Level		
EL	Eaves Level		
FL	Floor Level		
IL	Invert Level		
OL	Overhead Cable Level		
PL	Parapet Level		
RL	Roofridge Level		
SL	Soffit Level		
SPR	Arch Springing Level		
TF	Top Of Fence Level		
TW	Threshold Level		
WL	Water Level		
Levels defining edge of carriageway are observed at channel (bottom of kerb). Unless otherwise stated.			

Survey Station Coordinates			
Stn	Easting	Northing	Level
0001	390265.13	412682.19	142.84
0002	390238.61	412656.12	141.55
0003	390285.14	412587.04	142.58
0004	390305.51	412672.24	143.56
002A	390264.73	412647.94	143.04
002B	390276.60	412665.89	143.28

cadence

Cadence Architecture Ltd
contact@cadence-architecture.co.uk
www.cadence-architecture.co.uk

project north

notes

- Drawings are based on survey data and may not accurately represent what is physically present.
- Do not scale from this drawing. All dimensions to be site verified by the contractor before proceeding.
- All dimensions are in millimeters unless noted otherwise.
- Your Practice Name Ltd shall be notified in writing of any discrepancies.

key plan
not to scale

revisions

REV	DATE	DRAWN BY	APPR. BY	NOTES
-----	------	----------	----------	-------

client:

VALUME LTD

project:

CCG DEPOT
AINSWORTH ST, OL16 5QX

status:

PLANNING

revision:

title:

AS BUILT SITE PLAN

drawn by:

PDP

approved by:

PDP

date:

14.07.25

job no:

121ROC

scale:

1:200@A1

drawing no:

102