
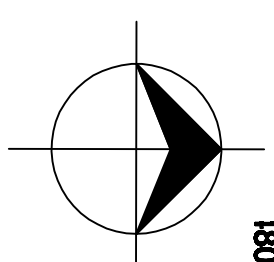
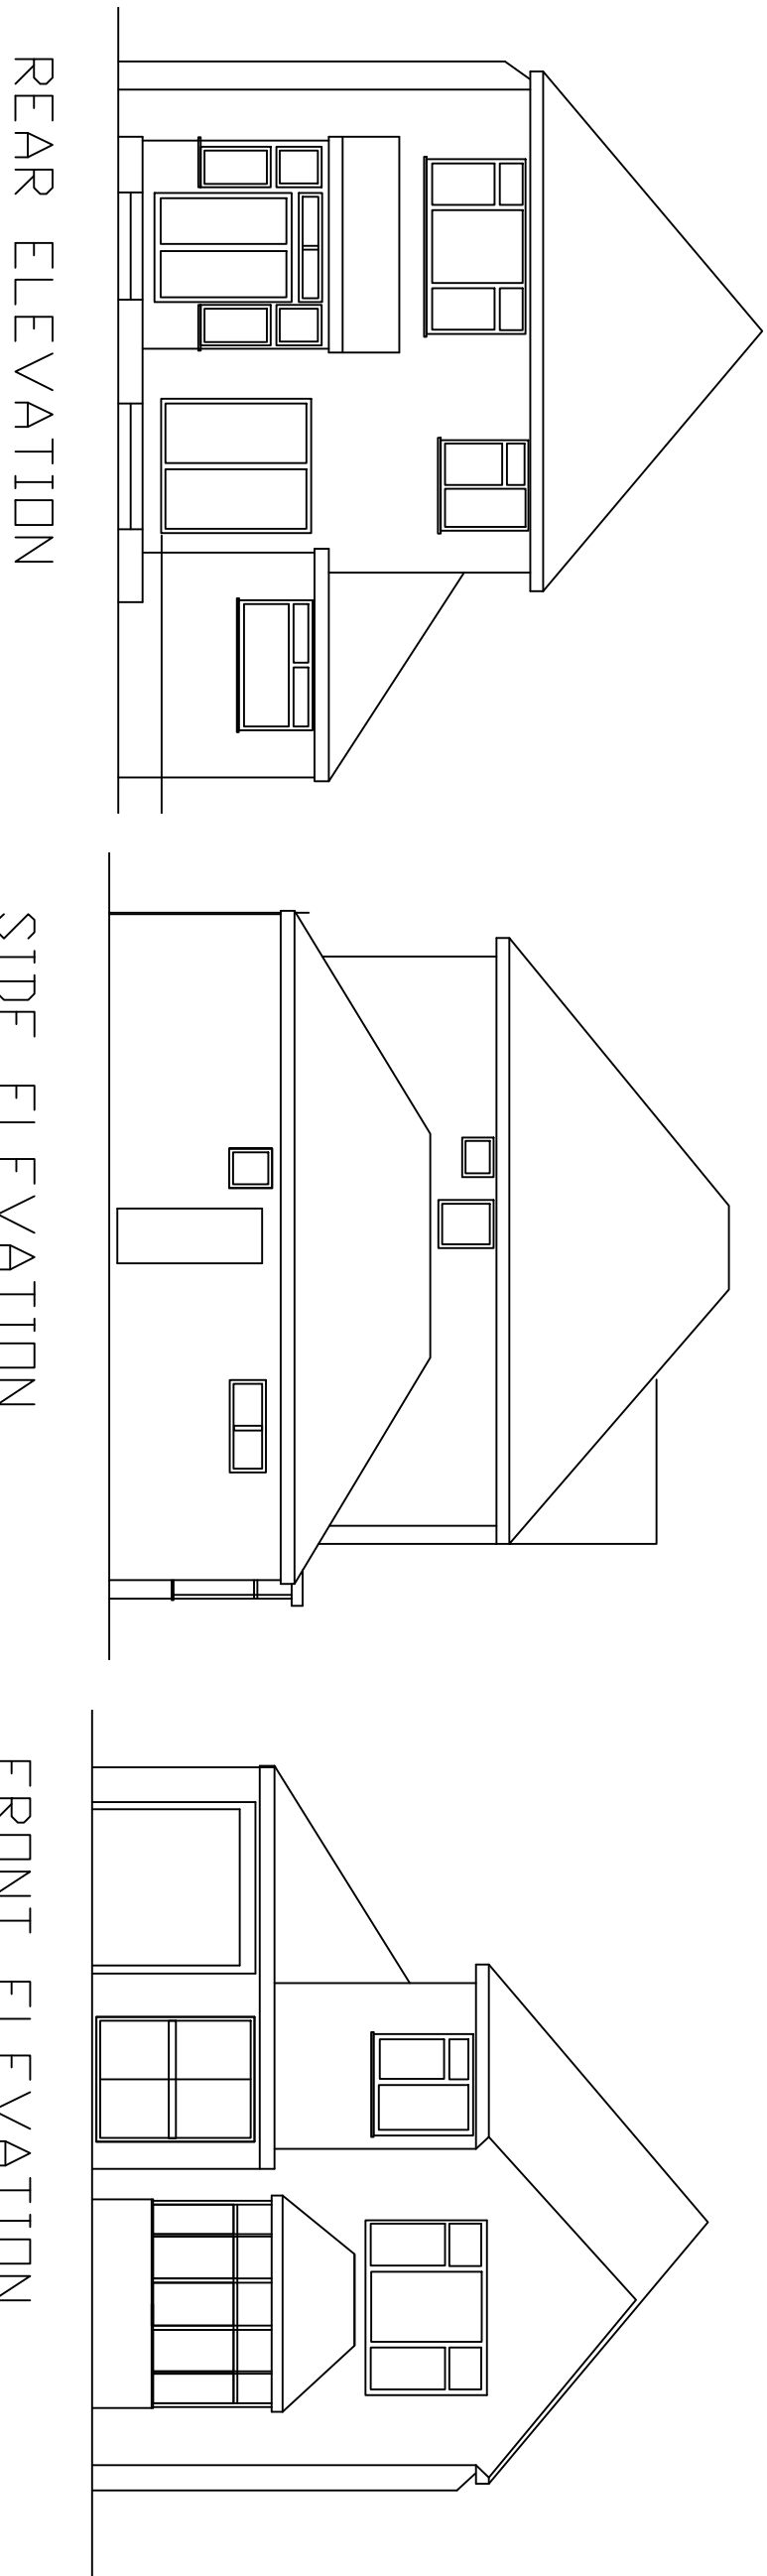



PLANS & ELEVATIONS AS EXISTING

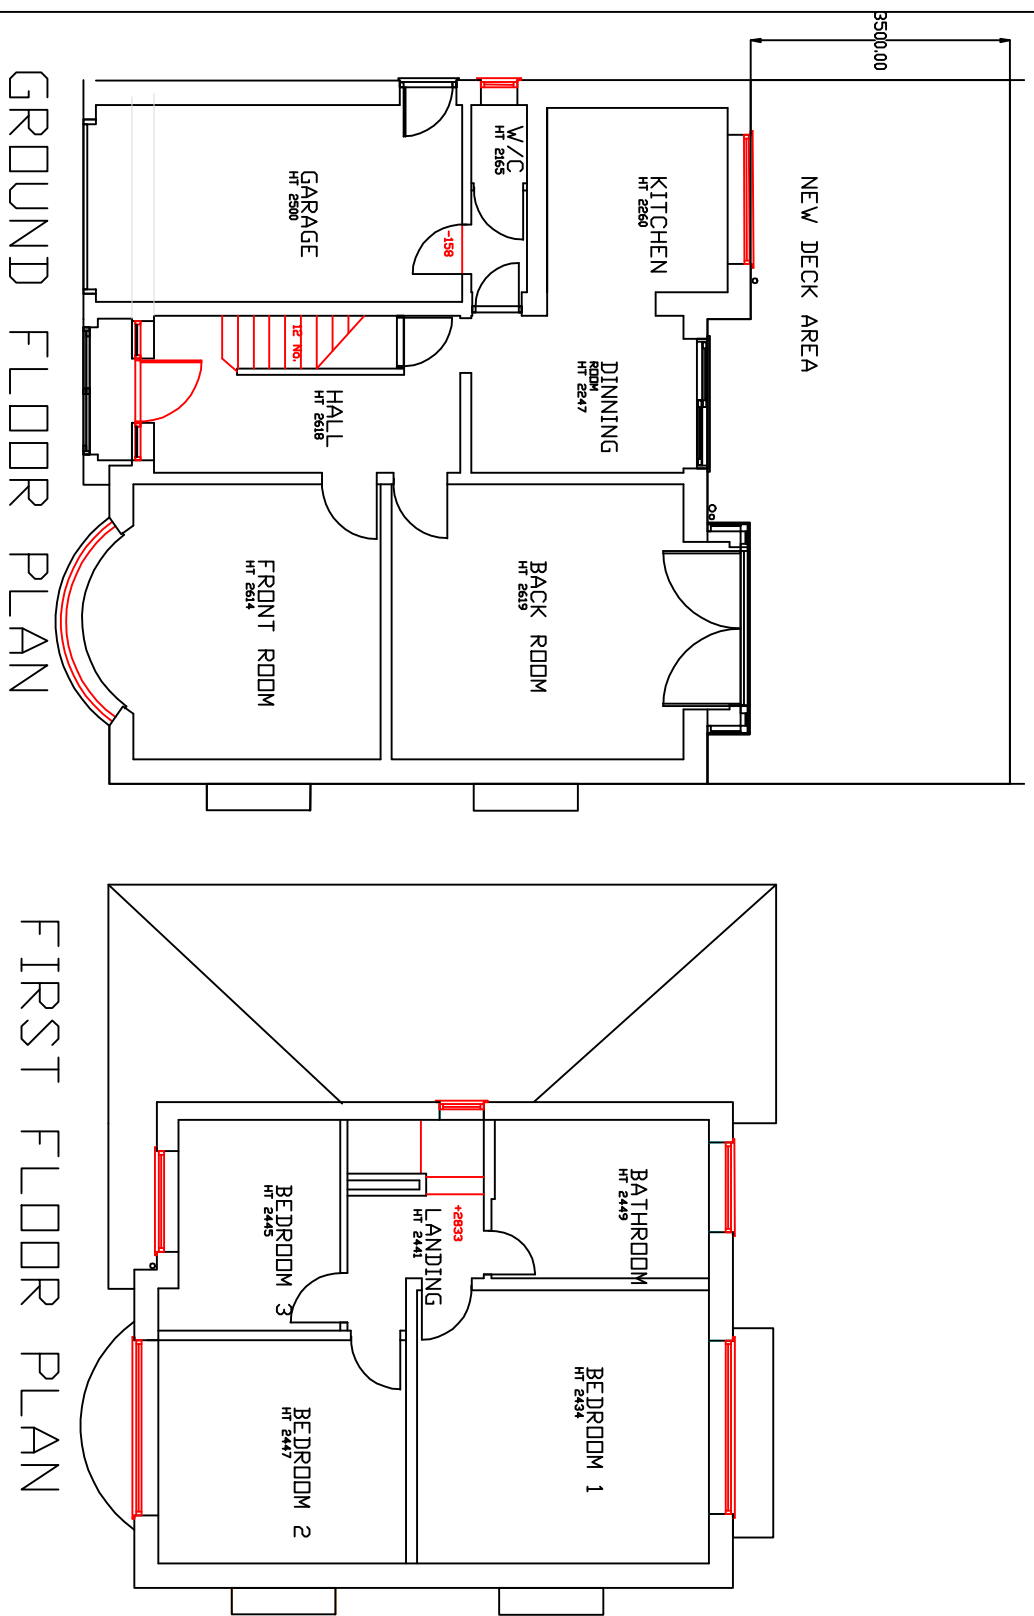

NOTES







ORIGINAL A1

DO NOT SCALE FROM THIS DRAWING.
ALL DIMENSIONS TO BE CHECKED ON SITE.
COPYRIGHT PROTECTED.

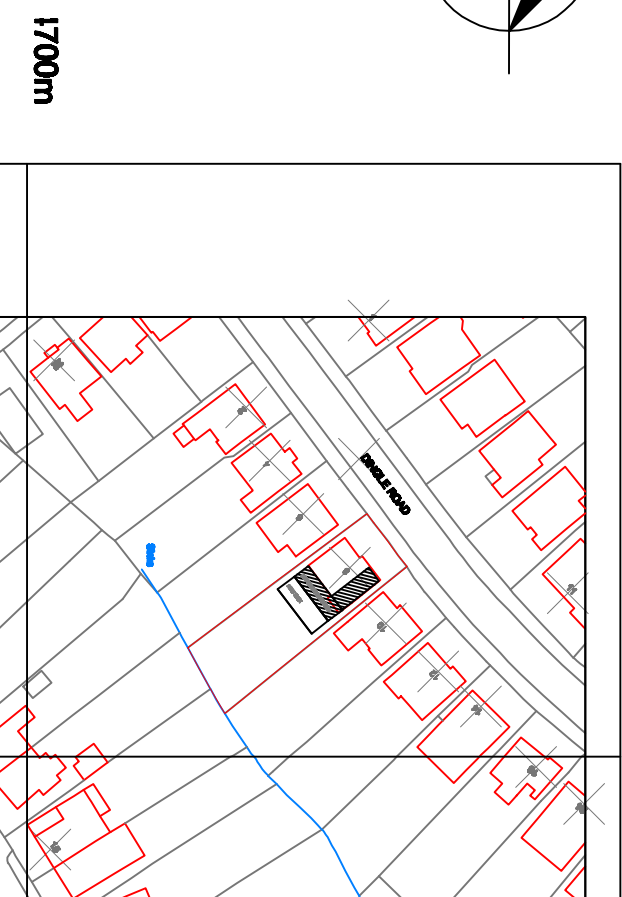

© Crown Copyright and database rights 2022 OS licence no. A0000046095

PLANS & ELEVATIONS AS PROPOSED

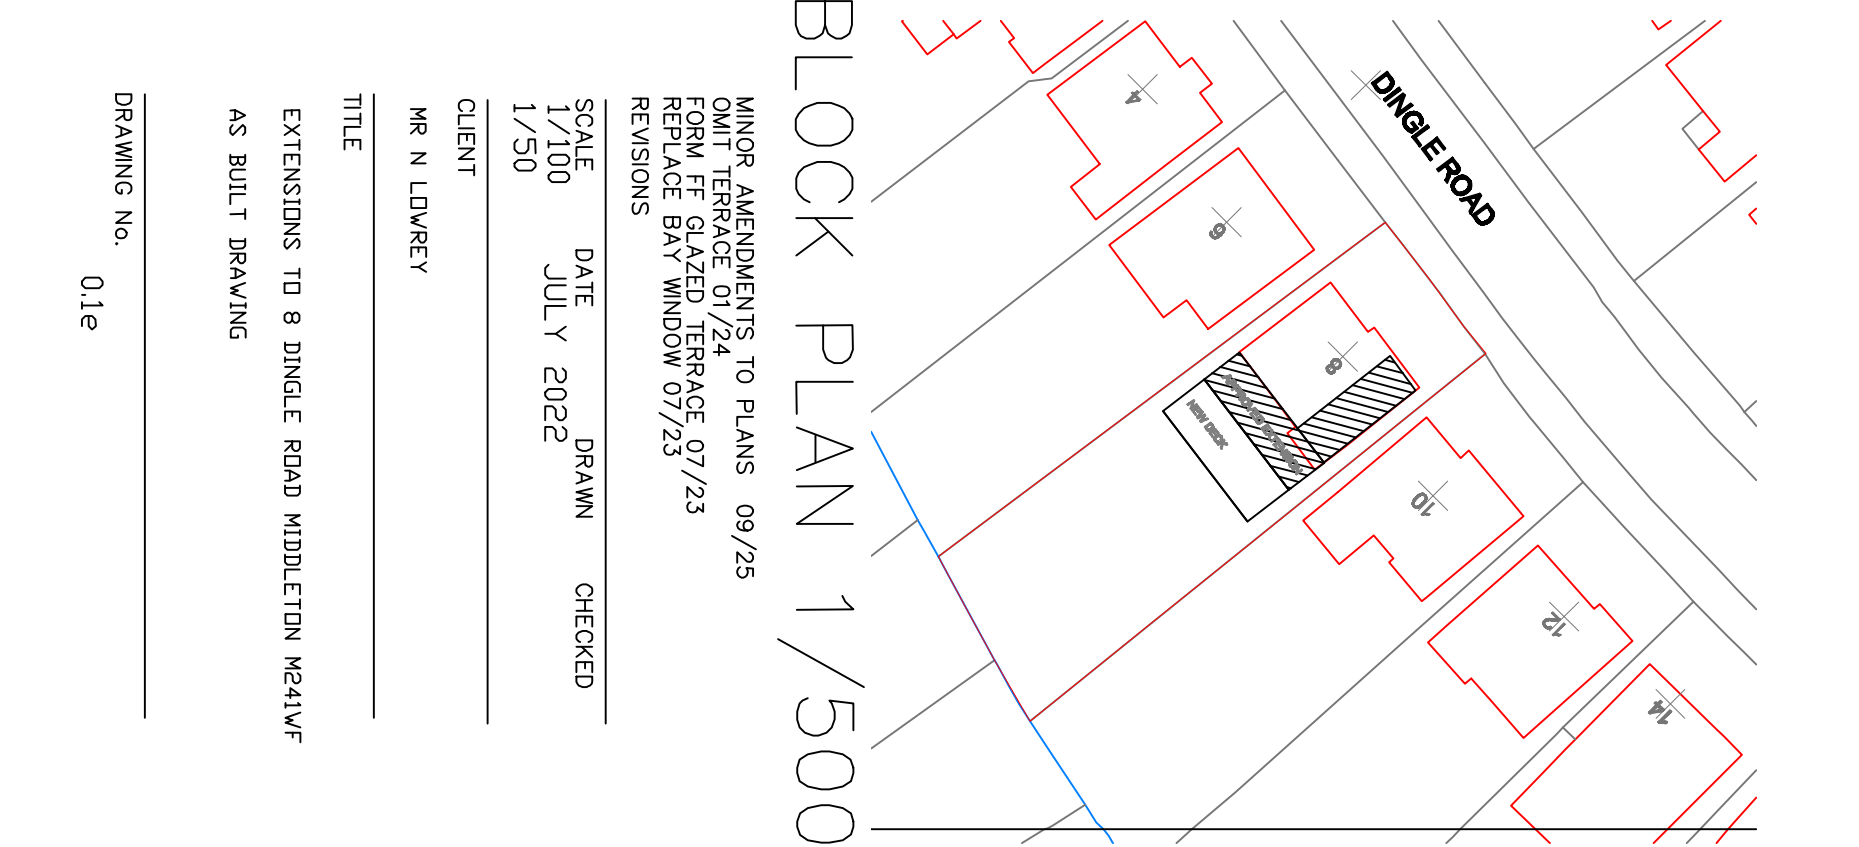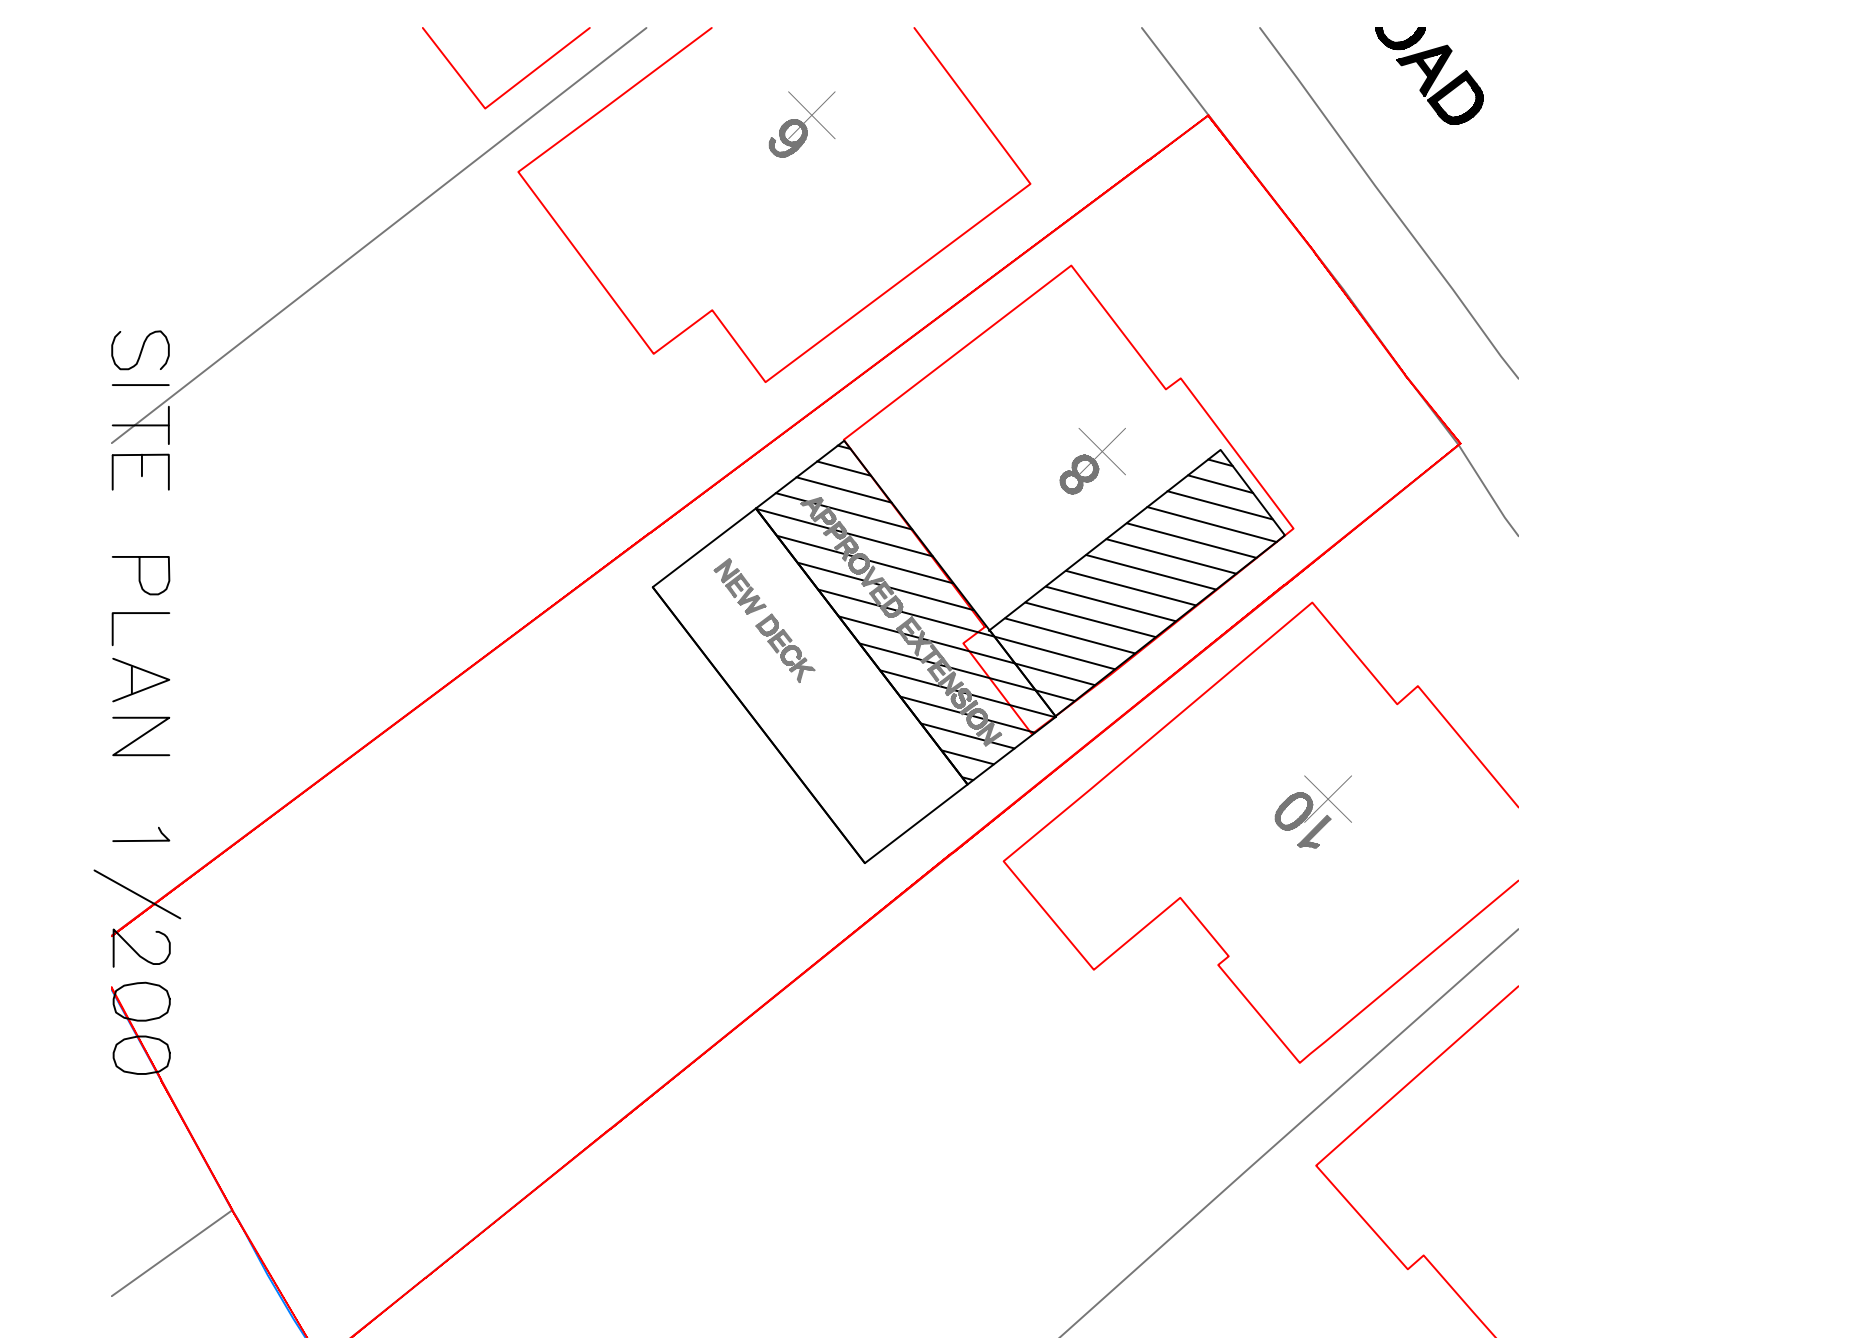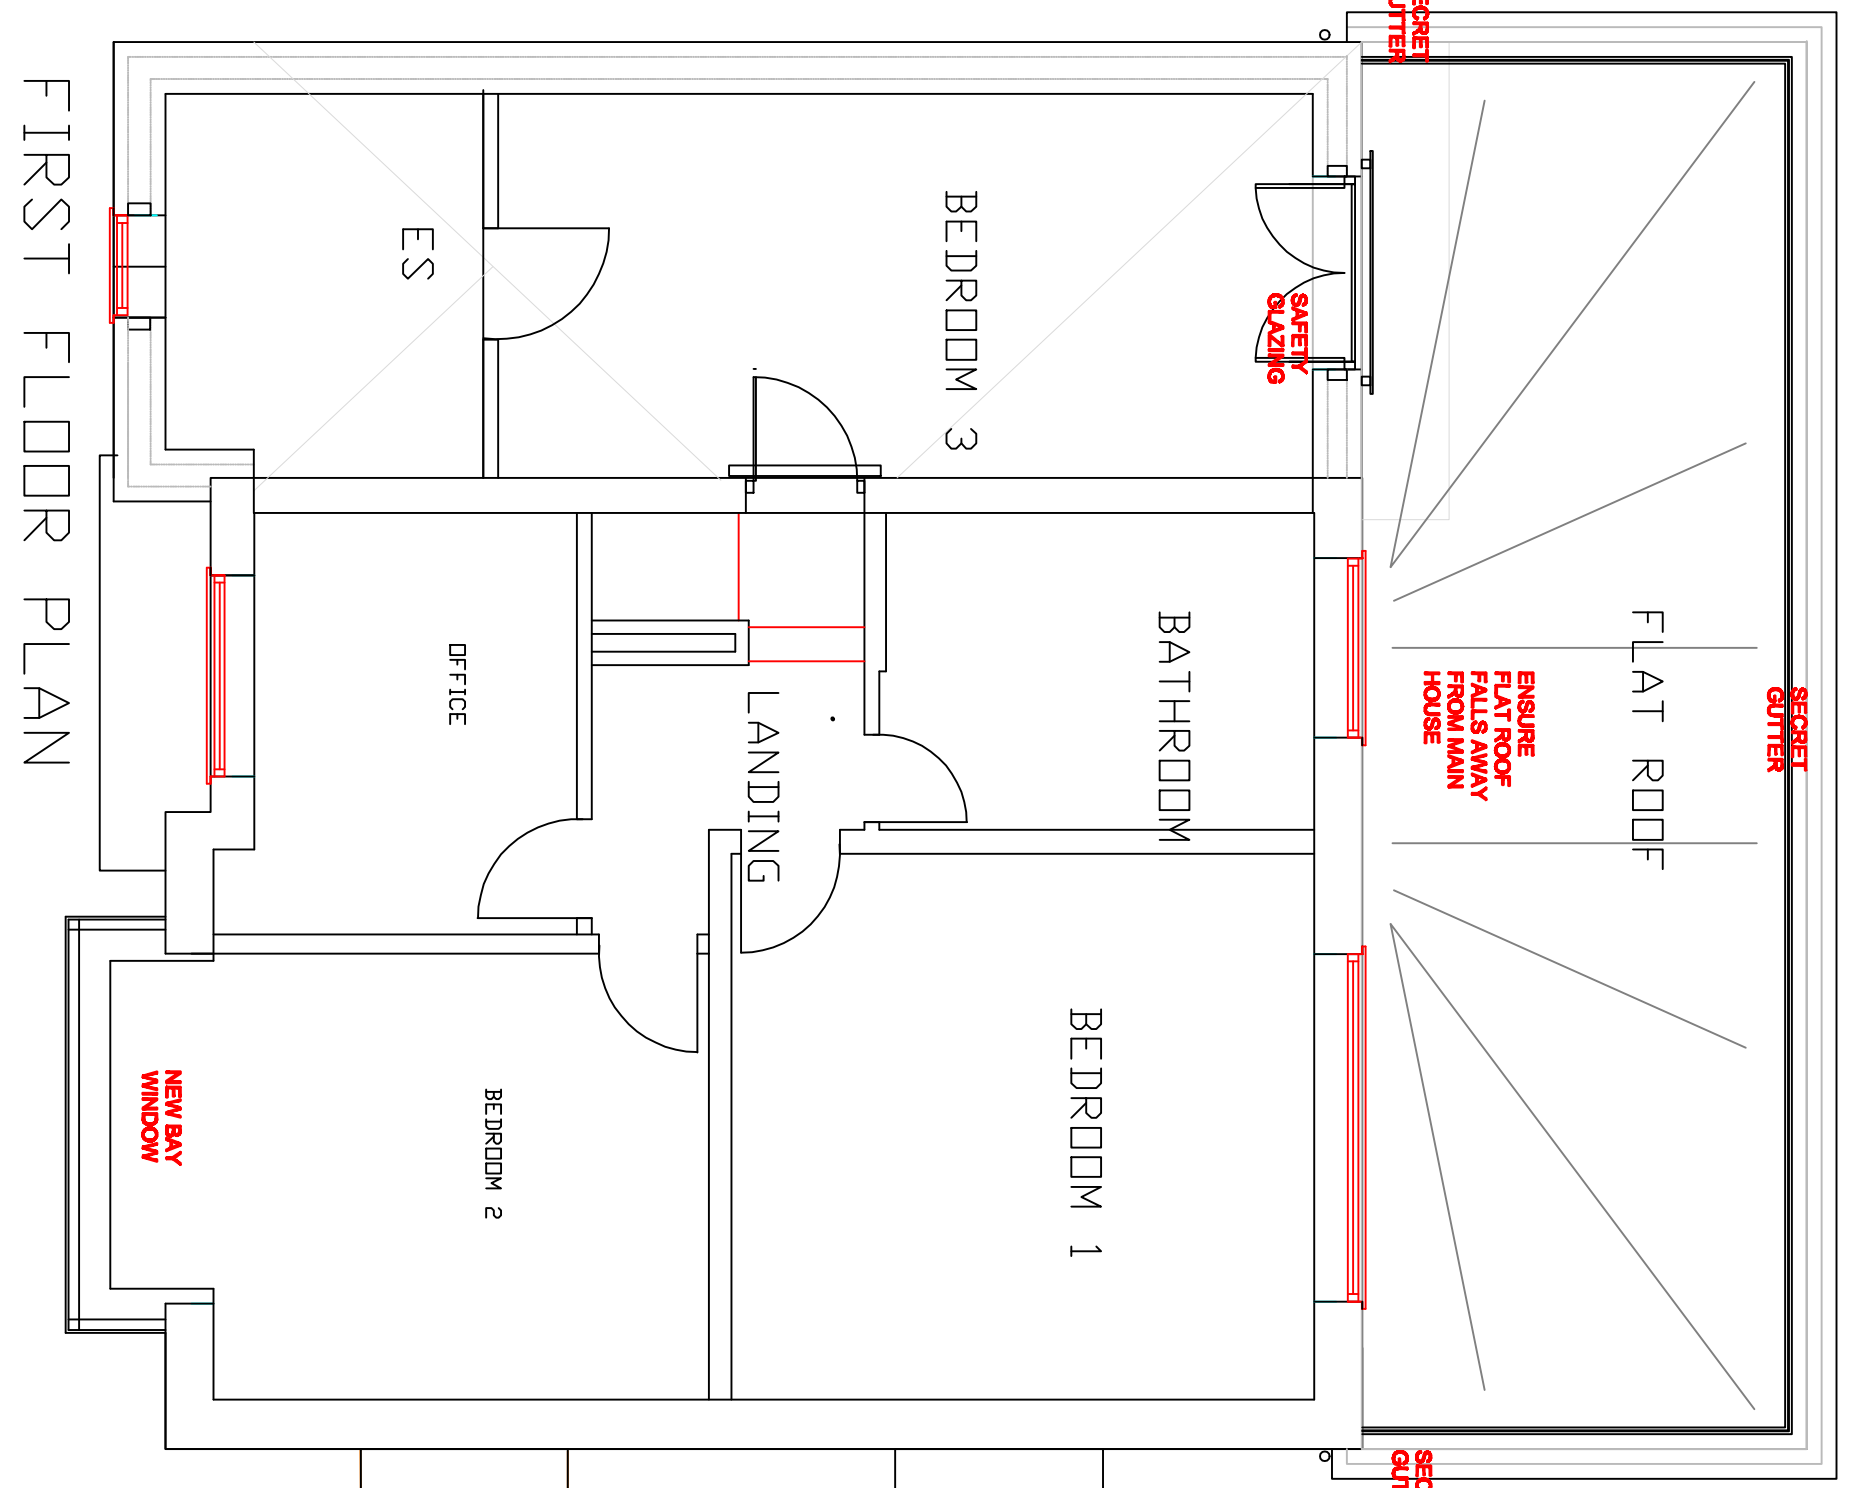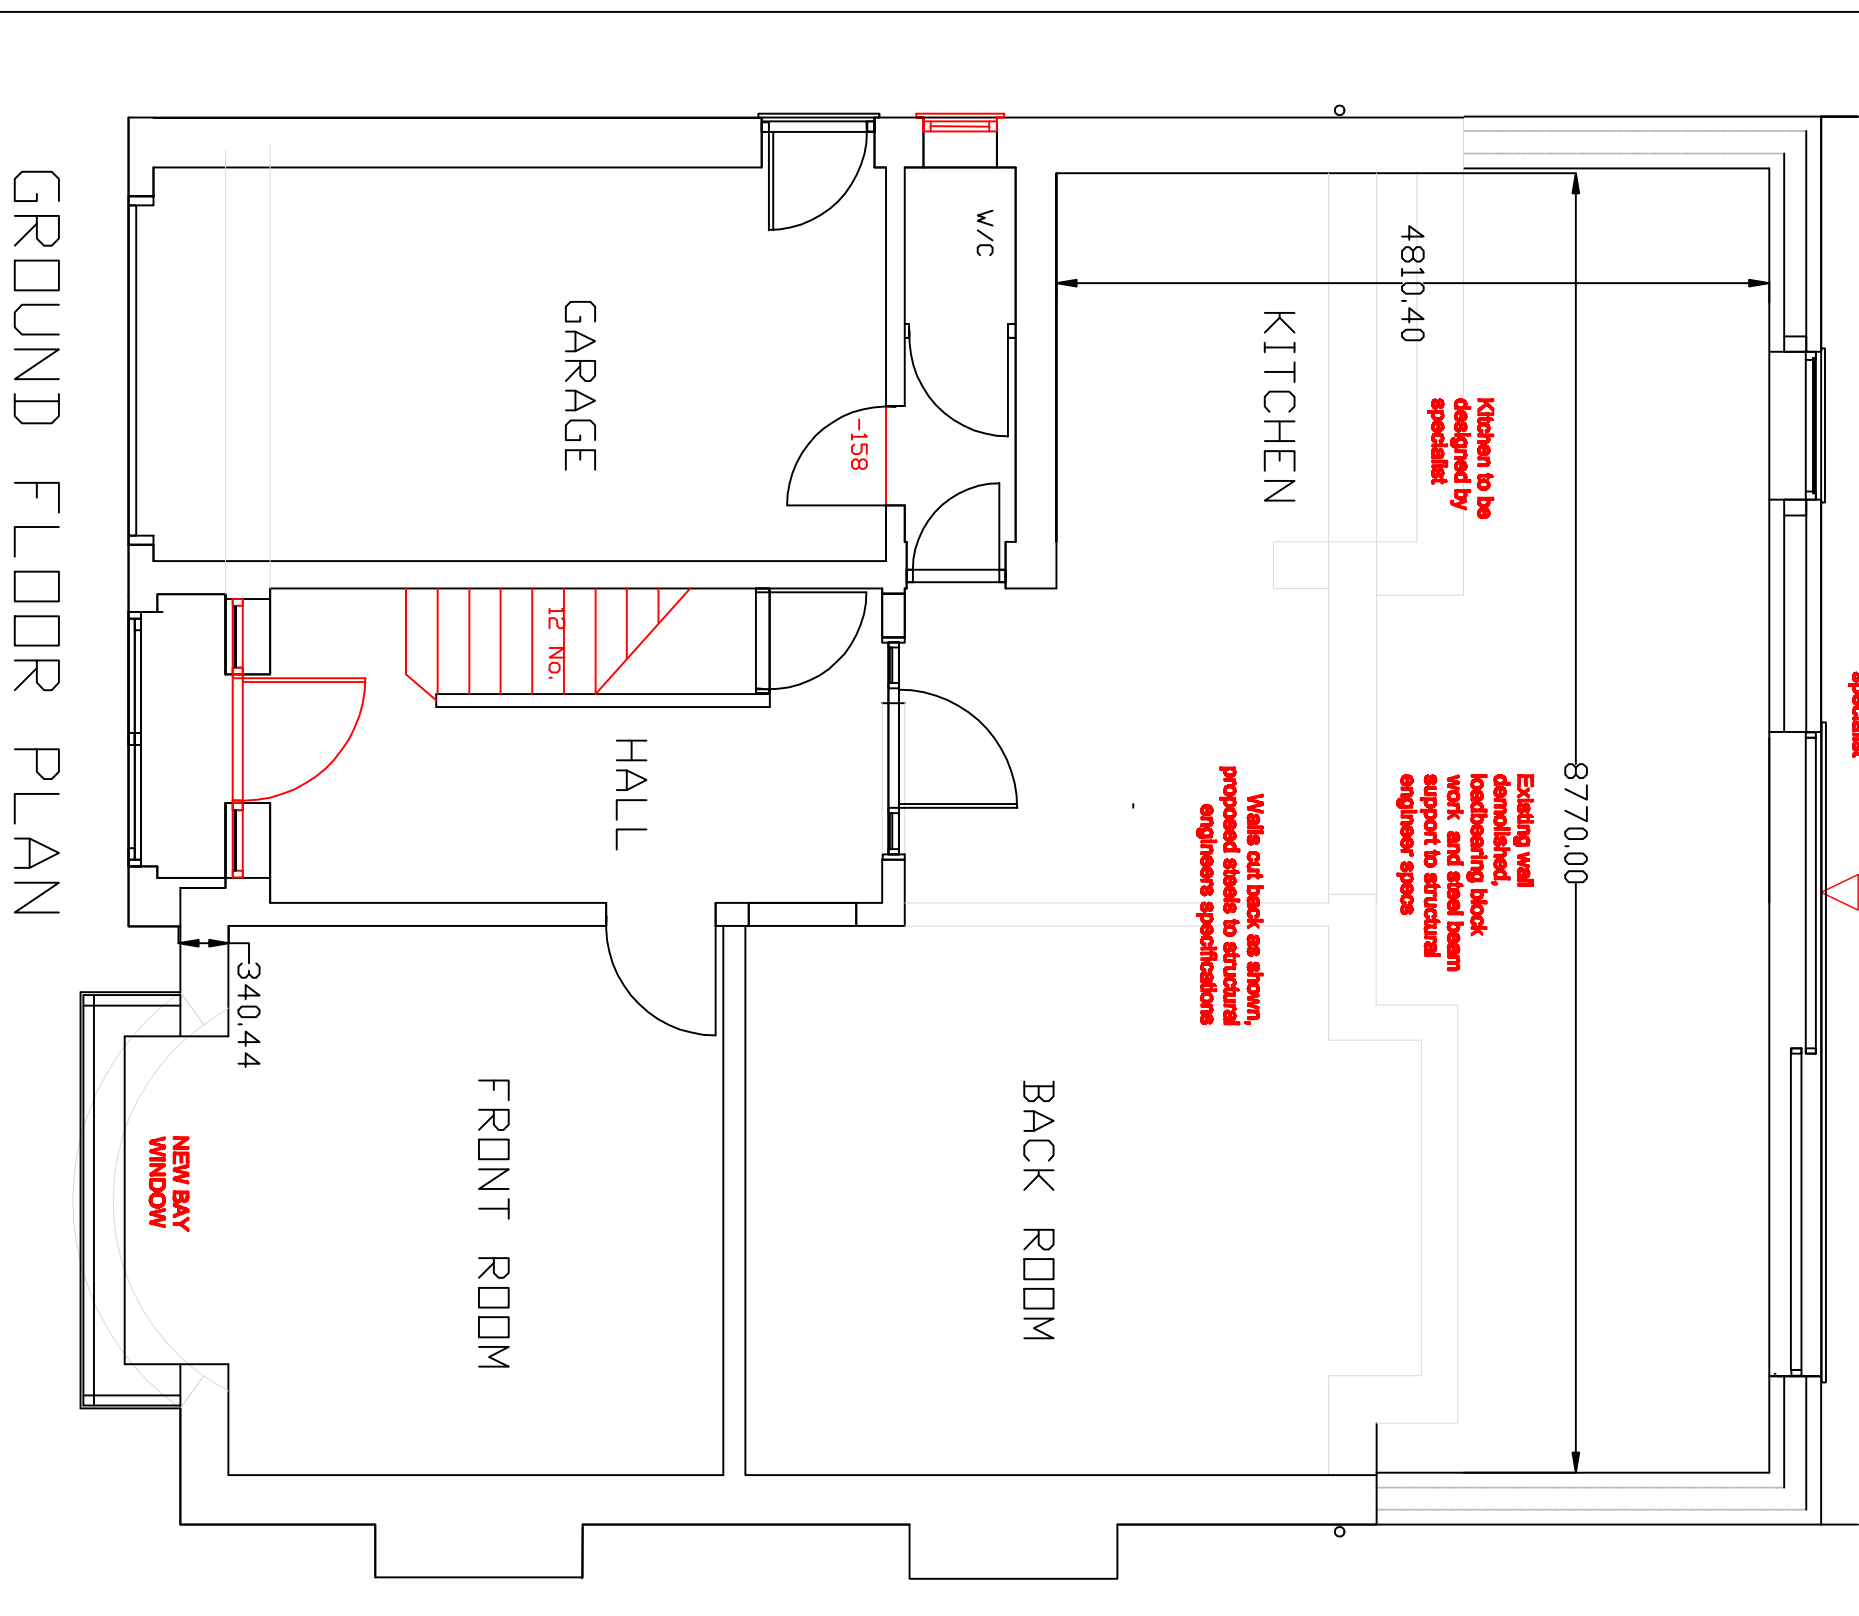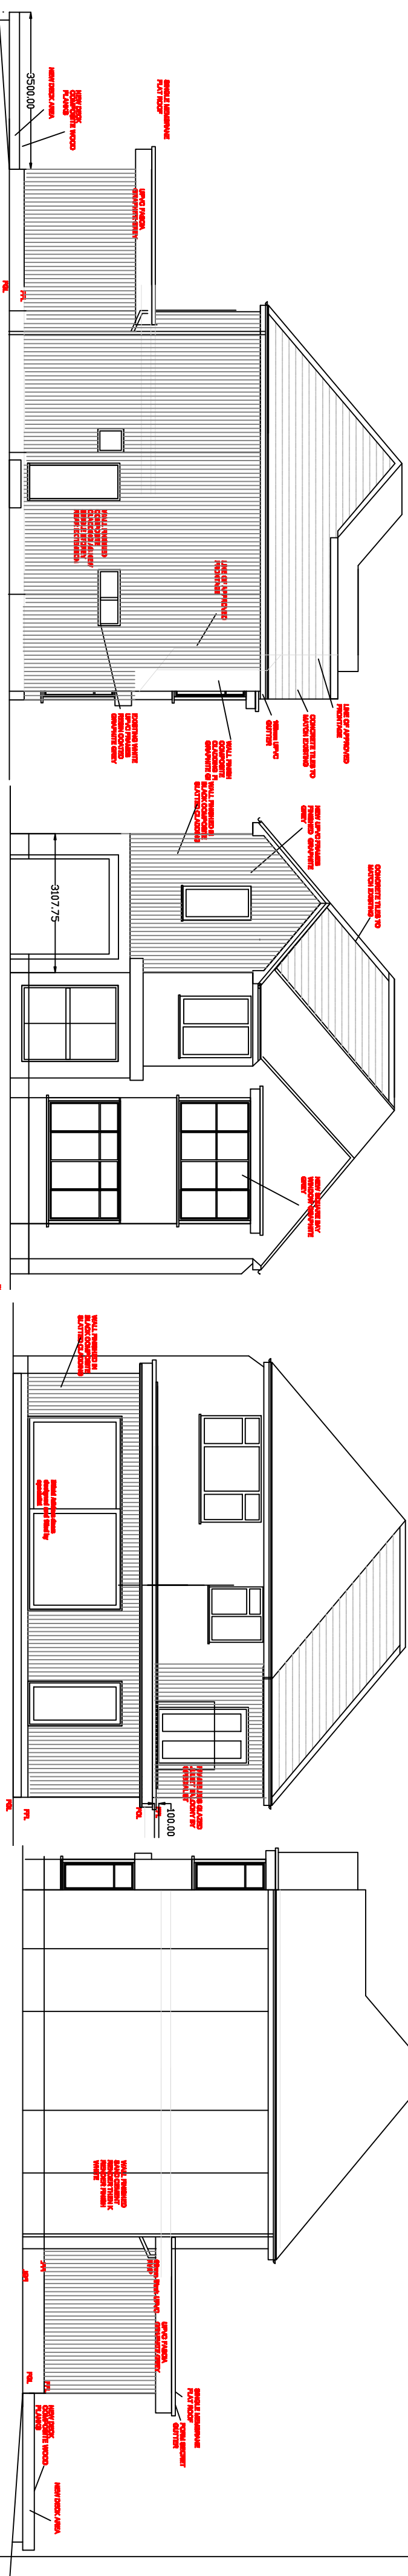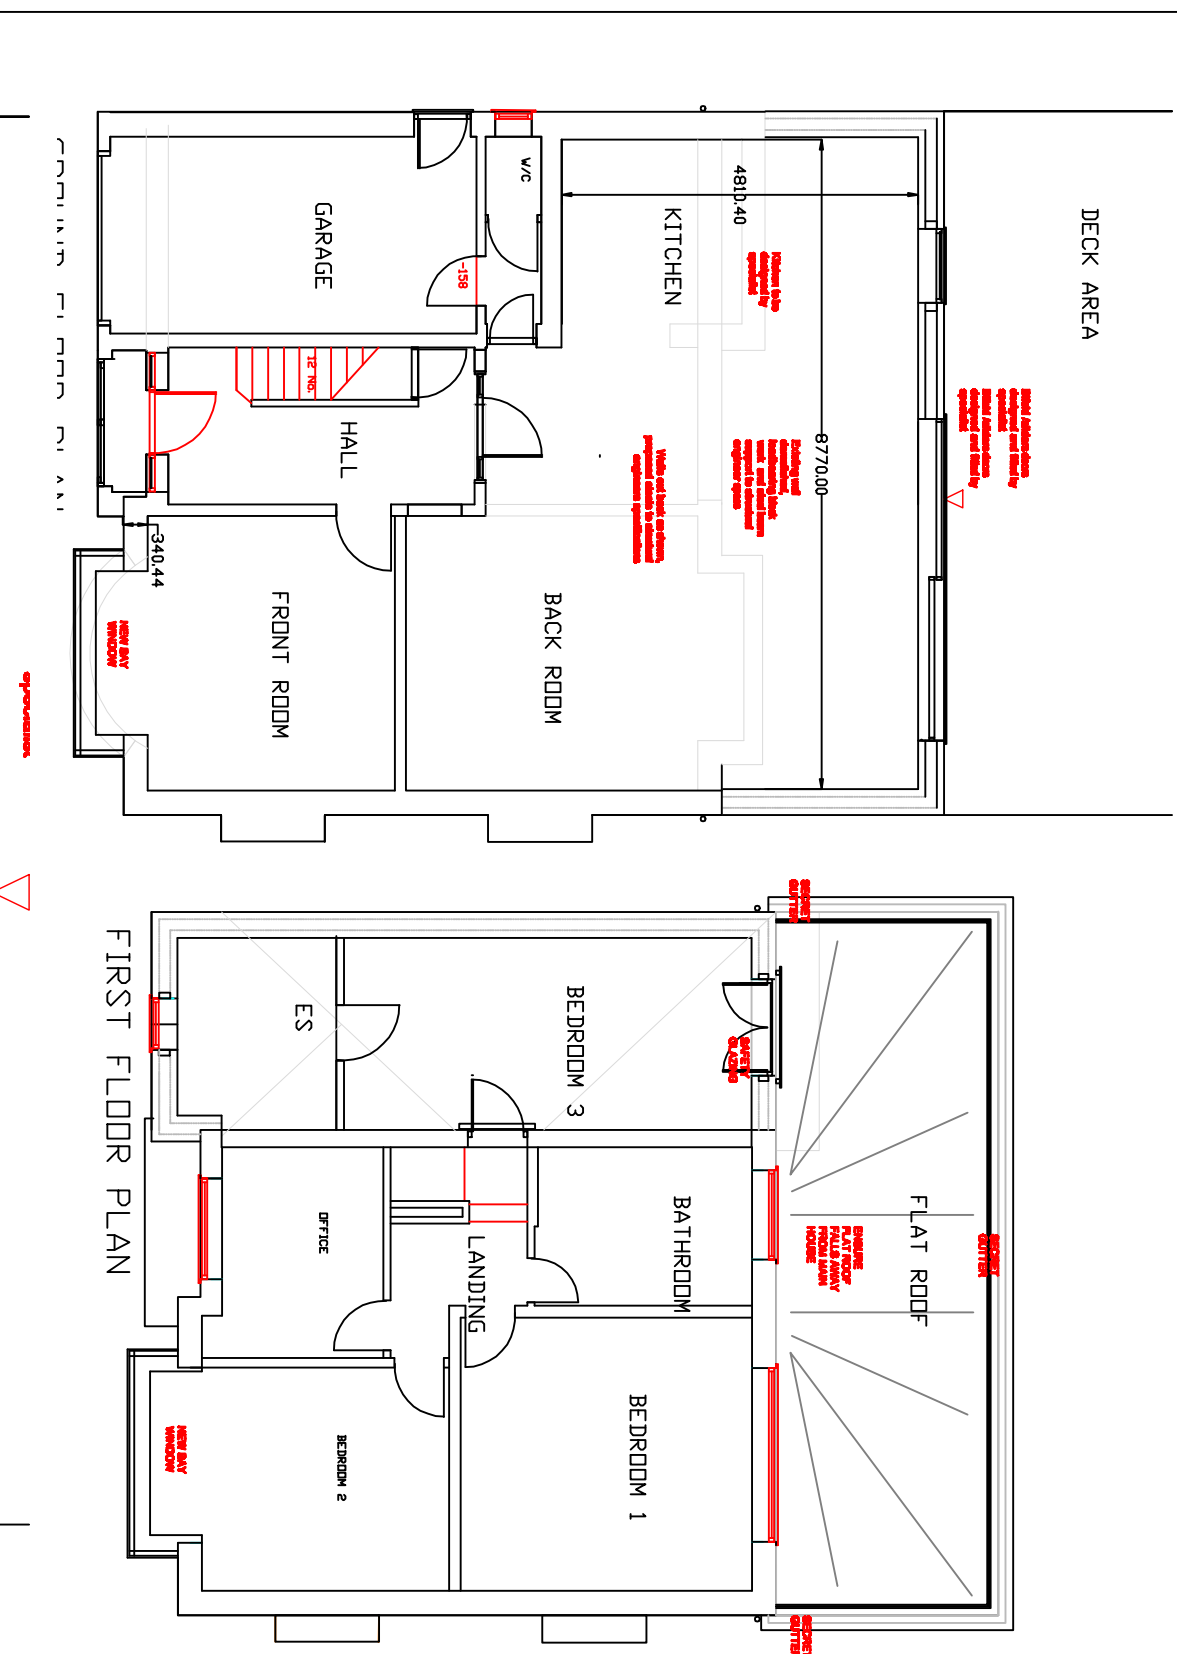

MINOR AMENDMENTS TO PLANS 09/25

OMIT TERRACE 01/24

FORM FF GLAZED TERRACE 07/23

REVISIONS

SCALE DATE DRAWN CHECKED

1/100 JULY 2022

1/50

CLIENT

MR N LOWREY

TITLE

EXTENSIONS TO 8 DINGLE ROAD WIDDELETON W414YF

AS BUILT DRAWING

DRAWING No. 01e