





AS BUILT WEST FACING ELEVATION (1:100)

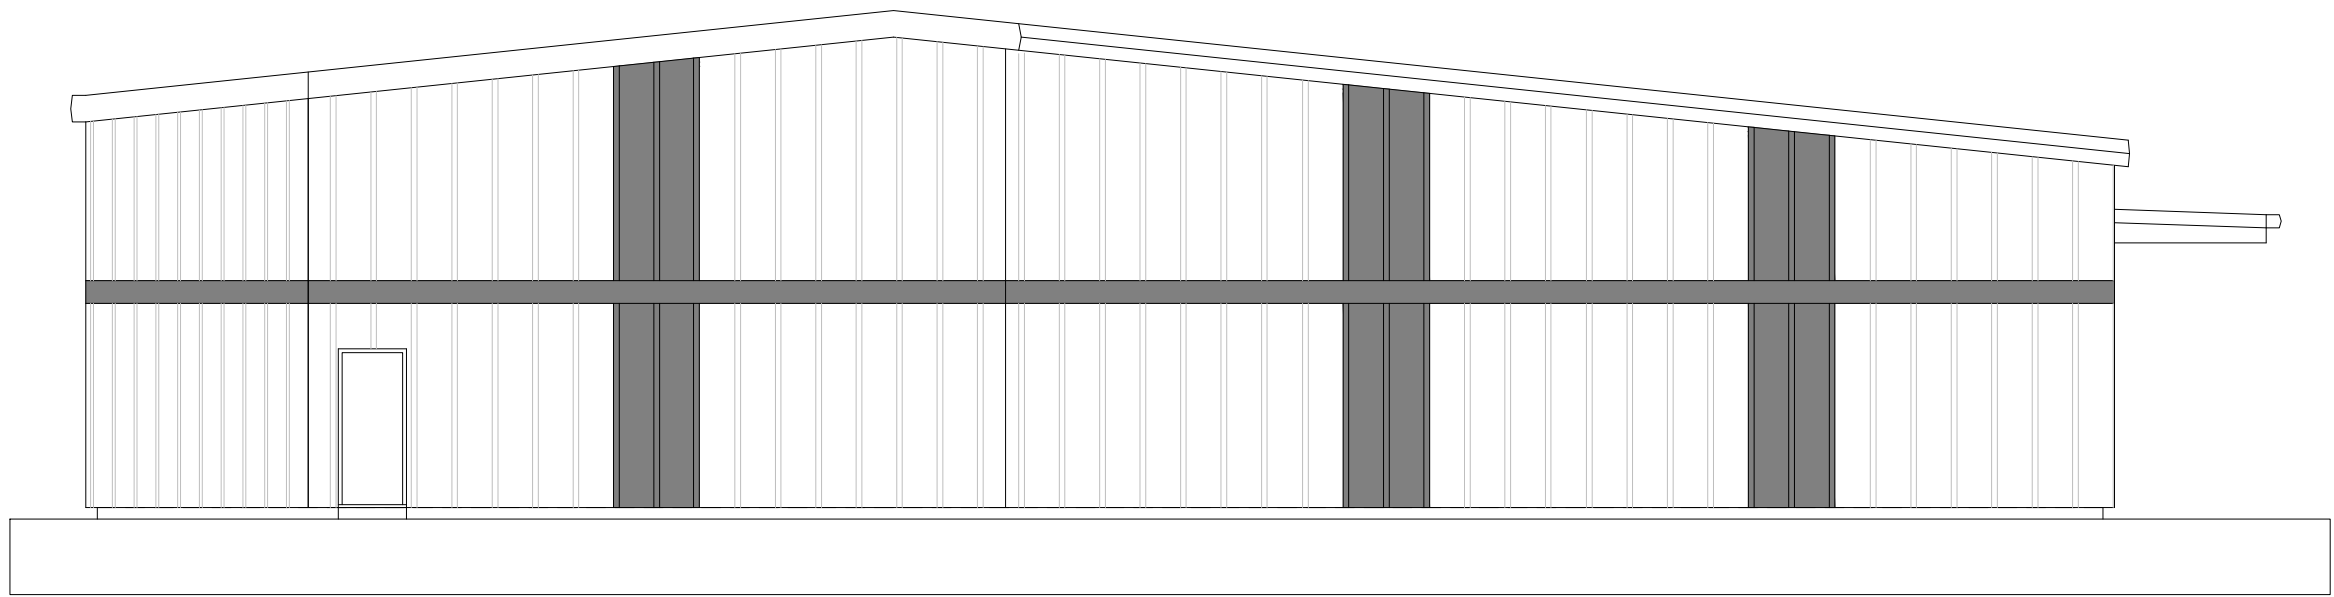


AS BUILT NORTH FACING ELEVATION (1:100)

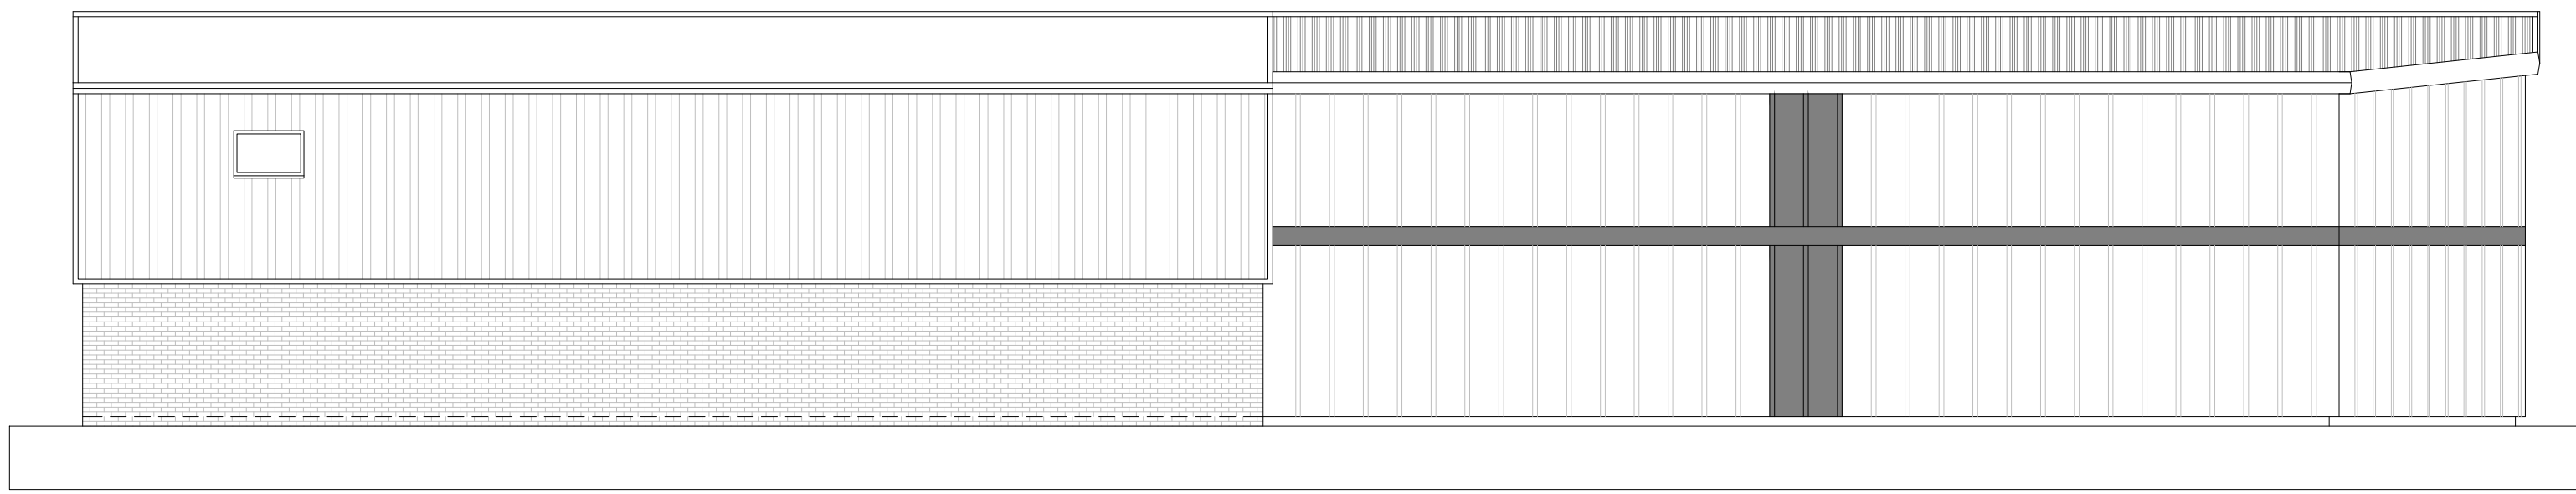

AS BUILT EAST FACING ELEVATION (1:100)

SPECIFICATION

- MAIN CLADDING AS35 80MM
COLOUR PIGEON GREY
- FEATURE CLADDING AS35 80MM
COLOUR MERLIN GREY
- ROOF CLADDING AS35 100MM
COLOUR PIGEON GREY
- EXISTING GREY CLADDING
- EXISTING BRICKWORK

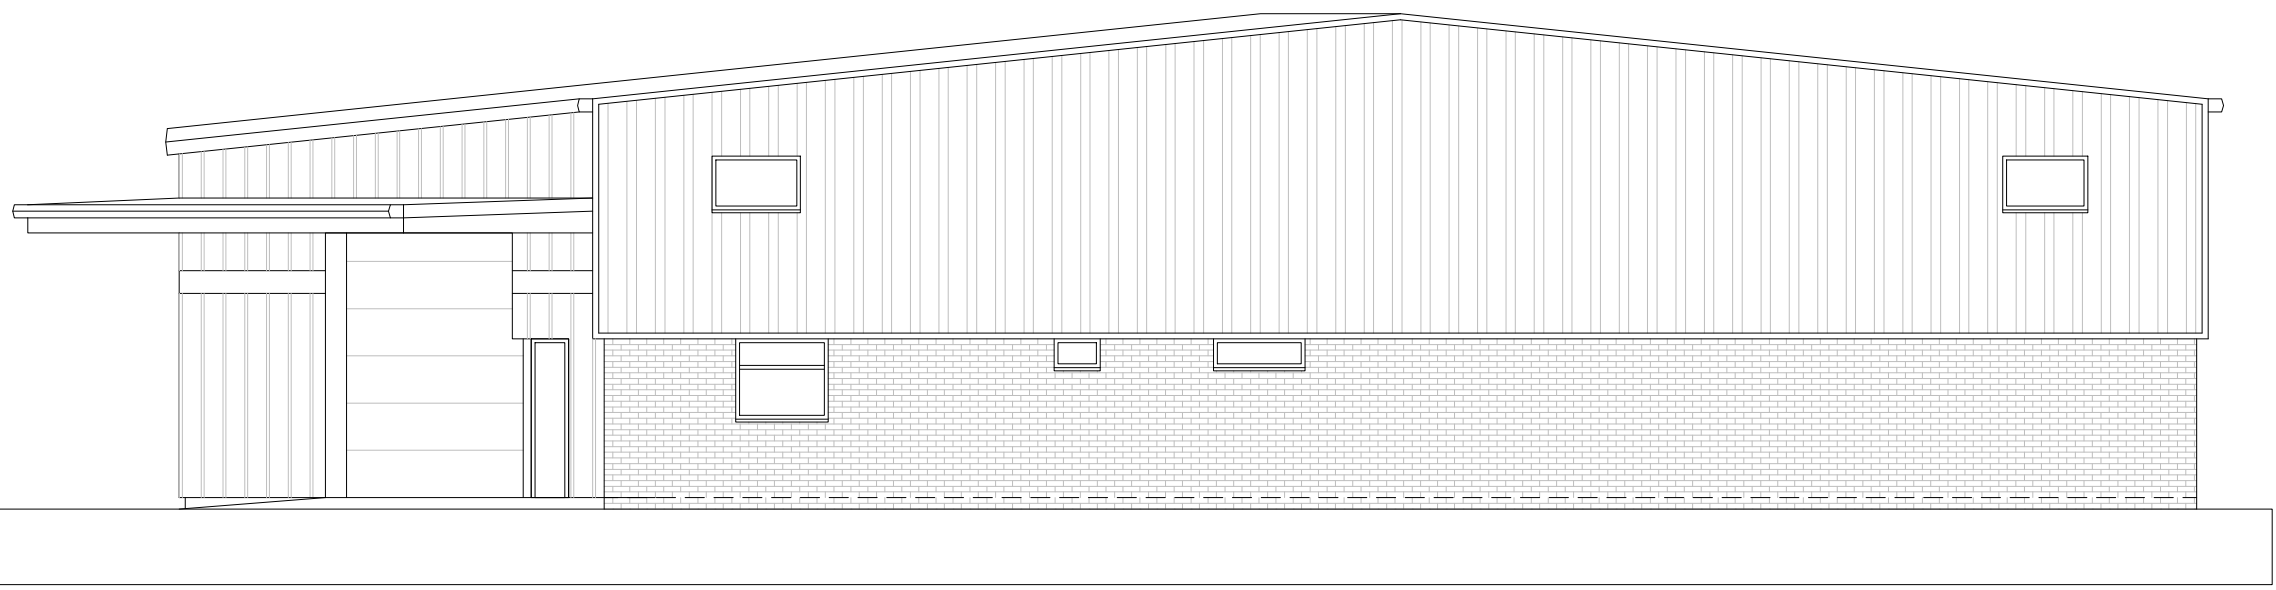


AS BUILT SOUTH FACING ELEVATION (1:100)

cadence

Cadence Architecture Ltd
contact@cadence-architecture.co.uk
www.cadence-architecture.co.uk

project north

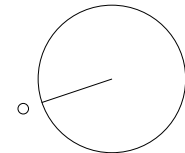

notes

- Drawings are based on survey data and may not accurately represent what is physically present.
- Do not scale from this drawing. All dimensions to be site verified by the contractor before proceeding.
- All dimensions are in millimeters unless noted otherwise.
- Your Practice Name Ltd shall be notified in writing of any discrepancies.

key plan
not to scale

revisions

REV	DATE	DRAWN BY	APPR. BY	NOTES
-----	------	----------	----------	-------

client:

VALUME LTD

project:

CCG DEPOT
AINSWORTH ST, OL16 5QX

status:

PLANNING

revision:

title:

AS BUILT ELEVATIONS

drawn by:

PDP

approved by:

PDP

date:

14.07.25

job no:

121ROC

scale:

1:100@A1

drawing no:

110