
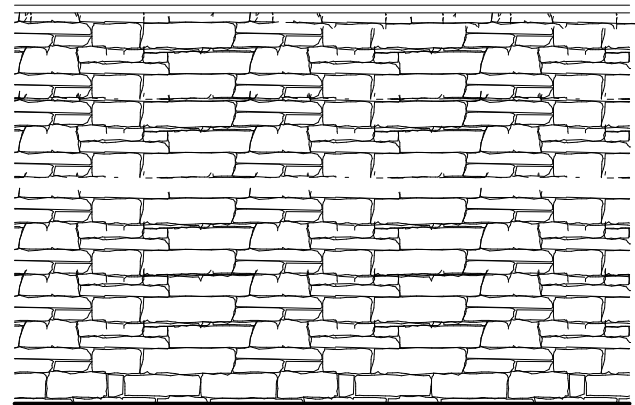


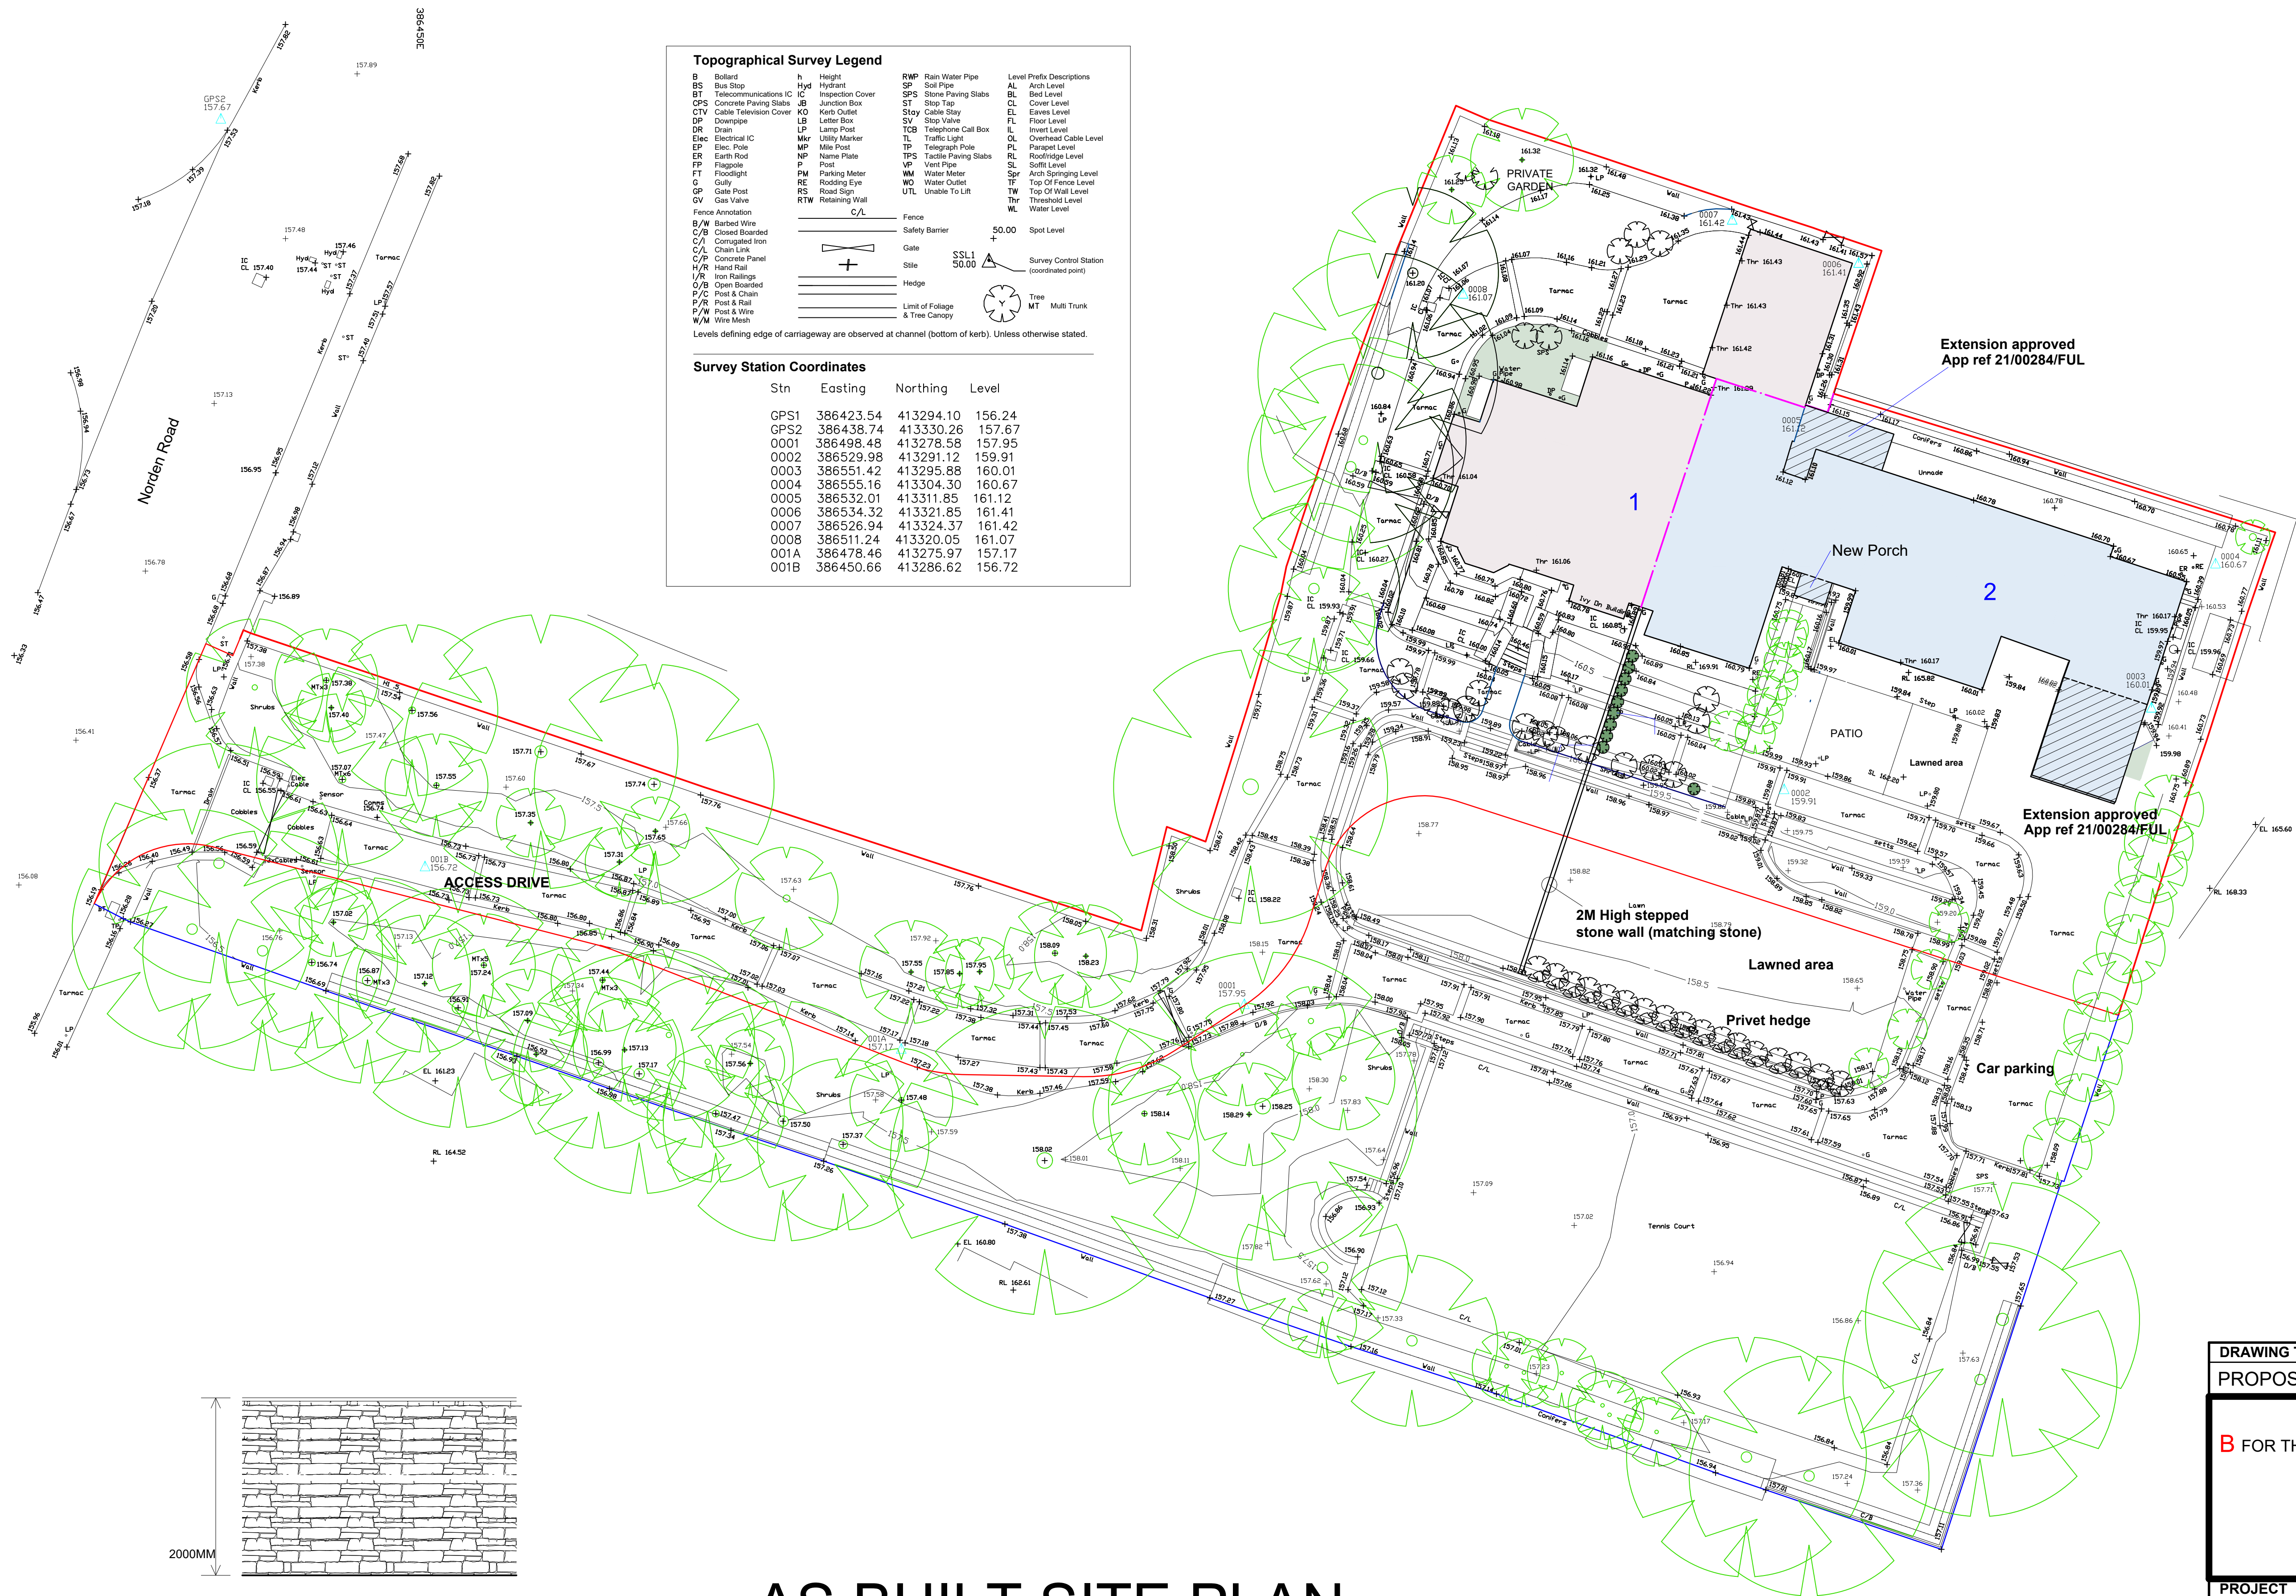

STONE WALL ELEVATION SCALE - 1:50

AS BUILT SITE PLAN

Approved extended areas shown - subject to future work

DRAWING TITLE	
PROPOSED SITE PLAN	
B FOR THE VARIATION OF CONDITIONS APPLICATION	
App ref 21/00284/FUL	
PROJECT	
RESIDENTIAL DEVELOPMENT	
LOCATION	
Mayroyd Norden Road Bamford Rochdale	
DRAWN:-	DRAWING NUMBER:-
DATE:-	29th JULY 2025
SCALE:-	1:200
ISSUE:-	B