



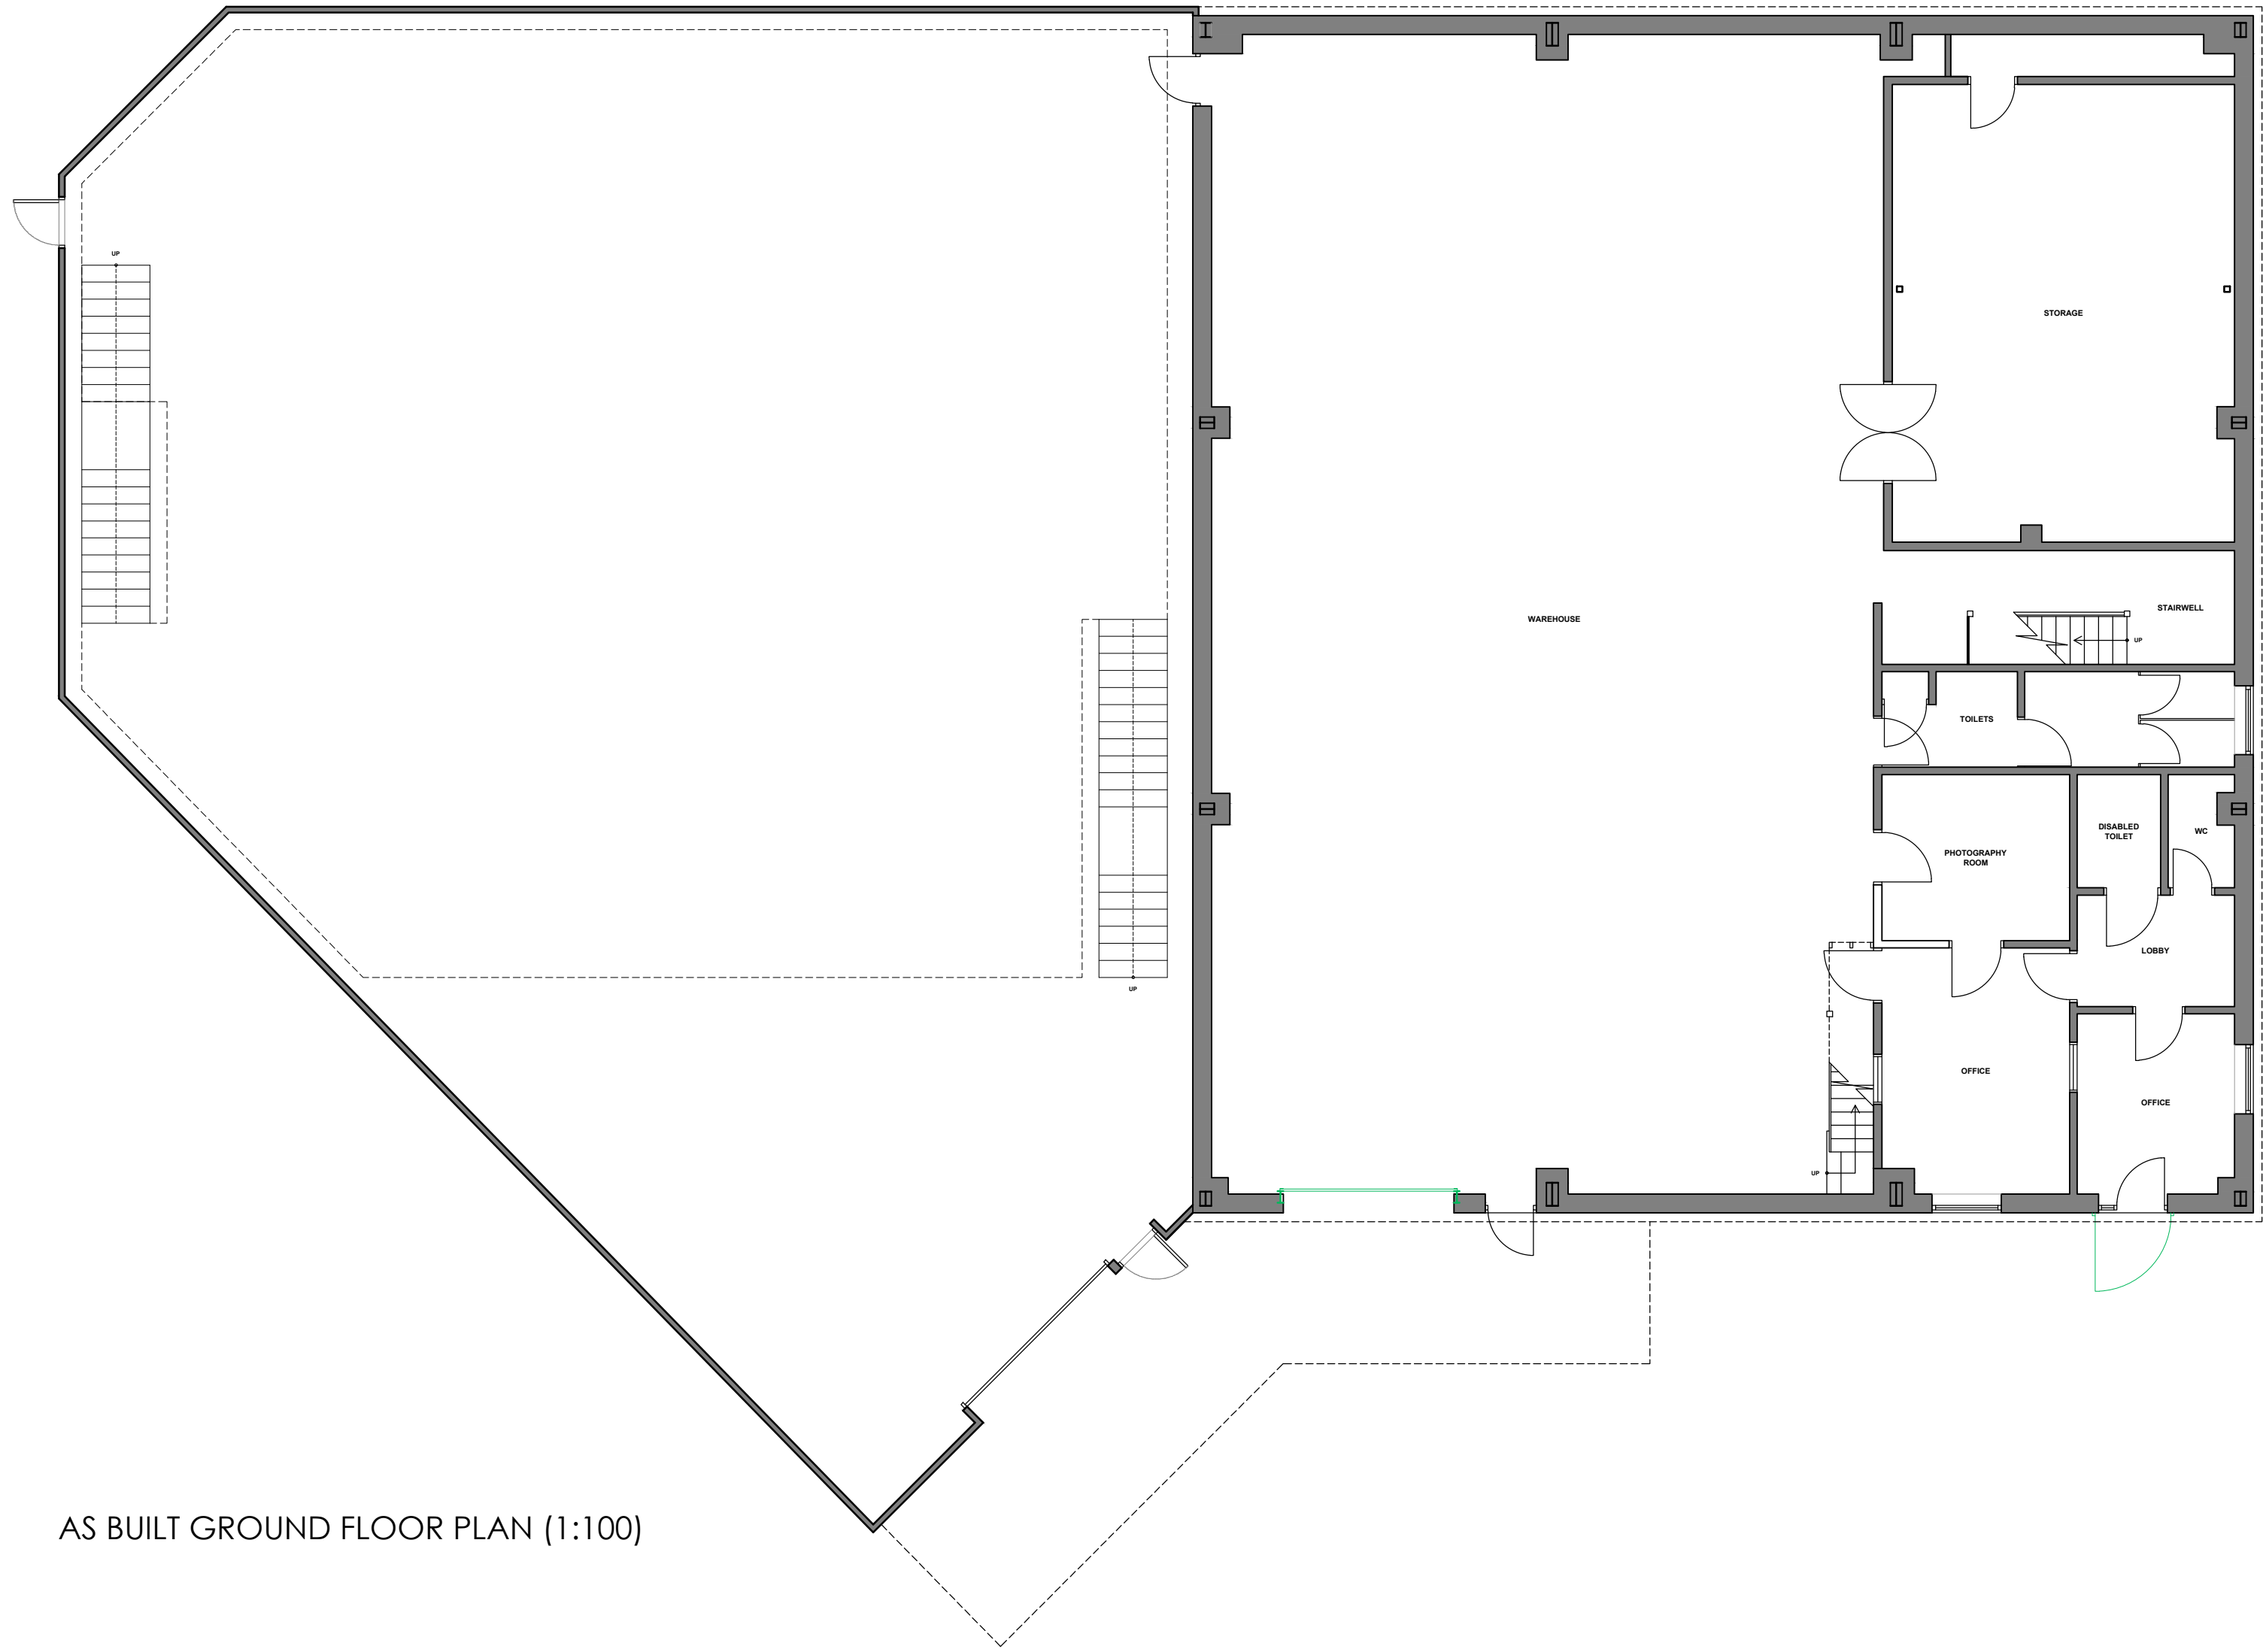

AS BUILT GROUND FLOOR PLAN (1:100)

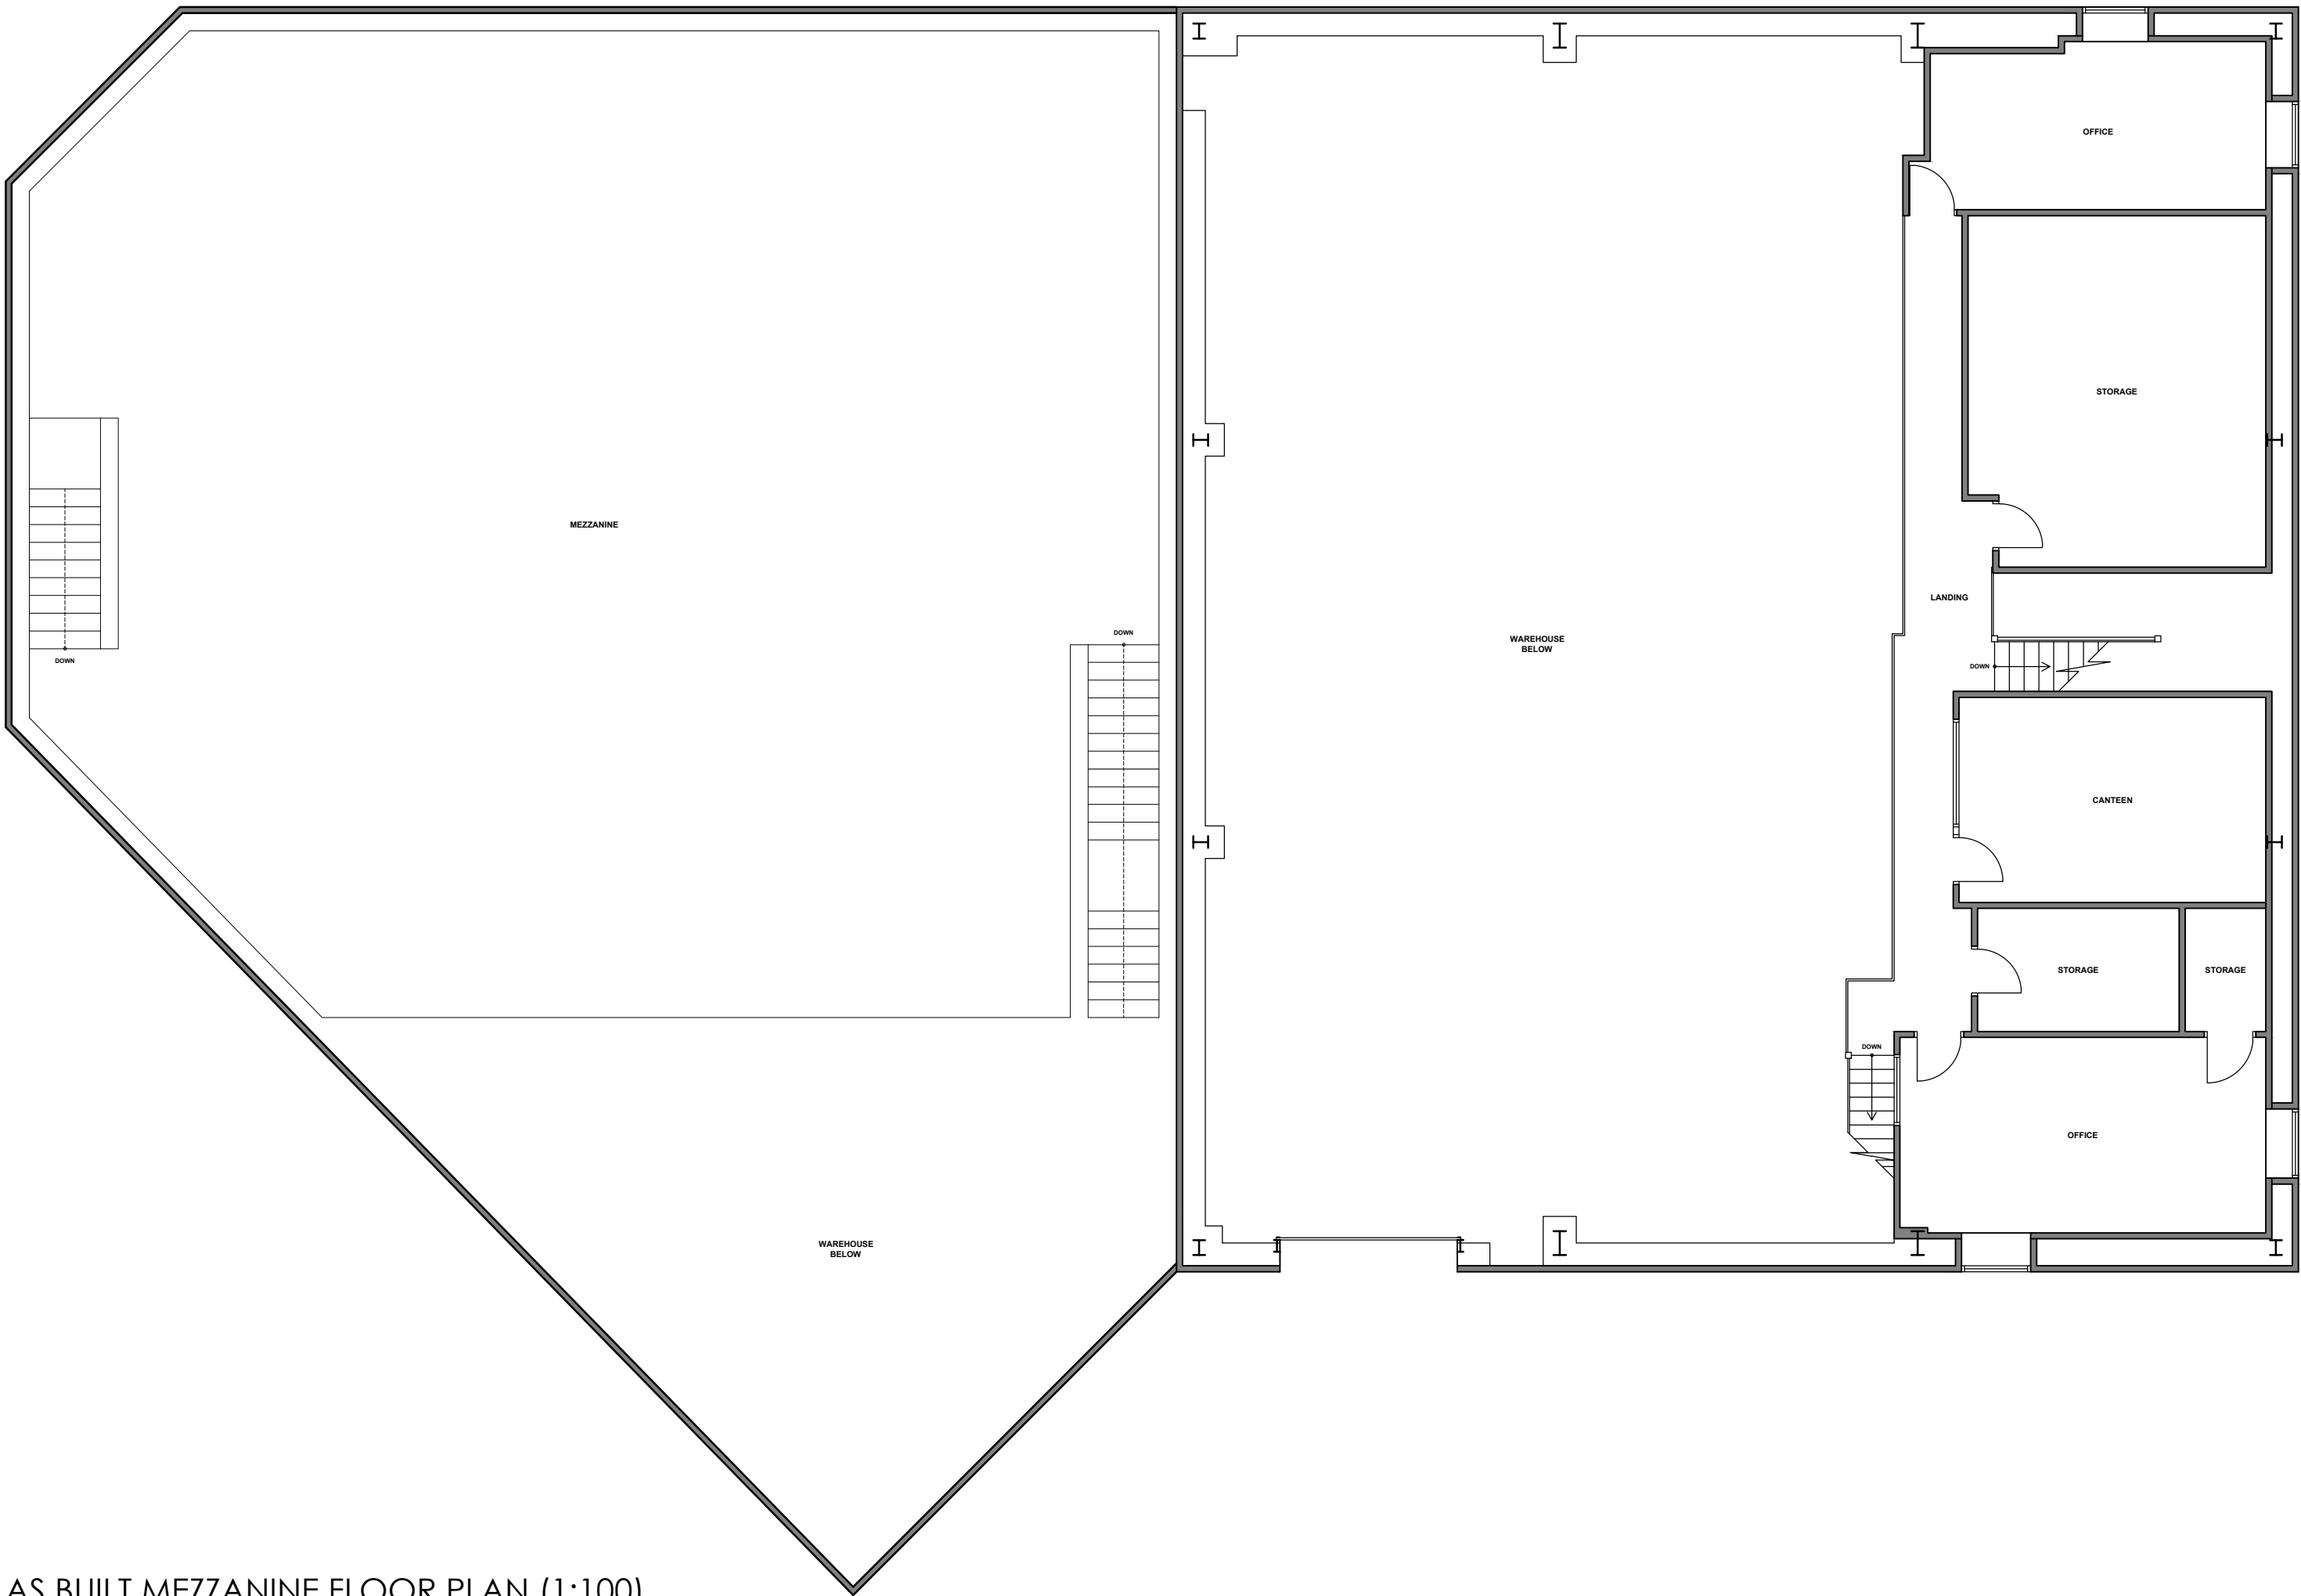


AS BUILT MEZZANINE FLOOR PLAN (1:100)

cadence

Cadence Architecture Ltd  
contact@cadence-architecture.co.uk  
www.cadence-architecture.co.uk

project north

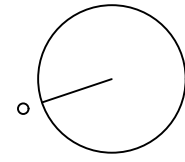

notes

1. Drawings are based on survey data and may not accurately represent what is physically present.
2. Do not scale from this drawing. All dimensions to be site verified by the contractor before proceeding.
3. All dimensions are in millimeters unless noted otherwise.
4. Your Practice Name Ltd shall be notified in writing of any discrepancies.

key plan  
not to scale

revisions

| REV | DATE | DRAWN BY | APPR. BY | NOTES |
|-----|------|----------|----------|-------|
|     |      |          |          |       |
|     |      |          |          |       |
client:

VALUME LTD

project:

CCG DEPOT  
AINSWORTH ST, OL16 5QX

status:

PLANNING

revision:

title:

AS BUILT PLANS

drawn by:

PDP

approved by:

PDP

date:

07.04.25

job no:

121ROC

scale:

1:100@A1

drawing no:

105