
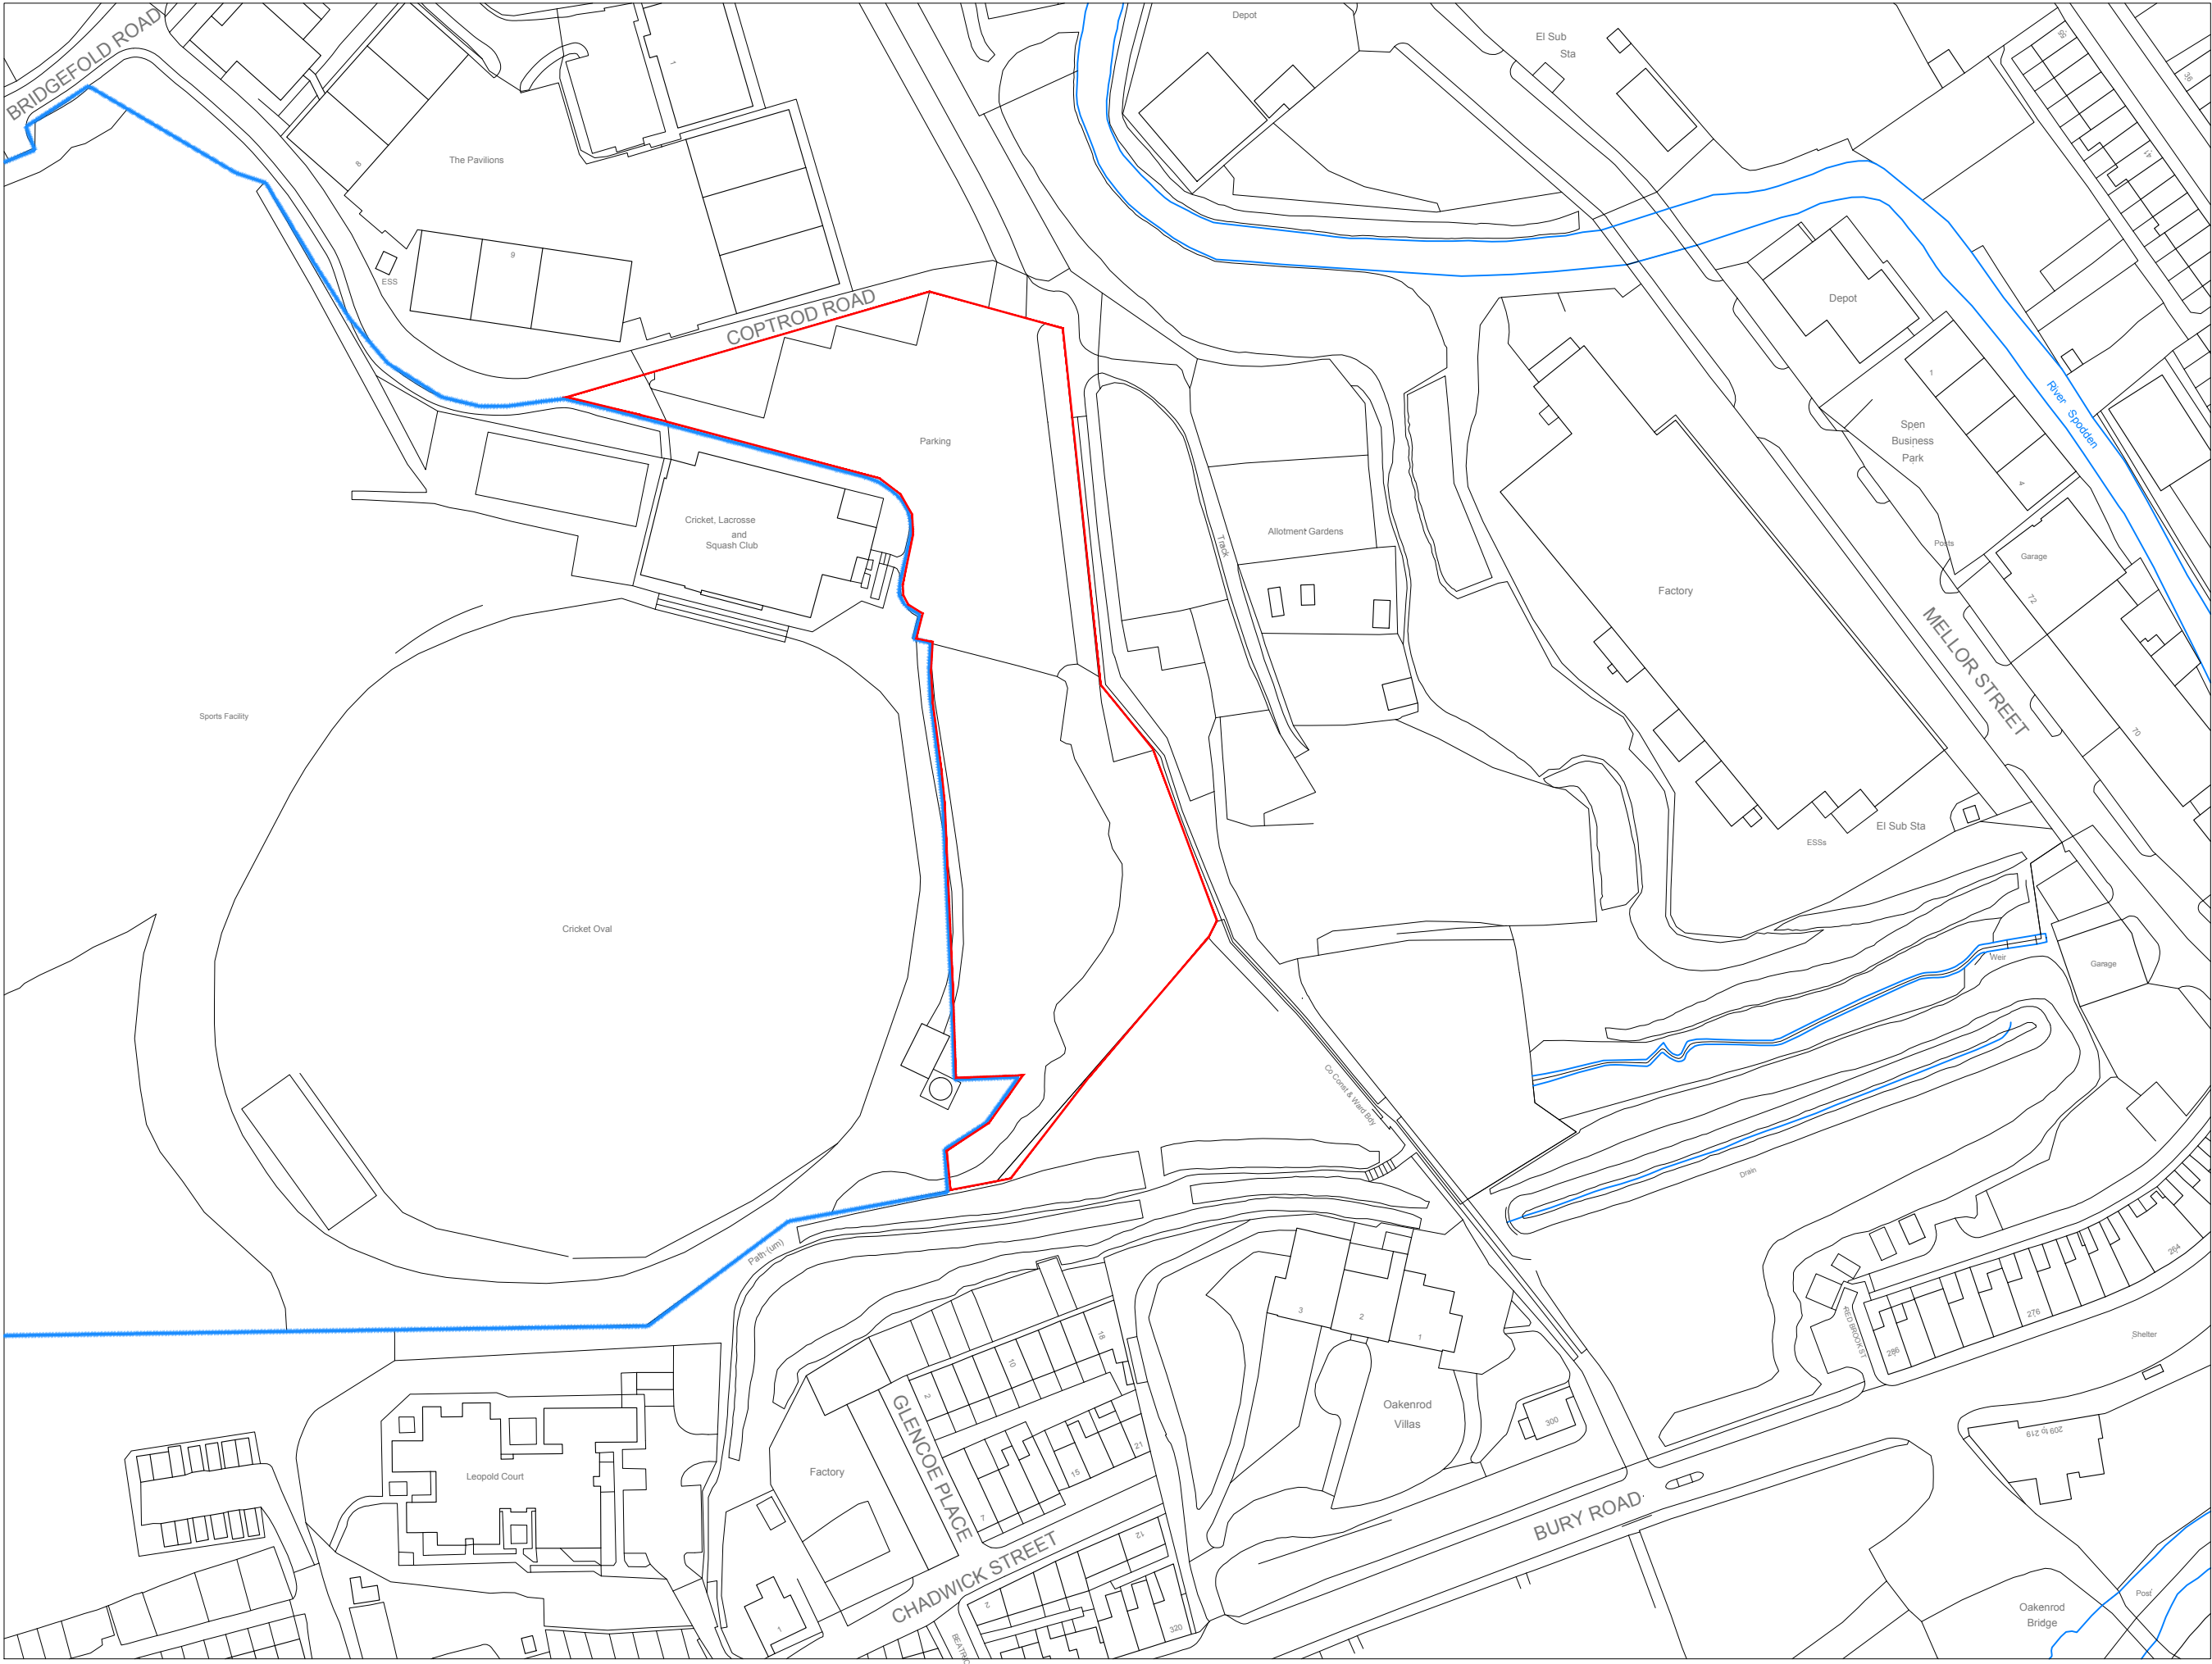


All dimensions are to be checked on site prior to commencement, any discrepancy is to be reported to the Architect or Contract Administrator.

All construction to be carried out in accordance with all relevant British Standards and Codes of Practice

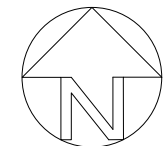

1 Existing Location Plan
1:1250

- | | | | |
|---|----------|---|----|
| C | 20.01.26 | Site boundary amended further to planner request. | LK |
| B | 03.12.25 | Red Line boundary amended further to planner request. | LK |
| A | 23.09.25 | Site boundary amended further to planner request. | LK |



**THE
PADEL
ARCHITECTS**

02074 078623
07879 674470
07920 720445

hello@thepadelarchitects.com
thepadelarchitects.com

Studio 531
Salisbury House Finsbury
Circus
London
EC2M 5AQ

Client JORDAN INGOE
ROCHDALE PADEL CLUB

Project BRIDGEFOLD ROAD
ROCHDALE
OL11 5BX

Drawing EXISTING LOCATION PLAN

Drawn By LK Scale 1:1250@A1

Checked By RH Date AUGUST 2025

Project No.	Drawing No.	Revision
25009	005	C
PLANNING		