


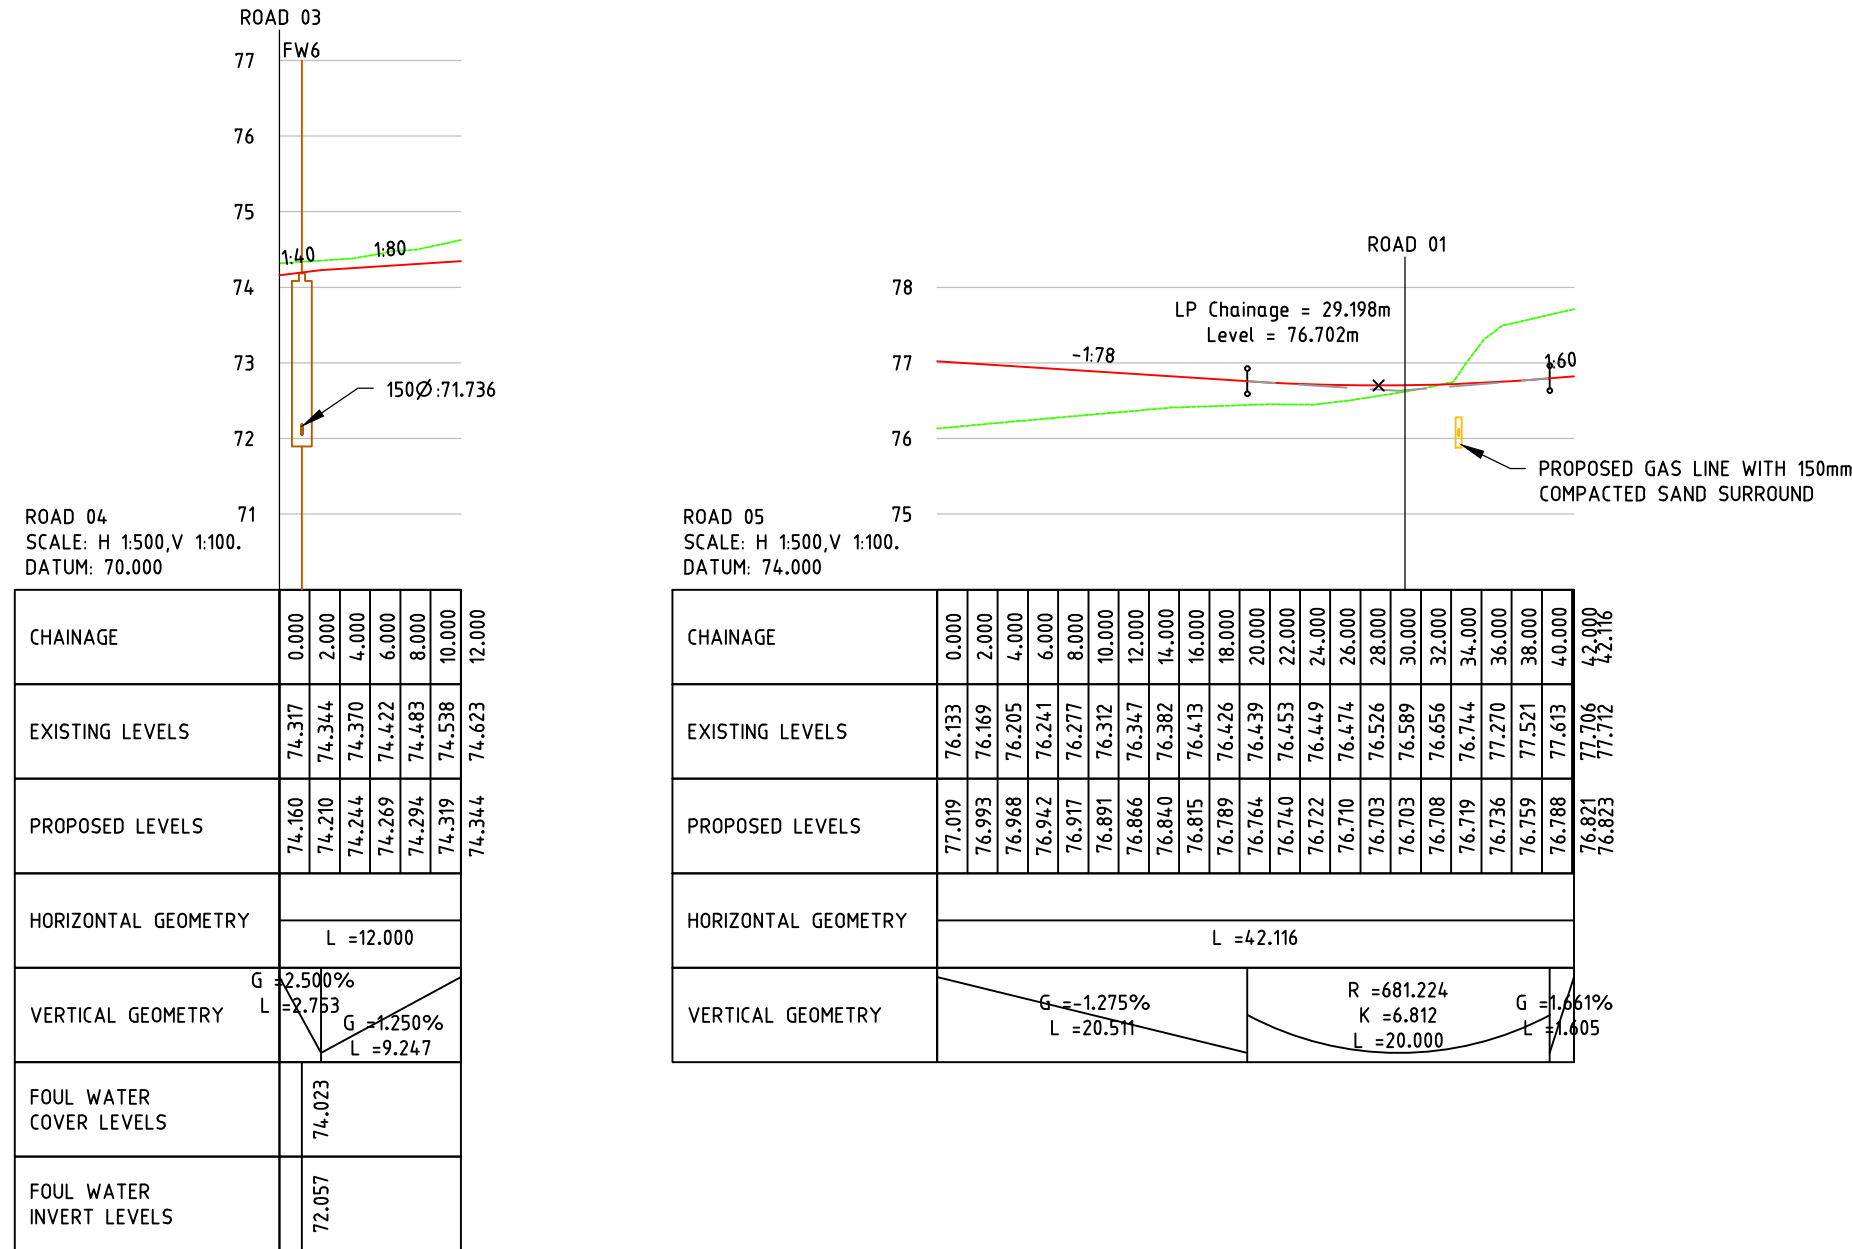

- | | | | |
|-----|----------|---|-----------|
| P07 | 27.10.25 | Updated to as-built information | M.A. R.A. |
| P07 | 30.09.25 | Drainage re-design | M.A. R.A. |
| P08 | 04.09.25 | Updated notes. | H.S. R.A. |
| P05 | 31.07.25 | Added proposed gas lines. | H.S. R.A. |
| P04 | 24.02.25 | Amended to site layout 49, and client comments. | H.S. R.A. |
| P03 | 16.01.25 | Lowered FW1 IL. | H.S. R.A. |
| P02 | 12.12.24 | Updated with site layout rev 47 | H.S. R.A. |
| P01 | 02.02.22 | PRELIMINARY - Issued for Information | J.C. R.A. |

Rev	Date	Description	By	Chk
Manchester, UK 3rd Floor, Canonway Court, 12 Blacklocks Street, Manchester, M3 9BG, United Kingdom T: +44 (0) 161 834 1938 E: manchester@edgeco.com				
The concept – information contained in this document is the copyright of EDGE Consulting Engineers. Use or copying of this document in whole or in part without the written permission of EDGE Consulting Engineers constitutes an infringement of copyright. DO NOT SCALE DRAWINGS. IF IN DOUBT, ASK!				
Project Name NORTH MANCHESTER GOLF CLUB				
Client DUCHY HOMES				
Designed	Drawn	Checked	Scale @ A1	
R.A	H.S	R.A	N/A	
Drawing Title LONGITUDINAL SECTIONS SHEET 1				
Project No 210701				
Drawing No 210508-EDGE-XX-XX-DR-C-2201_P08			Revision	

PRELIMINARY
NOT FOR CONSTRUCTION