

DO NOT SCALE FROM THIS DRAWING
The contractor shall check and verify all dimensions on site and report any discrepancies in writing to CodaStudios before proceeding work

FOR ELECTRONIC DATA ISSUE
Electronic Data / drawings are issued as "read only" and should not be interrogated for measurement. All dimensions and levels should read, only from those values stated on the drawing. Coda Studios Ltd is not responsible for discrepancies caused by the overlay of other parties BIM/IFC models. These are overlaid purely as reference.


Revision	Date	Drawn	Checked	
A	ASHP Relocated to Suit Location on Site	04/03/26	TH	YK




Front Elevation Plot 06
Scale: 1 : 50



Rear Elevation Plot 06
Scale: 1 : 50

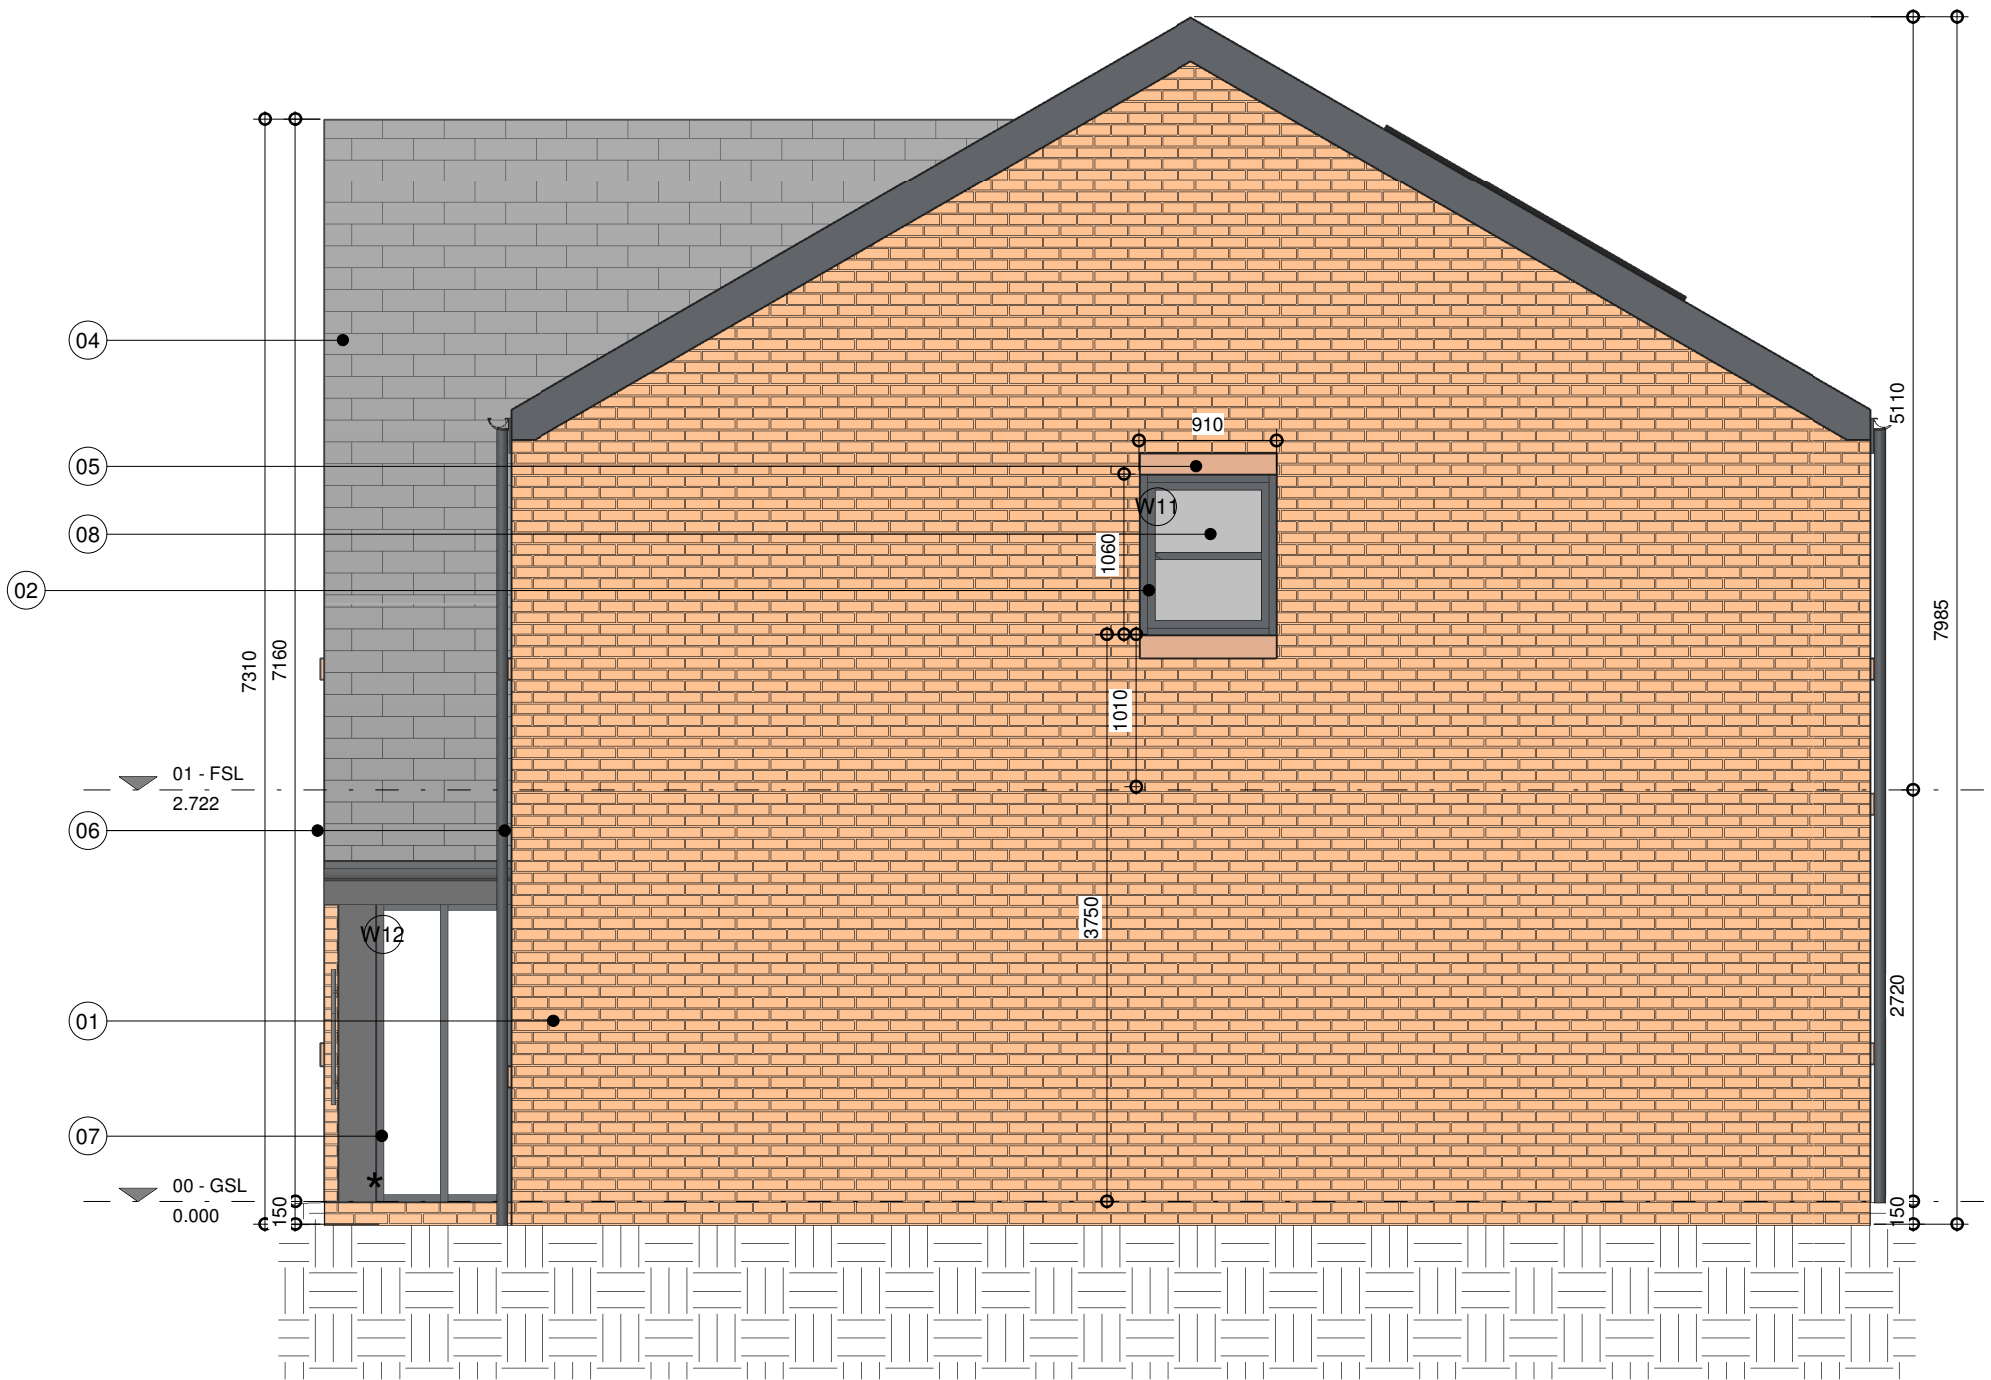

Right Side Elevation PLOT 06
Scale: 1 : 50

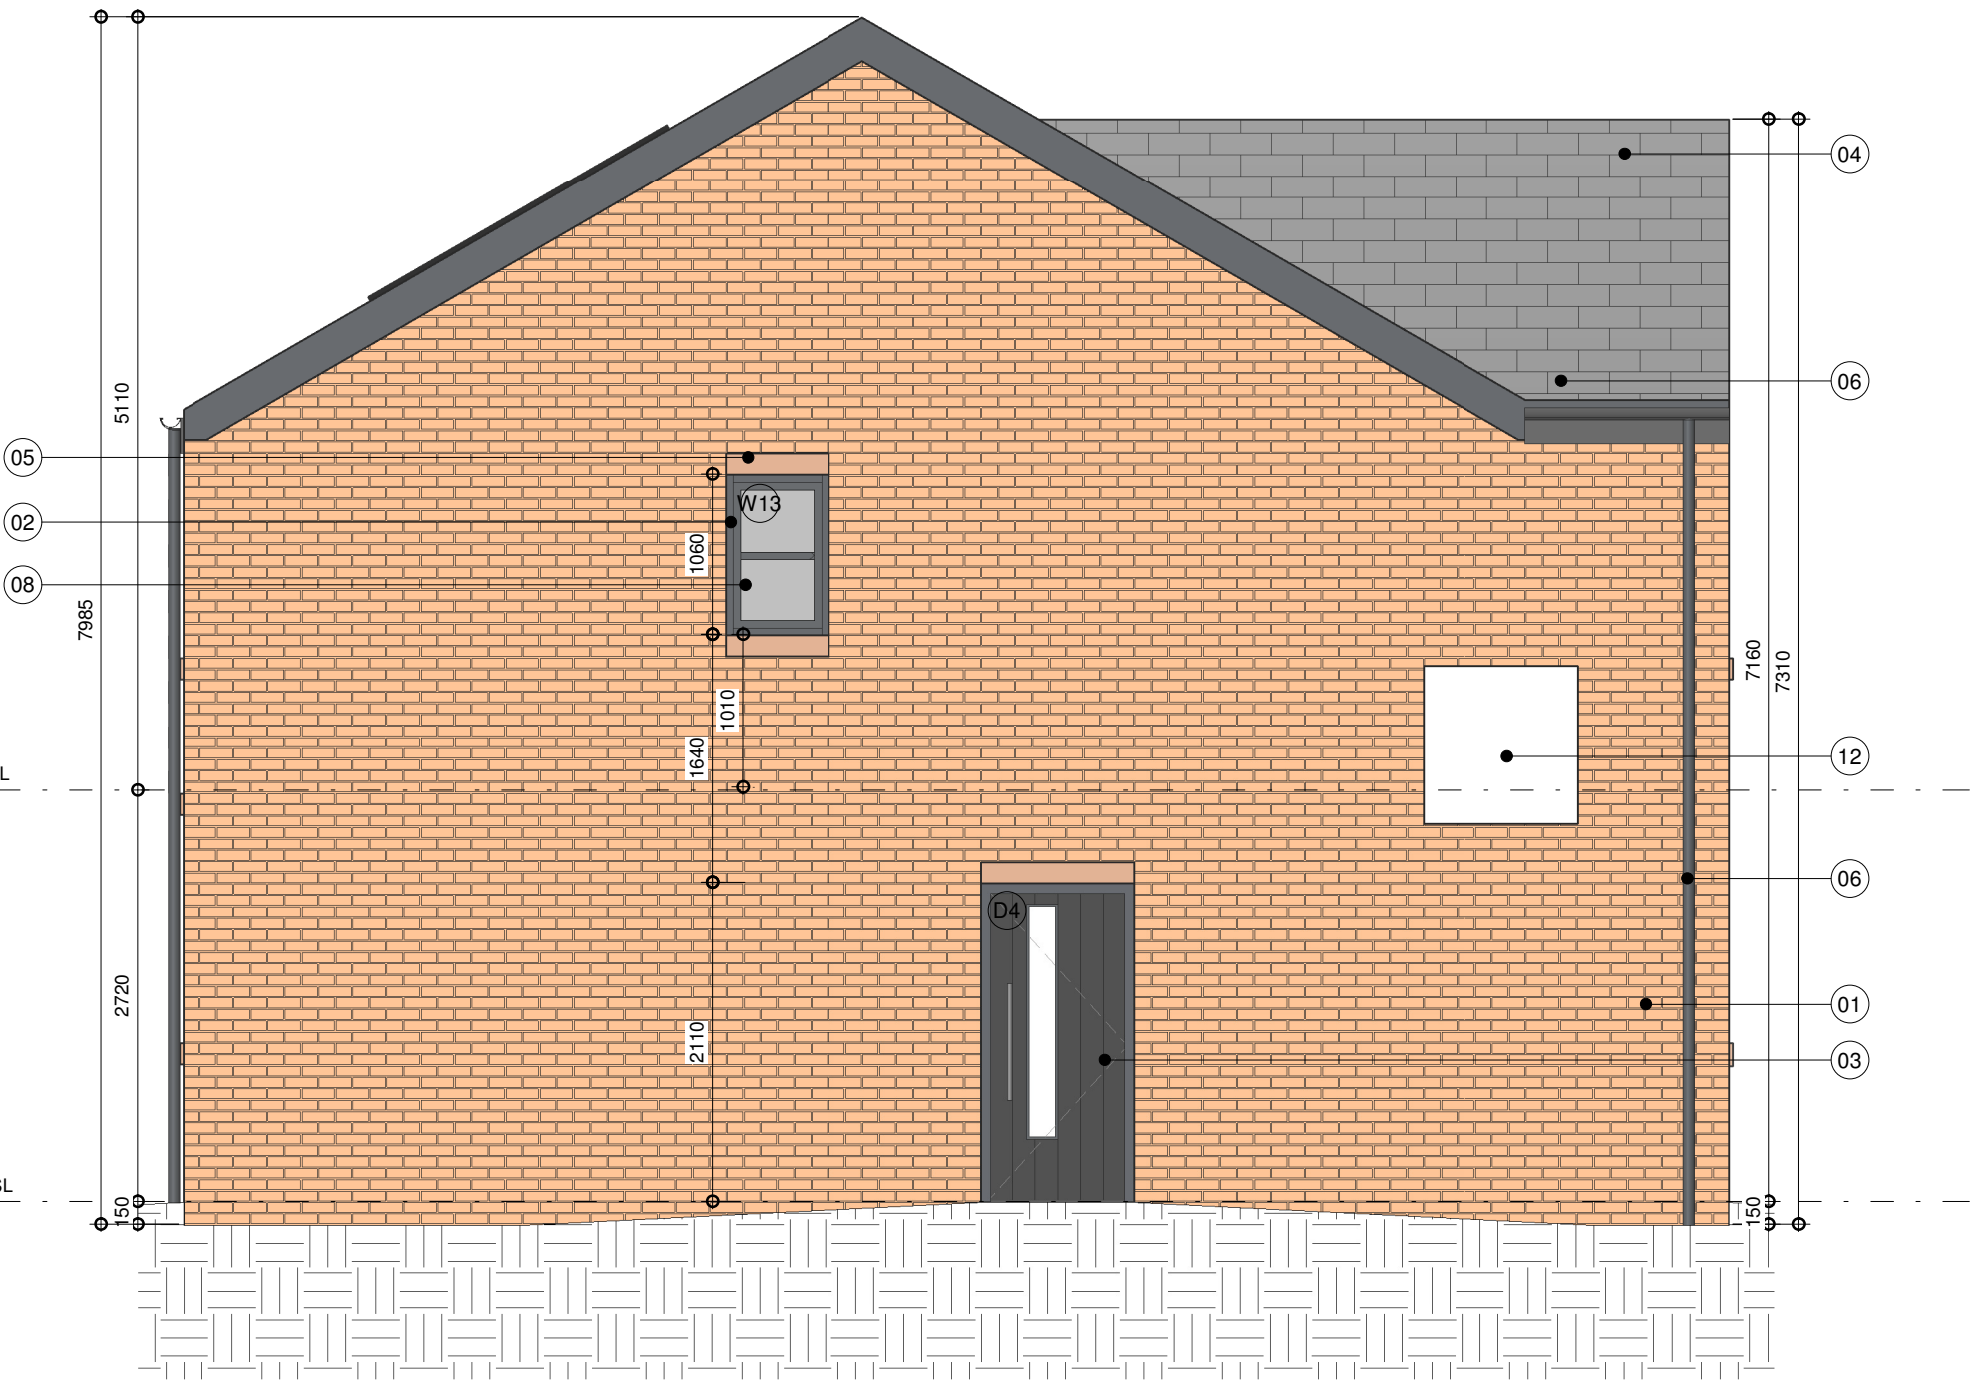

Left Side Elevation Plot 06
Scale: 1 : 50

Materials Key

- 01 Masonry Facing Brickwork (Dark Red Brick)
- 02 Black Aluminium Window (RAL 9005)
- 03 Black Front Entrance Door (RAL 9005)
- 04 Concrete Interlocking Roof Tiles
- 05 Stone Header & Cill
- 06 Black Fascias & Rainwater Goods
- 07 Black Entrance Atrium (RAL 9005)
- 08 Obscure Glazed Window
- 09 Black Garage Door
- 10 Glass Balustrade
- 11 Solar Panels
- 12 Air Source Heat Pump

THIS DRAWING MUST BE READ IN CONJUNCTION WITH THE FOLLOWING SERIES

- 00 EXISTING SITE
- 01 EXISTING PLANS
- 02 EXISTING ELEVATIONS
- 03 EXISTING SECTIONS
- 04 PLANNING DRAWINGS
- 05 PROPOSED SITE
- 06 PROPOSED PLANS
- 07 PROPOSED ELEVATIONS
- 08 PROPOSED SECTIONS
- 09 DEMOLITION
- 10 CONSTRUCTION NOTES
- 11 FIRE STRATEGY
- 12 SETTING OUT
- 13 APARTMENT SETTING OUT
- 14 WALL AND PARTITION TYPES
- 15 FLOOR AND ROOF TYPES
- 16 GROUND WORKS DETAIL
- 17 SUPERSTRUCTURE DETAILS
- 18 MASONRY
- 19 INTERNAL DETAILS
- 20 LIFT AND STAIRS
- 21 ROOF DETAILS
- 22 WINDOW PACKAGE
- 23 DOOR PACKAGE
- 24 METAL WORK
- 25 FACADES
- 26 EXTERNALS PACKAGE
- 27 BATHROOM PACKAGE
- 28 KITCHEN PACKAGE
- 29 PATTERESSING
- 30 ELECTRICAL & MECHANICAL
- 31 REFLECTED CEILING PLANS
- 32 FINISHES & WAYFINDING
- 33 LEGAL
- 34 AS BUILT

CODA
Bespoke

CODA Studios Ltd. 18 Lloyd House, Lloyd St, Manchester, M2 5WA.
T: 0161 660 2542 E: information@codastudios.co.uk

Client		PIC Homes	
Project			
Dobfield Road			
Drawn	Checked	Date	Scale @ A1
YK	TH	03/04/26	1 : 50
Title			
Elevations - HT01 (Plot 06)			
Suitability Code		Purpose for issue	
Coordination			
Drawing No			
3220	CDA	01 - XX - DR - A - 0706	A
Project	Originator	Volume	Level
		Type	Role
			Number
			Revision