

NOTES
ALL DIMENSIONS TO BE CHECKED ON SITE PRIOR TO ANY MANUFACTURING OR FABRICATION AND ANY ANOMALIES TO BE BROUGHT TO THE ATTENTION OF THE ARCHITECT.




FRONT ELEVATION




SIDE ELEVATION



REAR ELEVATION

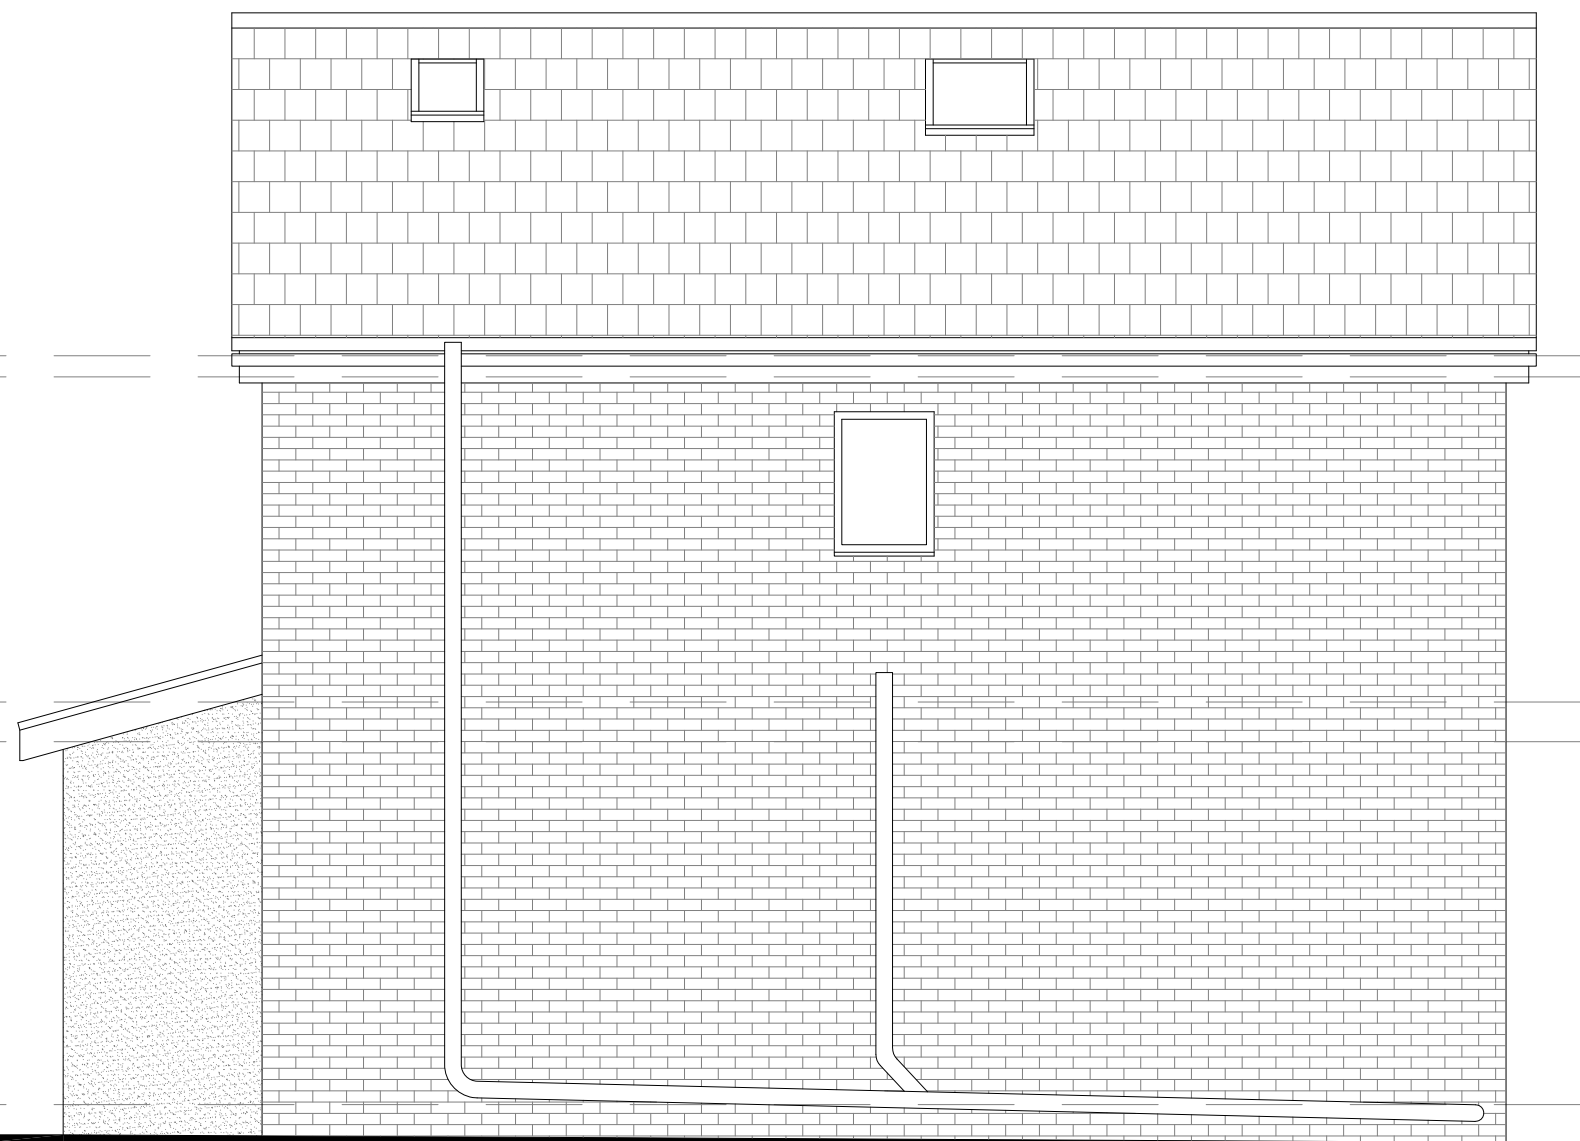

SIDE ELEVATION

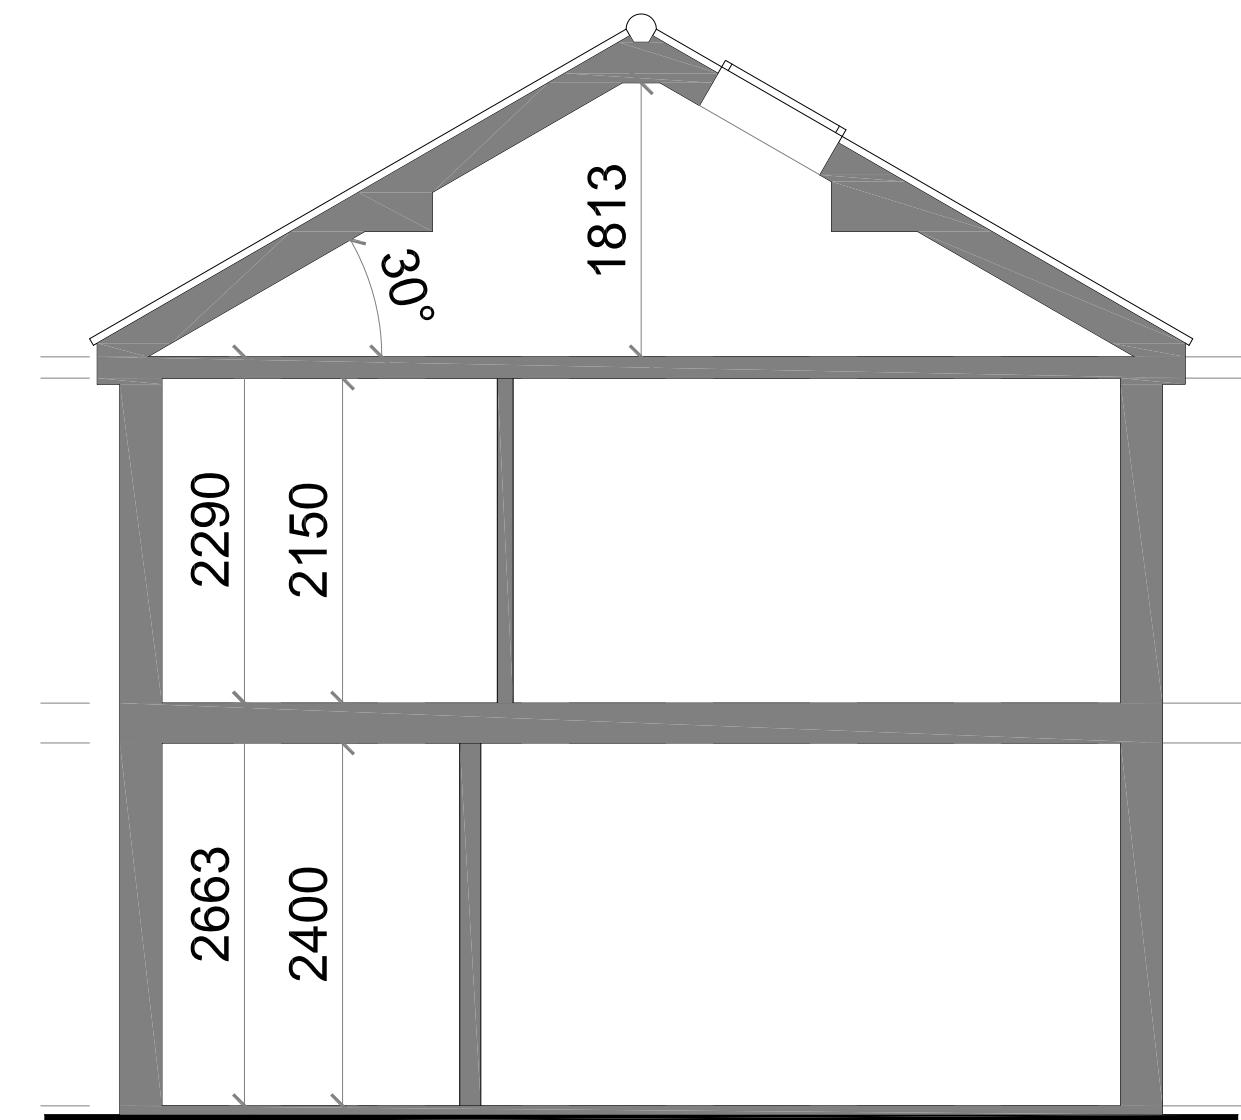

SECTION A-A

AS-BUILT

A REV	FIRST ISSUE	RW	10.04.26
AMENDMENTS		BY	DATE
PROJECT			
PROP EXTENSION / ALTERATIONS 6 WORDSWORTH WAY ROCHDALE OL11 5HZ			
CLIENT			
DR NOMAN			
DRAWING TITLE			
EXISTING ELEVATIONS AND SECTION			
DRAWN	RW	DATE	10.04.26
CHECKED		SCALE	1:50 (A1)
APPROVED			
		HOWARD & SEDDON A.R.I.B.A. CHARTERED ARCHITECTS 64 WASHWAY ROAD SALE, CHESHIRE, M33 7RE TEL NO. 0161 - 973 8296 FAX NO. 0161 - 962 3485 E-MAIL : ADMIN@HOWARDANDEDSON.CO.UK	
JOB No.	16,125	DRG No.	02
		REVISION	A