



AS BUILT NORTH-WEST ELEVATION, 1:100 @ A1

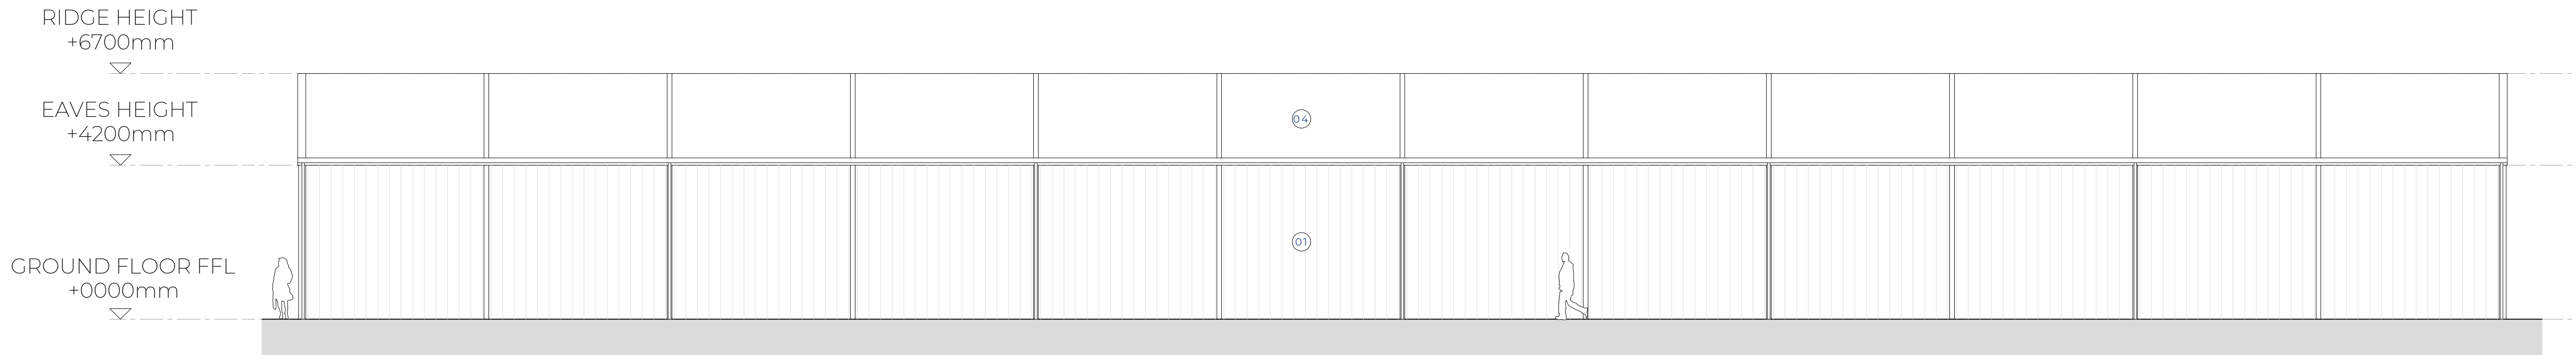

AS BUILT SOUTH-EAST ELEVATION, 1:100 @ A1

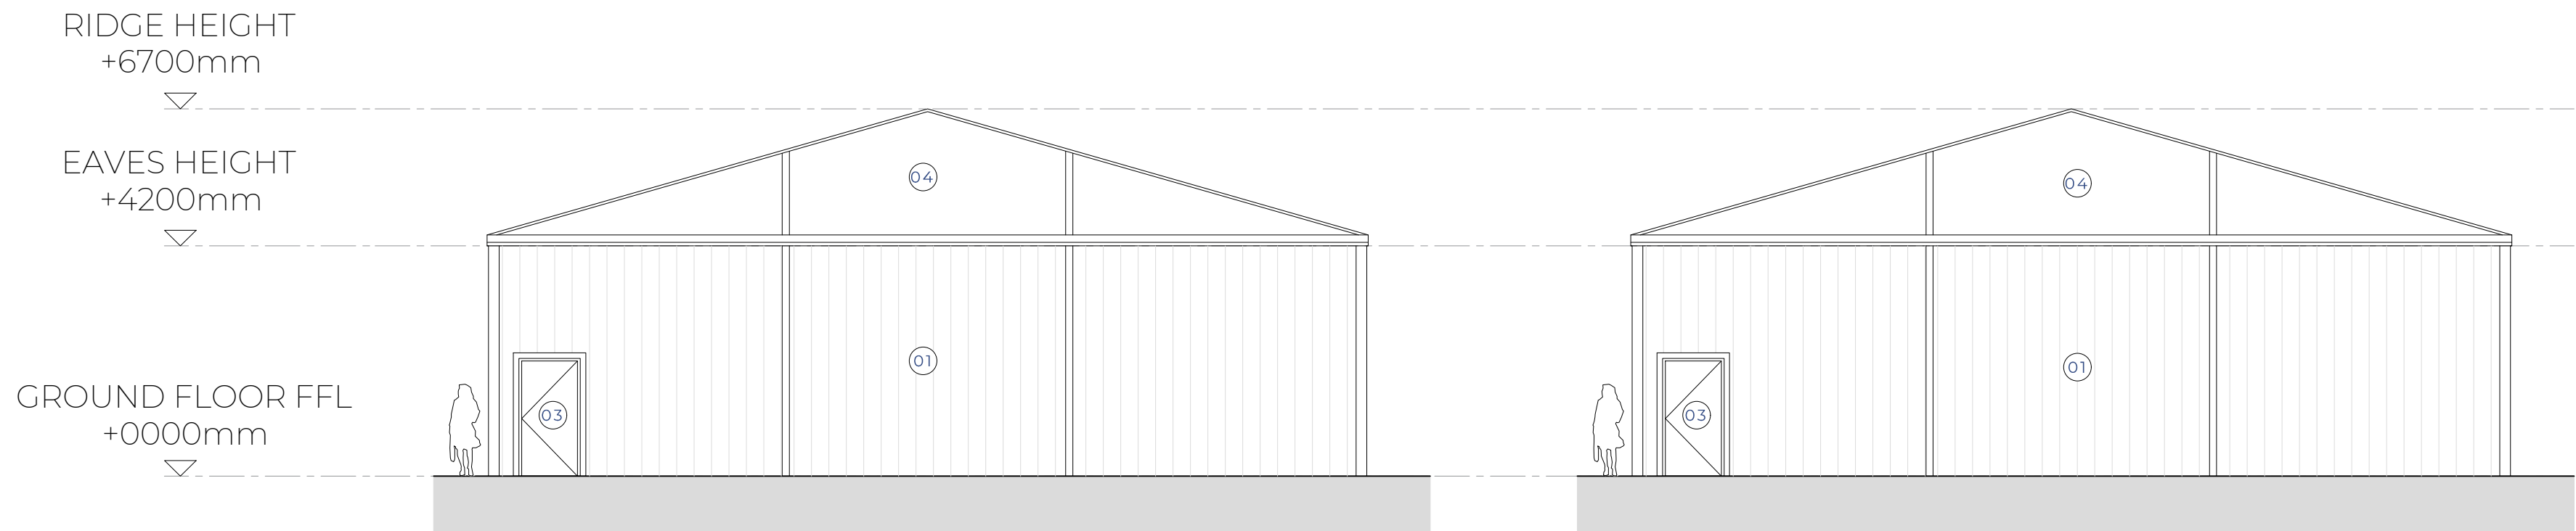

AS BUILT SOUTH-WEST ELEVATION,
1:100 @ A1

AS BUILT NORTH-EAST ELEVATION,
1:100 @ A1

MATERIAL KEY:

- 01 Trapezoidal Steel wall cladding
- 02 Roller shutter doors
- 03 Steel frame fire doors
- 04 White PVC coated polyester flame-retardant fabric

Drawings generated using information supplied from Quick Space Ltd. Structure Ref: TD5/16.0/42
Due to the novated nature of the appointment, SDA Architecture cannot provide collateral warranties.

This drawing is not to be manipulated in any way. Any errors or discrepancies should be reported to SDA Architecture. Work to given dimensions only which the contractor must check and confirm all dimensions onsite. Copyright to remain with SDA Architecture and is not to be copied, lent or used by any third party without the express written permission of SDA Architecture.

REV	DATE	NOTES
-	13.05.26	First issue for client comment only.

Scale @ A1: 1:100



SPATIAL CO-ORDINATION

PROJECT:

Royle Barn Road
Rochdale
OL11 3DT

DRAWING TITLE:

As built Elevations

DRAWN/APPROVED BY:

AD/AP

DRAWING NO:

26021-SDA-ZZ-ZZ-DR-A-0202

S D A ARCHITECTURE

34 Wellington Road
Oxton CH43 2JF
+44 (0) 151 651 1789
info@sdaarchitecture.com
sdaarchitecture.com

