



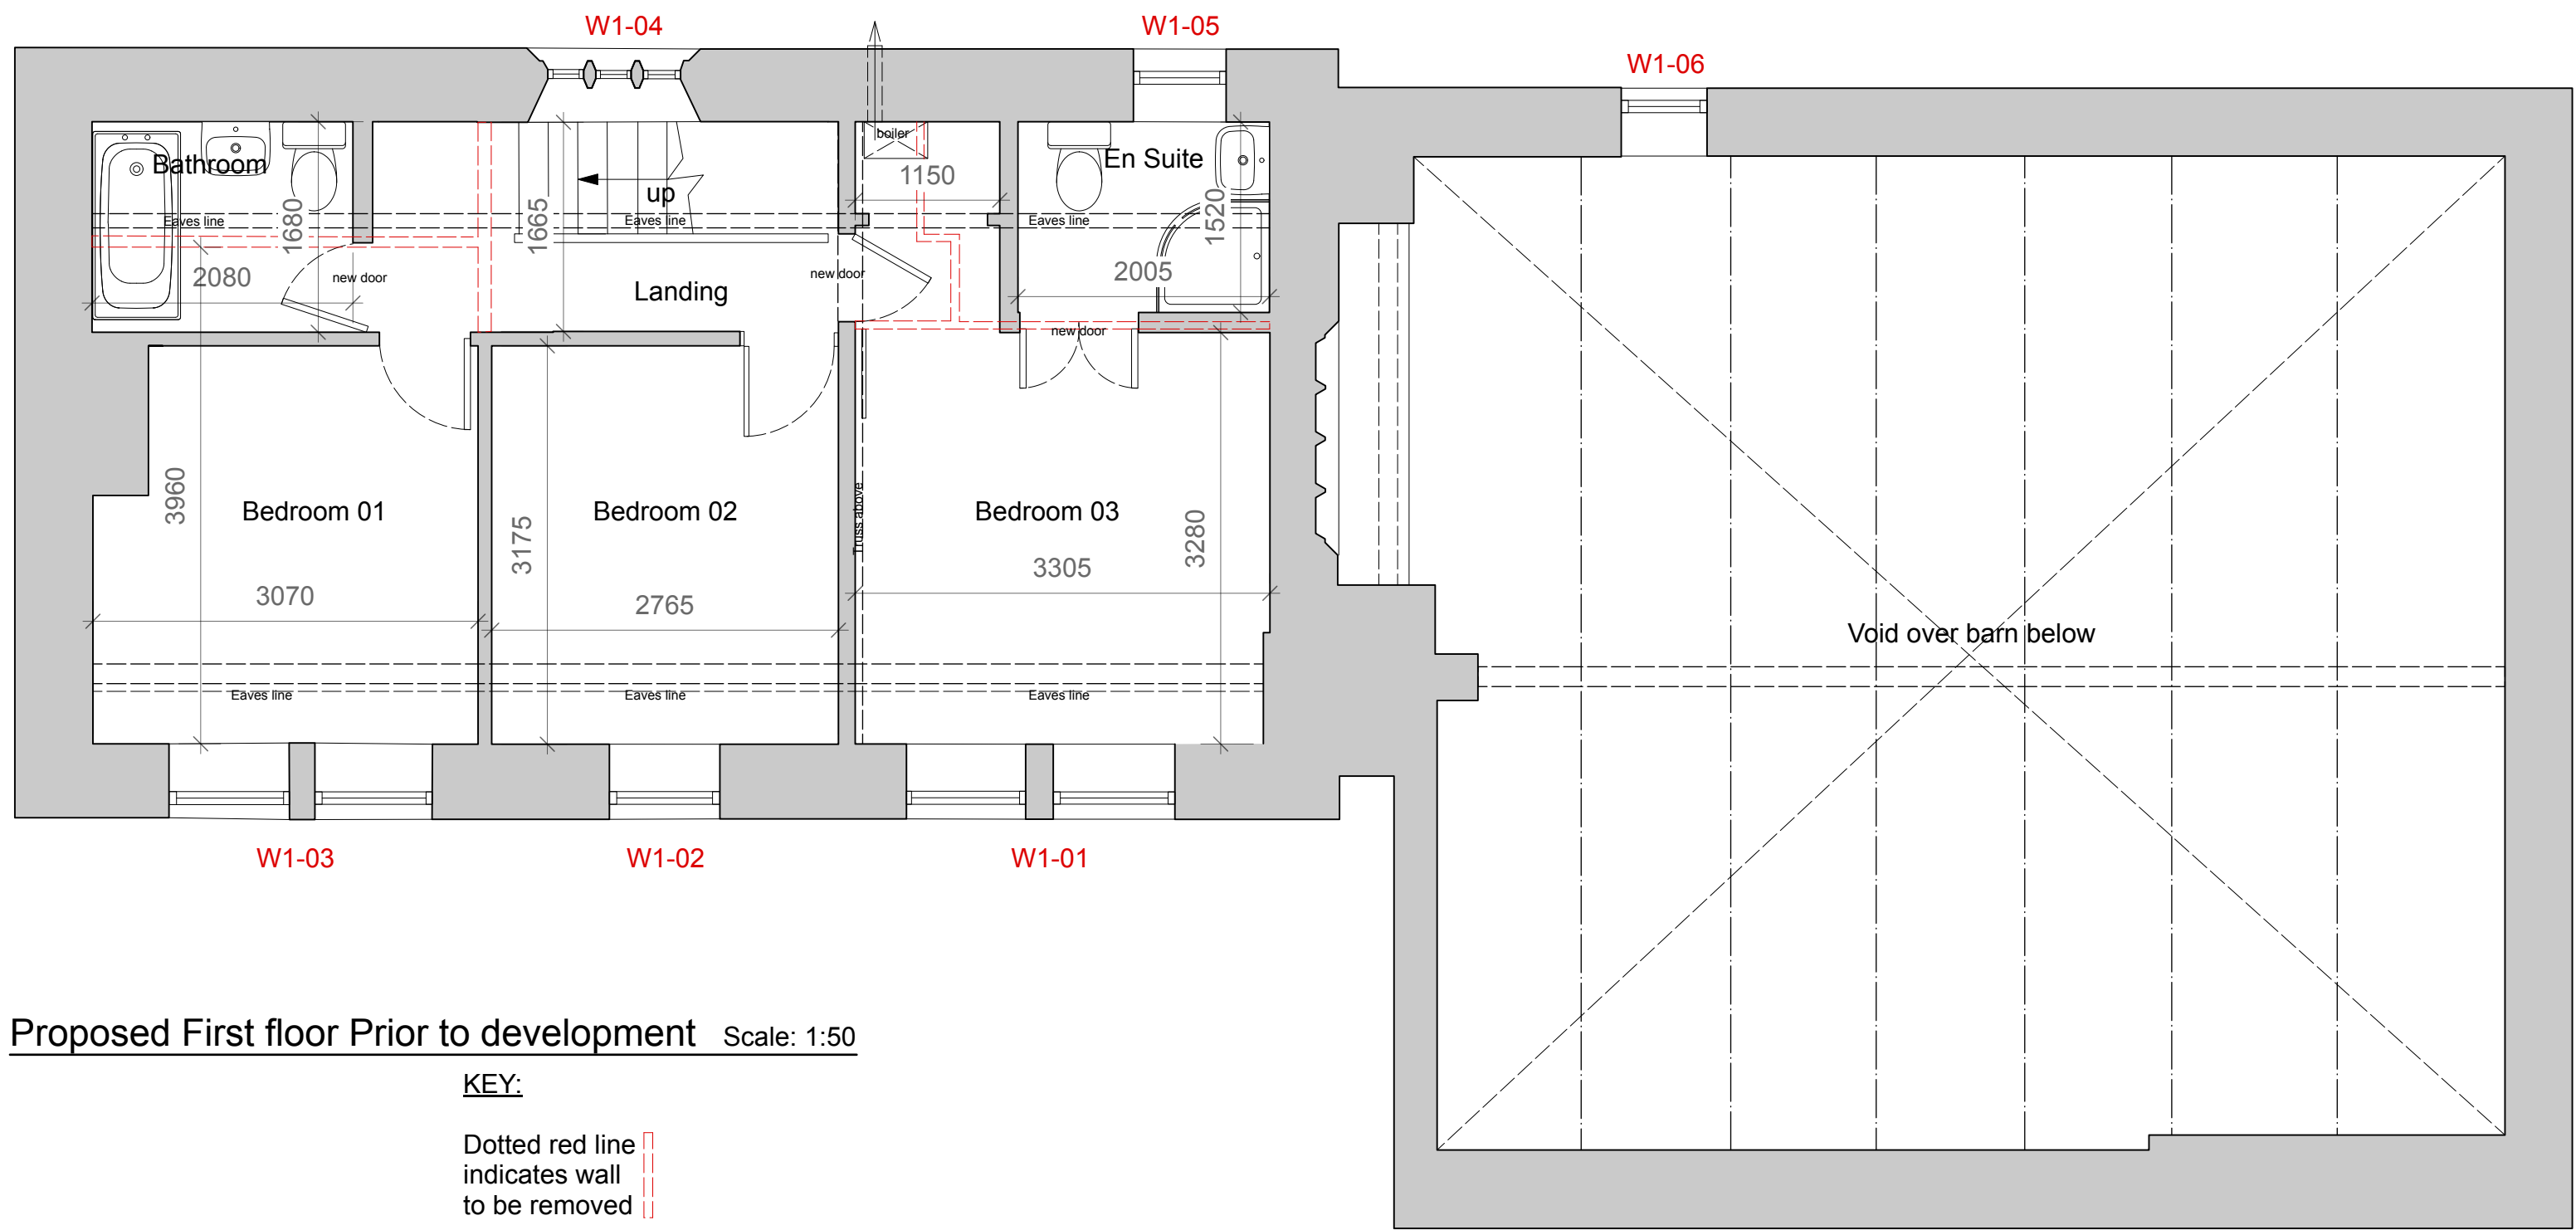

Proposed First floor Prior to development Scale: 1:50

KEY:

Dotted red line
indicates wall
to be removed

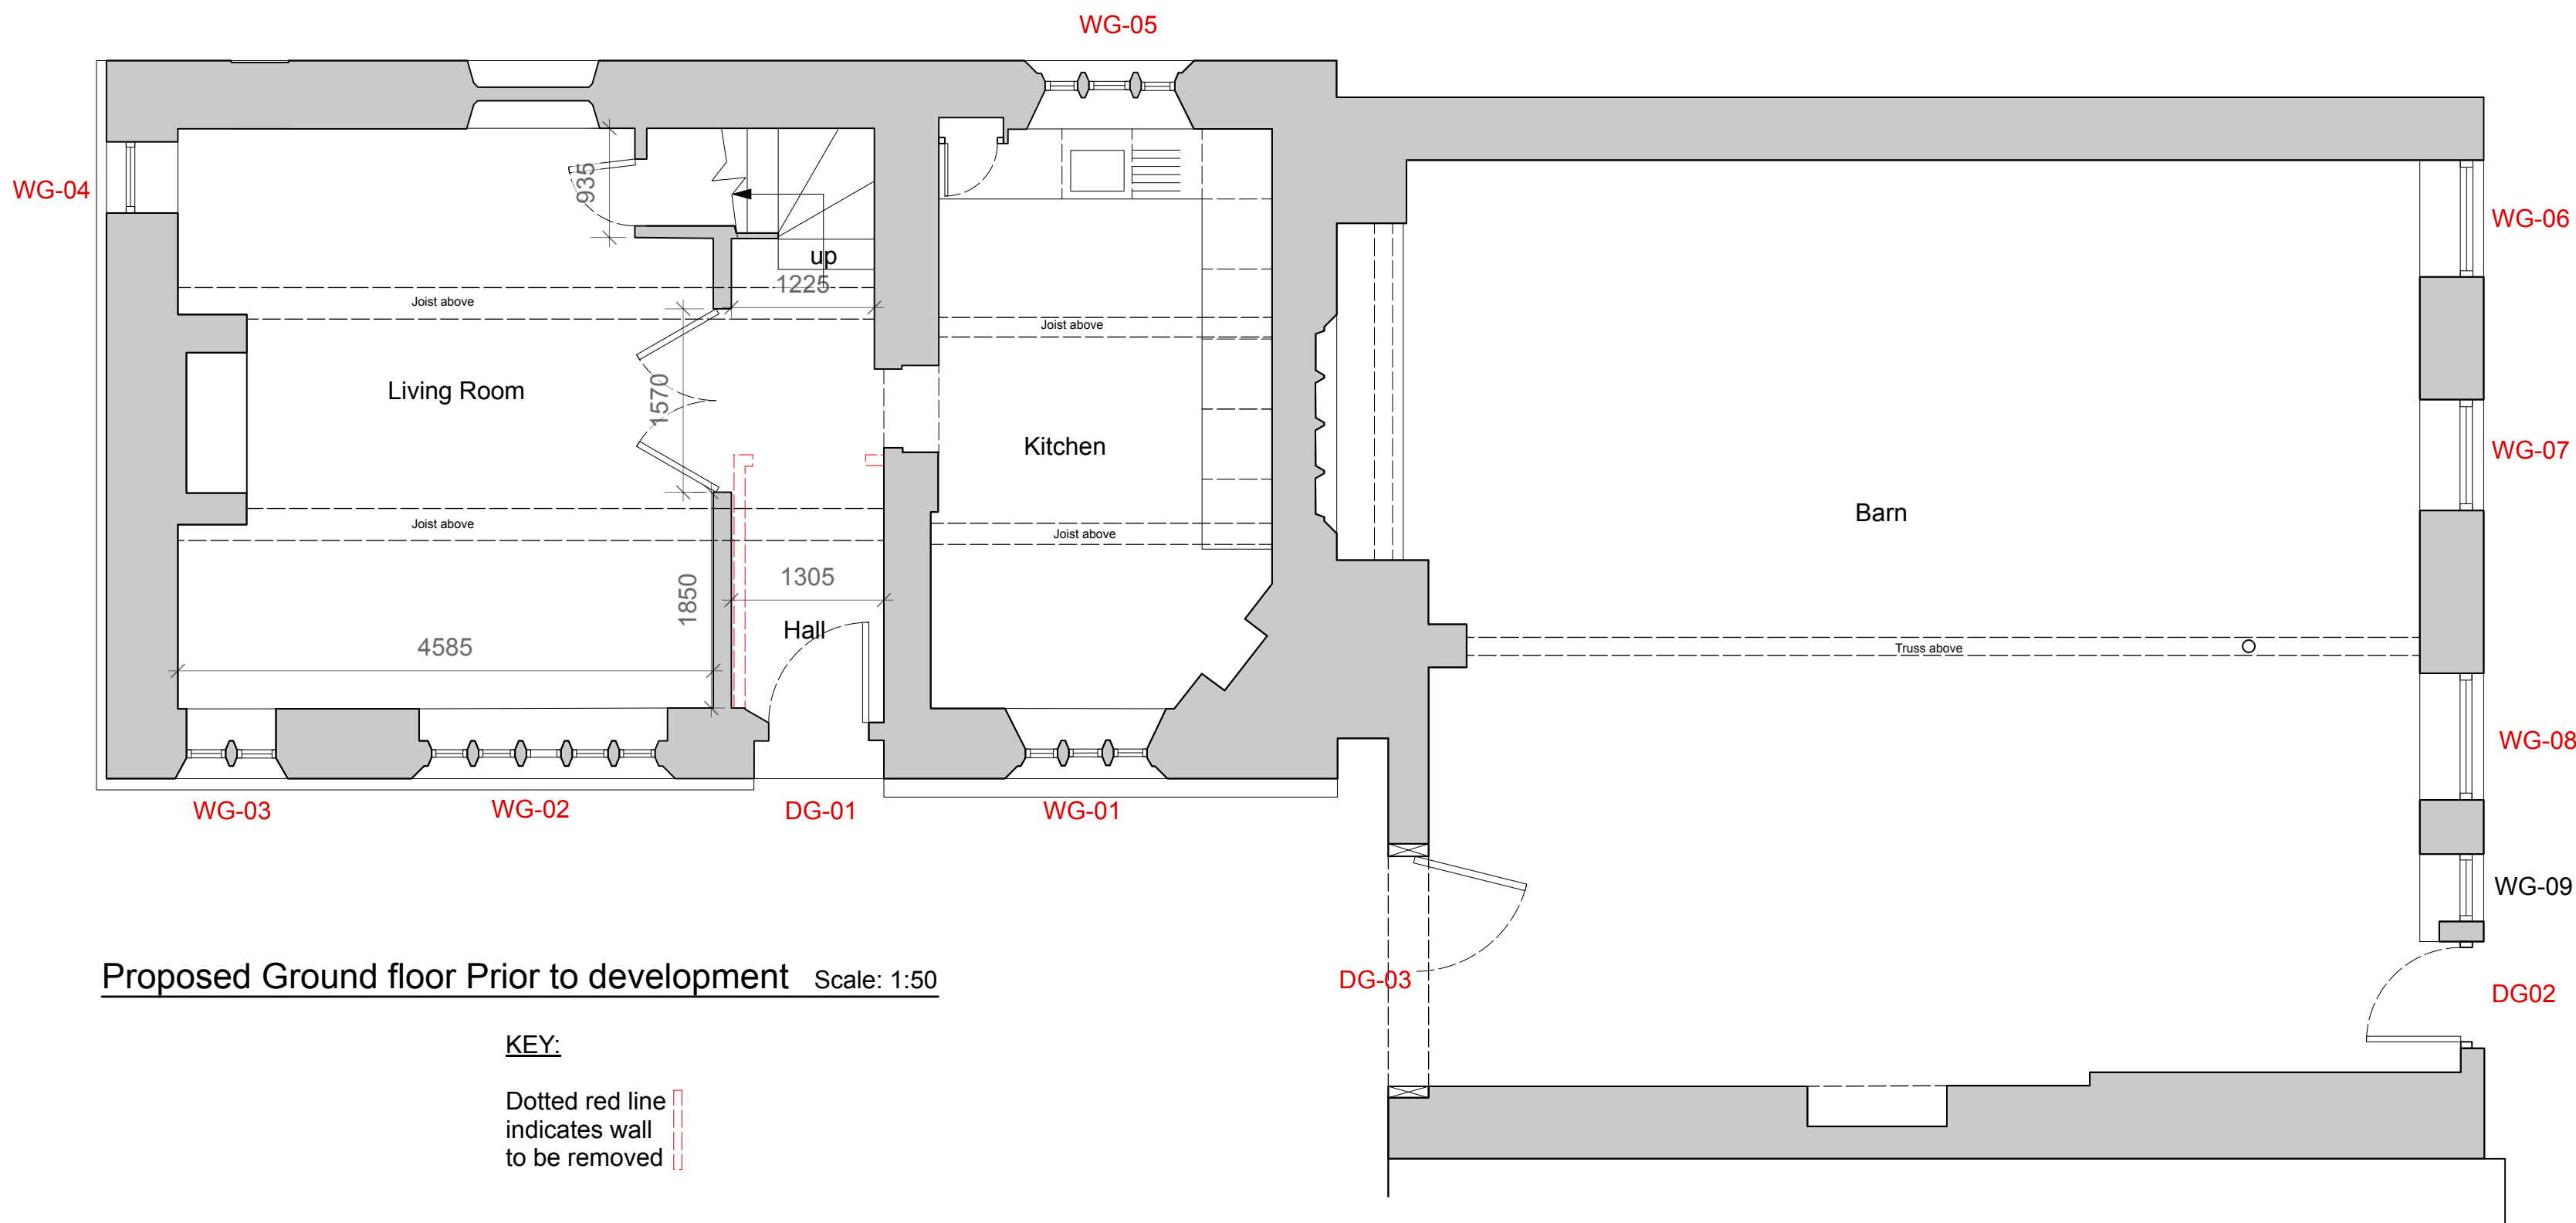

Proposed Ground floor Prior to development Scale: 1:50

KEY:

Dotted red line
indicates wall
to be removed

A 01/06/26 MB Minor changes to annotation

Revision

Project

Alterations to Existing Dwelling

Address

Manor Farm,
Wolstenholme Fold,
Rochdale
Mrs L Cramb

Drawing

Proposed Plans

storaarchitecture
Chartered Architects
RIBA Chartered Practice

www.storah.com mail@storah.com 01706 813214

Scale Sheet Size Date Drawn
1:50 ISO A1 10/04/26 MB

Drawing Number Revision

26-013- 300 A

© Storah Architecture Ltd.